


DATUM  
 VERTICAL NAVD88  
 HORIZONTAL NAD83 (92)

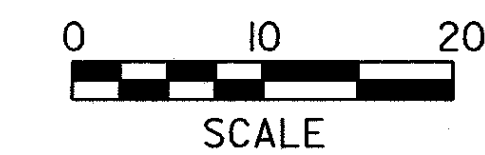

PROJECT NAME: SUDBURY  
 PROJECT NUMBER: ST 0161(10)  
 FILE NAME: /sqda/00c062/dc062xsl.dgn  
 PROJECT LEADER: BOMBARDIER  
 DESIGNED BY: MEUNIER  
 dc062x06.1  
 PLOT DATE: 19-DEC-2001  
 DRAWN BY: MEUNIER  
 CHECKED BY:  
 SHEET 33 OF 34