


DELONE
25DBCKA

Detour Profile

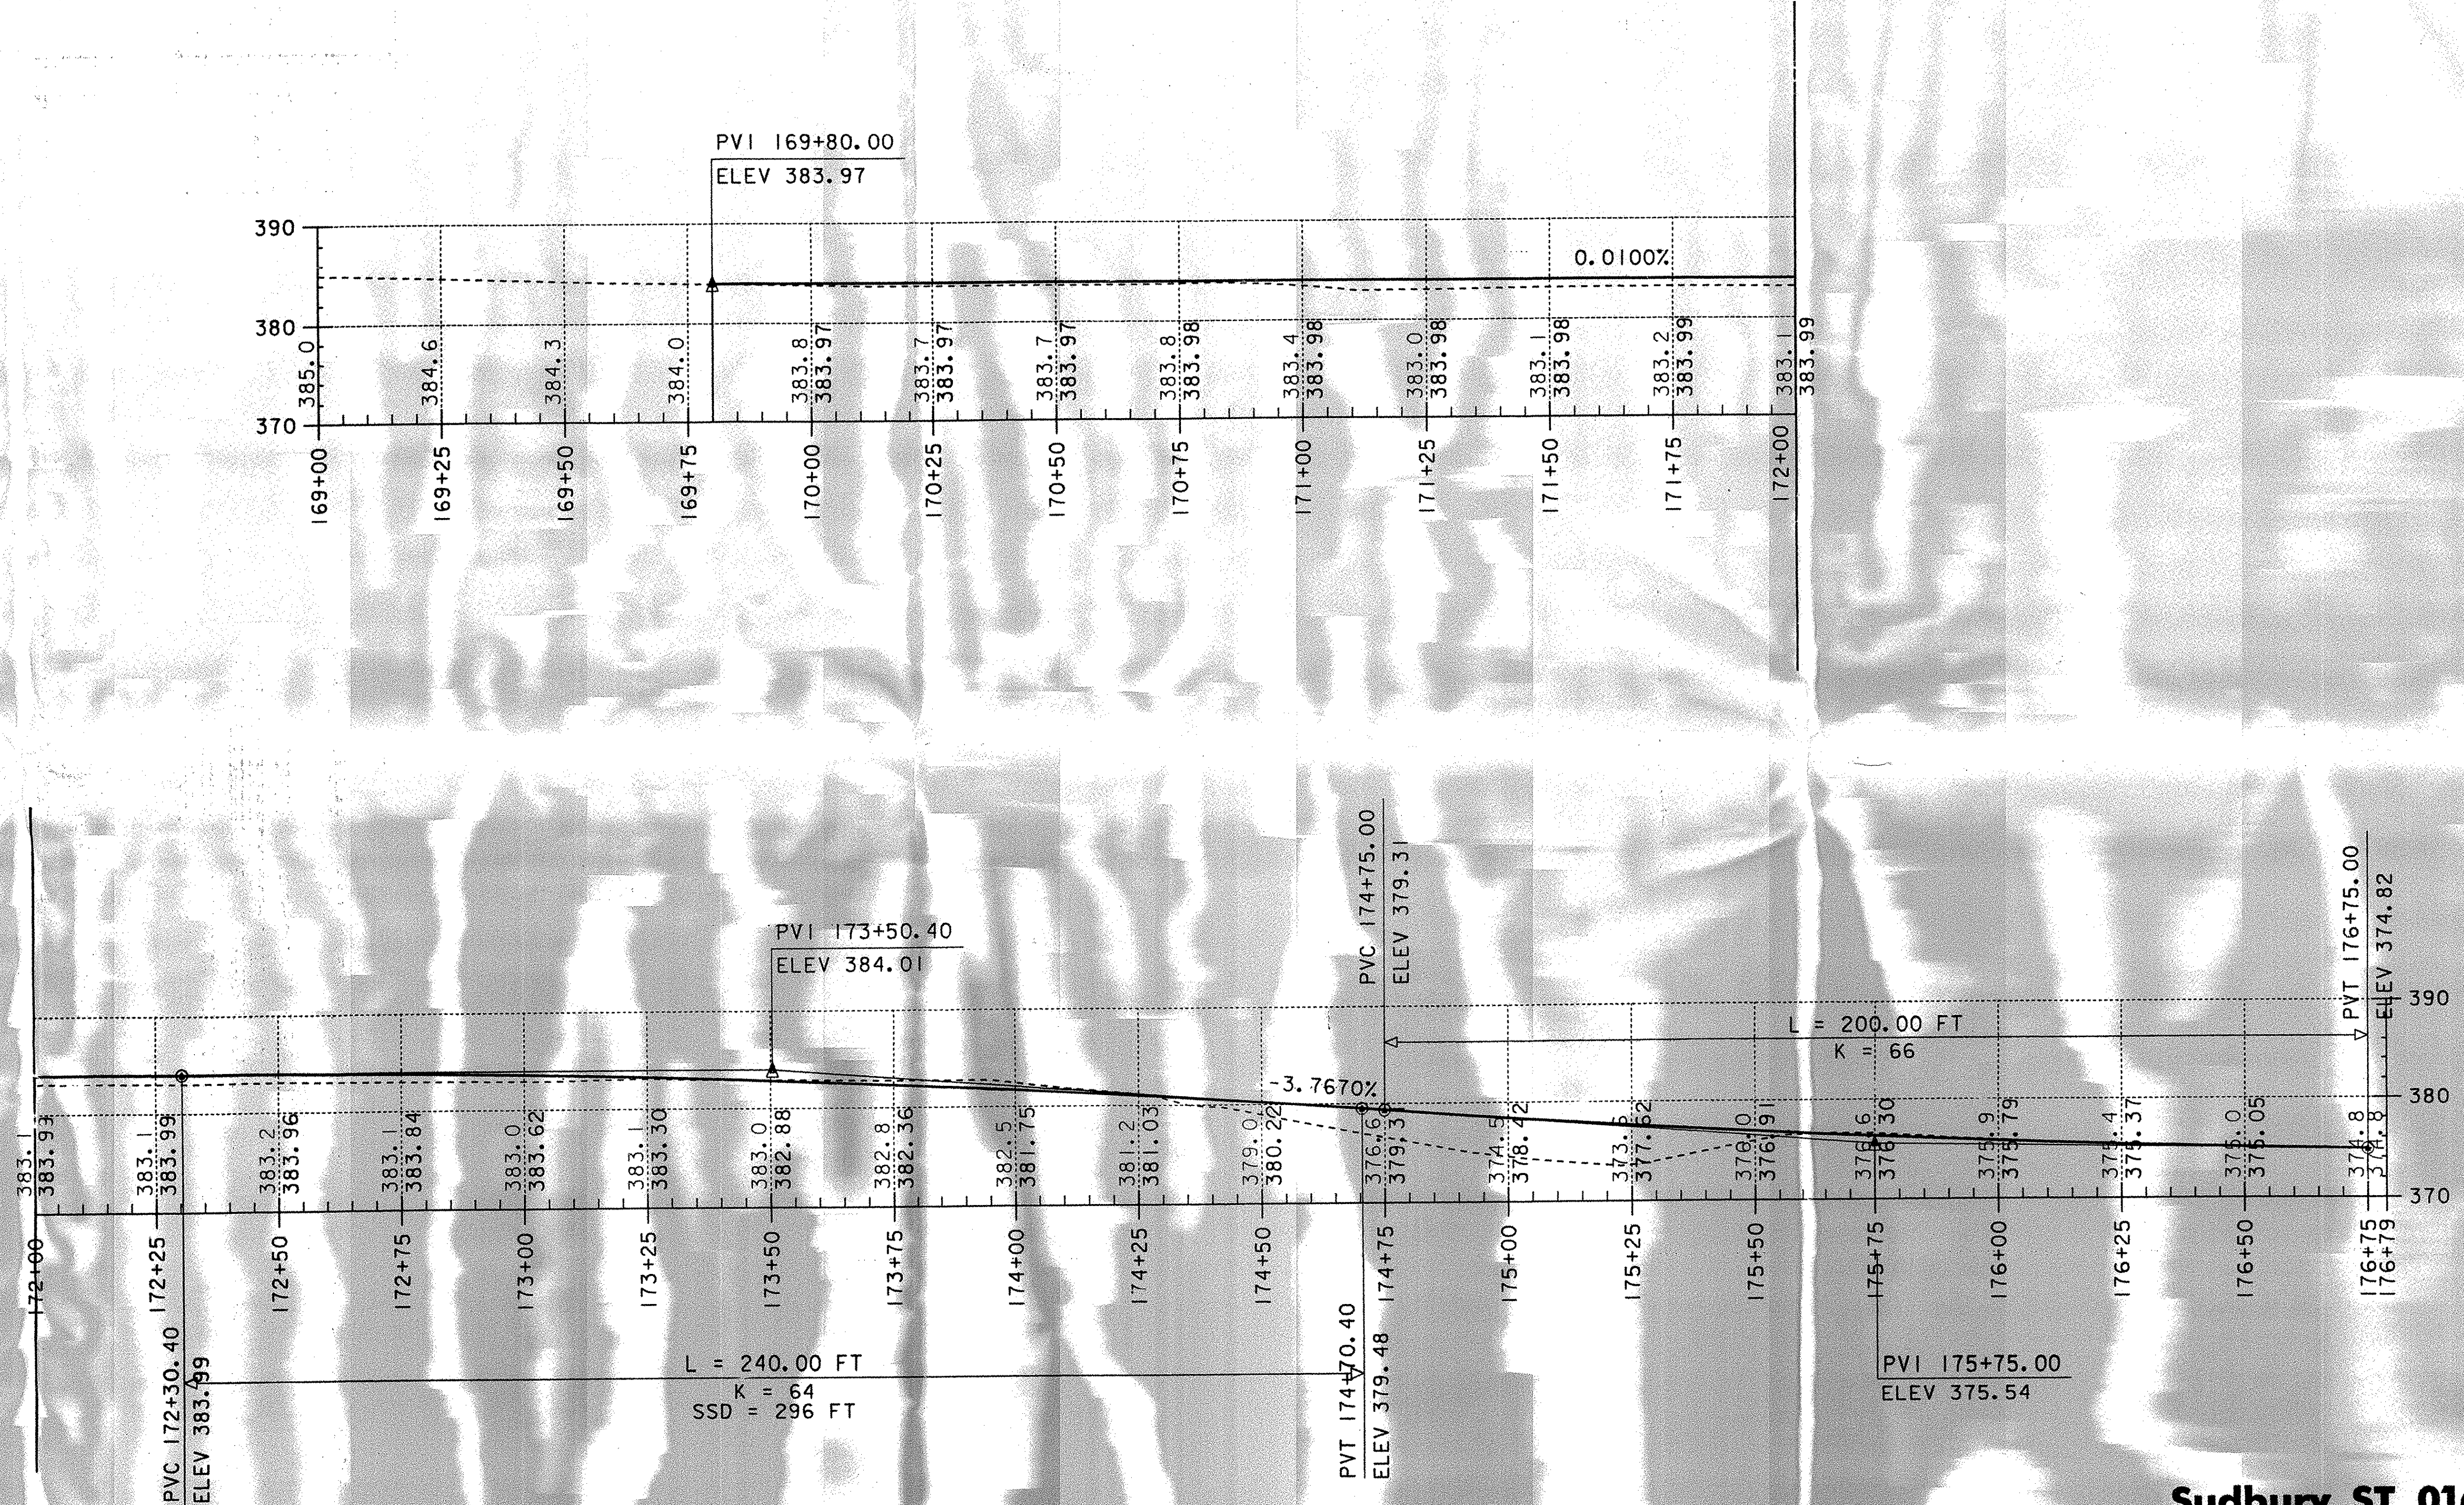

Sudbury ST 0161(10) Detour Profile Sheet

PROJECT NAME:		PLOT DATE: 10-SEP-2002
PROJECT NUMBER:		DRAWN BY:
FILE NAME:		CHECKED BY:
PROJECT LEADER:		SHEET 36 OF
DESIGNED BY:		