
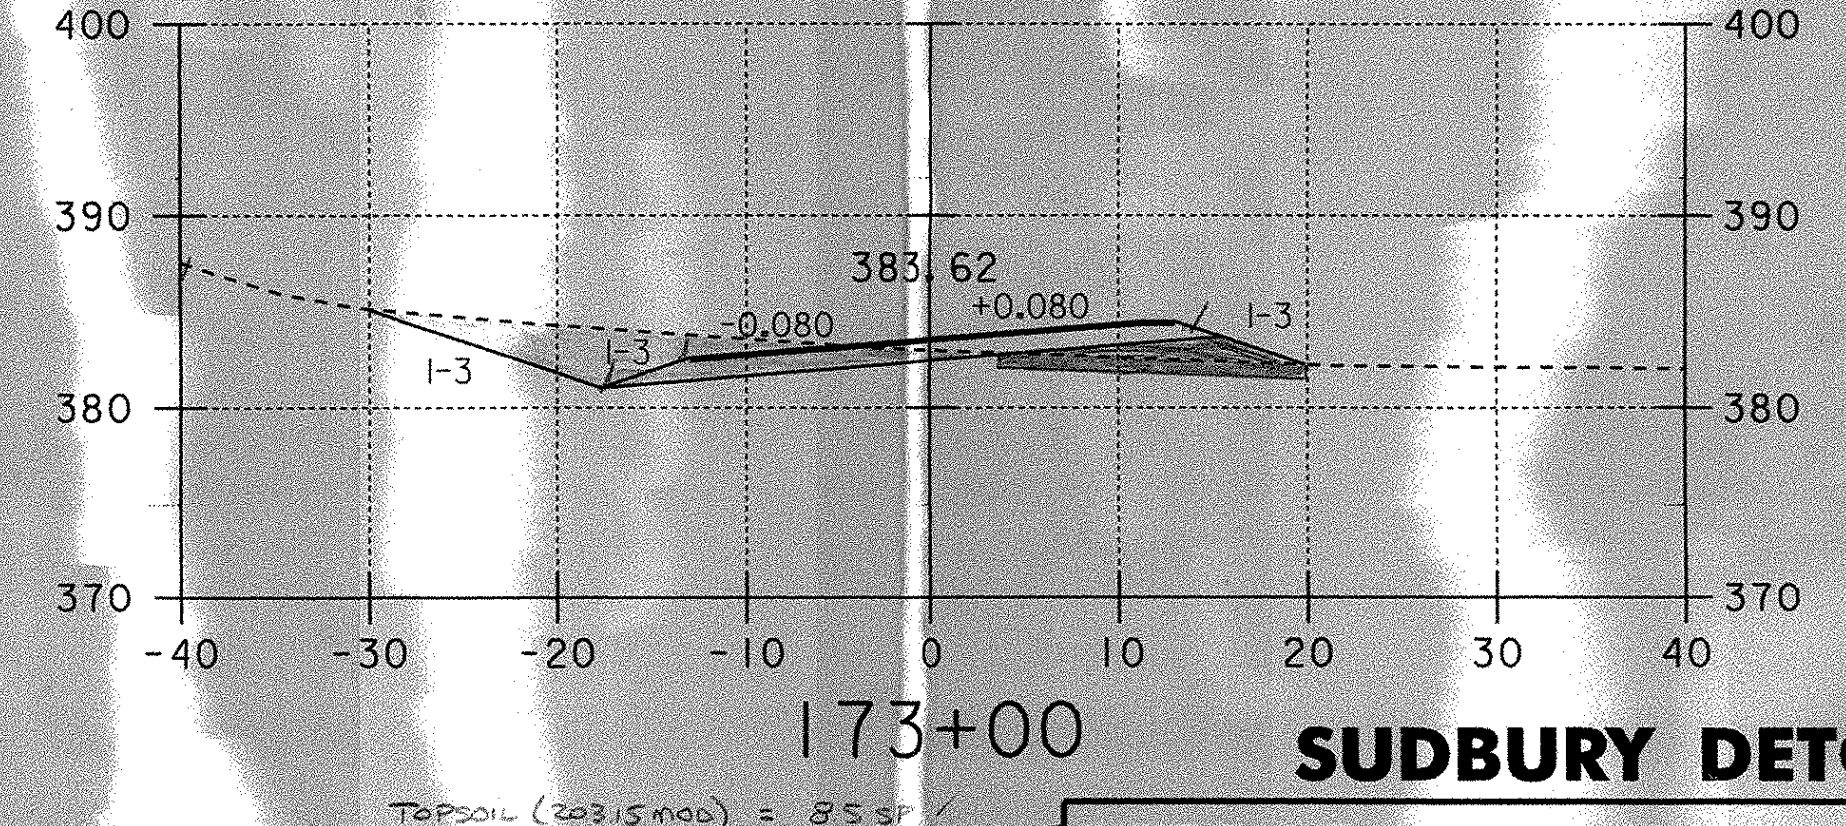
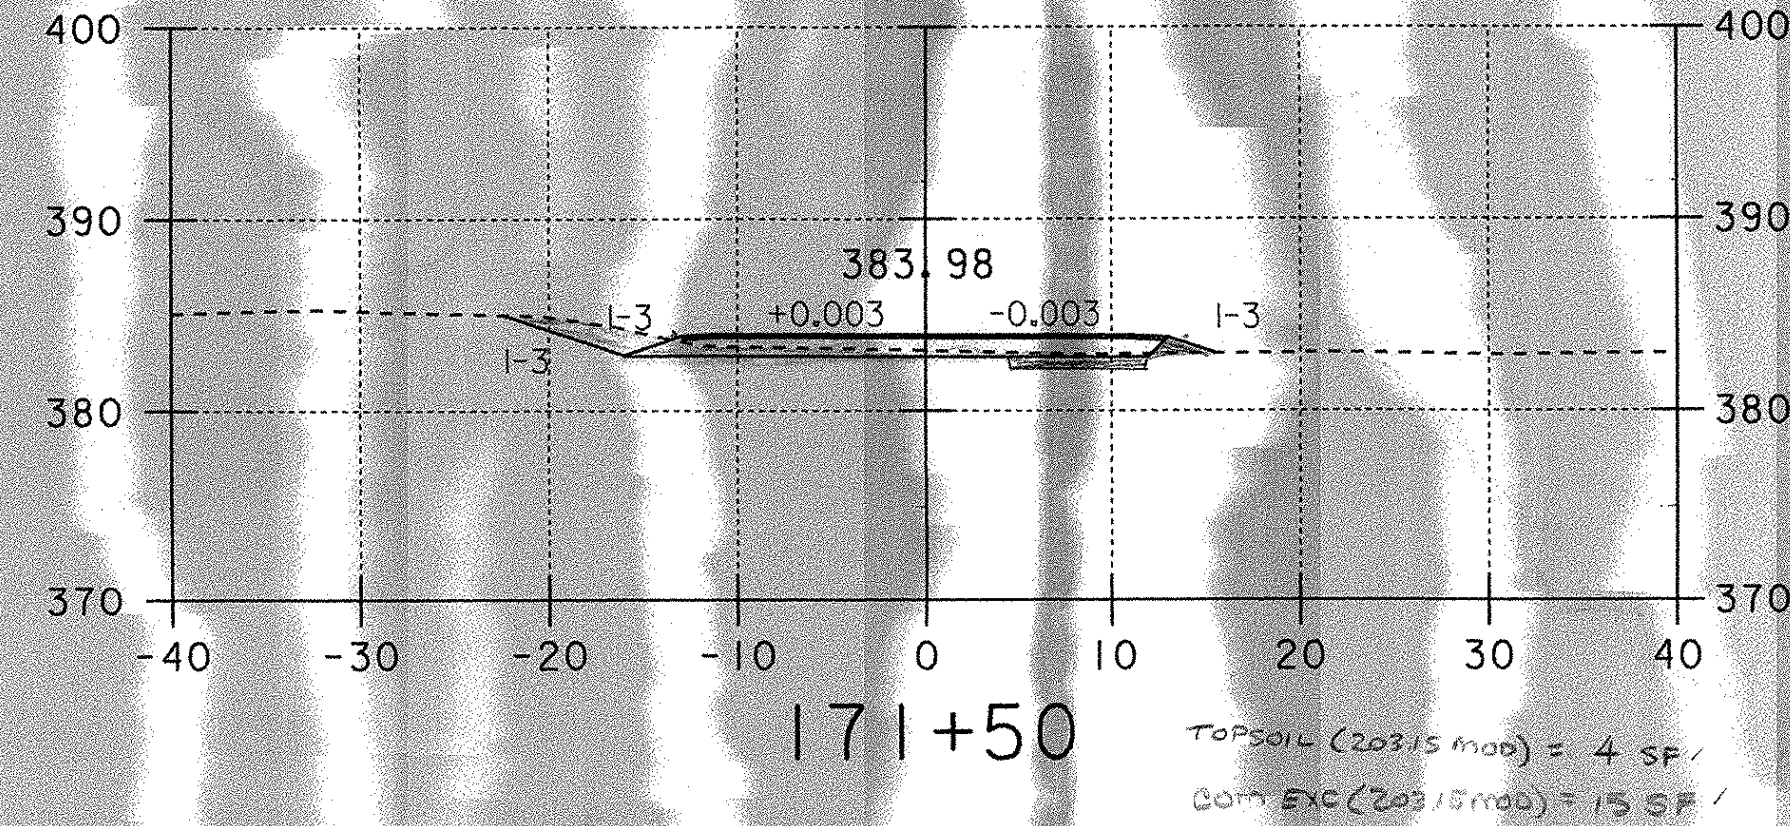
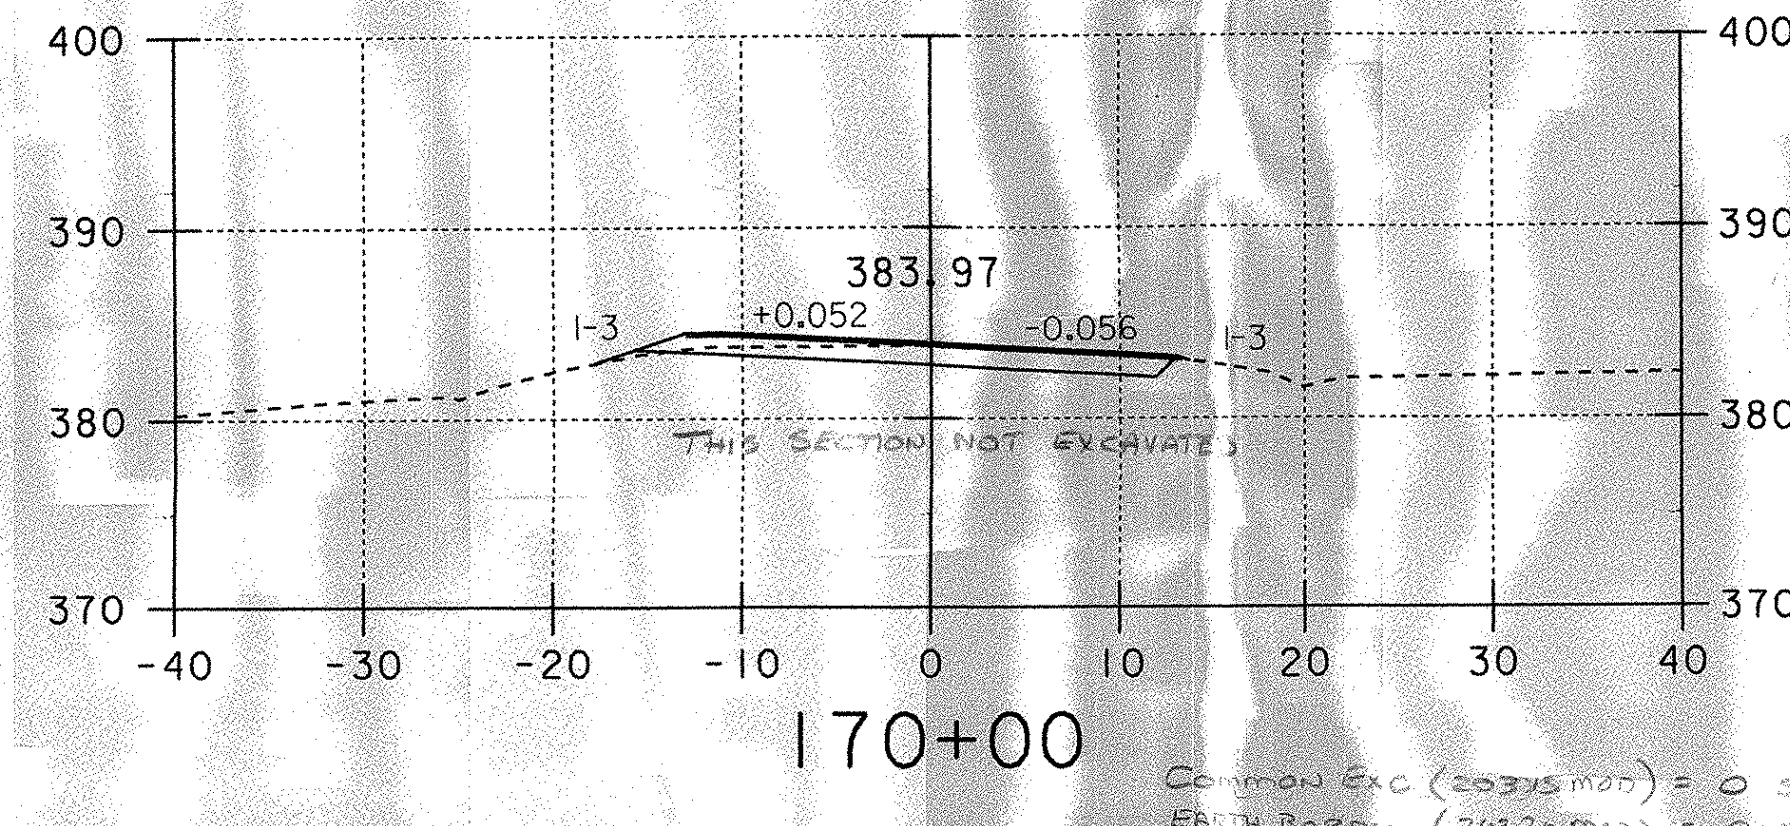
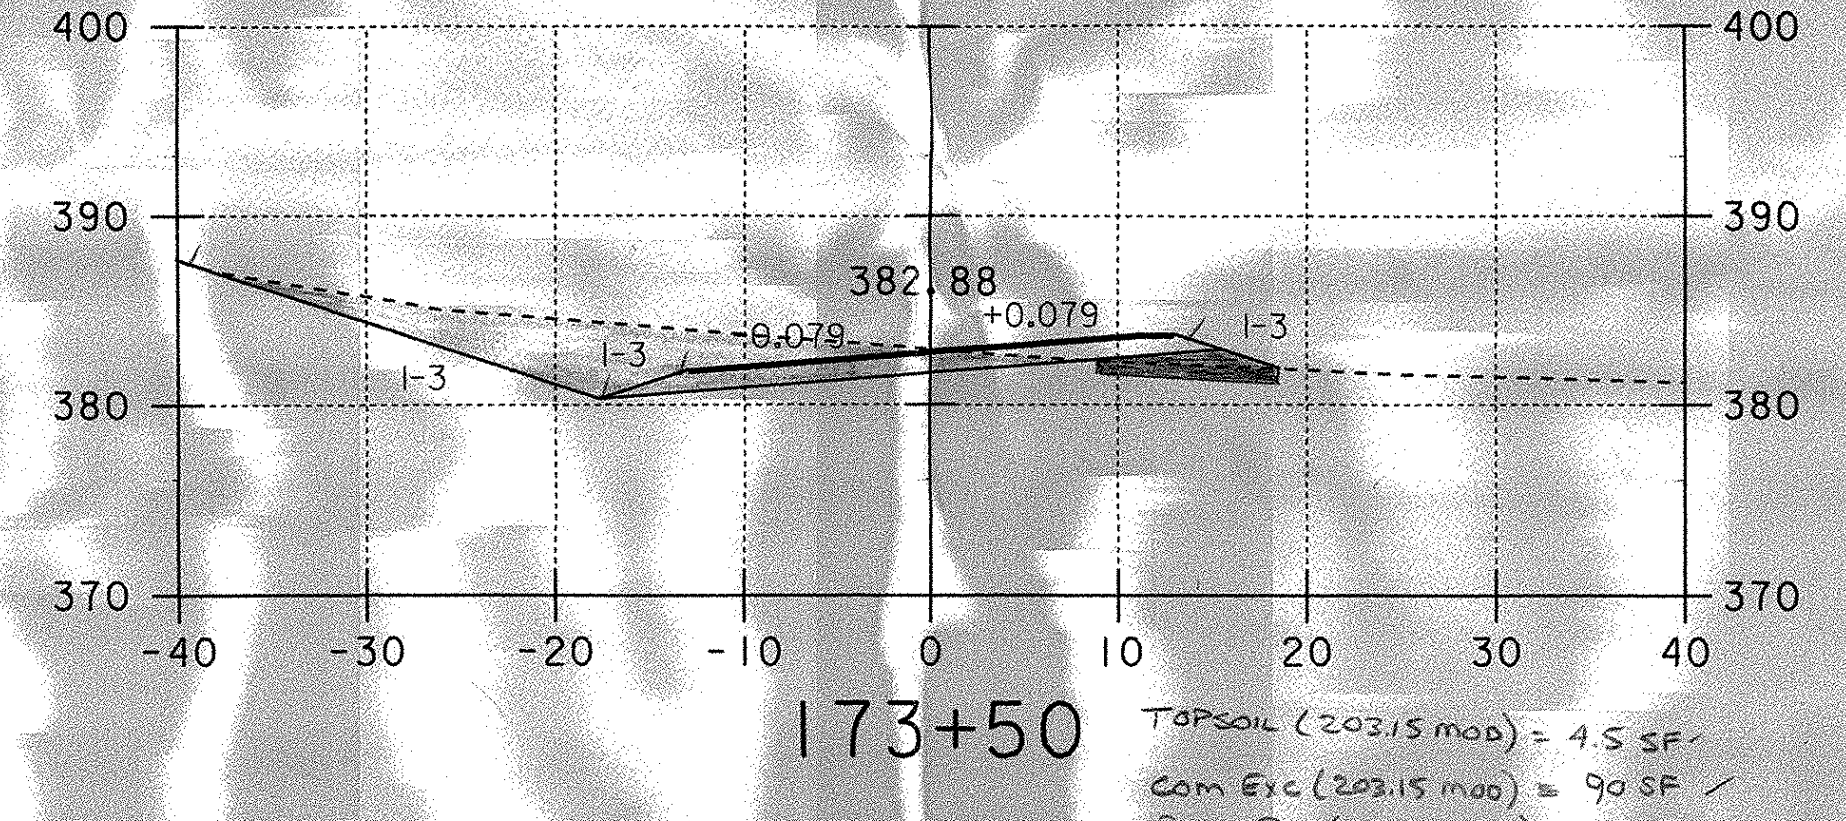
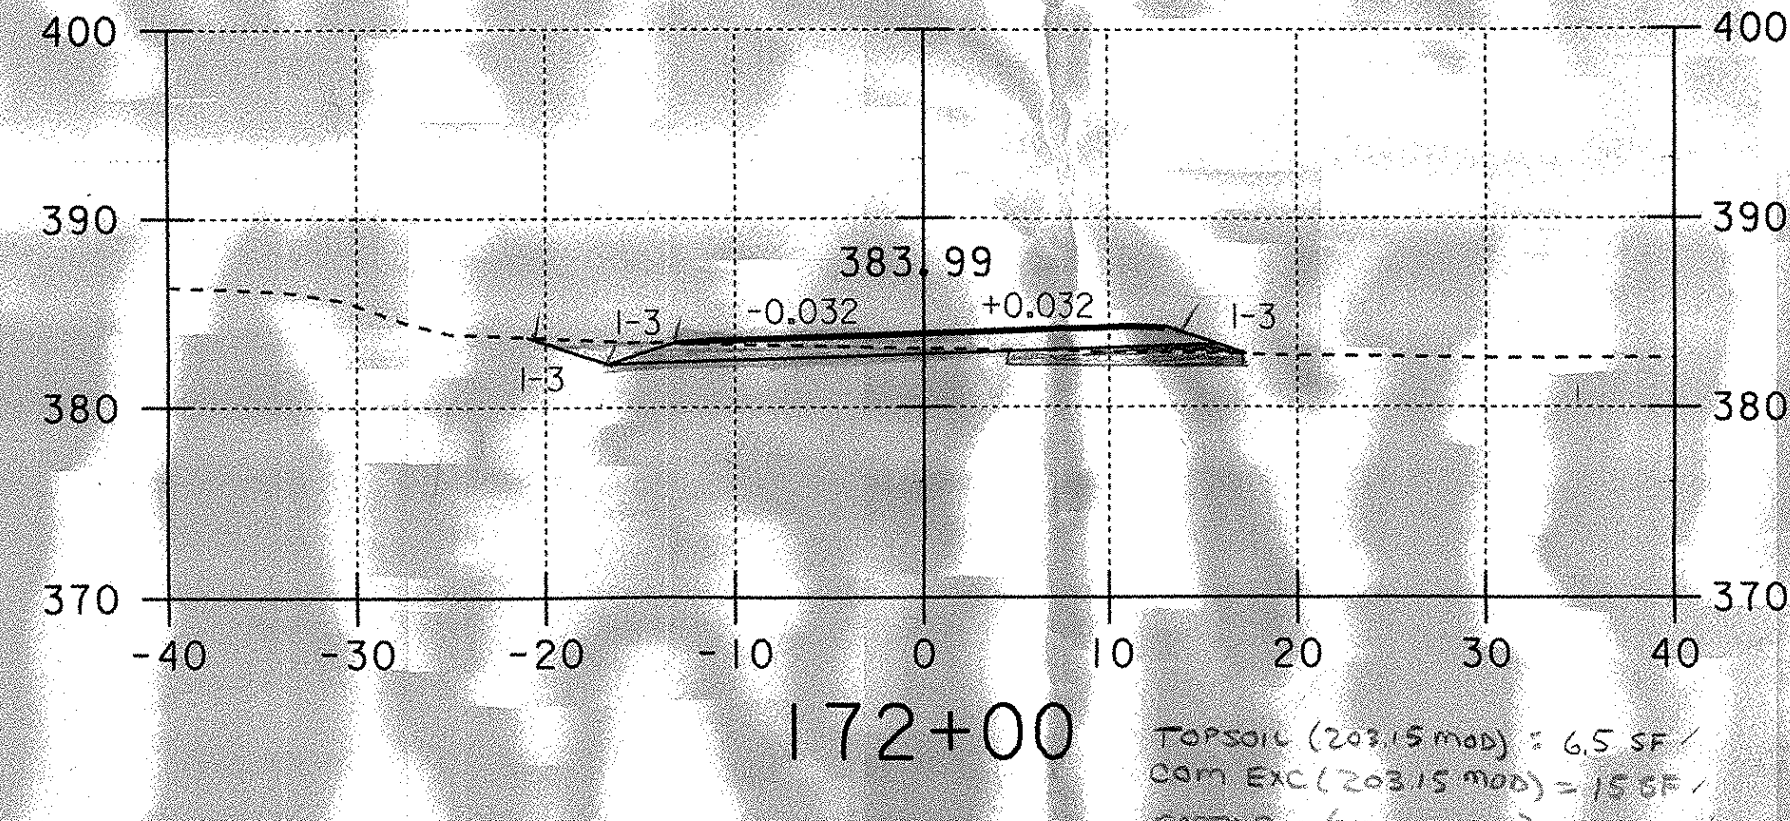
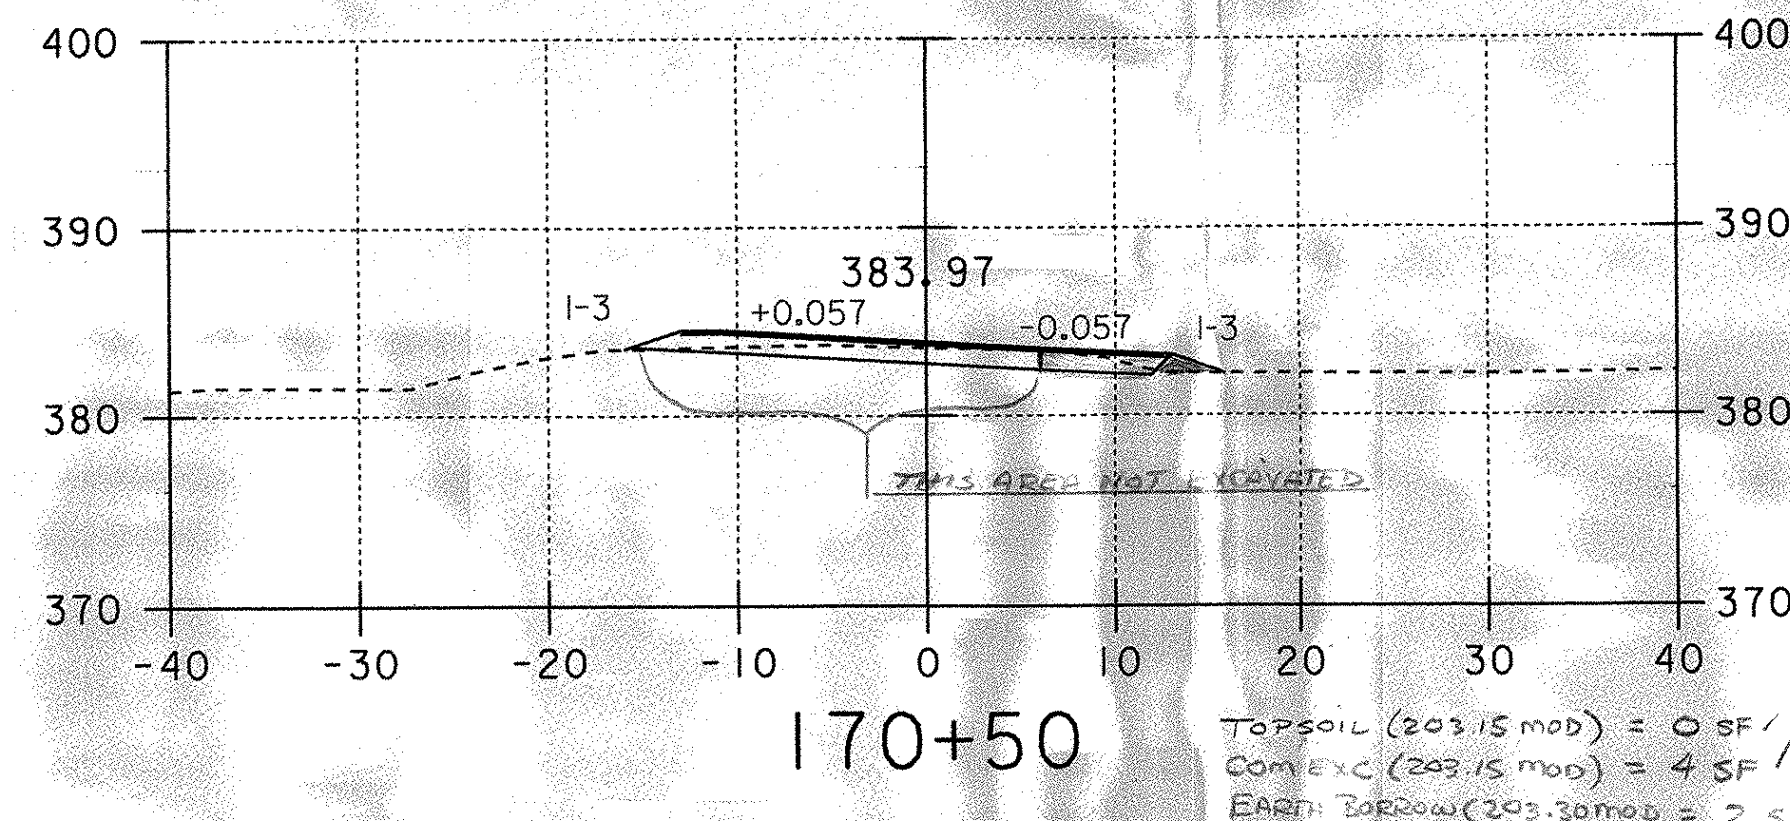
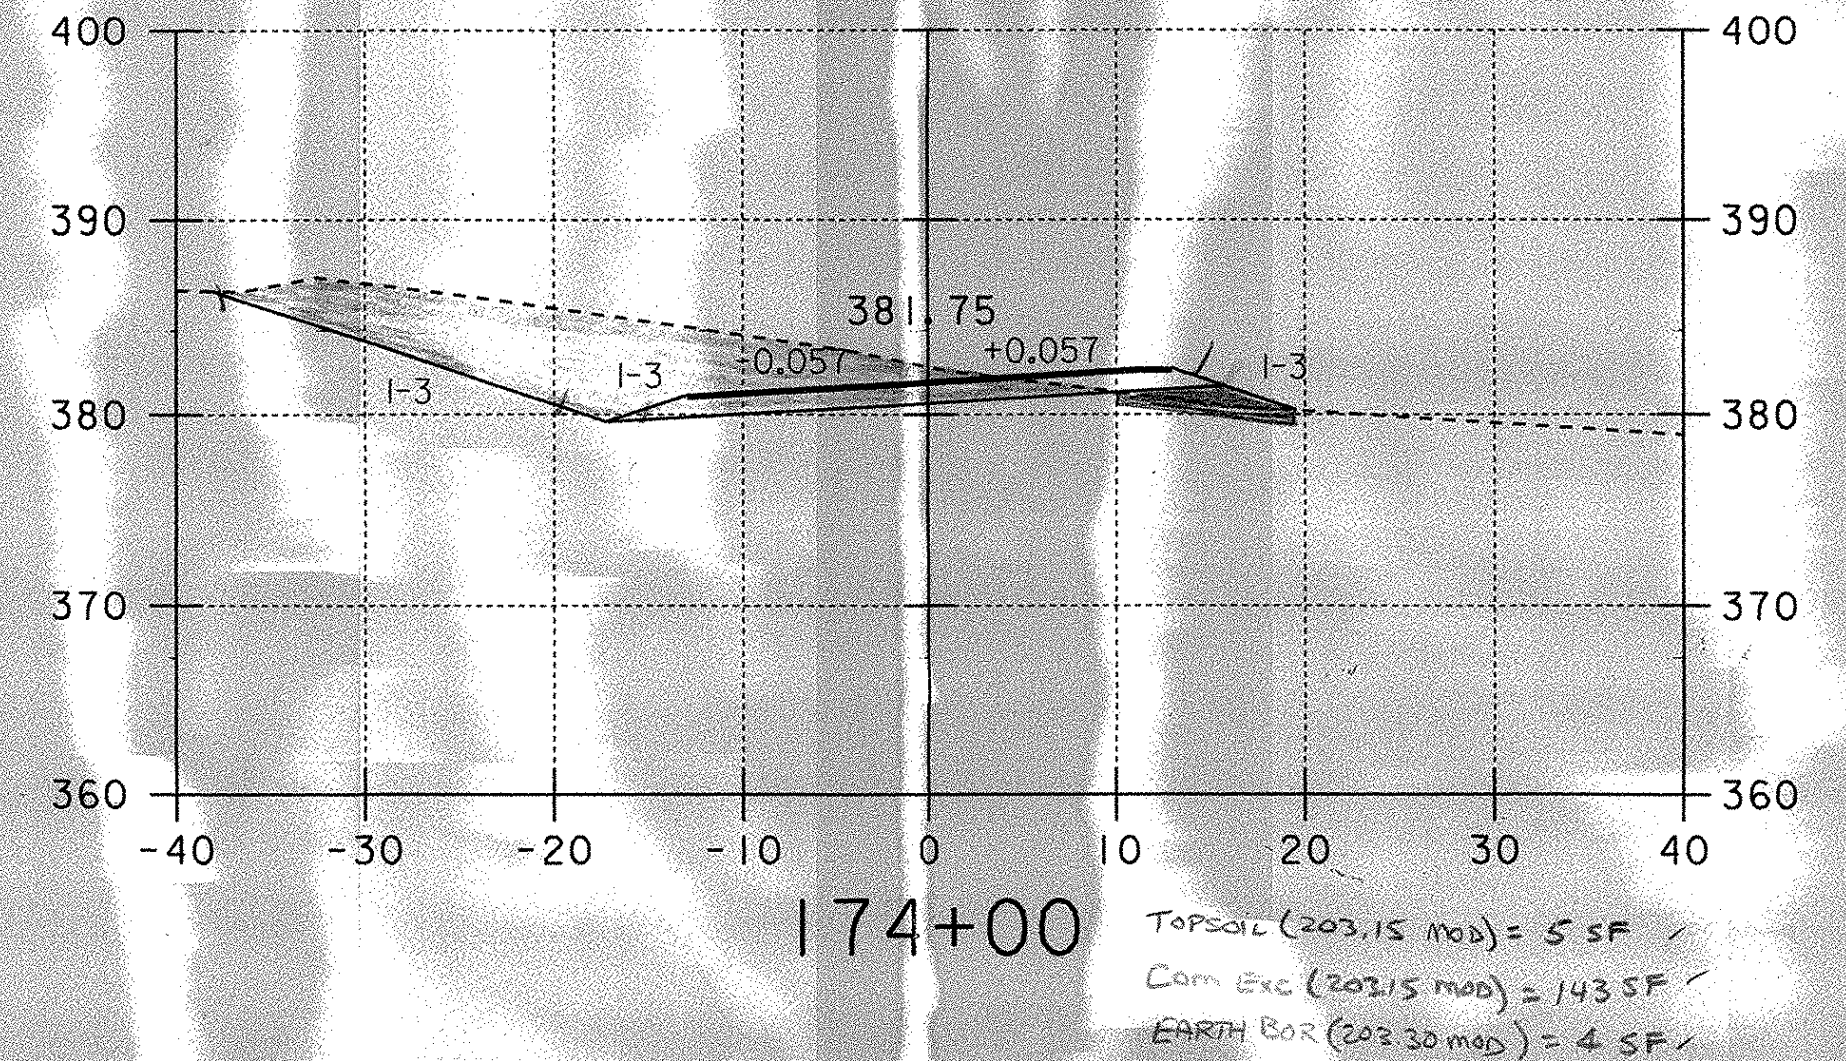
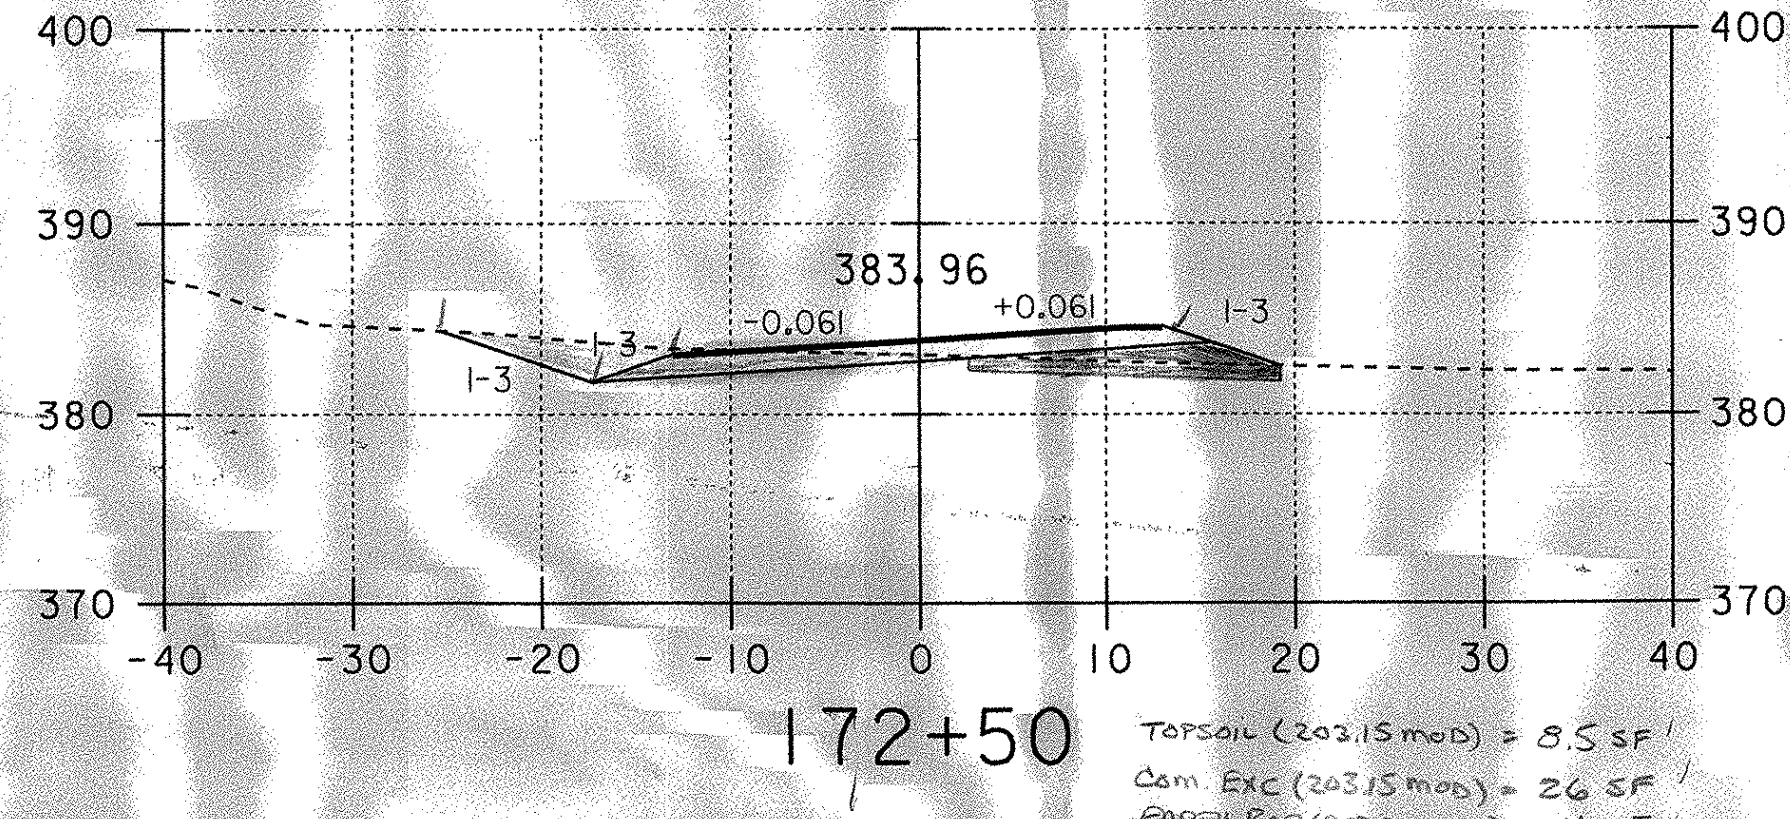


- AUTHORIZED EXCAVATION - TOPSOIL - PAY AS 203.15 (MOD)
- COMMON EXCAVATION - PAY AS 203.15 (MOD)
- EARTH BORROW PAY AS 203.30 (MOD)
- SUBBASE MATERIAL - PAY AS 203.30 (MOD)

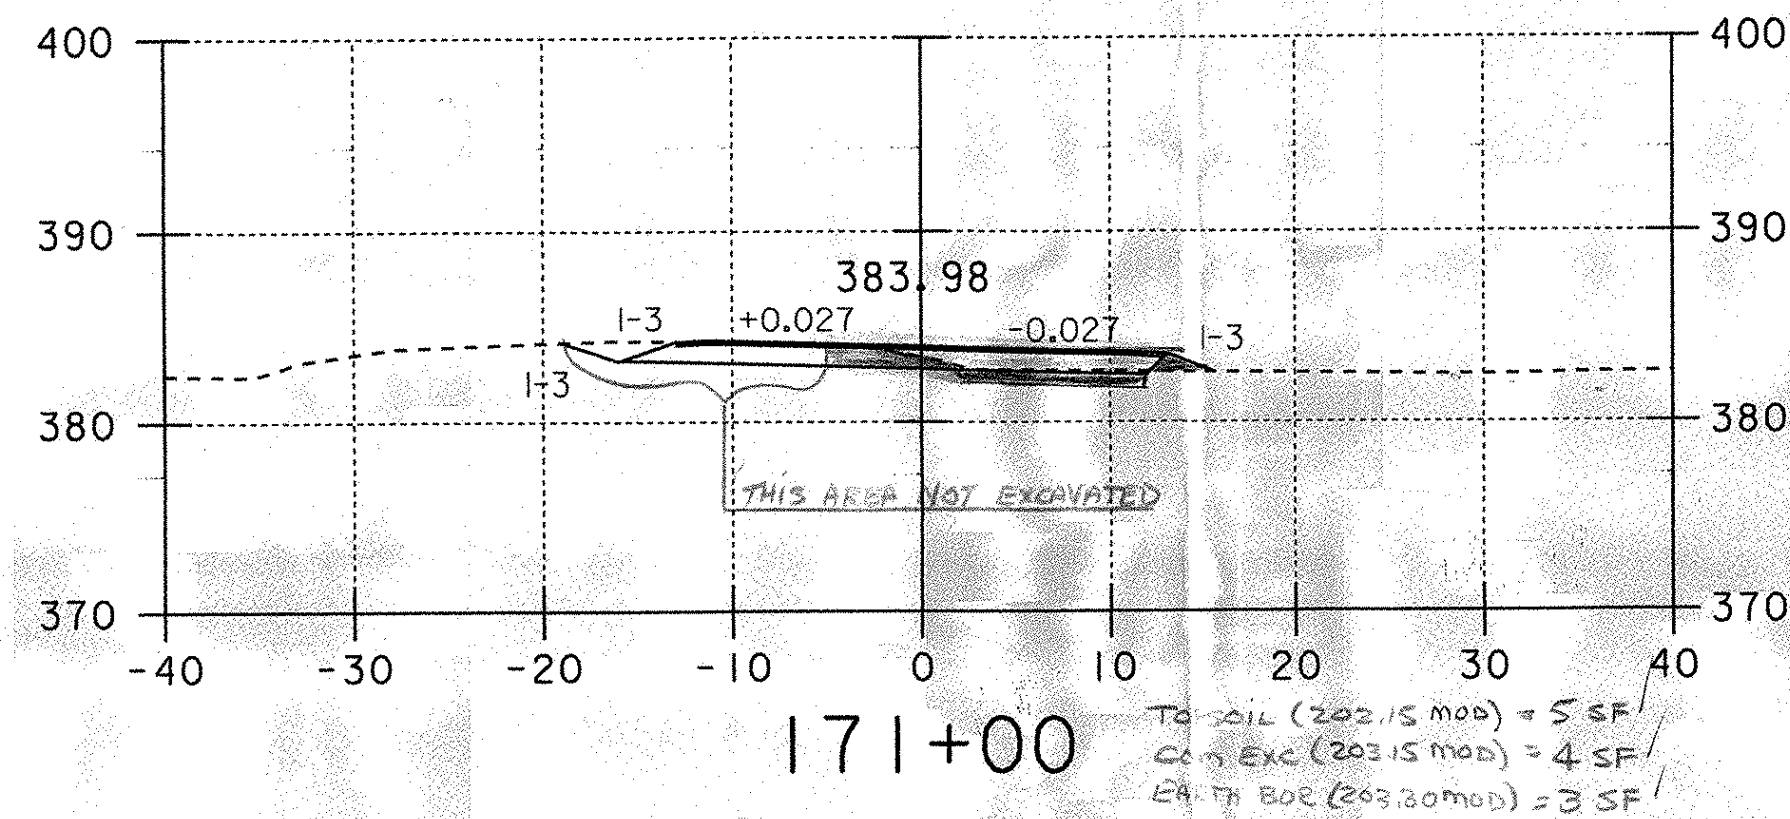

SUBBURY DETOUR SECTIONS

| | |
|-----------------|------------------------|
| PROJECT NAME: | PLOT DATE: 19-SEP-2002 |
| PROJECT NUMBER: | DRAWN BY: |
| FILE NAME: | CHECKED BY: |
| PROJECT LEADER: | SHEET 38 OF |
| DESIGNED BY: | |