



SEE SHEET 2 FOR
INDEX OF SHEETS AND
LIST OF STANDARDS

STATE OF VERMONT AGENCY OF TRANSPORTATION

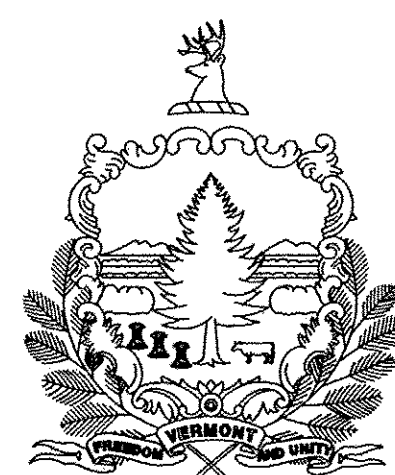

PROPOSED IMPROVEMENT BRIDGE PROJECT TOWN OF EAST HAVEN COUNTY OF ESSEX STATE ROUTE 114 - MAJOR COLLECTOR BRIDGE NO. 18

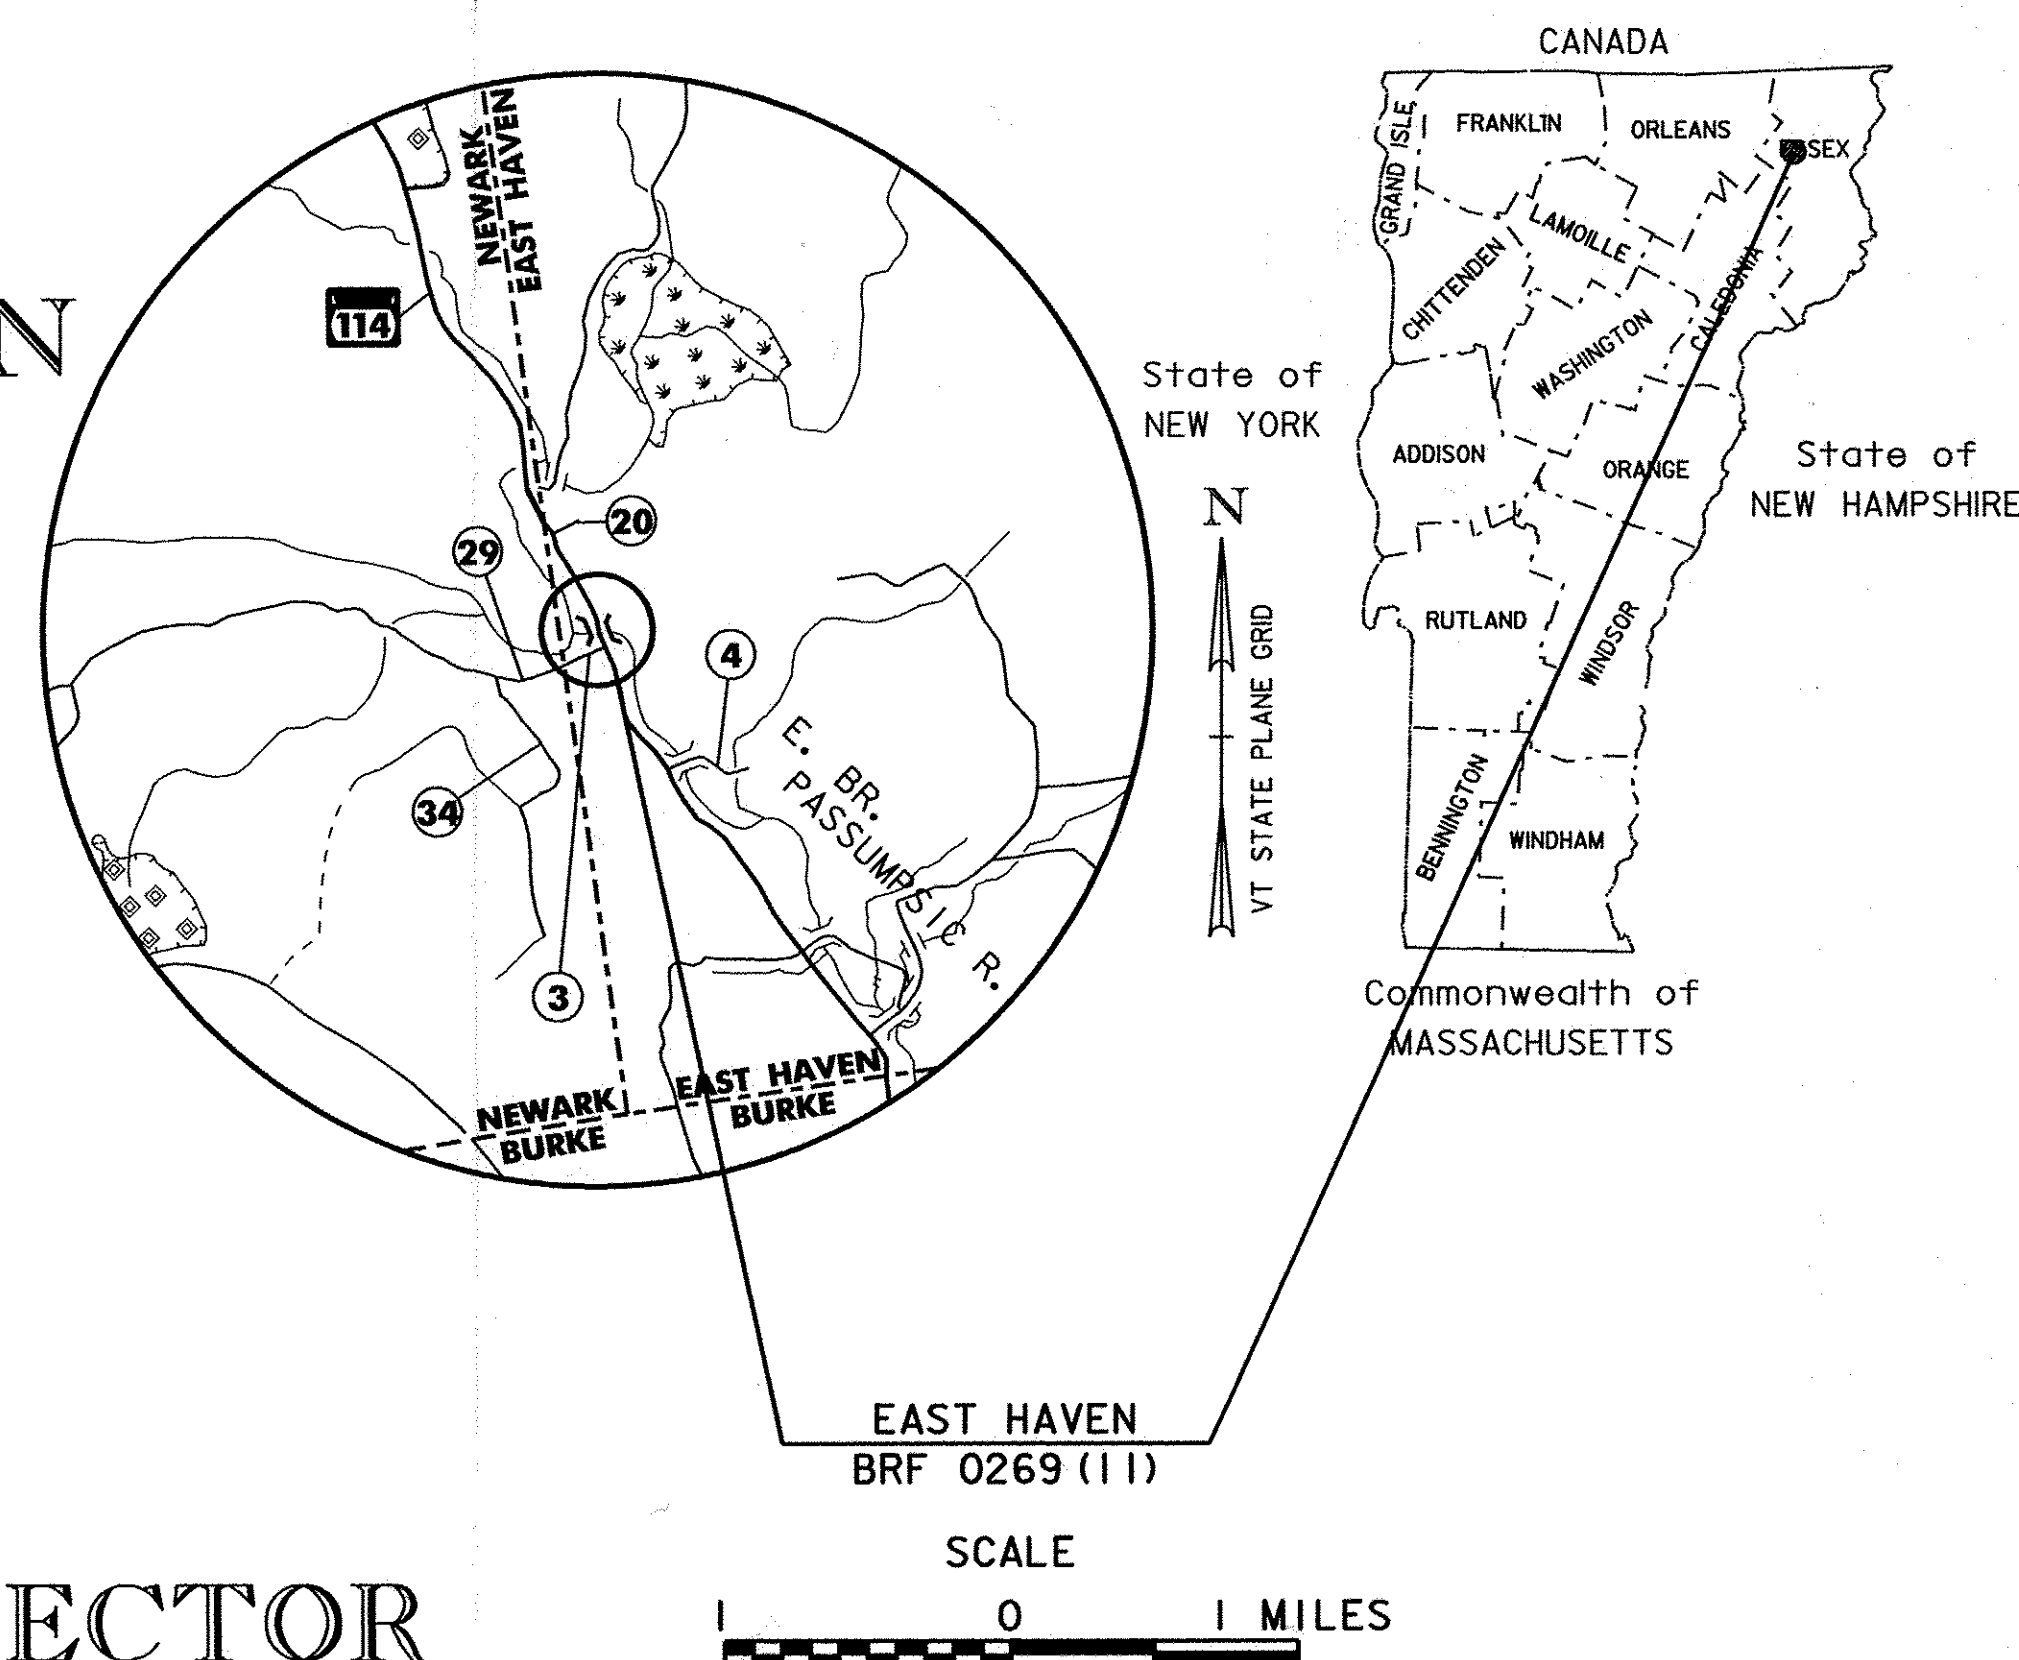


RECORD PLANS	
CONTRACTOR:	AUSTIN CONSTRUCTION, INC. - CONCORD, VT
RESIDENT ENGINEER:	DOUG BUMPS
CONSTRUCTION BEGAN:	APRIL 23, 2012
CONSTRUCTION COMPLETE:	
RECORD PLANS BY:	DOUG BUMPS & C. PIERCE
I HEREBY CERTIFY THAT ALL THE CONSTRUCTION REQUIRED BY THIS SET OF DRAWINGS HAS BEEN ACCOMPLISHED AS INDICATED HEREIN.	
BY	<i>Douglas Bumps</i> RESIDENT ENGINEER
DATE	5/23/12
NOTE: Any further information concerning final quantities, amounts or other details relative to this project may be found at Central Files in the electronic archives.	

PROJECT LOCATION: BEGINNING AT MILE POST 1.827 ON VT 114 IN EAST HAVEN, CROSSING THE PASSUMPSIC RIVER AND ENDING AT MILE POST 1.860.

PROJECT DESCRIPTION: THIS PROJECT SHALL CONSIST OF THE REPLACEMENT OF THE EXISTING STRUCTURE WITH RELATED APPROACH WORK.

LENGTH OF BRIDGE: 70.00 FEET
LENGTH OF ROADWAY: 100.00 FEET
LENGTH OF PROJECT: 170.00 FEET

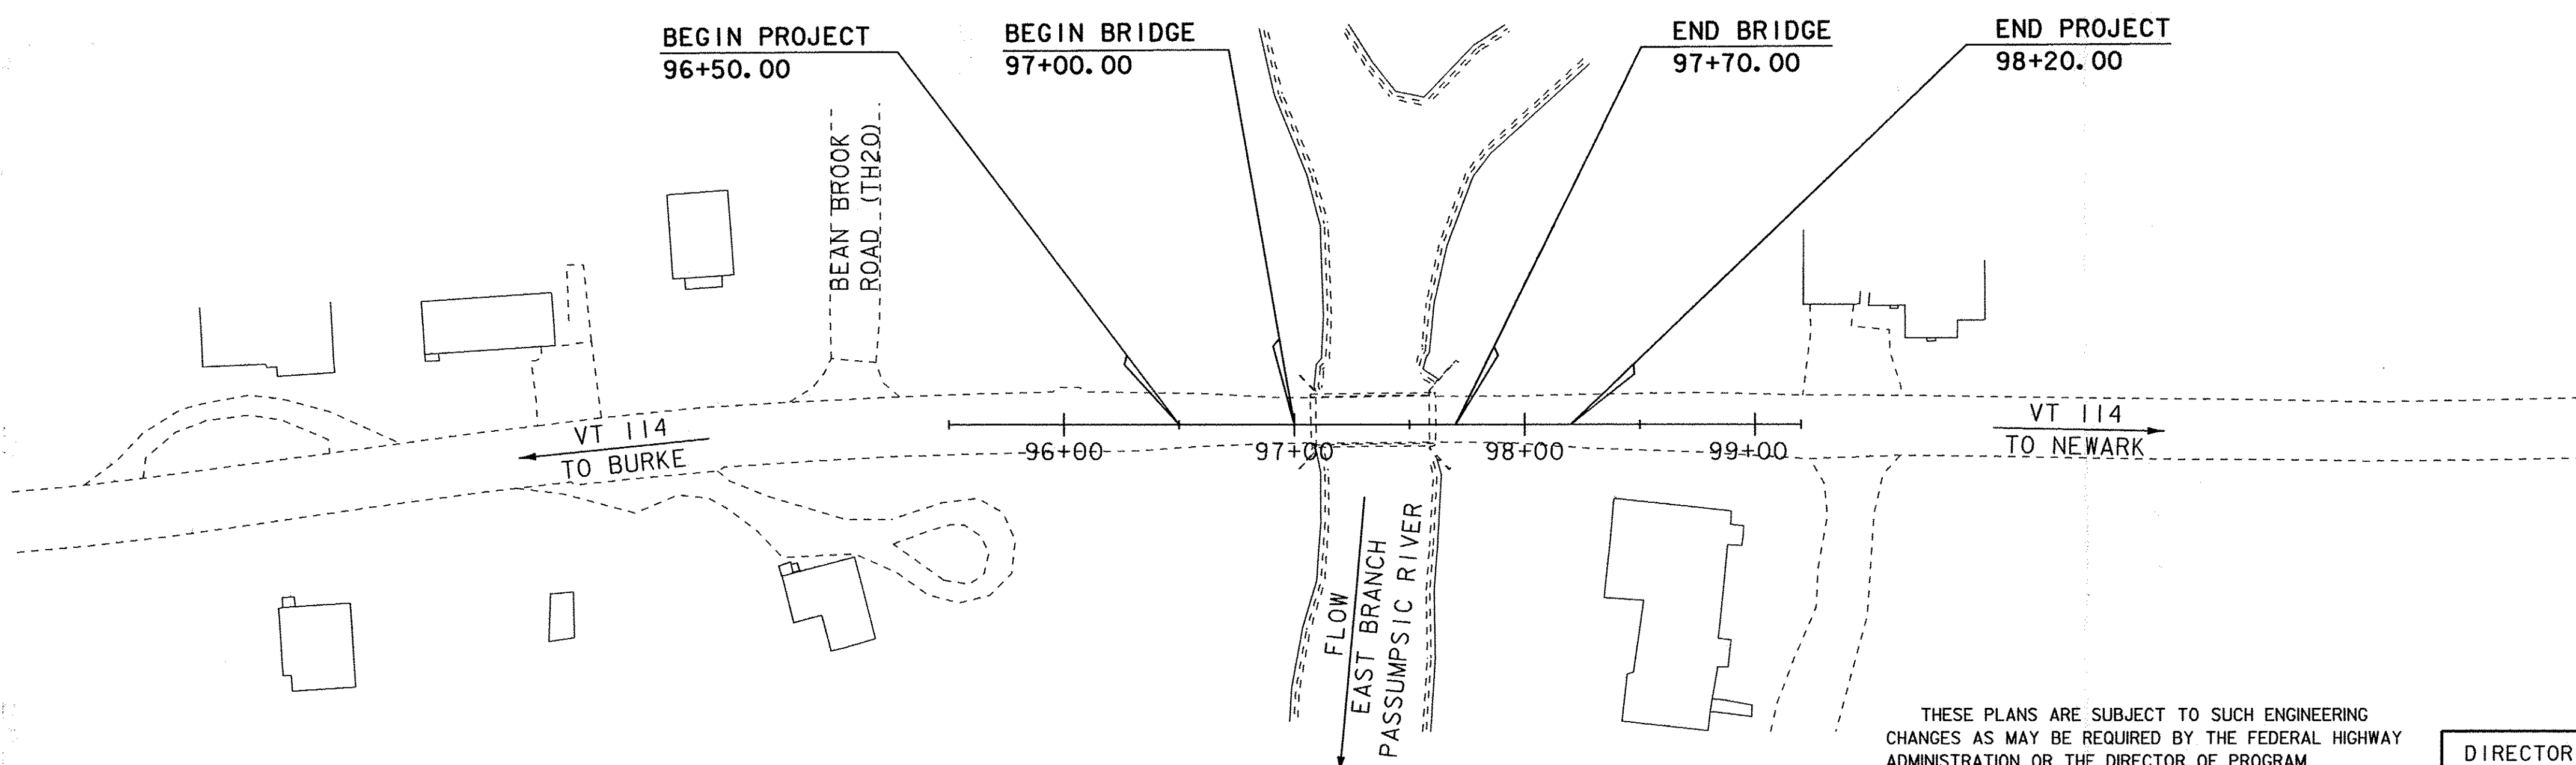

QUALITY ASSURANCE PROGRAM: LEVEL 2

CONVENTIONAL SYMBOLS

COUNTY LINE	
TOWN LINE	
LIMITS OF ACCESS	
POINT OF ACCESS	
FENCE LINE	
STONE WALL	
TRAVELED WAY	
GUARD RAIL	
RAILROAD	
SURVEY LINE	
CULVERT	
POWER POLE	
TELEPHONE POLE	
TREES	
CONTROL OF ACCESS	
PROPERTY LINE	
R.O.W. TAKING LINE	
SLOPE RIGHTS	
TOP OF CUT	
TOE OF SLOPE	

SURVEYED BY : R. GILMAN
SURVEYED DATE : 11/00

DATUM

VERTICAL NAVD 88
HORIZONTAL NAD 83 (96)

SCALE 1" = 50'-0"
50 0 50

THESE PLANS ARE SUBJECT TO SUCH ENGINEERING CHANGES AS MAY BE REQUIRED BY THE FEDERAL HIGHWAY ADMINISTRATION OR THE DIRECTOR OF PROGRAM DEVELOPMENT.

CONSTRUCTION IS TO BE CARRIED ON IN ACCORDANCE WITH THESE PLANS AND THE STANDARD SPECIFICATIONS FOR CONSTRUCTION DATED 2006, AS APPROVED BY THE FEDERAL HIGHWAY ADMINISTRATION ON JUNE 15, 2006 FOR USE ON THIS PROJECT, INCLUDING ALL SUBSEQUENT REVISIONS AND SUCH REVISED SPECIFICATIONS AND SPECIAL PROVISIONS AS ARE INCORPORATED IN THESE PLANS.

DIRECTOR OF PROGRAM DEVELOPMENT

APPROVED *Rutha Johnson* DATE 8/8/11

PROJECT MANAGER: KRISTIN HIGGINS

PROJECT NAME : EAST HAVEN

PROJECT NUMBER : BRF 0269 (11)

SHEET 1 OF 40 SHEETS