




97+75  
END BRIDGE 97+70

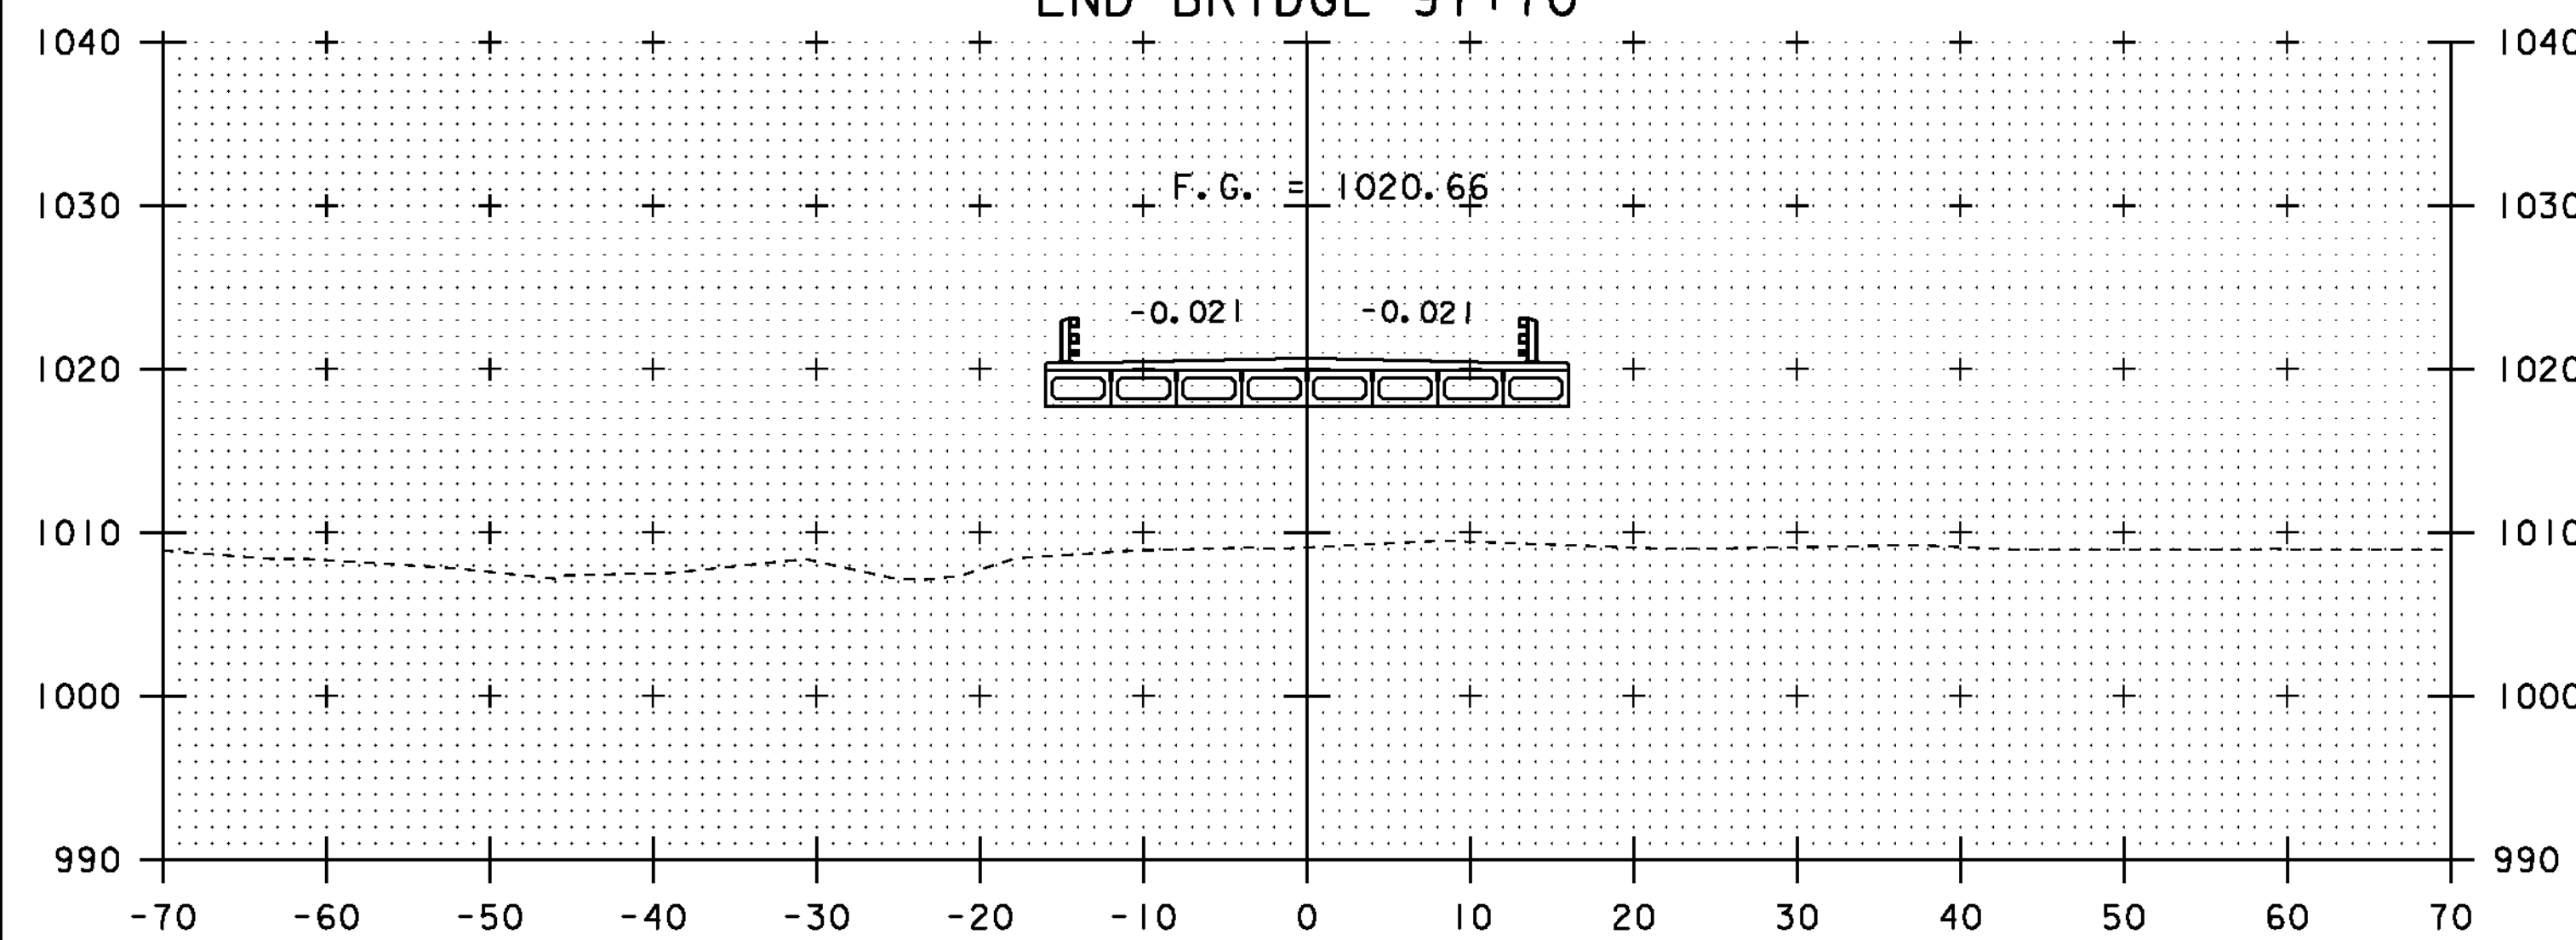


97+50

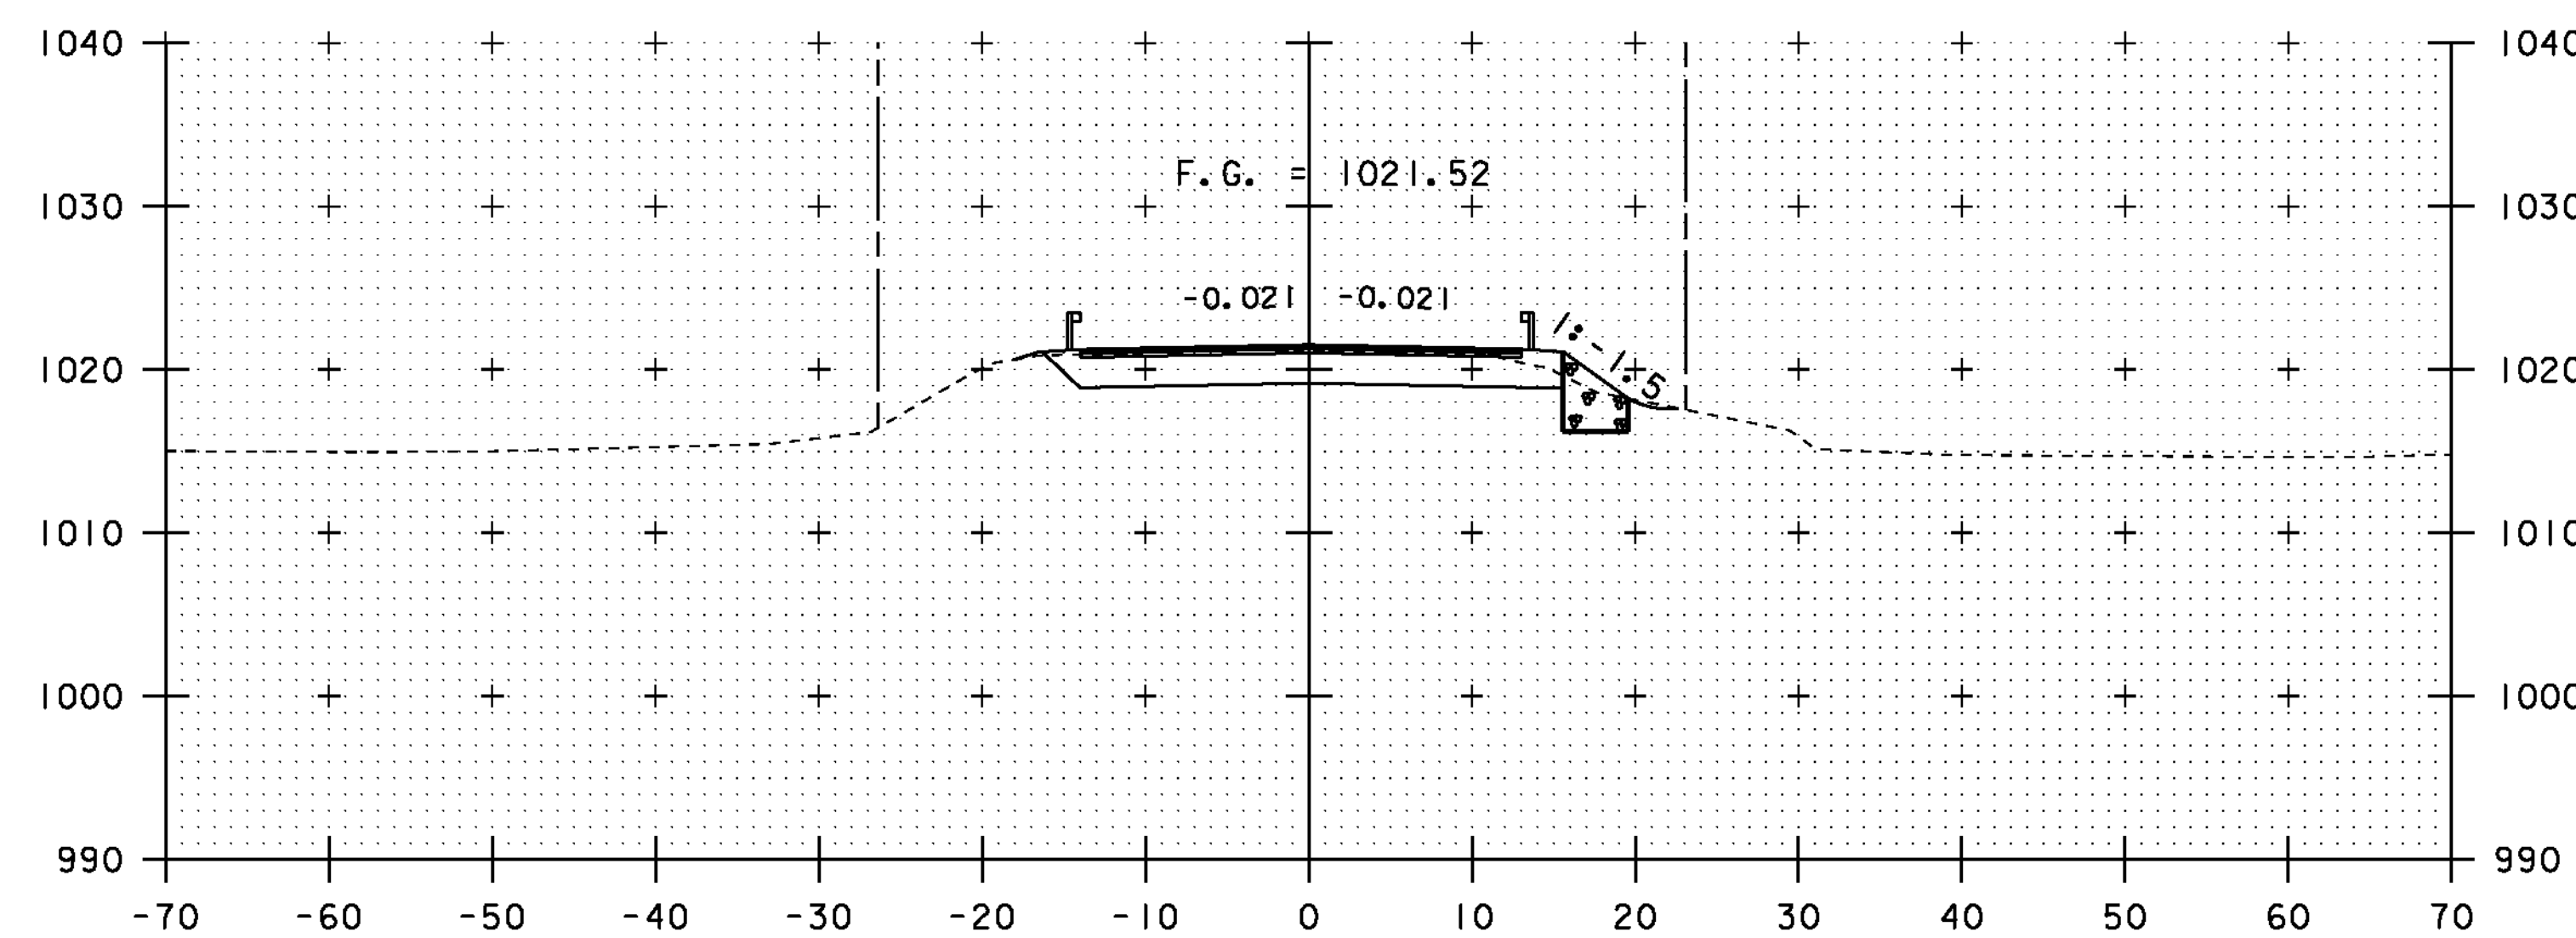

98+25  
END PROJECT 98+20

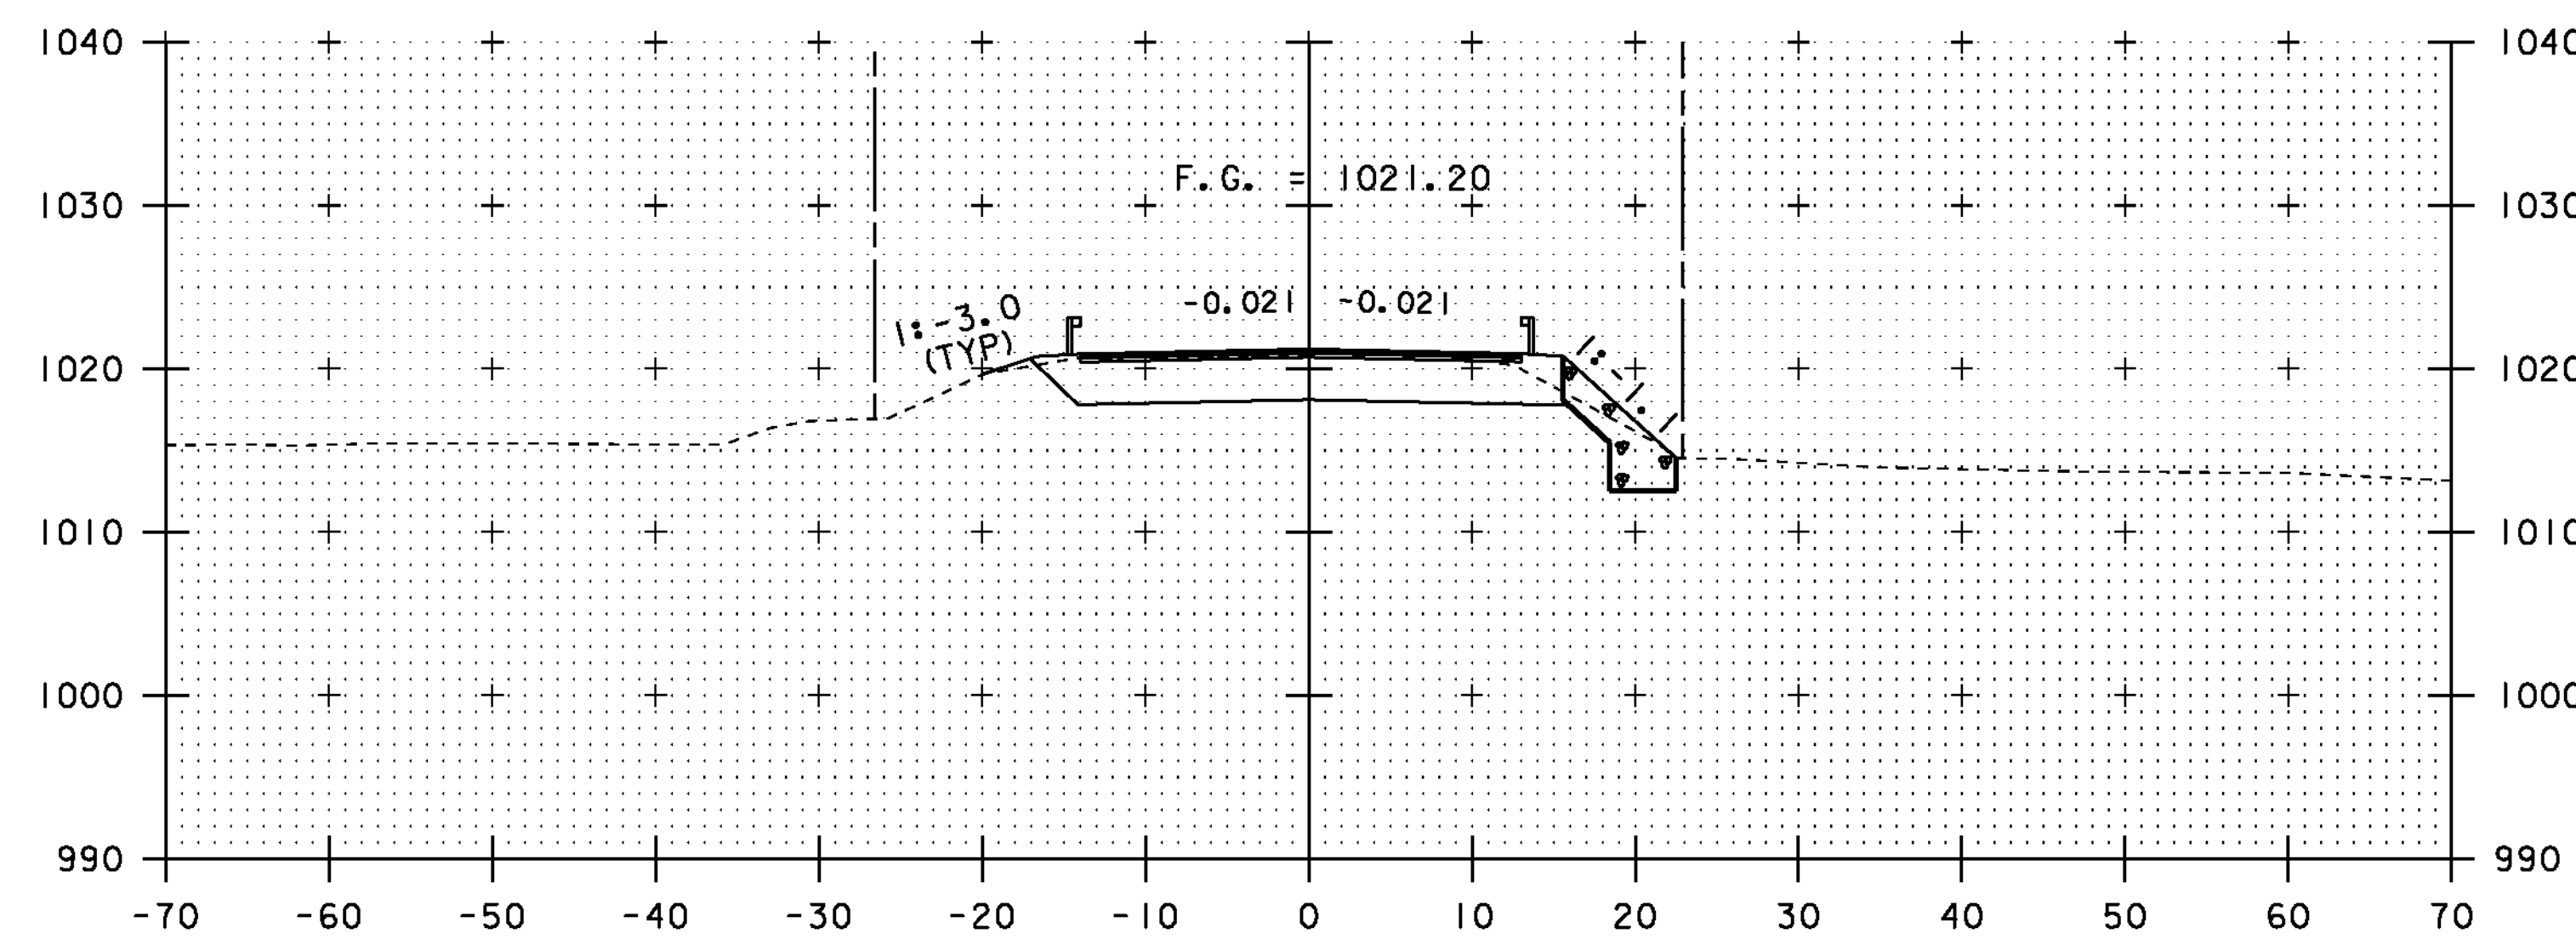

98+00

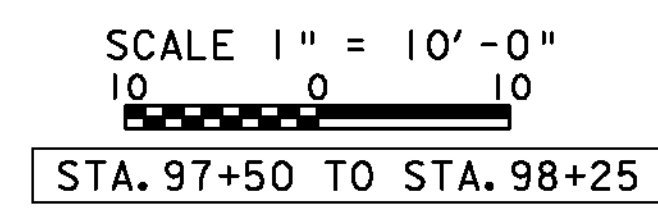

STA. 97+50 TO STA. 98+25

PROJECT NAME: EAST HAVEN	PLOT DATE: 08-AUG-2011
PROJECT NUMBER: BRF 0269(II)	DRAWN BY: R. PELLETT
FILE NAME: s00cl62xs.dgn	CHECKED BY: J. LACROIX
PROJECT LEADER: K. HIGGINS	SHEET 37 OF 40
DESIGNED BY: J. LACROIX	MAINLINE SECTIONS #3