




96+75

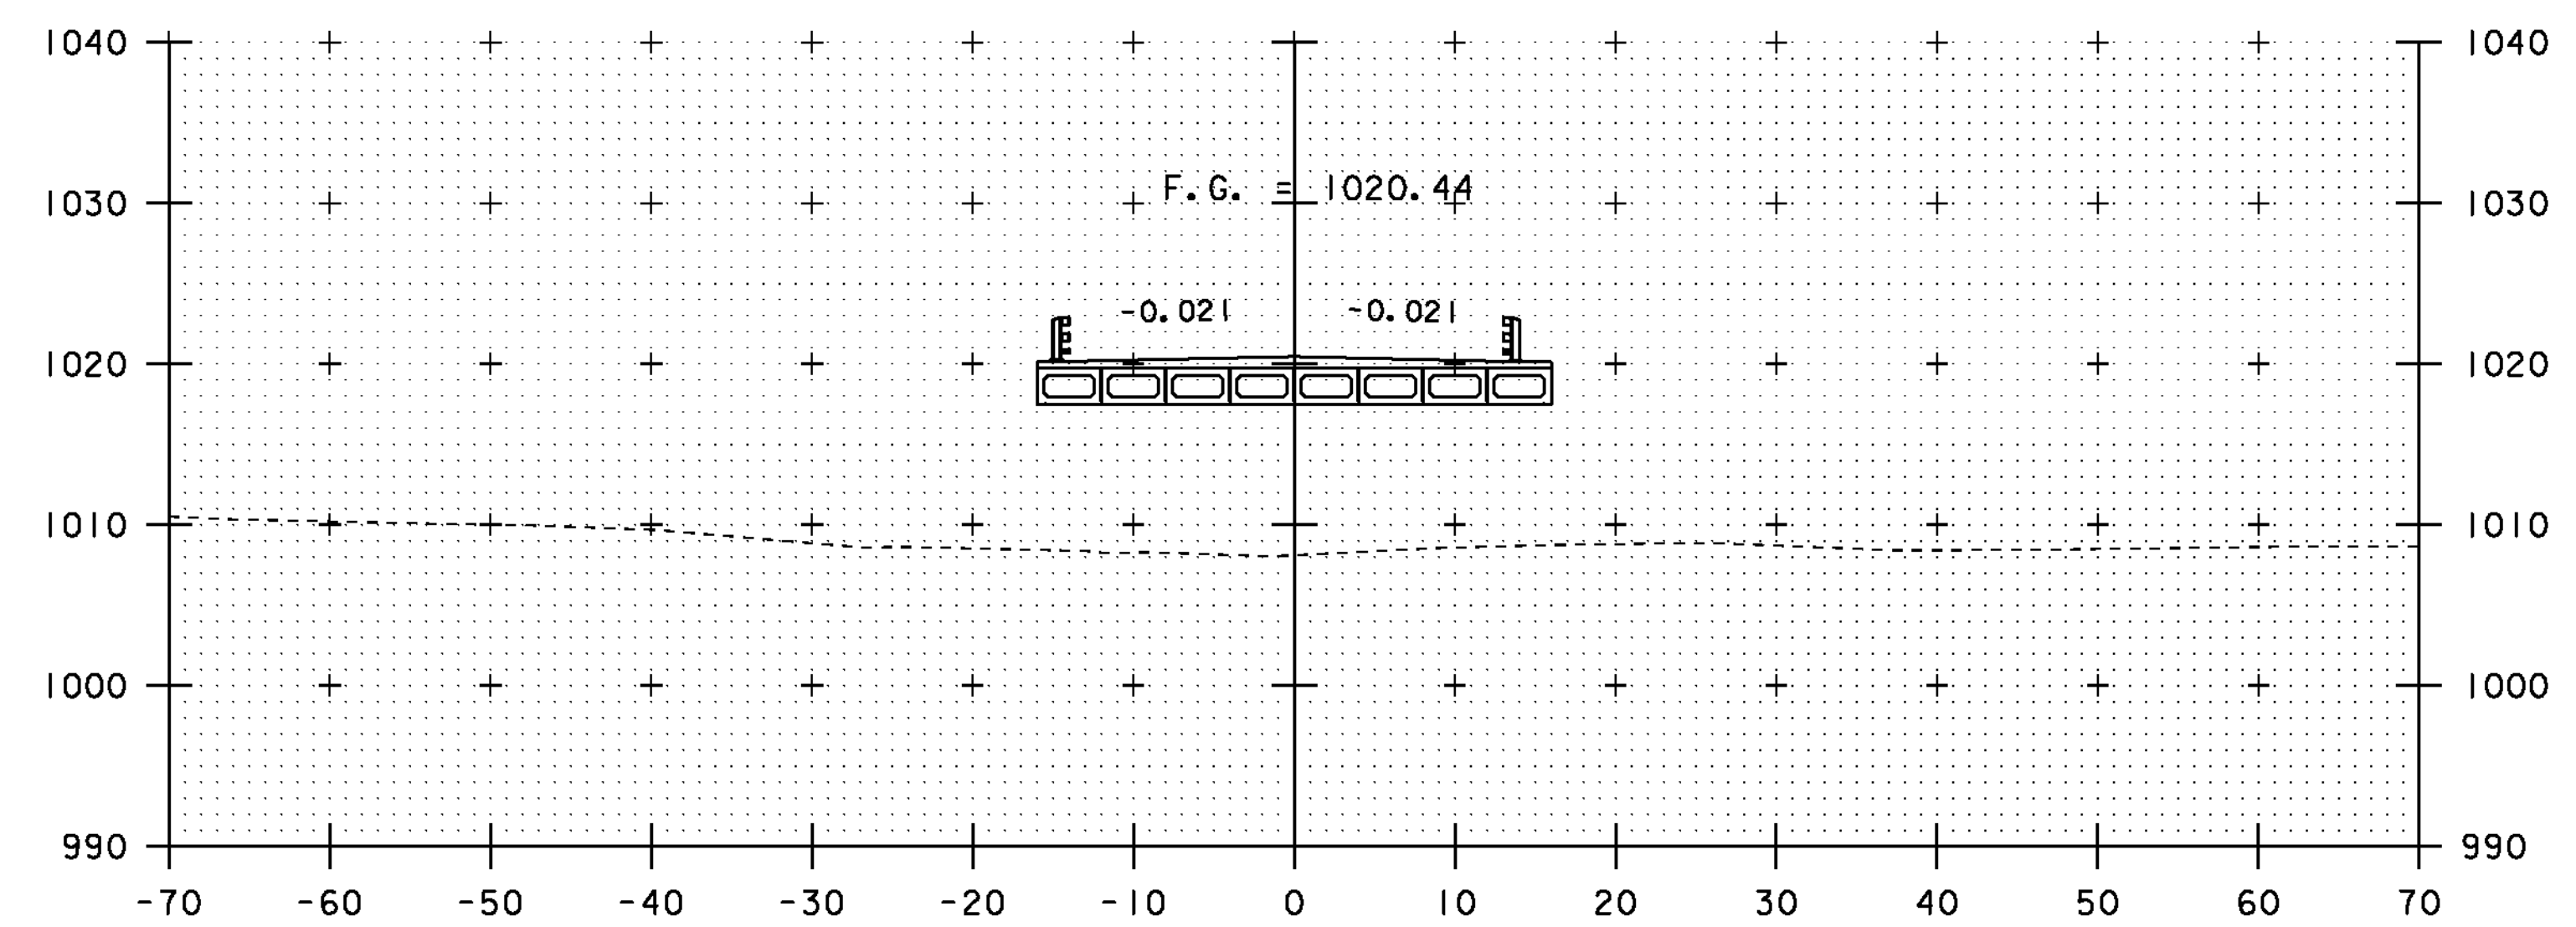


97+25

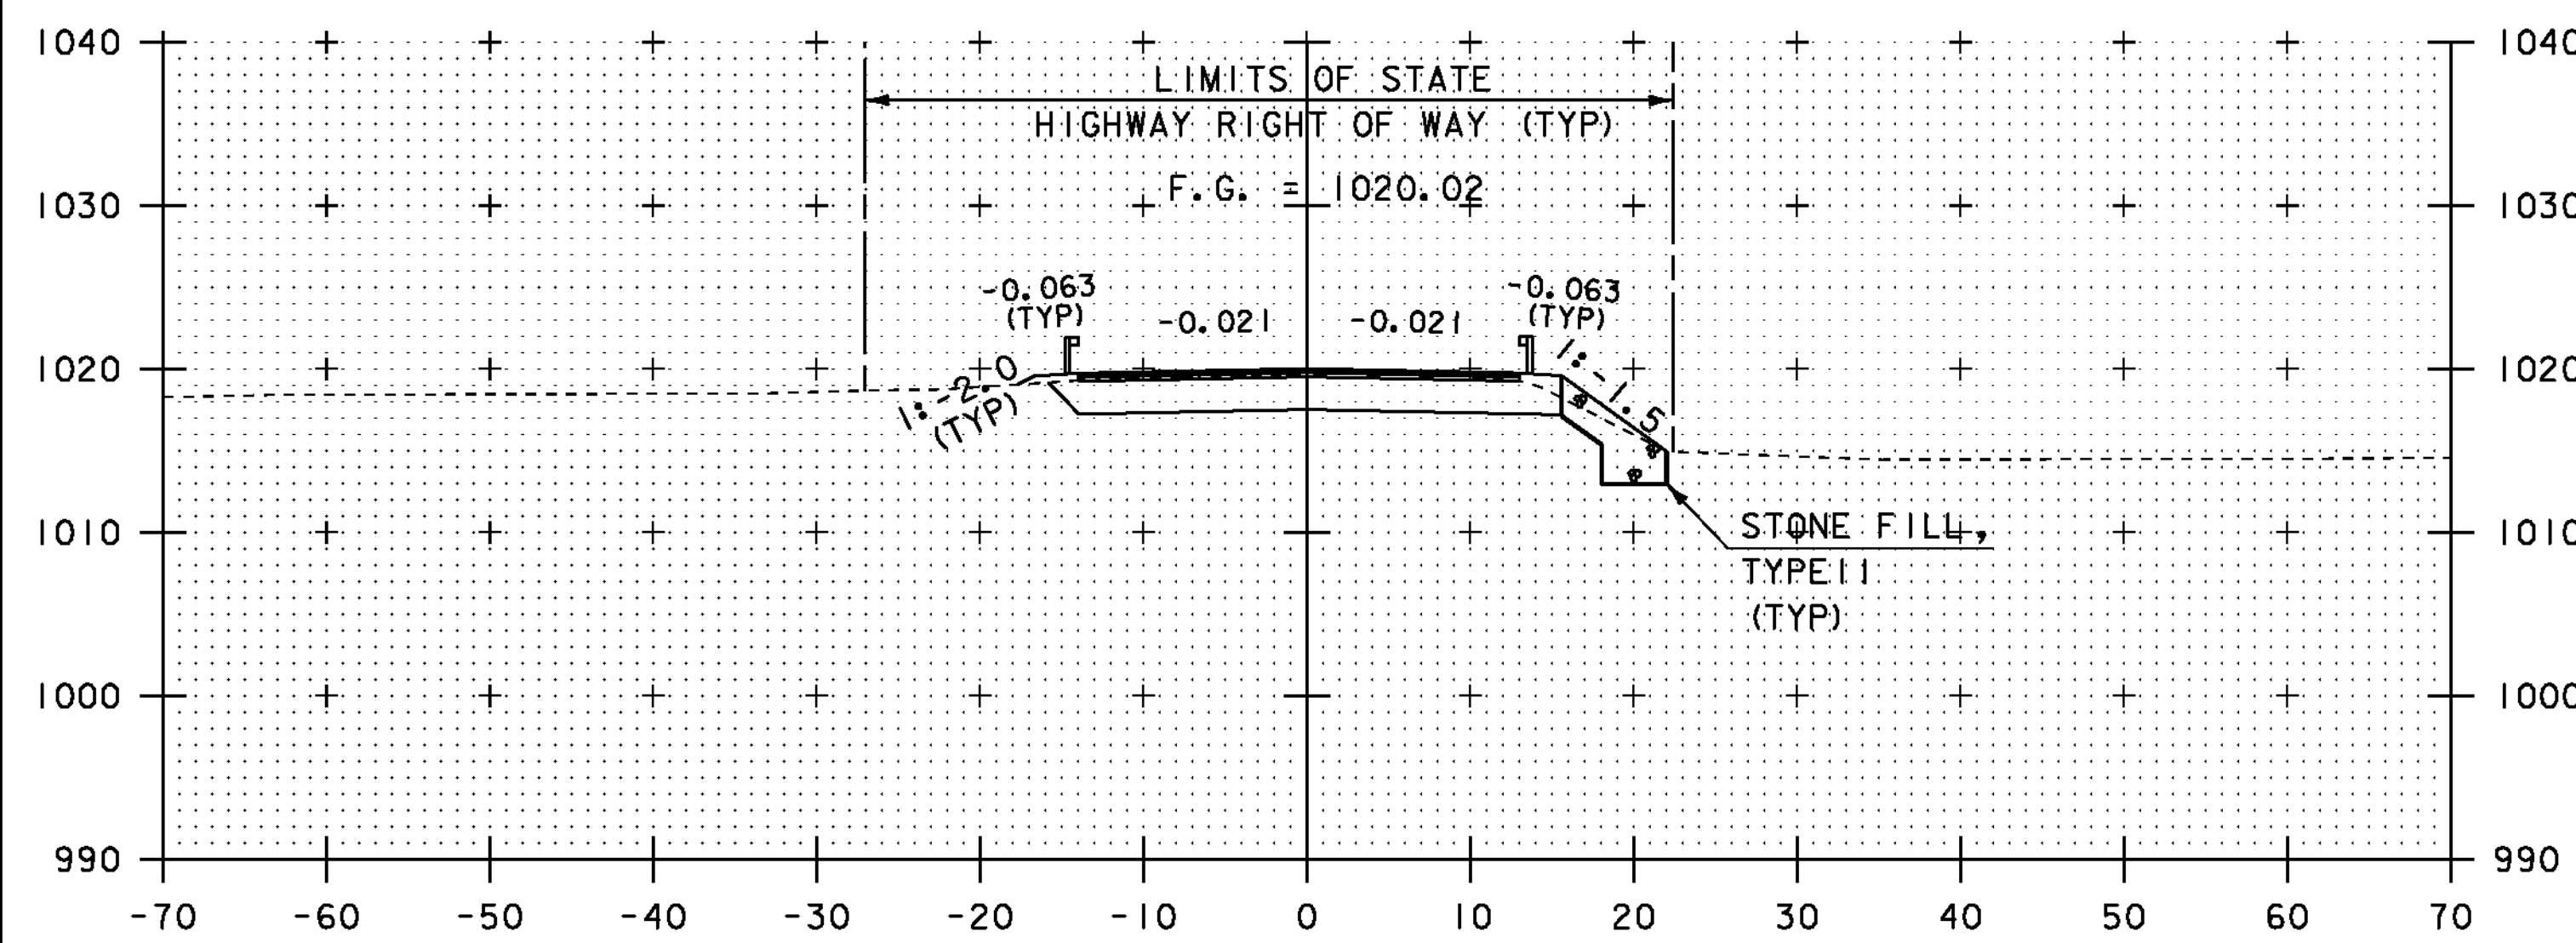

96+50
BEGIN PROJECT

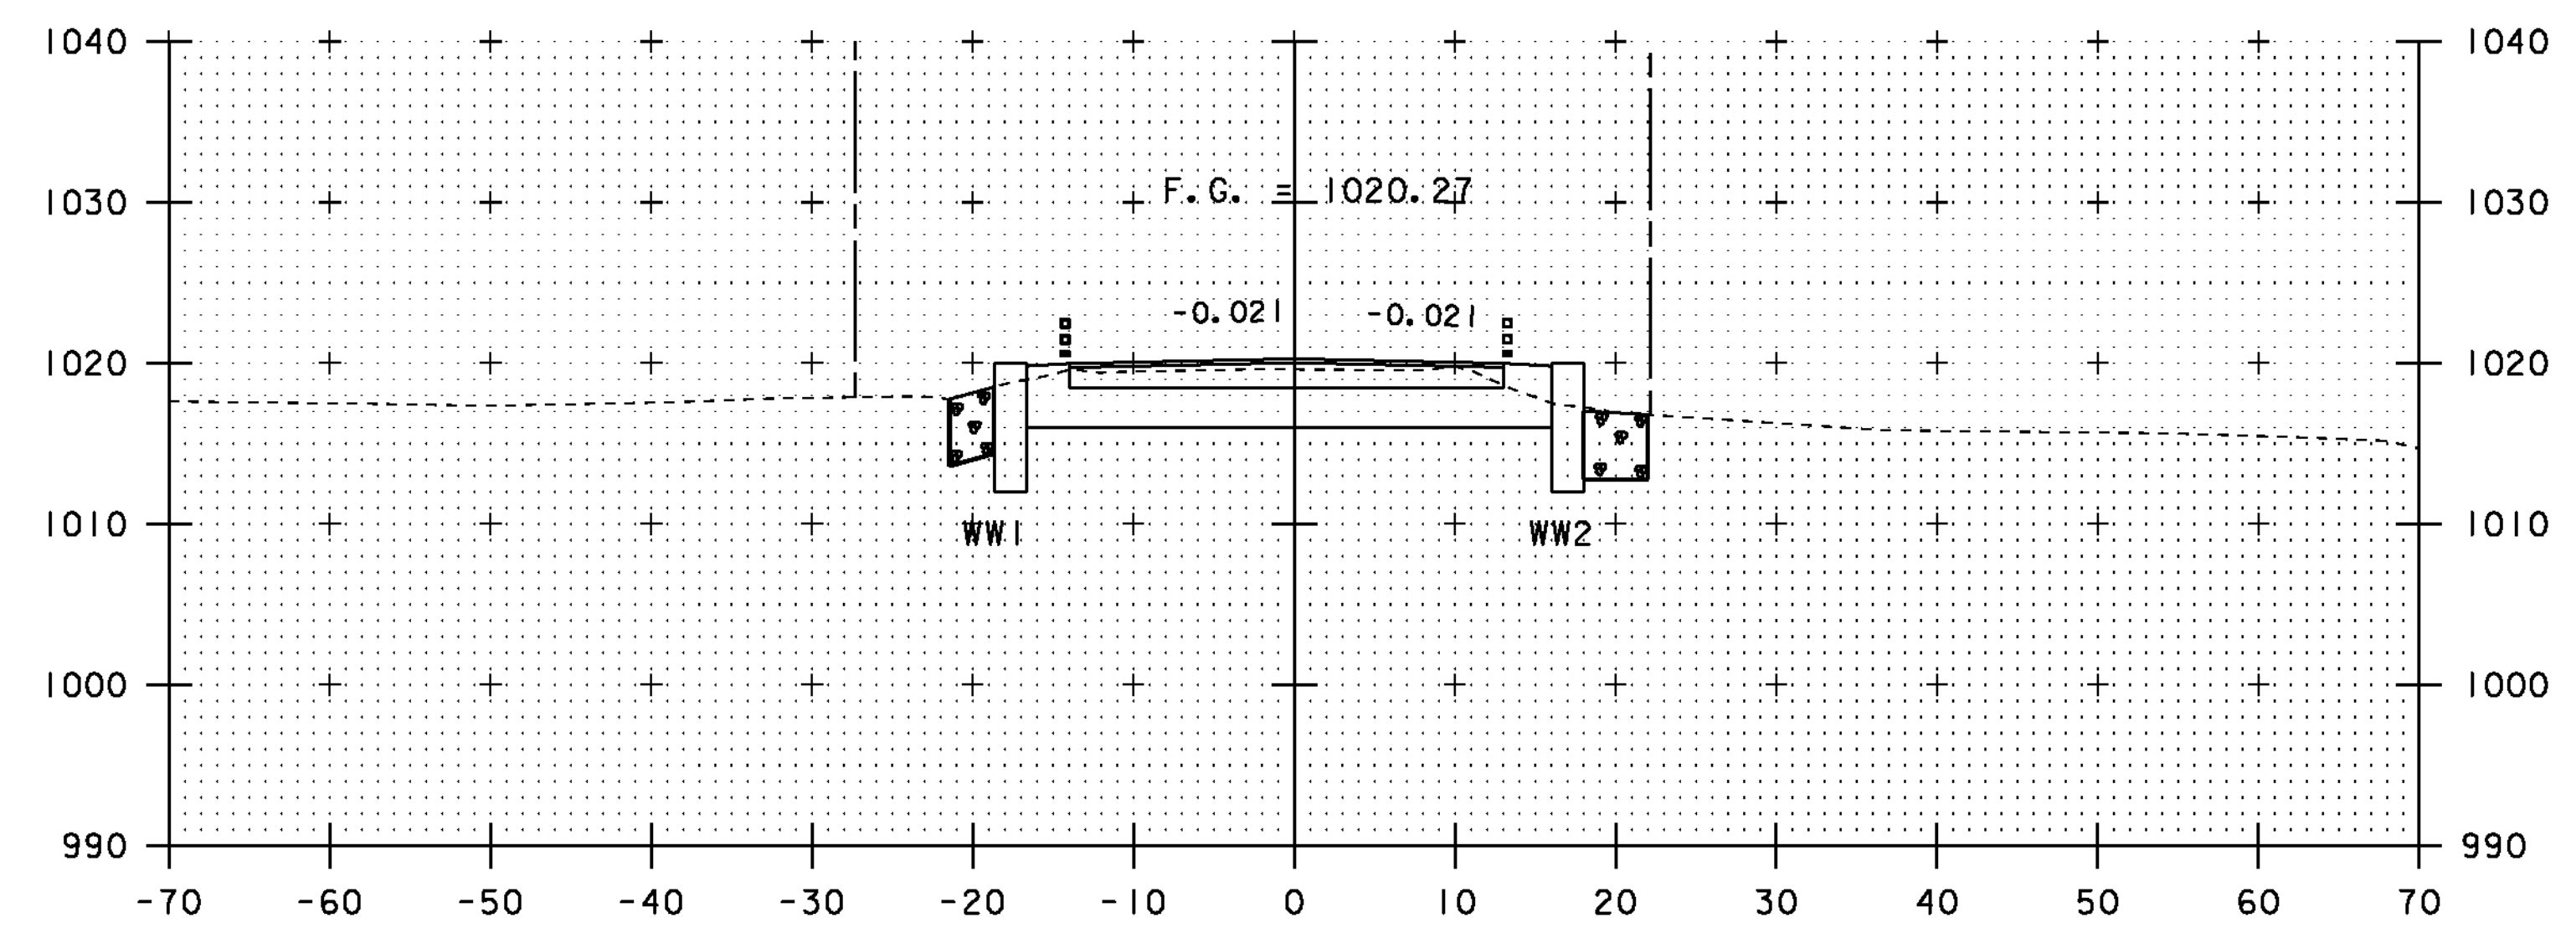

97+00
BEGIN BRIDGE

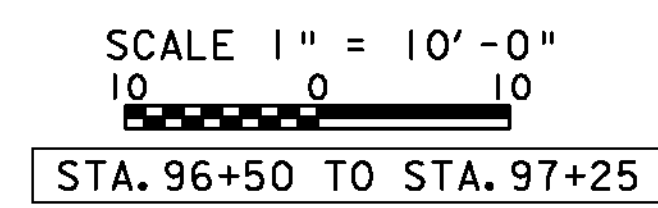

PROJECT NAME:	EAST HAVEN	PLOT DATE:	08-AUG-2011
PROJECT NUMBER:	BRF 0269(II)	DRAWN BY:	R. PELLETT
FILE NAME:	s00cl62xs.dgn	CHECKED BY:	J. LACROIX
PROJECT LEADER:	K. HIGGINS	SHEET	36 OF 40
DESIGNED BY:	J. LACROIX	MAINLINE SECTIONS #2	