


EPSC FINAL SITE PLAN

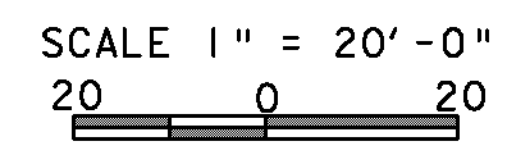

AREAS OF EARTH DISTURBANCE THAT WILL REQUIRE REVEGETATION.

PROJECT NAME:	EAST HAVEN	PLOT DATE:	08-AUG-2011
PROJECT NUMBER:	BRF 0269(II)	DRAWN BY:	R. PELLET
FILE NAME:	s00c162erobdr.dgn	CHECKED BY:	J. LACROIX
PROJECT LEADER:	K. HIGGINS	SHEET	32 OF 40
DESIGNED BY:	J. LACROIX		
EPSC FINAL SITE PLAN			