


SEE SHEET 2 FOR
INDEX OF SHEETS AND
LIST OF STANDARDS

STATE OF VERMONT AGENCY OF TRANSPORTATION



PROPOSED IMPROVEMENT BRIDGE PROJECT TOWN OF EAST HAVEN COUNTY OF ESSEX STATE ROUTE 114 - MAJOR COLLECTOR BRIDGE NO. 18

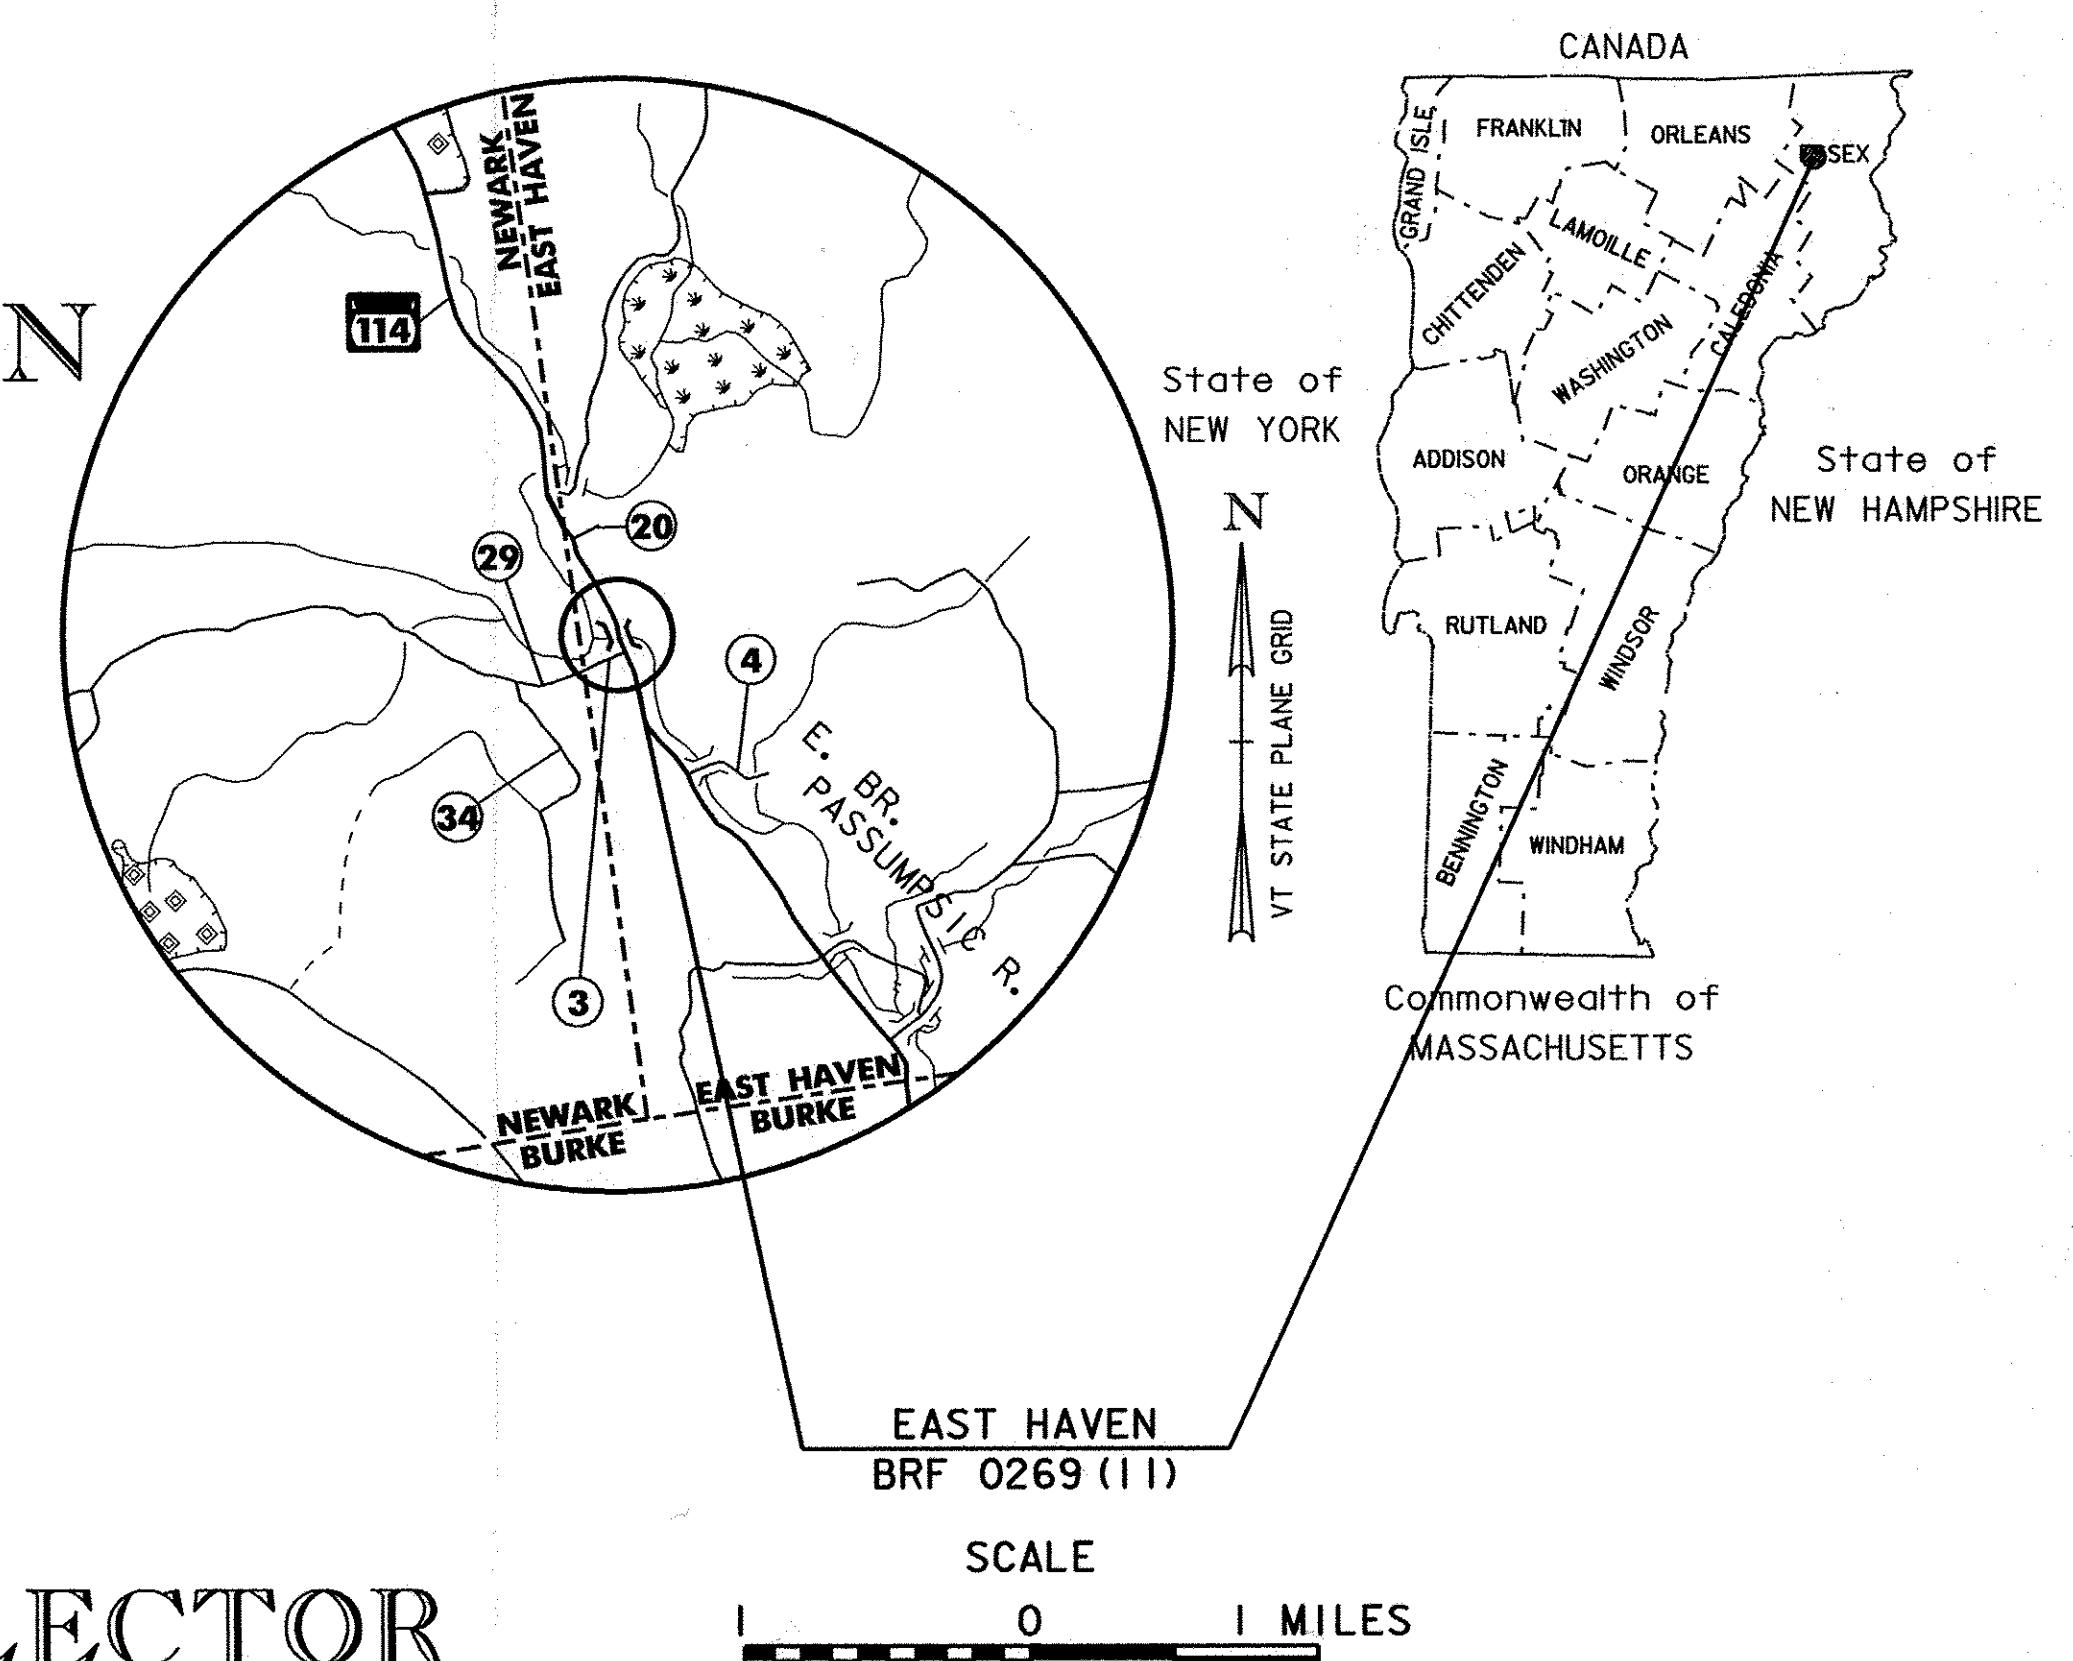


RECORD PLANS	
CONTRACTOR:	AUSTIN CONSTRUCTION, INC. - CONCORD, VT
RESIDENT ENGINEER:	DOUG BUMPS
CONSTRUCTION BEGAN:	APRIL 23, 2012
CONSTRUCTION COMPLETE:	
RECORD PLANS BY:	DOUG BUMPS & C. PIERCE
I HEREBY CERTIFY THAT ALL THE CONSTRUCTION REQUIRED BY THIS SET OF DRAWINGS HAS BEEN ACCOMPLISHED AS INDICATED HEREIN.	
BY	<i>Douglas Bumps</i> RESIDENT ENGINEER
DATE	5/23/12
NOTE: Any further information concerning final quantities, amounts or other details relative to this project may be found at Central Files in the electronic archives.	

PROJECT LOCATION: BEGINNING AT MILE POST 1.827 ON VT 114 IN EAST HAVEN, CROSSING THE PASSUMPSIC RIVER AND ENDING AT MILE POST 1.860.

PROJECT DESCRIPTION: THIS PROJECT SHALL CONSIST OF THE REPLACEMENT OF THE EXISTING STRUCTURE WITH RELATED APPROACH WORK.

LENGTH OF BRIDGE: 70.00 FEET
LENGTH OF ROADWAY: 100.00 FEET
LENGTH OF PROJECT: 170.00 FEET

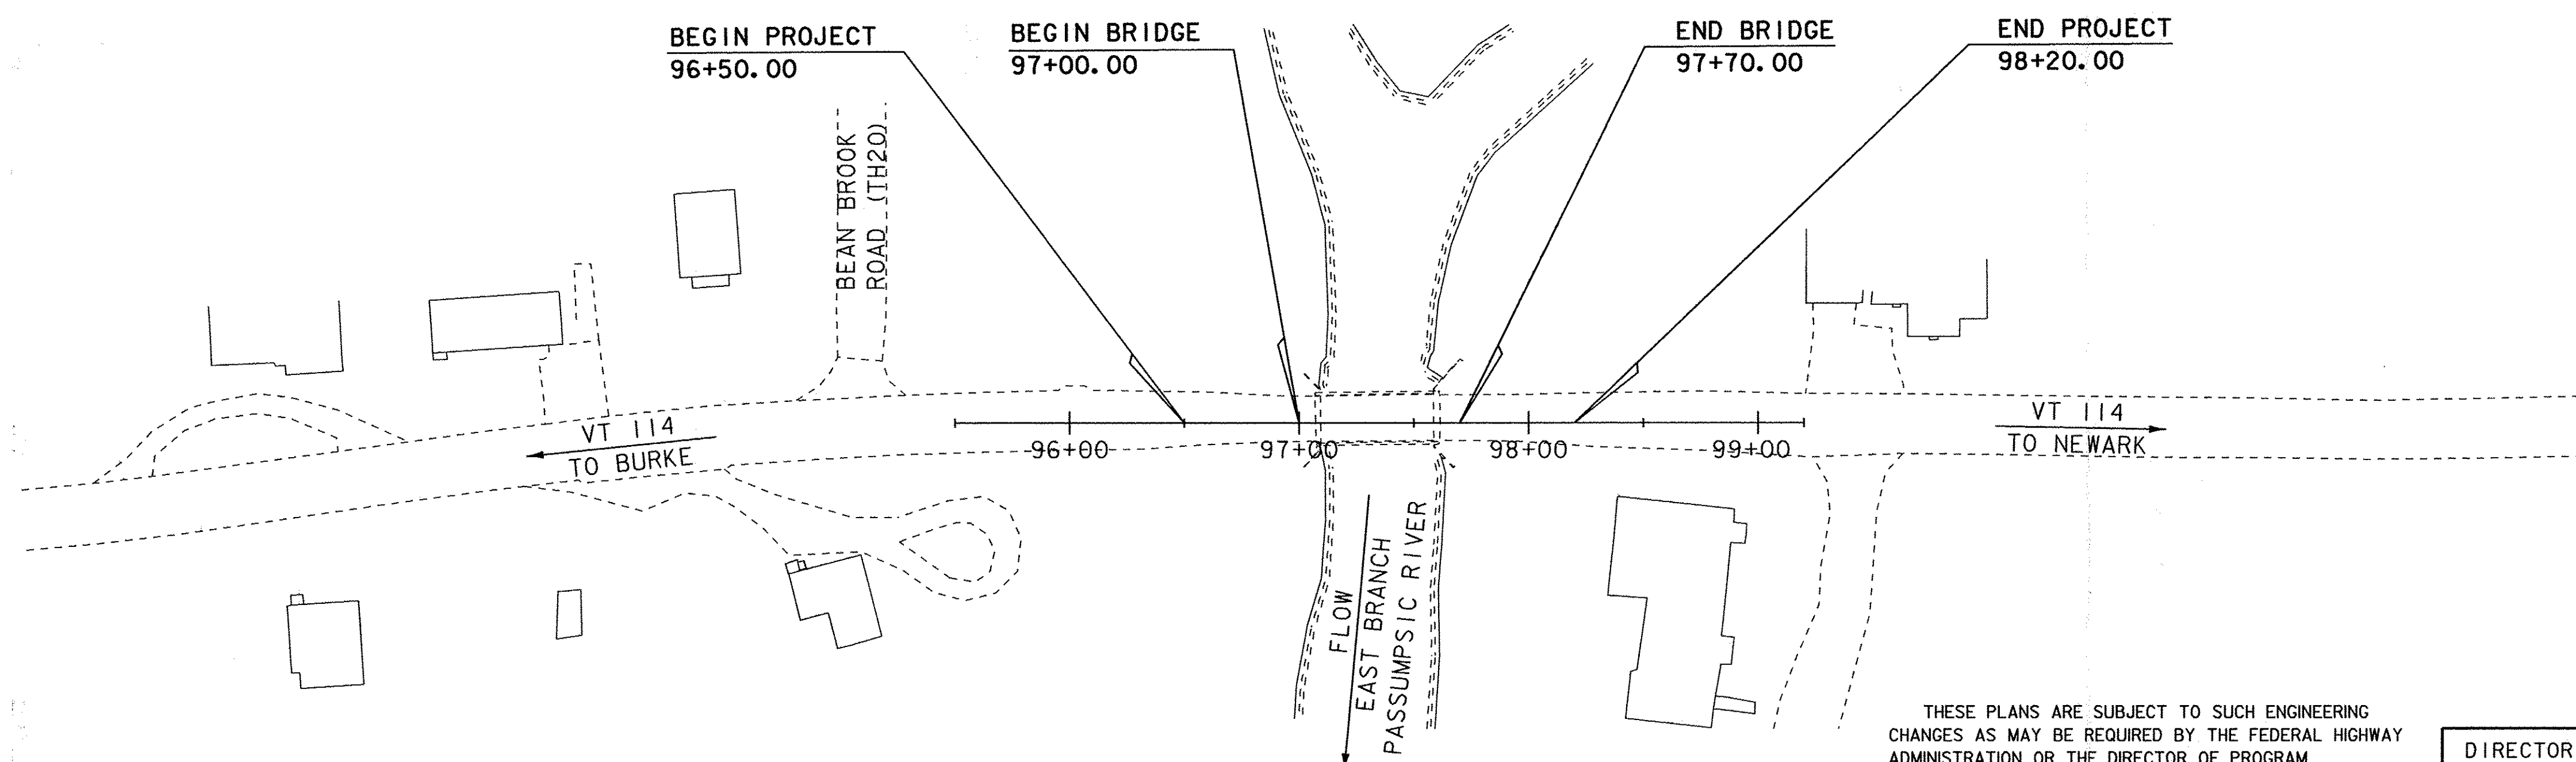

QUALITY ASSURANCE PROGRAM: LEVEL 2

CONVENTIONAL SYMBOLS

COUNTY LINE	
TOWN LINE	
LIMITS OF ACCESS	
POINT OF ACCESS	
FENCE LINE	
STONE WALL	
TRAVELED WAY	
GUARD RAIL	
RAILROAD	
SURVEY LINE	
CULVERT	
POWER POLE	
TELEPHONE POLE	
TREES	
CONTROL OF ACCESS	
PROPERTY LINE	
R.O.W. TAKING LINE	
SLOPE RIGHTS	
TOP OF CUT	
TOE OF SLOPE	

SURVEYED BY : R. GILMAN
SURVEYED DATE : 11/00

DATUM

VERTICAL NAVD 88
HORIZONTAL NAD 83 (96)

THESE PLANS ARE SUBJECT TO SUCH ENGINEERING CHANGES AS MAY BE REQUIRED BY THE FEDERAL HIGHWAY ADMINISTRATION OR THE DIRECTOR OF PROGRAM DEVELOPMENT.

CONSTRUCTION IS TO BE CARRIED ON IN ACCORDANCE WITH THESE PLANS AND THE STANDARD SPECIFICATIONS FOR CONSTRUCTION DATED 2006, AS APPROVED BY THE FEDERAL HIGHWAY ADMINISTRATION ON JUNE 15, 2006 FOR USE ON THIS PROJECT, INCLUDING ALL SUBSEQUENT REVISIONS AND SUCH REVISED SPECIFICATIONS AND SPECIAL PROVISIONS AS ARE INCORPORATED IN THESE PLANS.

SCALE 1" = 50'-0"
50 0 50

DIRECTOR OF PROGRAM DEVELOPMENT

APPROVED *Rutha Johnson* DATE 8/8/11

PROJECT MANAGER: KRISTIN HIGGINS


PROJECT NAME : EAST HAVEN

PROJECT NUMBER : BRF 0269 (11)


SHEET 1 OF 40 SHEETS

STA 51+28.00 RT
 BEGIN UNCLASSIFIED CHANNEL EXCAVATION
 BEGIN GEOTEXTILE UNDER STONE FILL
 BEGIN STONE, FILL TYPE IV
 BEGIN GRUBBING MATERIAL
 STA 51+34.00
 END GRUBBING MATERIAL


STA 51+27.60 FAR RT
 BEGIN UNCLASSIFIED CHANNEL EXCAVATION
 BEGIN GEOTEXTILE UNDER STONE FILL
 BEGIN STONE FILL, TYPE IV
 BEGIN GRUBBING MATERIAL
 STA 51+34.00
 END GRUBBING MATERIAL

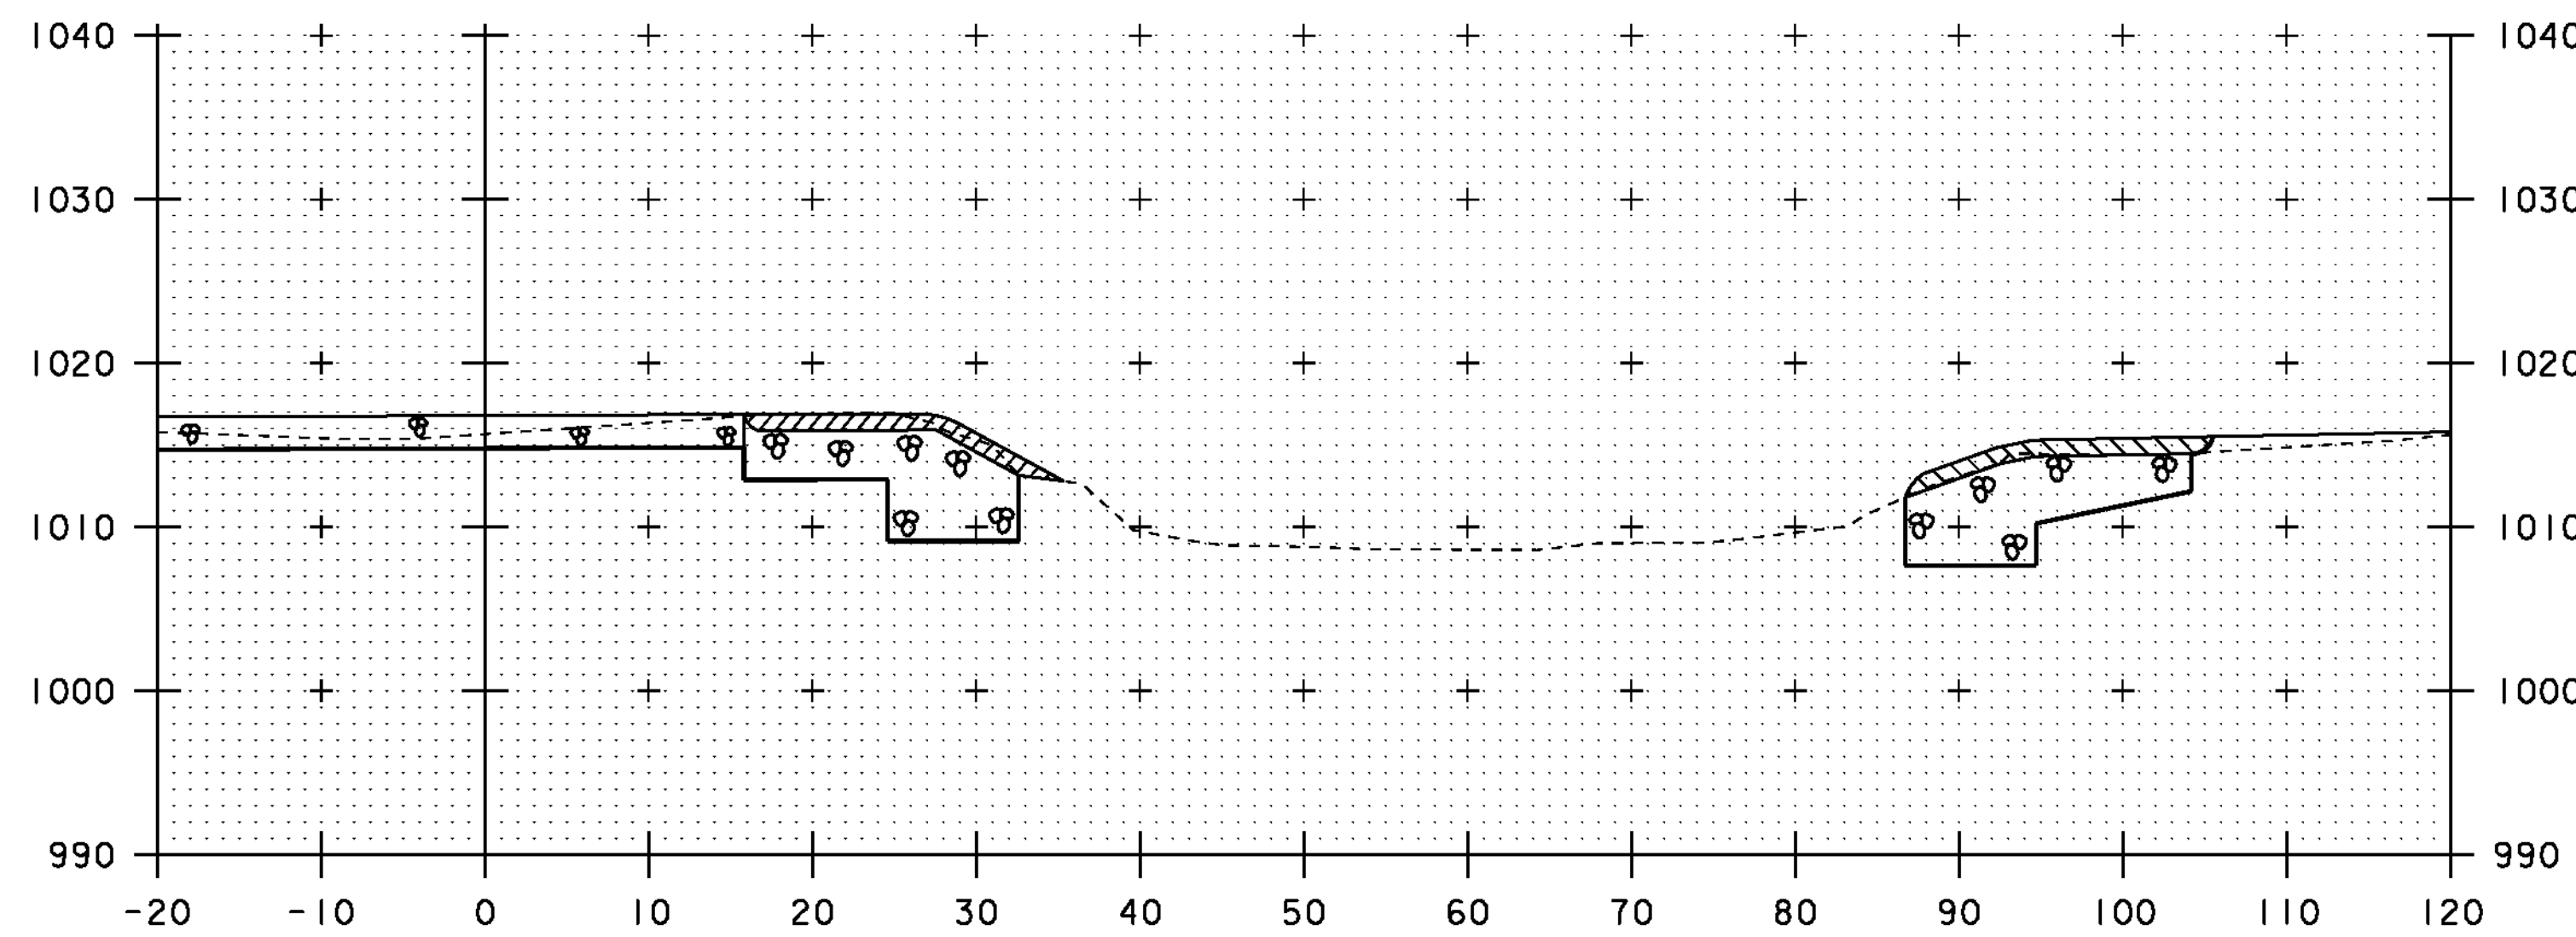


51+30

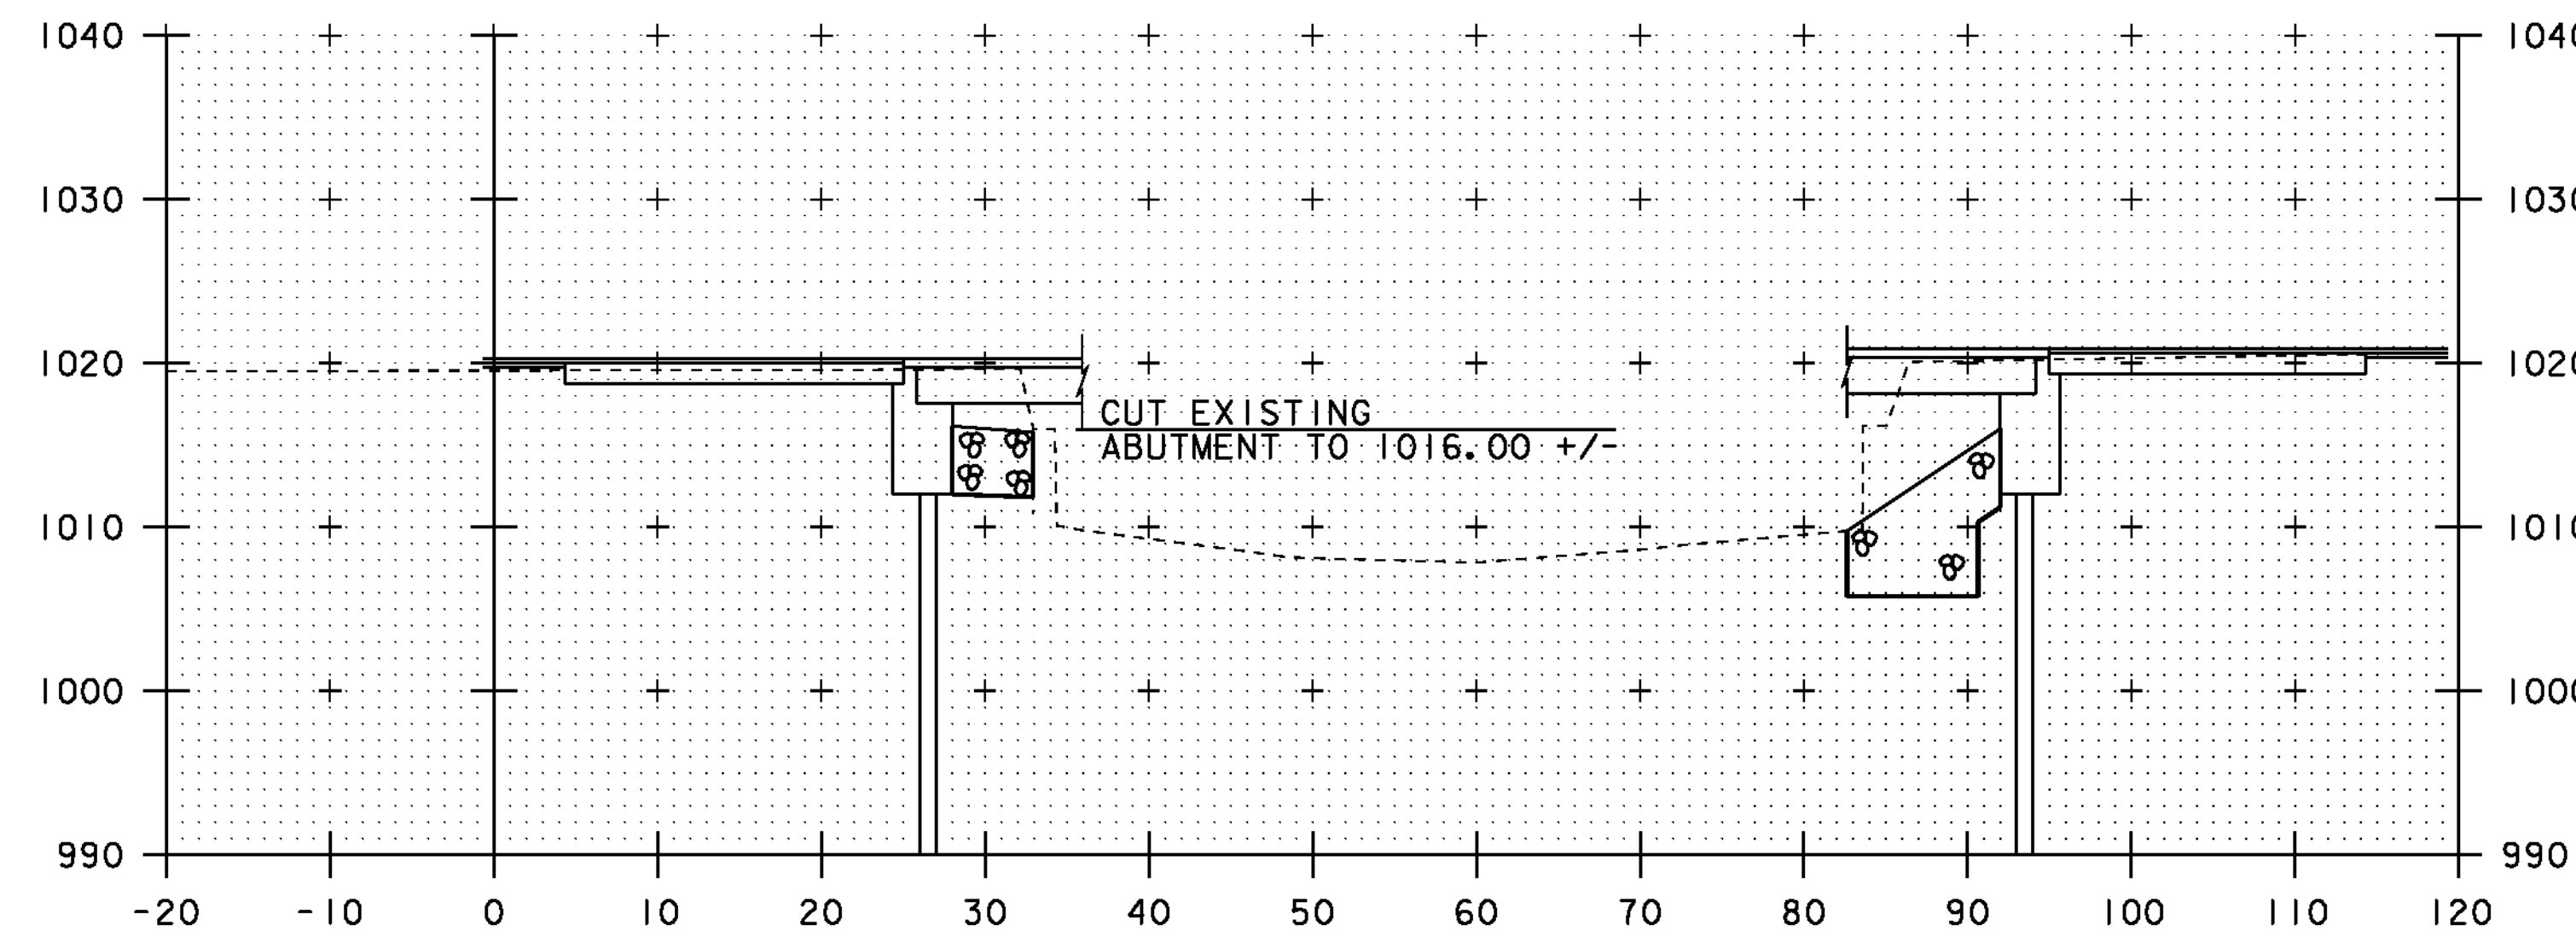

51+50

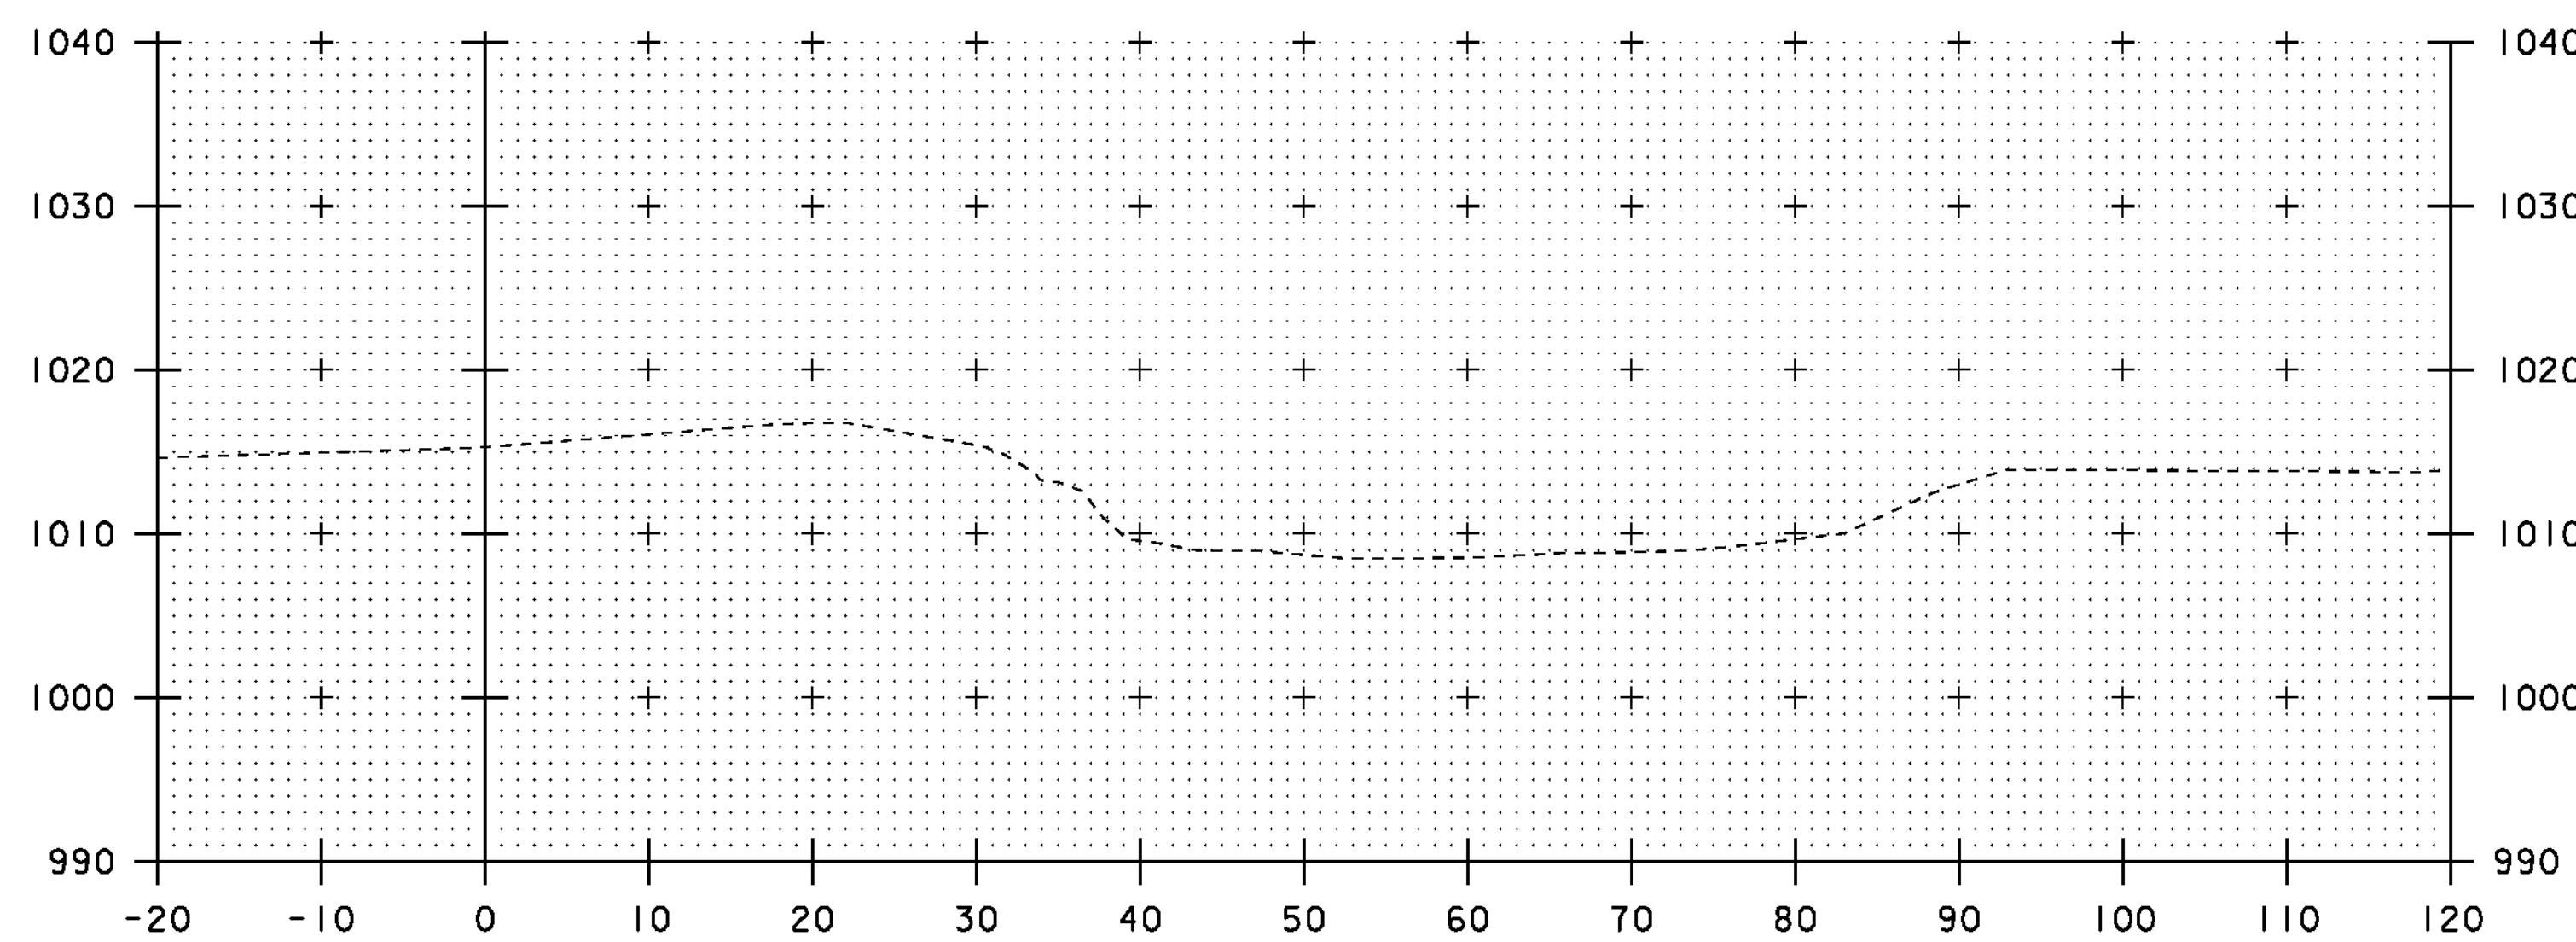

51+20

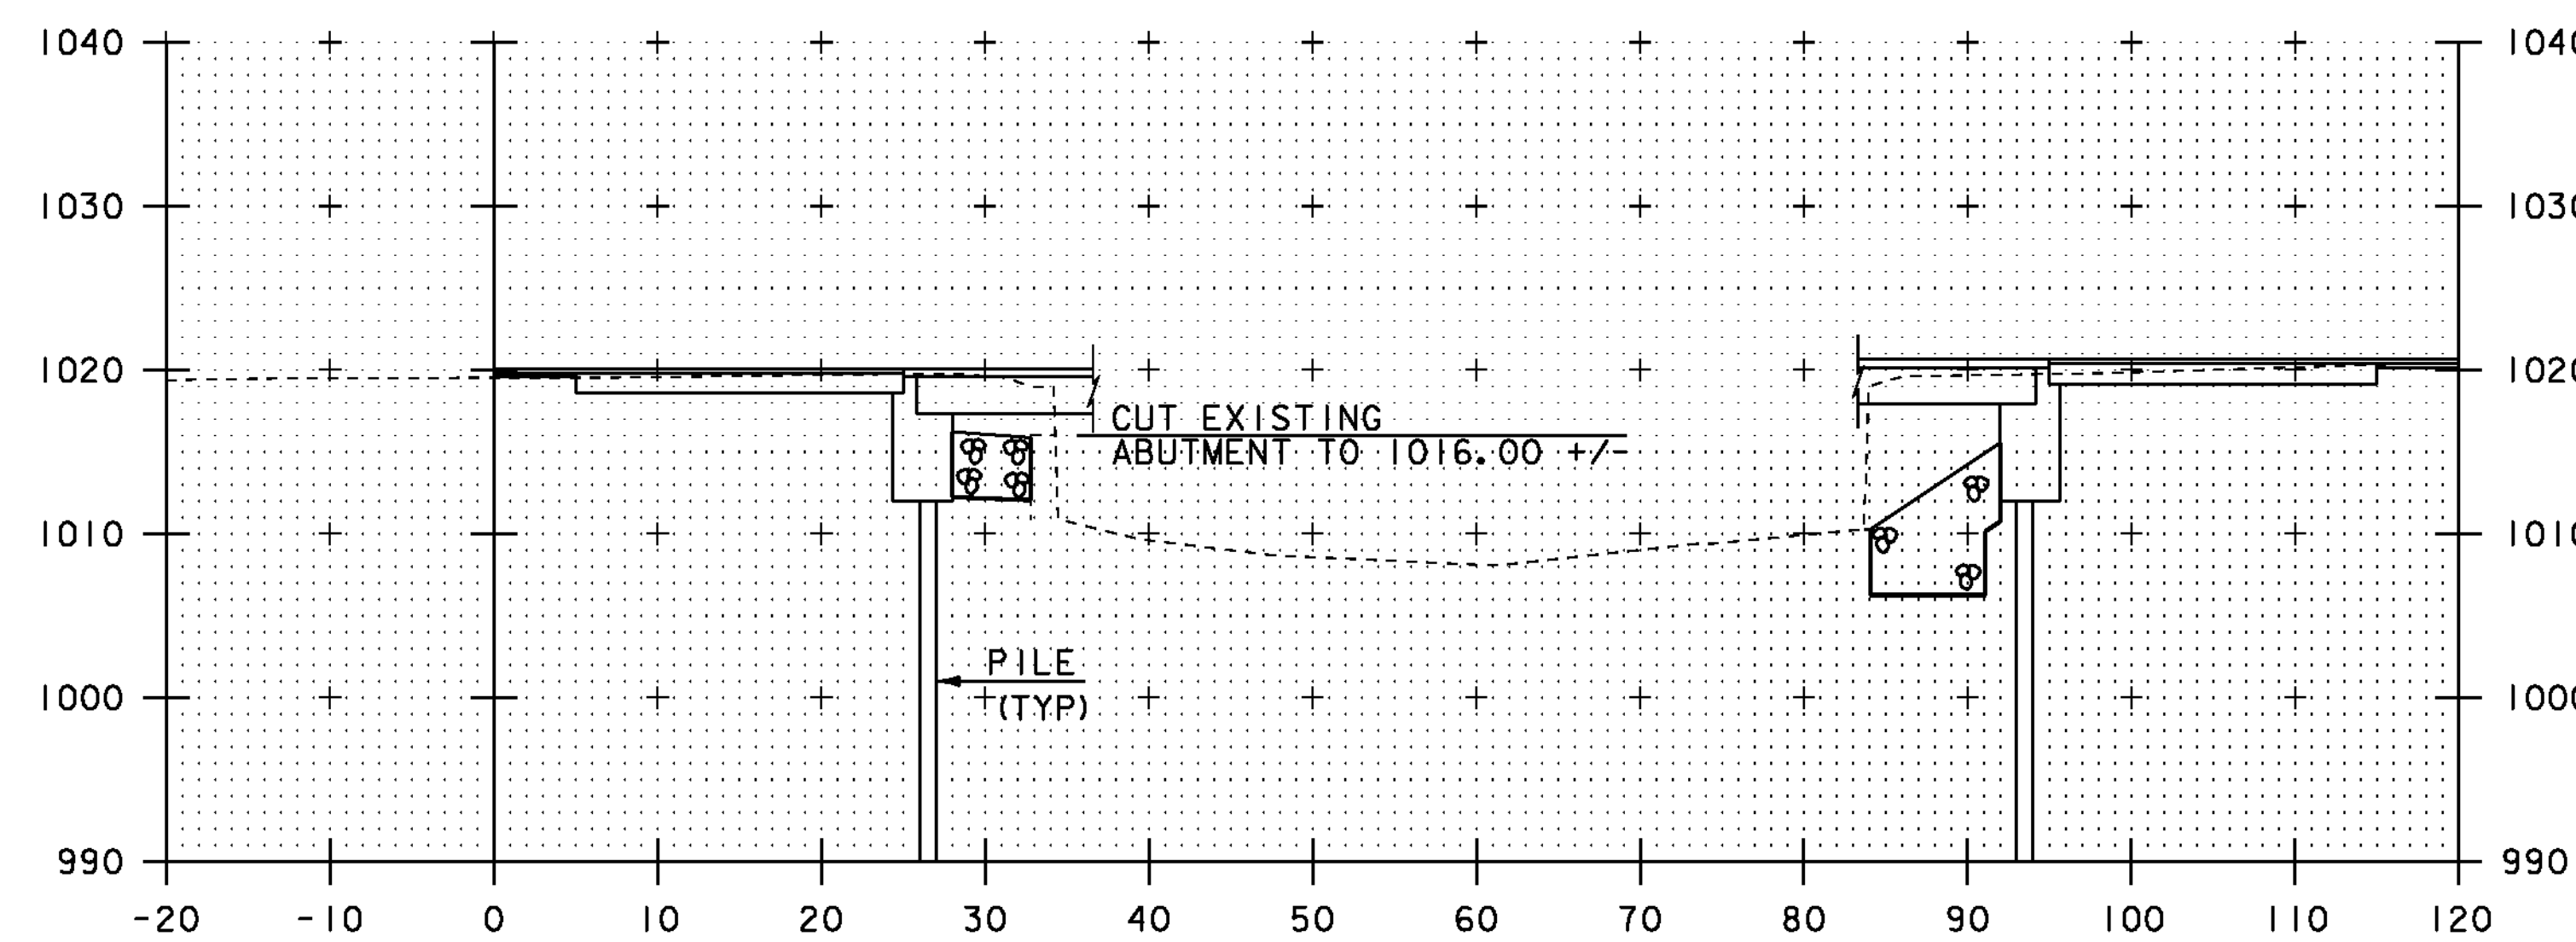

51+40

SCALE 1" = 10'-0"
 10 0 10

STA. 51+20 TO STA. 51+50

PROJECT NAME: EAST HAVEN
 PROJECT NUMBER: BRF 0269(II)

FILE NAME: s00cl62xs.dgn
 PROJECT LEADER: K. HIGGINS
 DESIGNED BY: J. LACROIX
 CHANNEL SECTIONS #1

PLOT DATE: 08-AUG-2011
 DRAWN BY: R. PELLETT
 CHECKED BY: J. LACROIX
 SHEET 39 OF 40

GENERAL

- 1. ALL MATERIALS AND CONSTRUCTION SHALL CONFORM TO THE STATE OF VERMONT, AGENCY OF TRANSPORTATION STANDARD SPECIFICATIONS FOR CONSTRUCTION, DATED 2006, AND ITS LATEST REVISIONS, THE AASHTO LRFD BRIDGE DESIGN SPECIFICATIONS FIFTH EDITION, AND ITS LATEST REVISIONS AND THE AASHTO LRFD BRIDGE CONSTRUCTION SPECIFICATIONS, THIRD EDITION, AND ITS LATEST REVISIONS.
- 2. ALL DIMENSIONS SHOWN IN THE PLANS ARE HORIZONTAL OR VERTICAL AND ARE GIVEN AT 68 DEGREES FAHRENHEIT, UNLESS NOTED OTHERWISE.
- 3. ~~ITEM 529.15 "REMOVAL OF STRUCTURE" IS FOR THE REMOVAL OF THE EXISTING SUPERSTRUCTURE, INCLUDING THE BRIDGE RAIL, THE SOUTH ABUTMENT DOWN TO ELEVATION 1016' AS WELL AS ANY PORTION OF THE ABUTMENT THAT WILL AFFECT NEW CONSTRUCTION, AND THE ENTIRE NORTH ABUTMENT.~~
- 4. THERE ARE GRAVE SITES LOCATED IN THE VICINITY OF WINGWALL #1. THE CONTRACTOR SHALL CONTACT VTRANS ARCHAEOLOGIST JEANNINE RUSSELL AT 802-828-3981 A MINIMUM OF TWO WEEKS PRIOR TO PERFORMING EXCAVATION IN THIS AREA. A REPRESENTATIVE OF THE STATE WILL BE PRESENT DURING THE EXCAVATION IN THIS AREA. THIS WORK WILL BE INCLUDED IN THE BID PRICE OF THE APPROPRIATE EXCAVATION ITEM. IN NO CASE SHALL THE CONTRACTOR DISTURB EARTH OUTSIDE OF THE BARRIER FENCE AS SHOWN IN THE EROSION CONTROL PLANS. SEE SPECIAL PROVISIONS FOR MORE INFORMATION.
- 5. THERE IS A FENCE TO BE REMOVED BETWEEN STATIONS 97+61 RT AND 98+50 RT. THE CONTRACTOR SHALL STOCKPILE THIS FENCE AT A LOCATION ACCEPTABLE TO THE PROPERTY OWNER.

CONCRETE

- 6. ITEM 514.10 "WATER REPELLENT, SILANE", SHALL BE APPLIED TO ALL EXPOSED CONCRETE SURFACES, EXCEPT THE UNDERSIDE OF THE SUPERSTRUCTURE BETWEEN DRIP NOTCHES.
- 7. THE OVERLAY AND SUBSTRUCTURE CONCRETE ABOVE THE CONSTRUCTION JOINT SHALL BE SPECIAL PROVISION (HIGH PERFORMANCE CONCRETE, CLASS A LOW CEMENT)
- 8. THE SUBSTRUCTURE CONCRETE BELOW THE CONSTRUCTION JOINT SHALL BE CONCRETE, HIGH PERFORMANCE CLASS B.
- 9. THE DECK WILL HAVE A LONGITUDINAL GROOVED FINISH. THIS WORK WILL BE PAID FOR UNDER ITEM 900.675 SPECIAL PROVISION (LONGITUDINAL DECK GROOVING).
- 10. THE TOP SURFACE OF THE PILE CAP SHALL INITIALLY BE GIVEN A FLOAT FINISH TO GRADE. THE CONCRETE WITHIN THE REINFORCING CAGE SHALL THEN BE ROUGHENED BY RAKING PARALLEL TO THE FACE OF THE ABUTMENT TO AN AMPLITUDE OF 1/2 INCH. THE CONCRETE OUTSIDE THE REINFORCING CAGE AND UNDER THE BEARING PADS SHALL REMAIN SMOOTH.
- 11. TO FACILITATE COMPLETE CONSOLIDATION OF CONCRETE BETWEEN THE TOP OF THE BRIDGE SEAT AND THE BOTTOM OF THE BEAM, VENT HOLES MAY BE PROVIDED FOR THE INSERTION OF A VIBRATOR IN THE FRONT FORM UNDER EACH BEAM. IF CONCRETE DOES NOT CONSOLIDATE IN THIS AREA, THE CONTRACTOR SHALL REPAIR THIS AREA TO THE SATISFACTION OF THE ENGINEER.

PRESTRESSED BOX BEAMS

- 12. TRANSVERSE TENDONS PLATES AND CHUCKS SHALL BE GALVANIZED AFTER FABRICATION IN ACCORDANCE WITH AASHTO M 232M/M 232.
- 13. ITEM 510.24 "GROUTING SHEAR KEYS": FILL THE JOINTS BETWEEN THE BEAMS WITH MORTAR, TYPE IV, AS DESCRIBED IN SUBSECTION 510.13 AND AS FOLLOWS:
 - A. CLEAN JOINTS WITH AN OIL FREE AIR-BLAST IMMEDIATELY BEFORE GROUT PLACEMENT. VERIFY THAT THE BACKER ROD IS STILL IN PLACE.
 - B. FOLLOW MANUFACTURER'S RECOMMENDATIONS FOR ADDITIONAL JOINT PREPARATION AND GROUT PLACEMENT.
 - C. CAREFULLY ROD JOINTS TO ELIMINATE ANY POSSIBILITY OF VOIDS.
- 14. DESIGN VALUES
 - A. CONCRETE: $f_c = 7$ ksi AND STRENGTH @ RELEASE = 5.5 ksi
 - B. LIVE LOAD: AASHTO HL-93
 - C. PRESTRESSING STRANDS: 0.6" DIAMETER, 270 ksi, LOW-RELAXATION 7-WIRE STRANDS PULLED TO 75% OF THEIR YIELD STRENGTH
 - D. POST-TENSIONING STRANDS: 0.6" DIAMETER, 270 ksi, LOW-RELAXATION 7-WIRE STRANDS.
 - E. THE ASSUMED MODULUS OF ELASTICITY FOR THE STRAND IS 28,500 KSI.
 - F. TRANSVERSE TENDONS SHALL BE COVERED BY SEAMLESS POLYPROPYLENE SHEATH (WITH CORROSION INHIBITOR GREASE BETWEEN SHEATH AND STRAND) FOR THE LENGTH OF THE STRAND. TIES SHALL BE TENSIONED TO 47 KIPS FOR EACH 0.6" DIAMETER STRAND.

G. SERVICE LOADS

MEMBER MOMENT	732.1 K-FT
SUPERIMPOSED DEAD LOAD MOMENT	106.3 K-FT
LIVE LOAD & IMPACT MOMENT	499.2 K-FT
DEAD LOAD REACTION	67.4 K
LIVE LOAD & IMPACT REACTION	57.9 K
TOTAL REACTION	125.3 K
FINAL CAMBER	0.3 IN

- 15. THE FABRICATOR MAY, WITH THE APPROVAL OF THE ENGINEER, ALTER THE DESIGN AS DETAILED TO MEET THE CONTRACTOR'S CONSTRUCTION NEEDS, OR THE PLANT'S PRESTRESSING OPERATION AND MATERIAL REQUIREMENTS. ALTERNATE STRAND, TRANSVERSE TIE AND CROSS-SLOPE CONFIGURATIONS MAY BE SUBMITTED TO THE ENGINEER FOR APPROVAL. ANY DESIGN CHANGES SHALL MEET ALL OF THE APPLICABLE DESIGN CRITERIA, LOADINGS AND CODES (THE LATEST EDITION OF THE AASHTO LRFD BRIDGE DESIGN SPECIFICATIONS AND THE LATEST EDITION OF THE STRUCTURES DESIGN MANUAL), AND SHALL BE STAMPED AND SIGNED BY A PROFESSIONAL ENGINEER LICENSED IN THE STATE OF VERMONT.
- 16. THE PRECASTER SHALL SANDBLAST SHEAR KEY FACES PRIOR TO DELIVERY.
- 17. ALL TIES AND STIRRUPS IN THE BOX BEAMS SHALL BE EPOXY COATED.

PILES

- 18. THE PILES SHALL BE HP 14 X 102.
- 19. THE PILES SHALL BE EMBEDDED IN THE GROUND A MINIMUM OF 25 FEET AND SHALL BE DRIVEN TO A NOMINAL RESISTANCE OF 350 KIP. TO PREVENT DAMAGE TO THE PILES, PILE SHOES SHALL BE REQUIRED AND SHALL CONFORM TO SECTION 505.
- 20. FOR ESTIMATING PURPOSES, THE PILE TIP ELEVATIONS WERE ASSUMED AS SHOWN ON THE BORING LOGS. THE ACTUAL IN PLACE LENGTHS MAY VARY.
- 21. A MINIMUM OF ONE DYNAMIC PILE TEST SHALL BE CONDUCTED FOR EACH SUBSTRUCTURE UNIT. MORE TESTS MAY BE REQUIRED BY THE ENGINEER. THE FIRST TEST PILE SHALL BE THE FIRST DRIVEN FOR THE SUBSTRUCTURE UNIT. THE PILE SHALL BE DRIVEN AT THE PLAN LOCATION AND THE PILE SHALL BE MEASURED FOR PAYMENT UNDER CONTRACT ITEM 505.29.


TRAFFIC CONTROL

- 22. THE TRAFFIC CONTROL PHASING SHOWN IN THE PLANS IS OF A CONCEPTUAL NATURE ONLY. THE CONTRACTOR SHALL SUPPLY A DETAILED TRAFFIC CONTROL PLAN, WHICH NEED NOT UTILIZE THE PHASING SHOWN IN THESE PLANS.
- 23. AS PART OF 900.645 SPECIAL PROVISION (TRAFFIC CONTROL, ALL-INCLUSIVE), THE CONTRACTOR SHALL SUBMIT A SITE SPECIFIC TRAFFIC CONTROL PLAN TO THE ENGINEER FOR APPROVAL PER SUBSECTION 105.03. SEE SPECIAL PROVISIONS.
- 24. ALL SIGNING SHALL BE IN ACCORDANCE WITH THE LATEST EDITION OF THE MUTCD. FOR ADDITIONAL SIGNING INSTRUCTIONS SEE STANDARDS E-100, E-100A, E-101, E-102, E-102A, AND E-121.
- 25. ALL ITEMS REQUIRED TO IMPLEMENT THE CONTRACTOR'S TRAFFIC CONTROL PLAN WILL NOT BE PAID FOR DIRECTLY BUT WILL BE CONSIDERED INCLUDED IN THE BID PRICE FOR ITEM 900.645 SPECIAL PROVISION (TRAFFIC CONTROL, ALL-INCLUSIVE). THIS INCLUDES BUT IS NOT LIMITED TO THE FOLLOWING ITEMS:
 - TEMPORARY TRAFFIC SIGNAL SYSTEM
 - TEMPORARY TRAFFIC BARRIER
 - TEMPORARY PAVEMENT MARKINGS (INCLUDING REMOVAL OF EXISTING MARKINGS)
 - CONSTRUCTION SIGNING
- 26. PAYMENT FOR MAINTENANCE OF THE EXISTING BRIDGE STRUCTURE FOR PHASE I TRAFFIC WILL BE MADE UNDER CONTRACT ITEM 527.10. PAYMENT FOR TEMPORARY BRIDGE WIDENING AND MAINTENANCE OF THE NEW BRIDGE STRUCTURE FOR PHASE II TRAFFIC WILL BE INCLUDED IN THE UNIT PRICE BID FOR CONTRACT ITEM 900.645 SPECIAL PROVISION (TEMPORARY BRIDGE WIDENING FOR PHASE CONSTRUCTION).
- 27. THERE ARE NUMEROUS DETAILS ON THESE PLANS THAT ARE BASED ON A PHASED CONSTRUCTION DESIGN THAT MAY OR MAY NOT BE USED BY THE CONTRACTOR. THE LOCATION OF CONSTRUCTION JOINTS, THE CONFIGURATION OF THE ABUTMENTS, AND THE DIMENSIONS OF REINFORCING STEEL WILL ALL HAVE TO BE CONSIDERED ONCE THE CONTRACTOR'S TRAFFIC CONTROL PLAN HAS BEEN ACCEPTED.


- 28. SPECIAL PROVISION (TEMPORARY BRIDGE WIDENING FOR PHASED CONSTRUCTION) IS FOR THE CONSTRUCTION OF A TEMPORARY ROADWAY AND BRIDGE COMPONENT SO THAT A 12 FOOT TRAVEL LANE, INCLUDING SHOULDERS CAN BE MAINTAINED THROUGH THE PROJECT (SEE TRAFFIC PHASING TYPICALS SHEET). THE CONTRACTOR SHALL KEEP ALL FILL SLOPES FROM THE TEMPORARY BRIDGE INSIDE THE RIGHT OF WAY LIMITS UNLESS THE CONTRACTOR CAN MAKE OTHER ARRANGEMENTS WITH PROPERTY OWNERS. IF TEMPORARY SHEET PILING IS REQUIRED TO KEEP FILLS INSIDE THE RIGHT OF WAY, COST SHALL BE INCLUDED IN THE LUMP SUM BID PRICE FOR SPECIAL PROVISION (TEMPORARY BRIDGE WIDENING FOR PHASED CONSTRUCTION).

REMOVED BOTH EXISTING ABUTMENTS DOWN TO ELEVATION 1013.50. REMAINDER OF EXISTING ABUTMENTS LEFT IN-PLACE.


PROJECT NAME:	EAST HAVEN
PROJECT NUMBER:	BRF 0269(II)
FILE NAME:	s00c162gennotes.dgn
PROJECT LEADER:	K. HIGGINS
DESIGNED BY:	J. LACROIX
GENERAL NOTES	
PLOT DATE:	08-AUG-2011
DRAWN BY:	R. PELLETT
CHECKED BY:	J. LACROIX
SHEET	3 OF 40

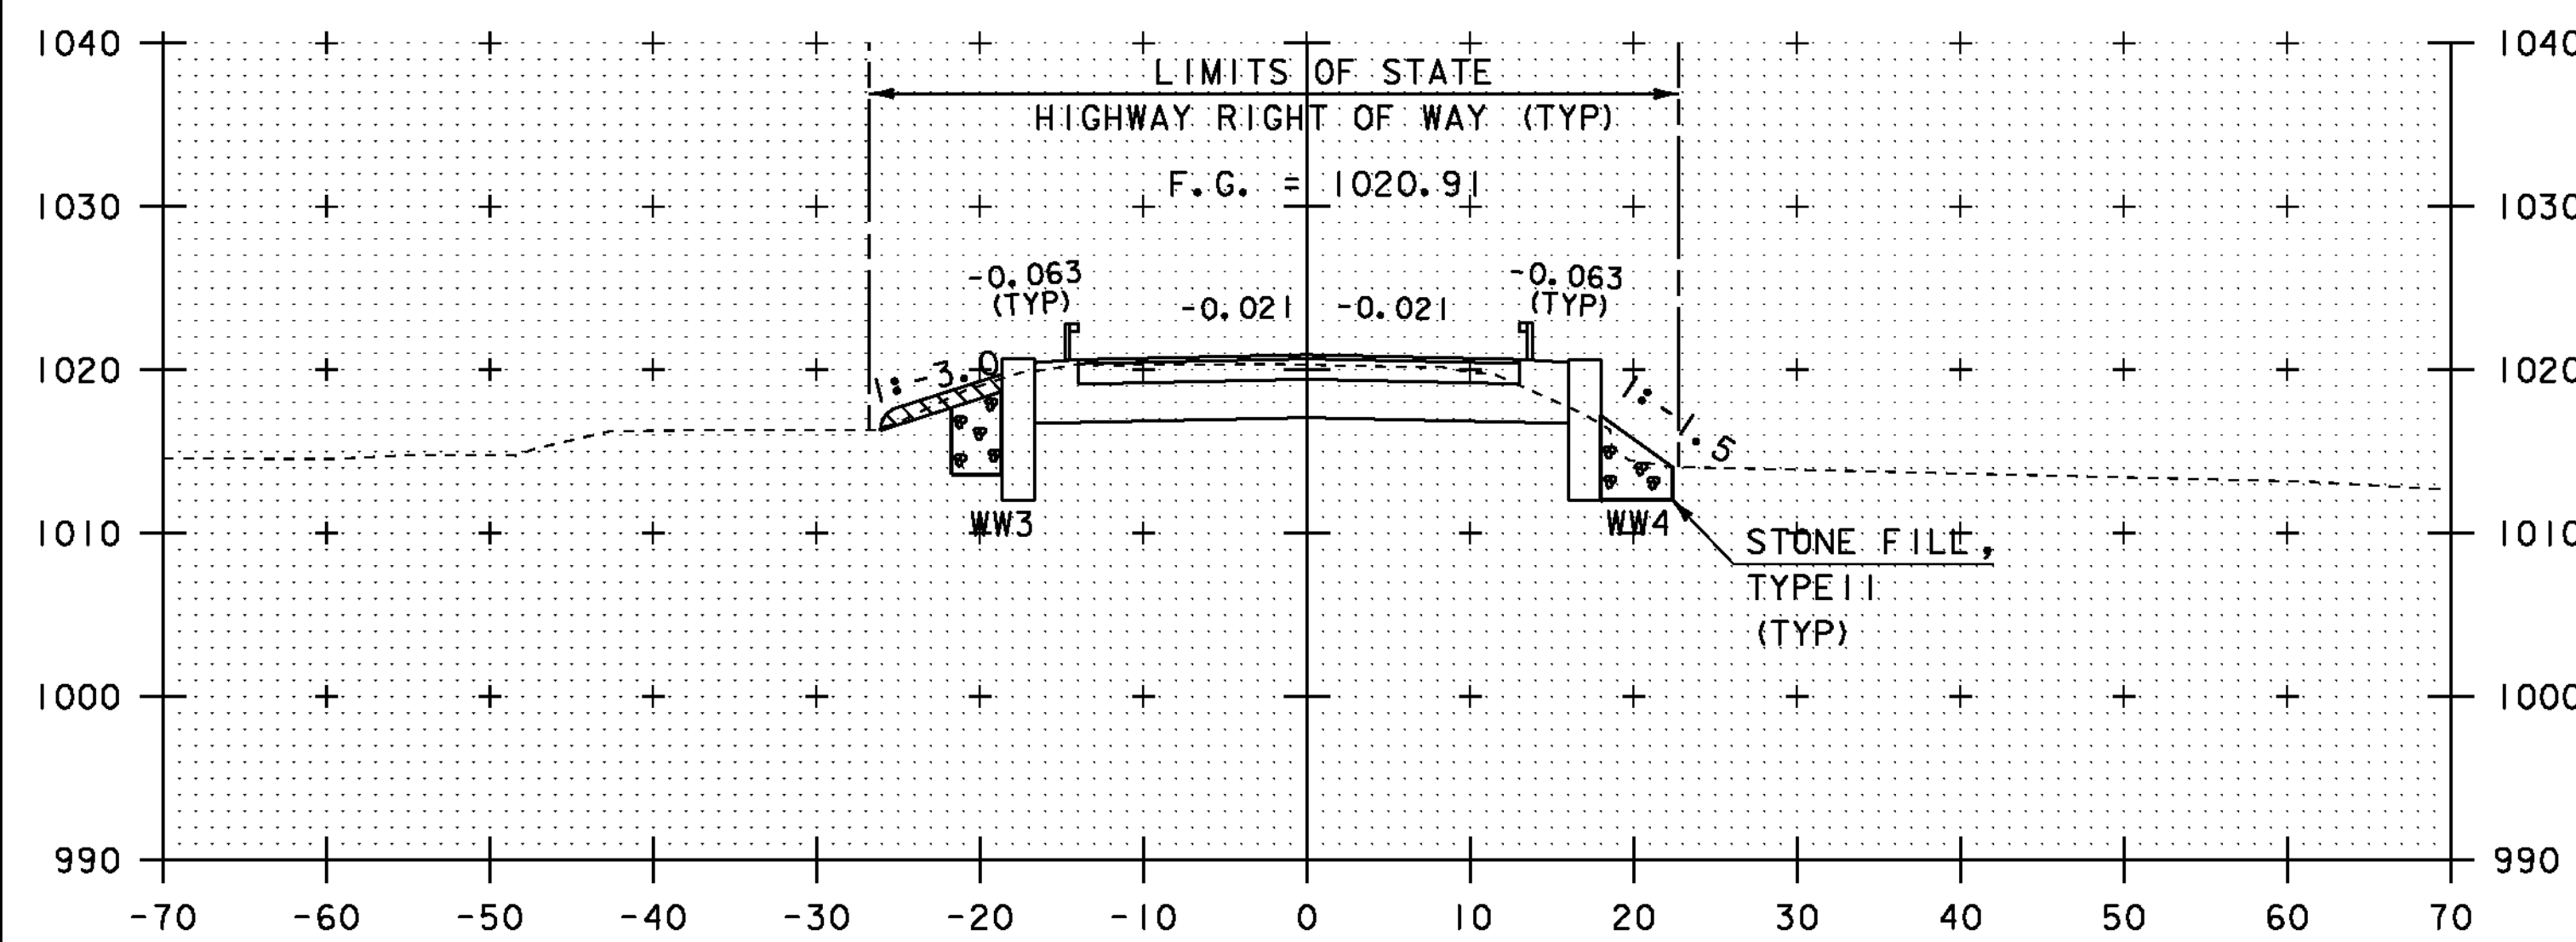


97+75
END BRIDGE 97+70

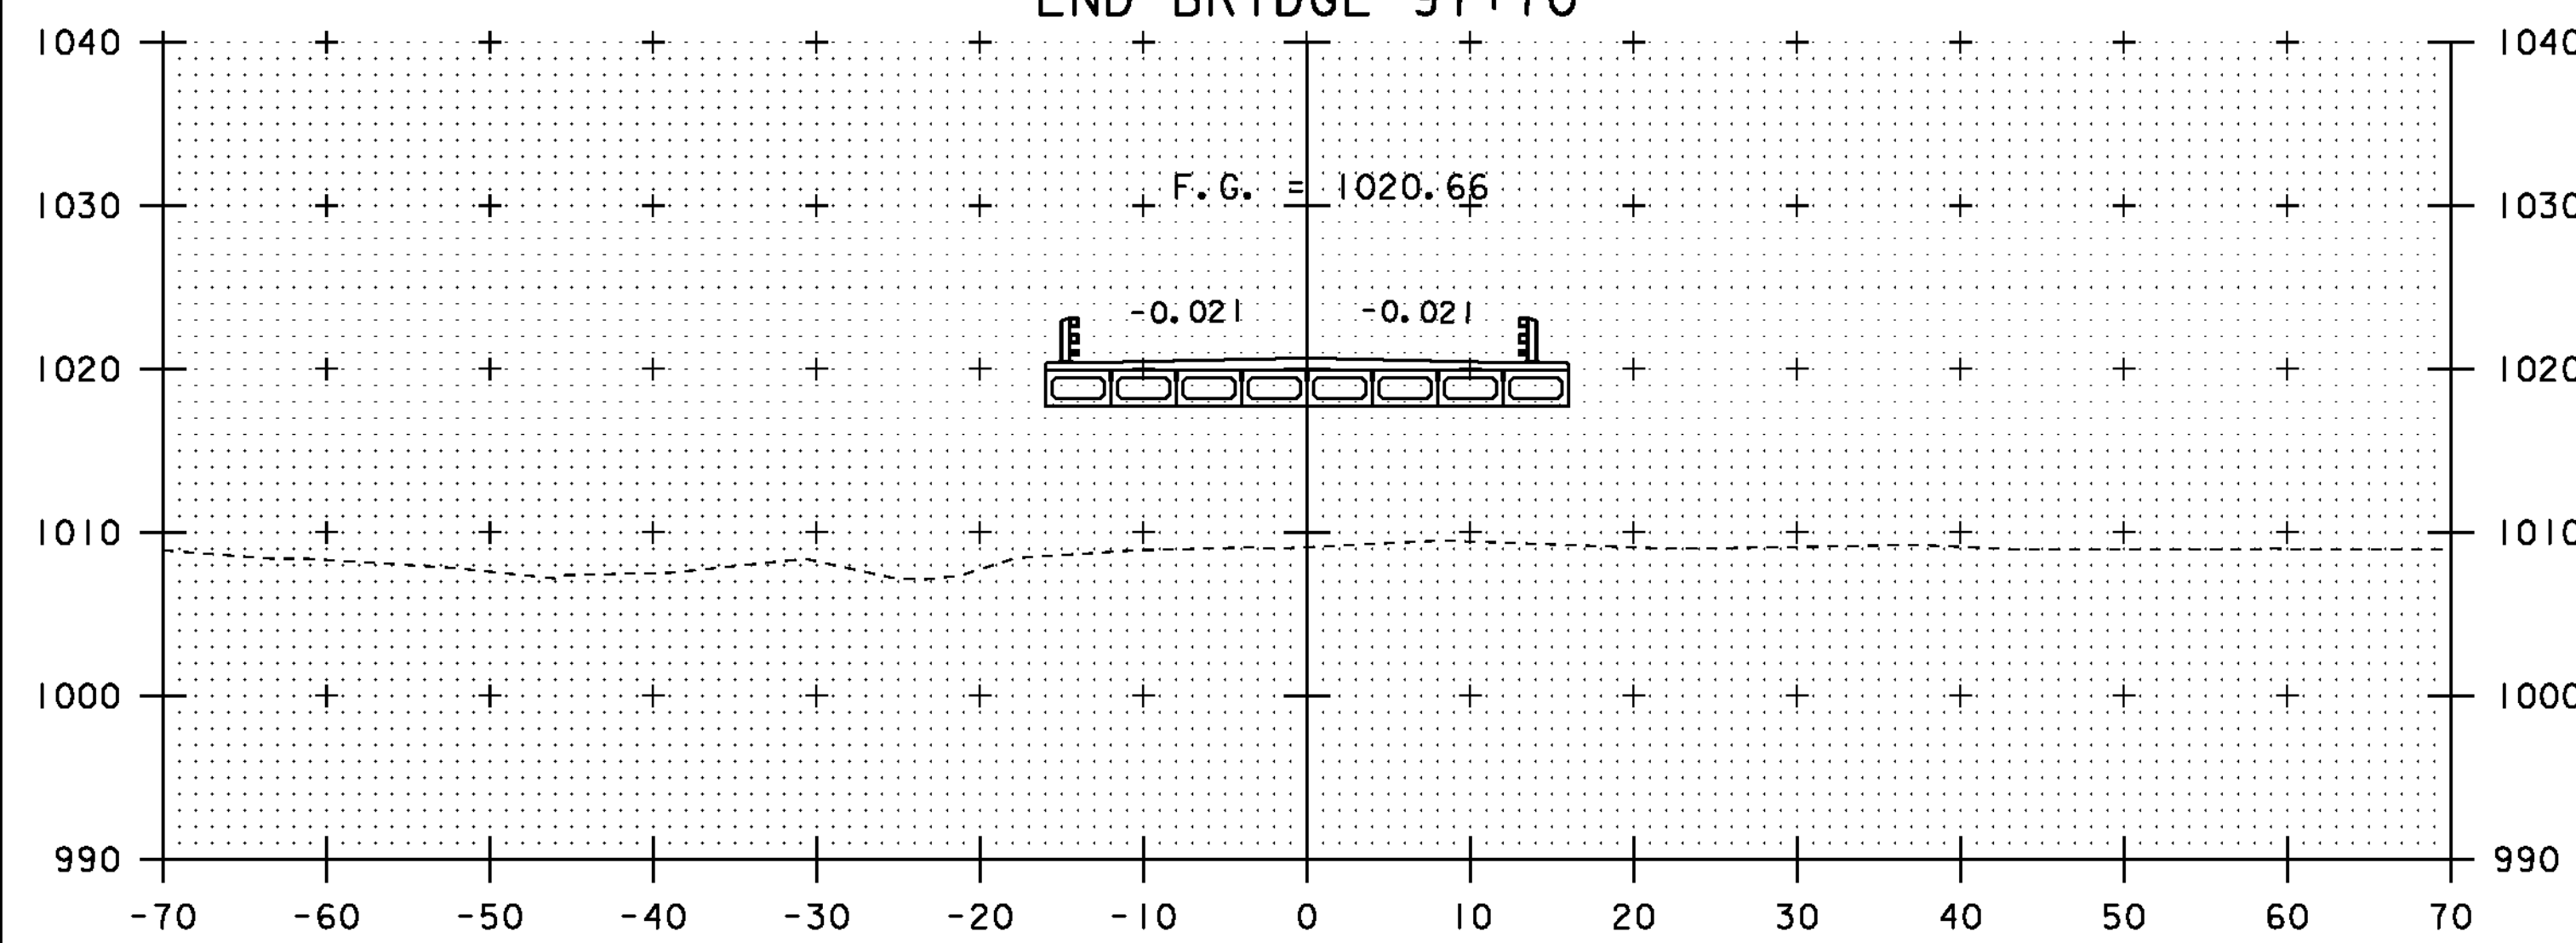


97+50

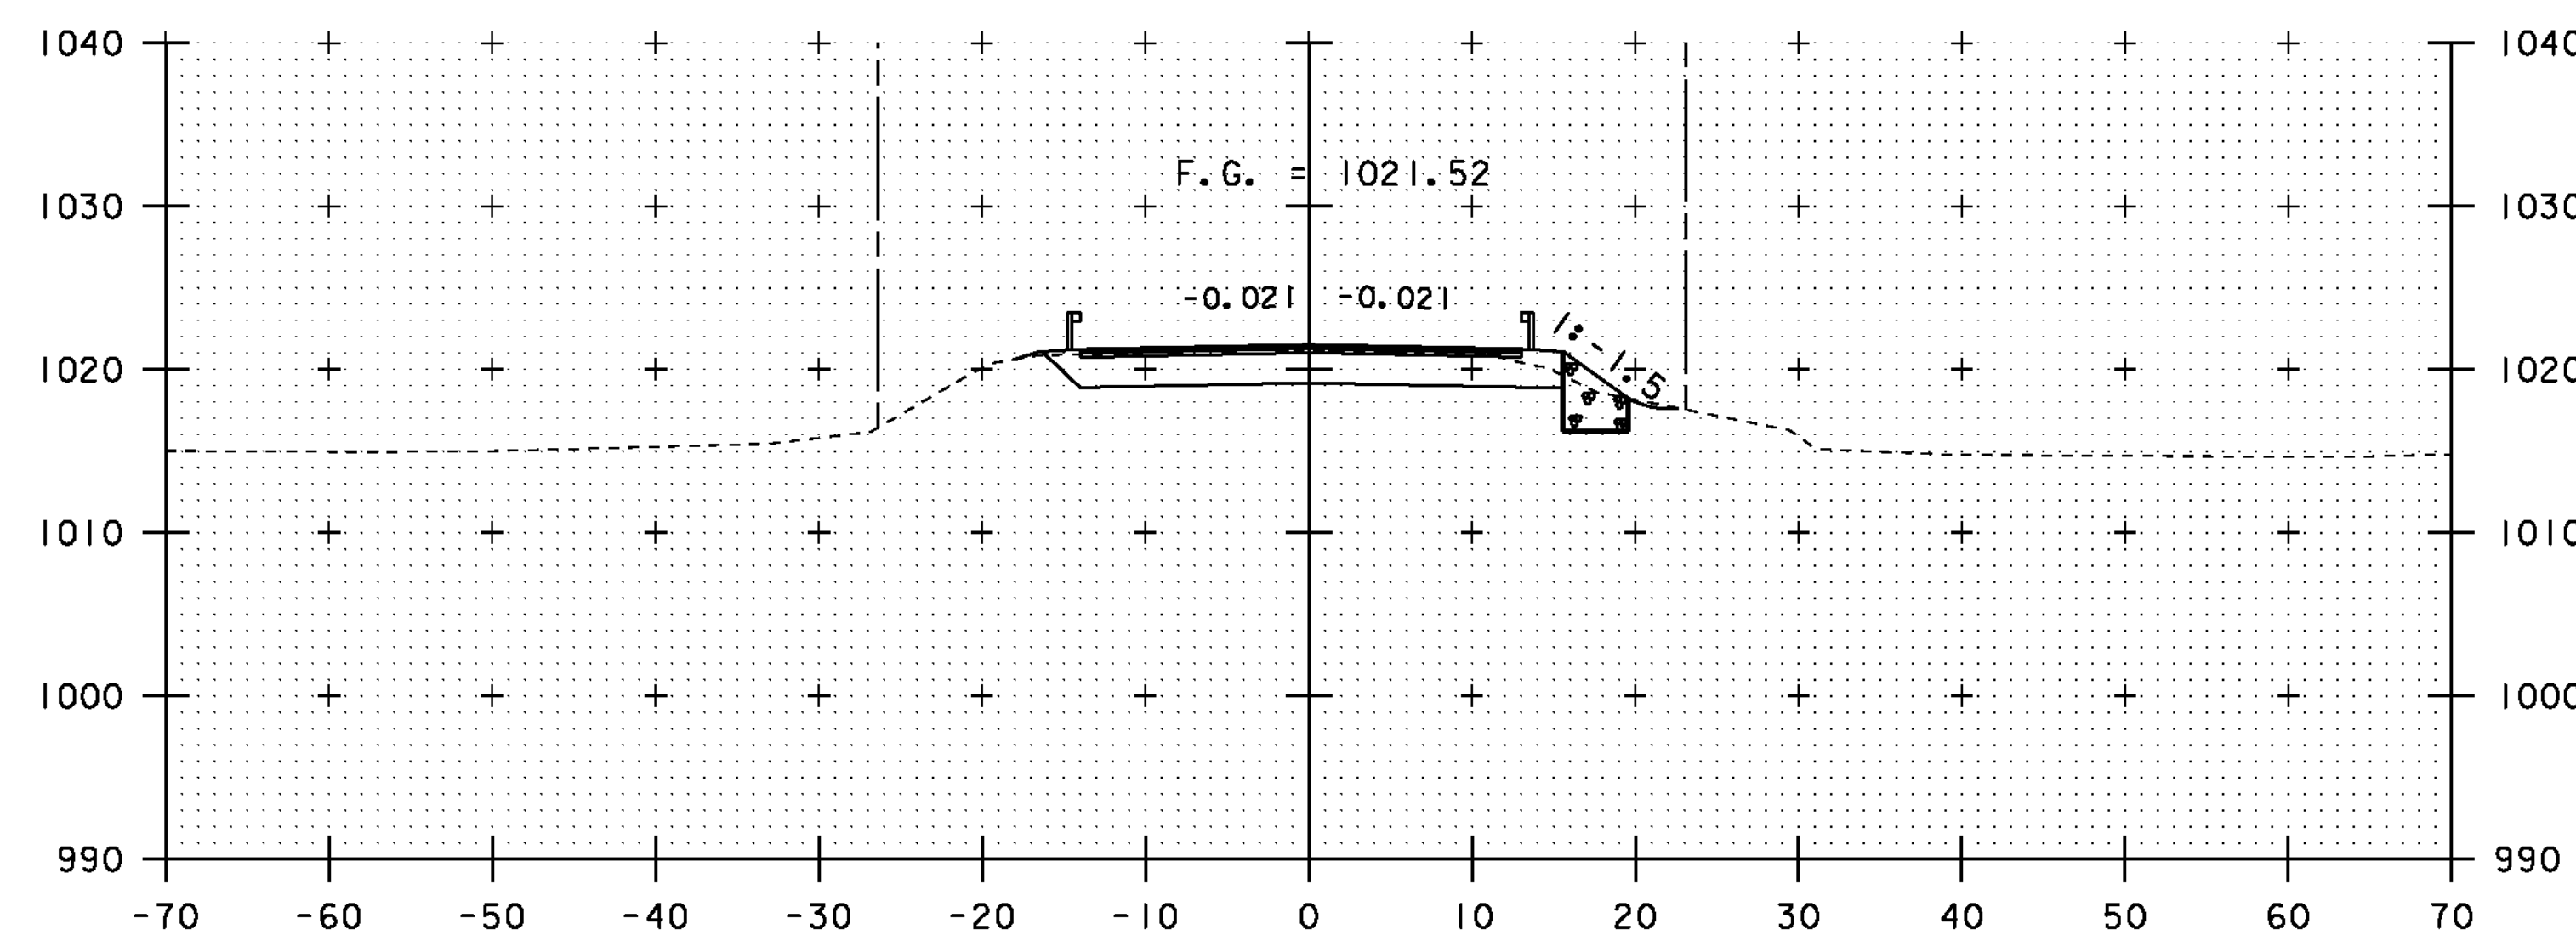

98+25
END PROJECT 98+20

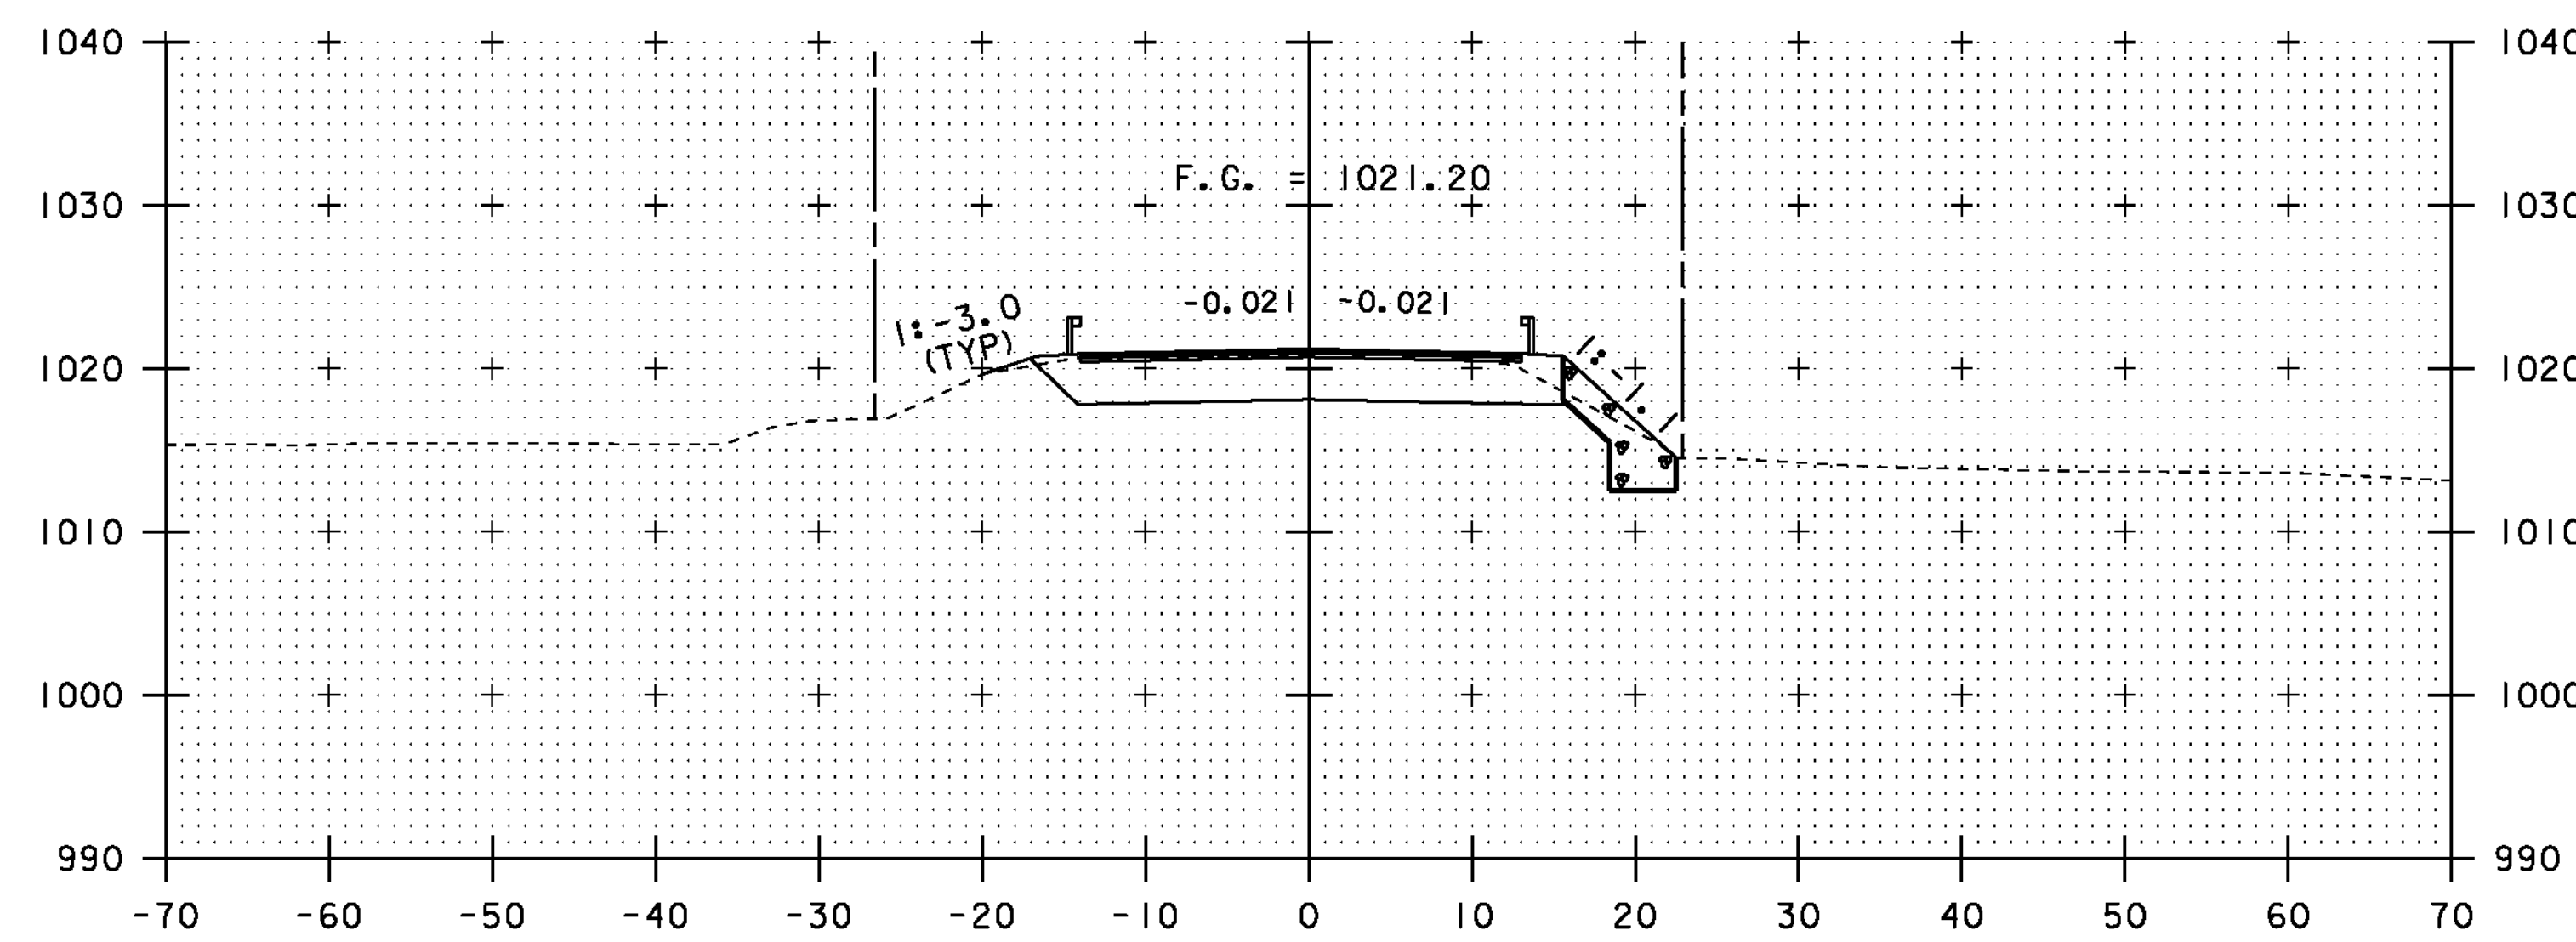


98+00

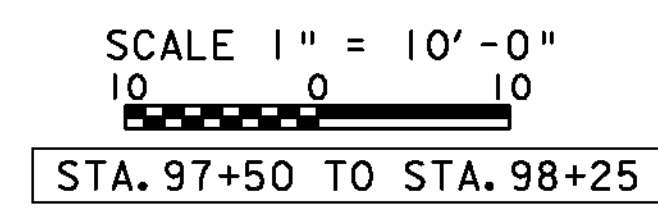


STA. 97+50 TO STA. 98+25


PROJECT NAME: EAST HAVEN	PLOT DATE: 08-AUG-2011
PROJECT NUMBER: BRF 0269(II)	DRAWN BY: R. PELLETT
FILE NAME: s00cl62xs.dgn	CHECKED BY: J. LACROIX
PROJECT LEADER: K. HIGGINS	SHEET 37 OF 40
DESIGNED BY: J. LACROIX	MAINLINE SECTIONS #3

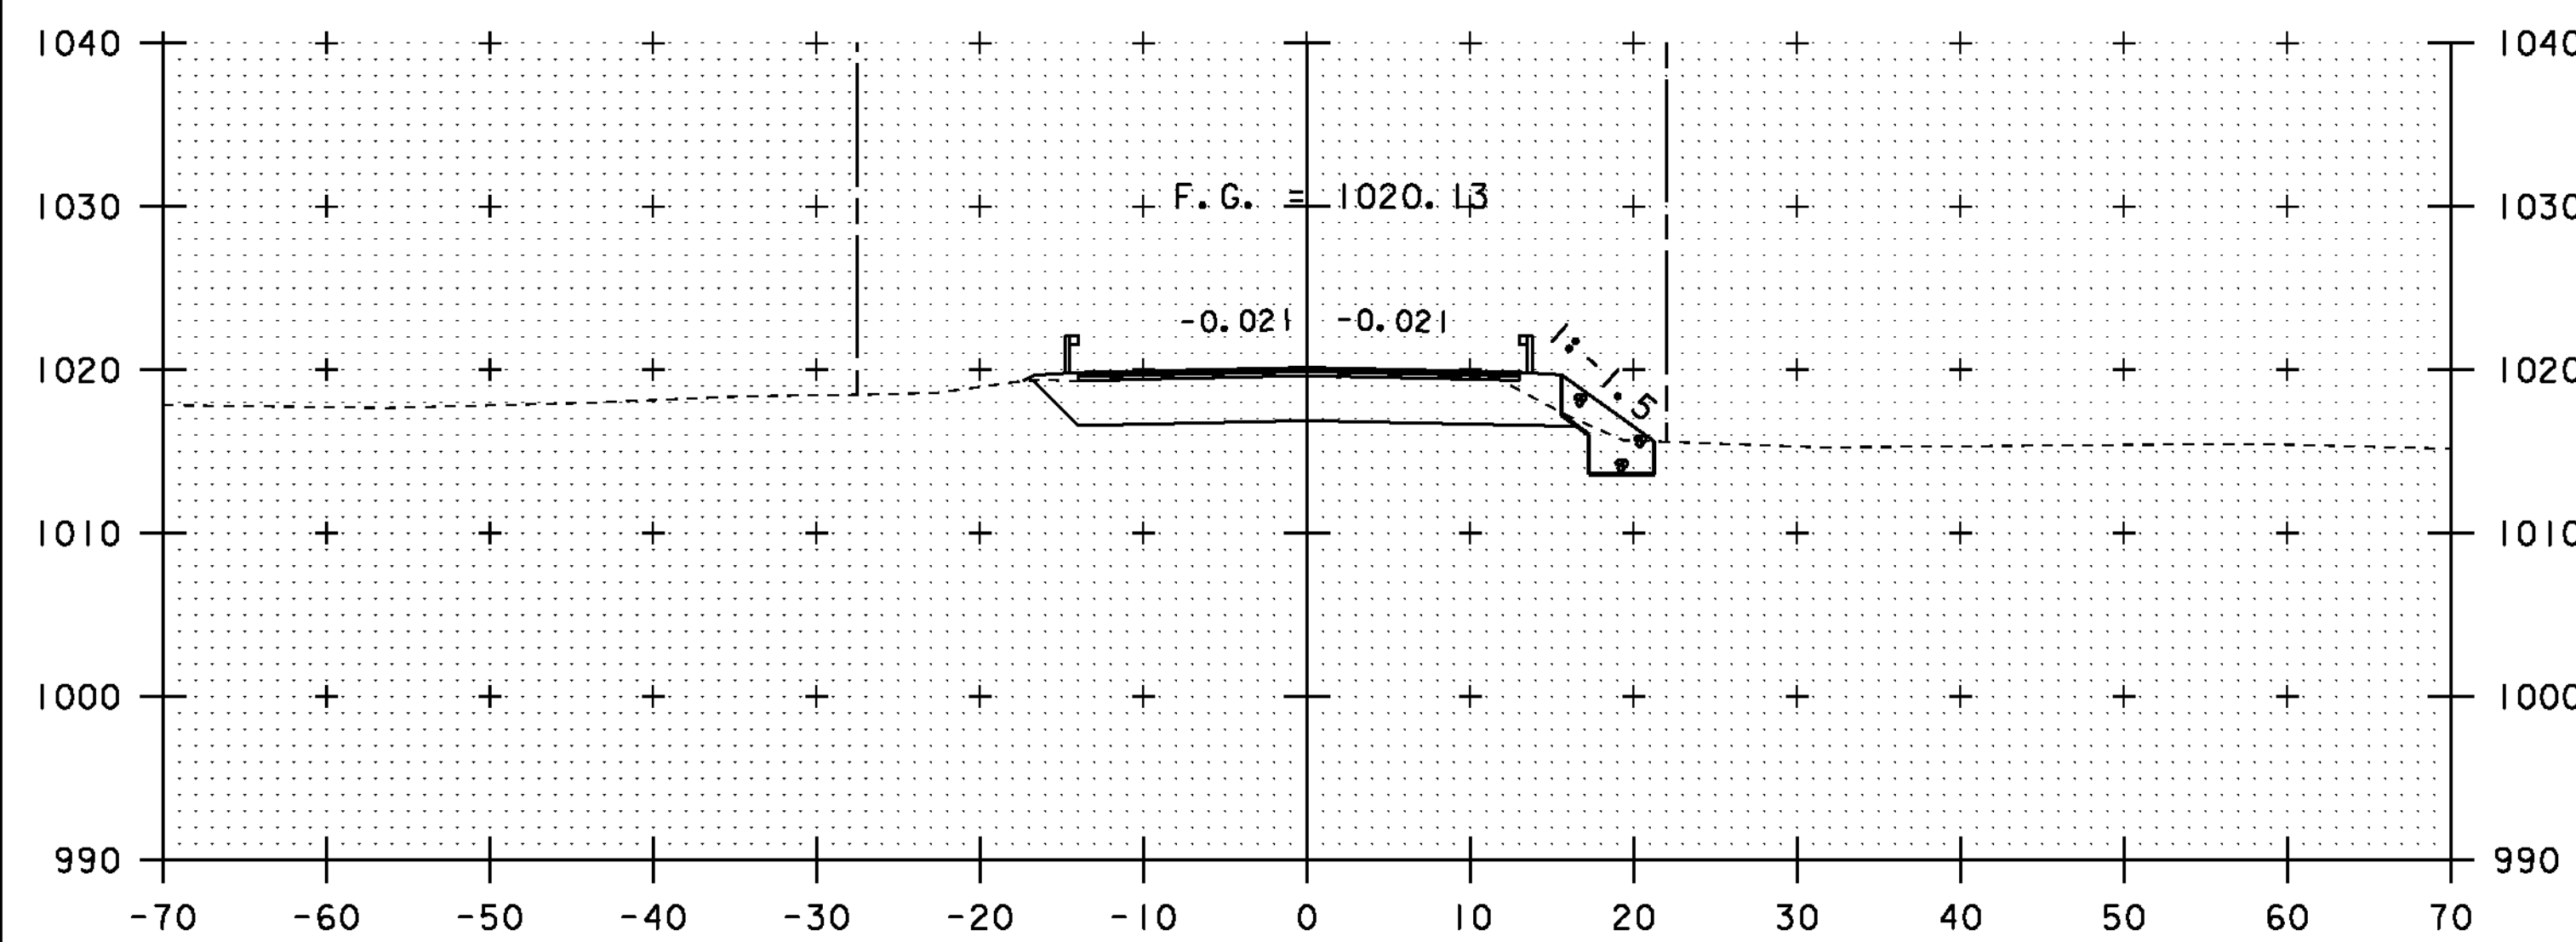


96+75

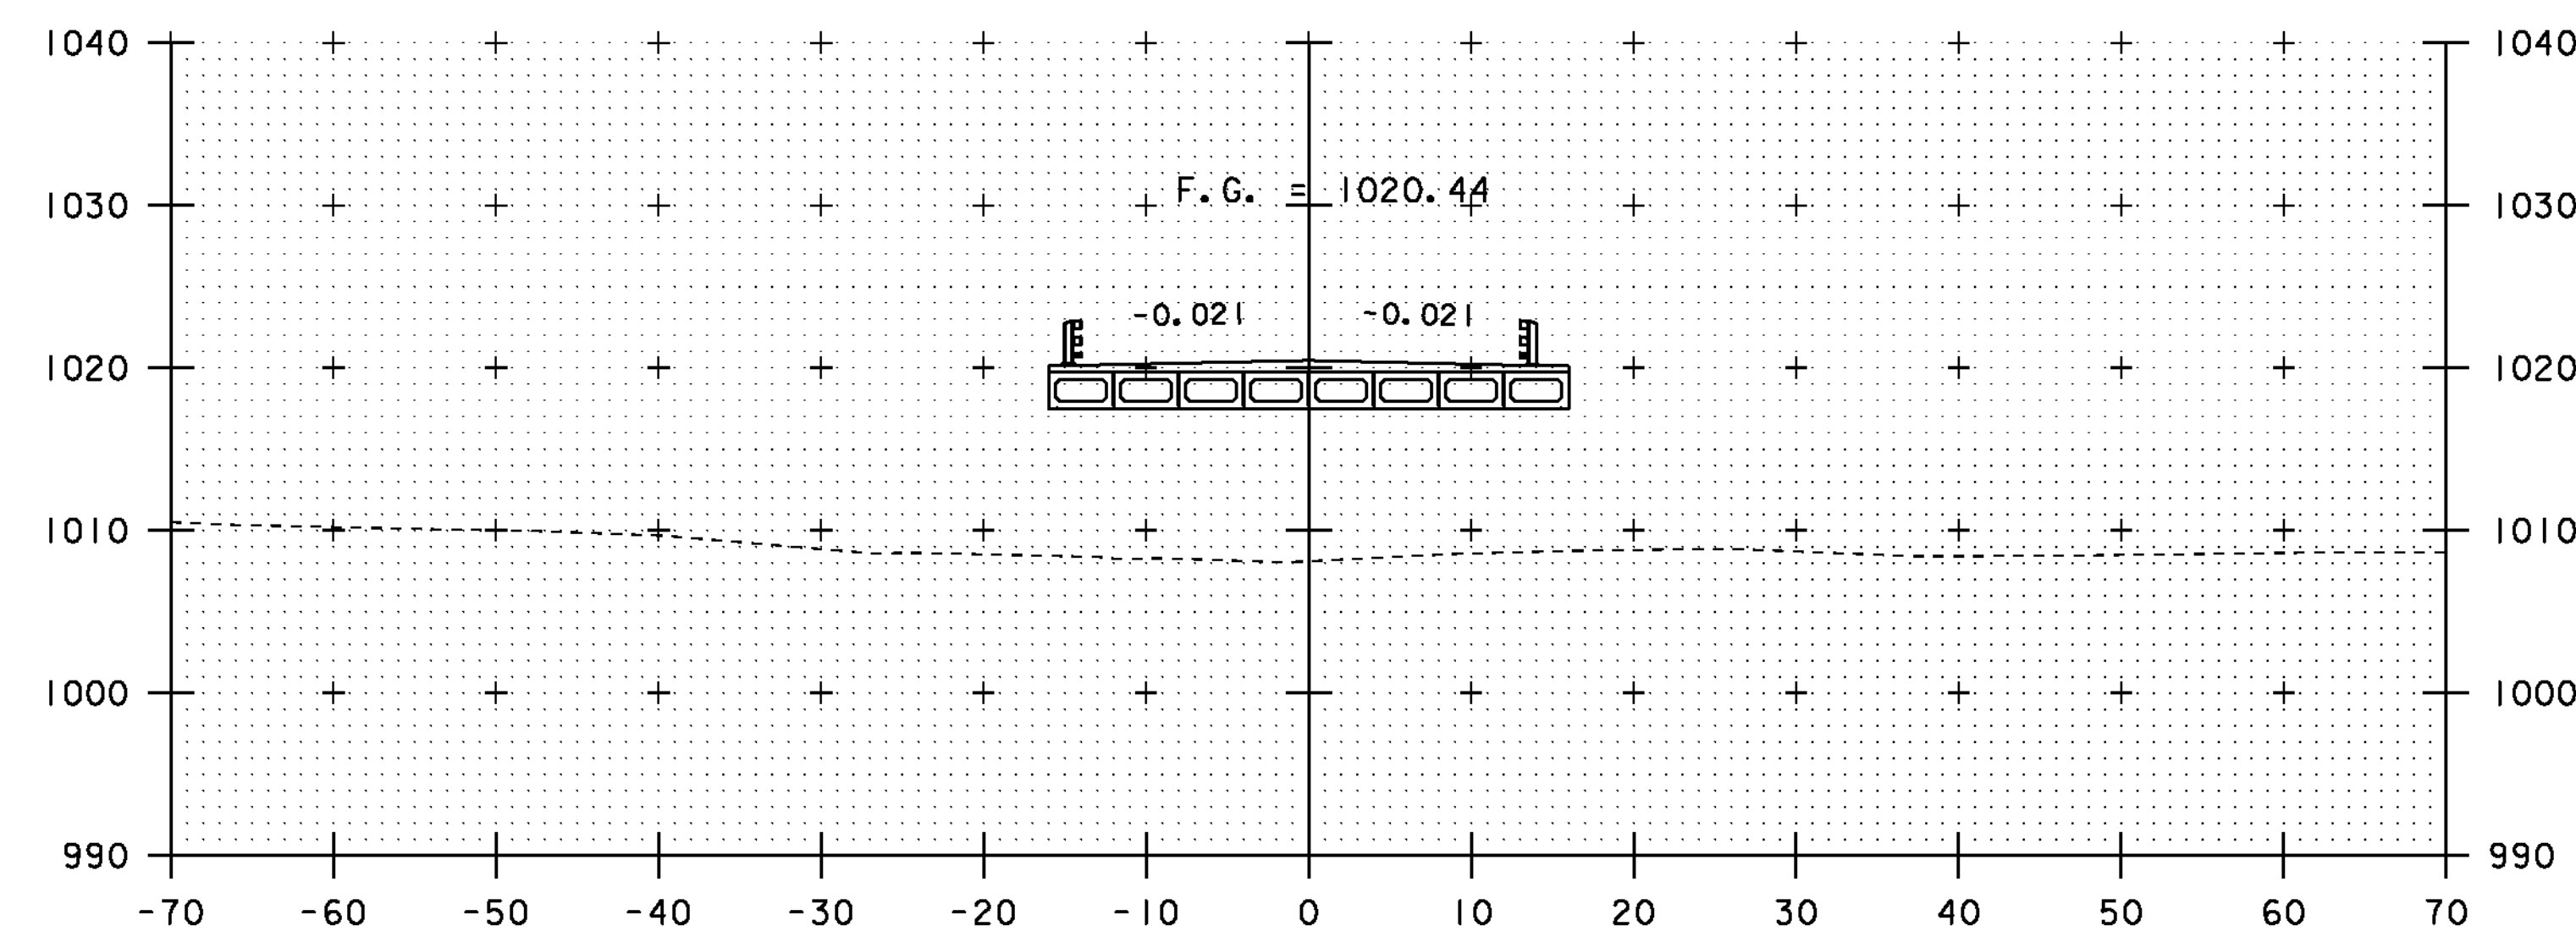


97+25

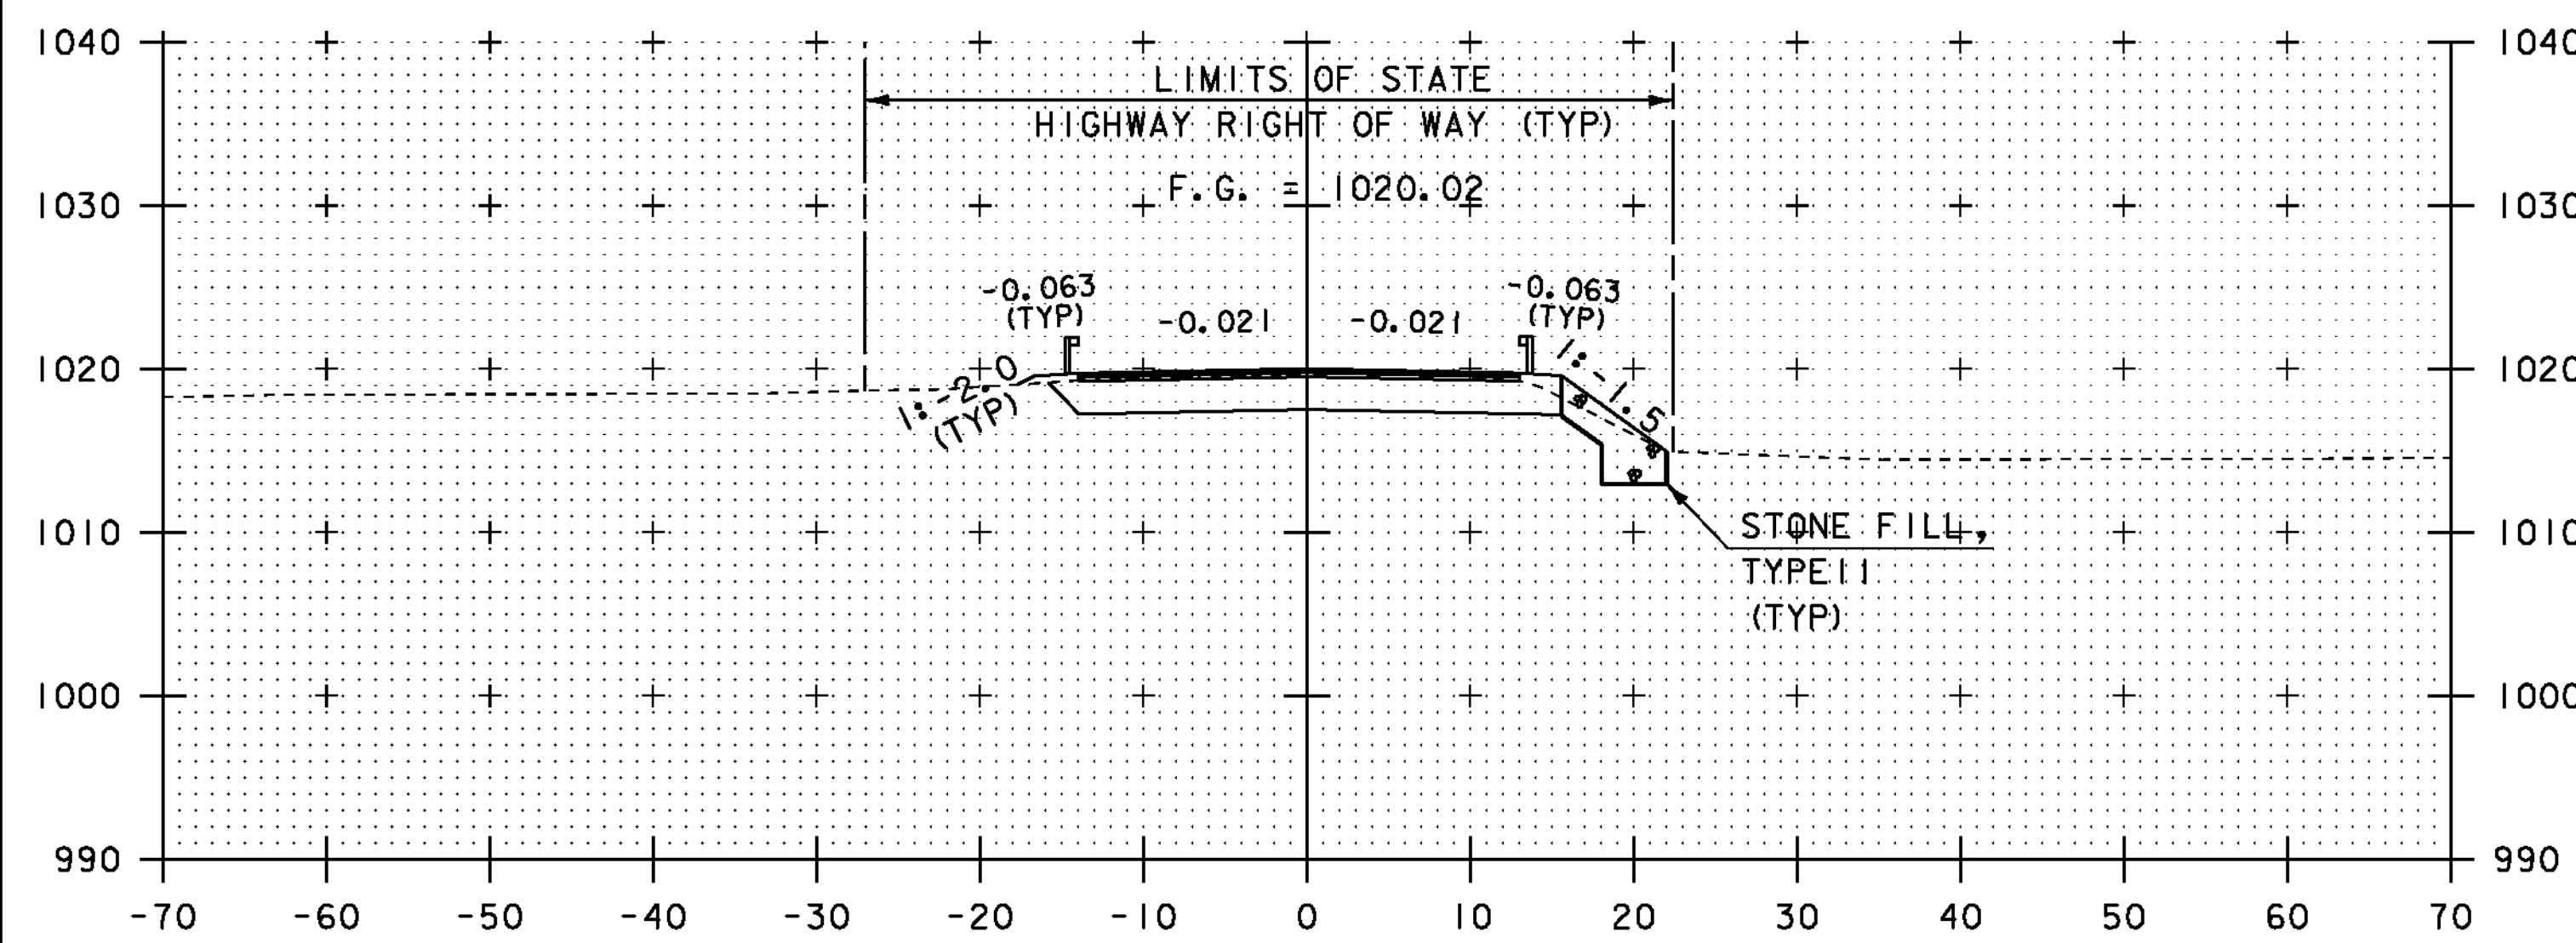


96+50
BEGIN PROJECT

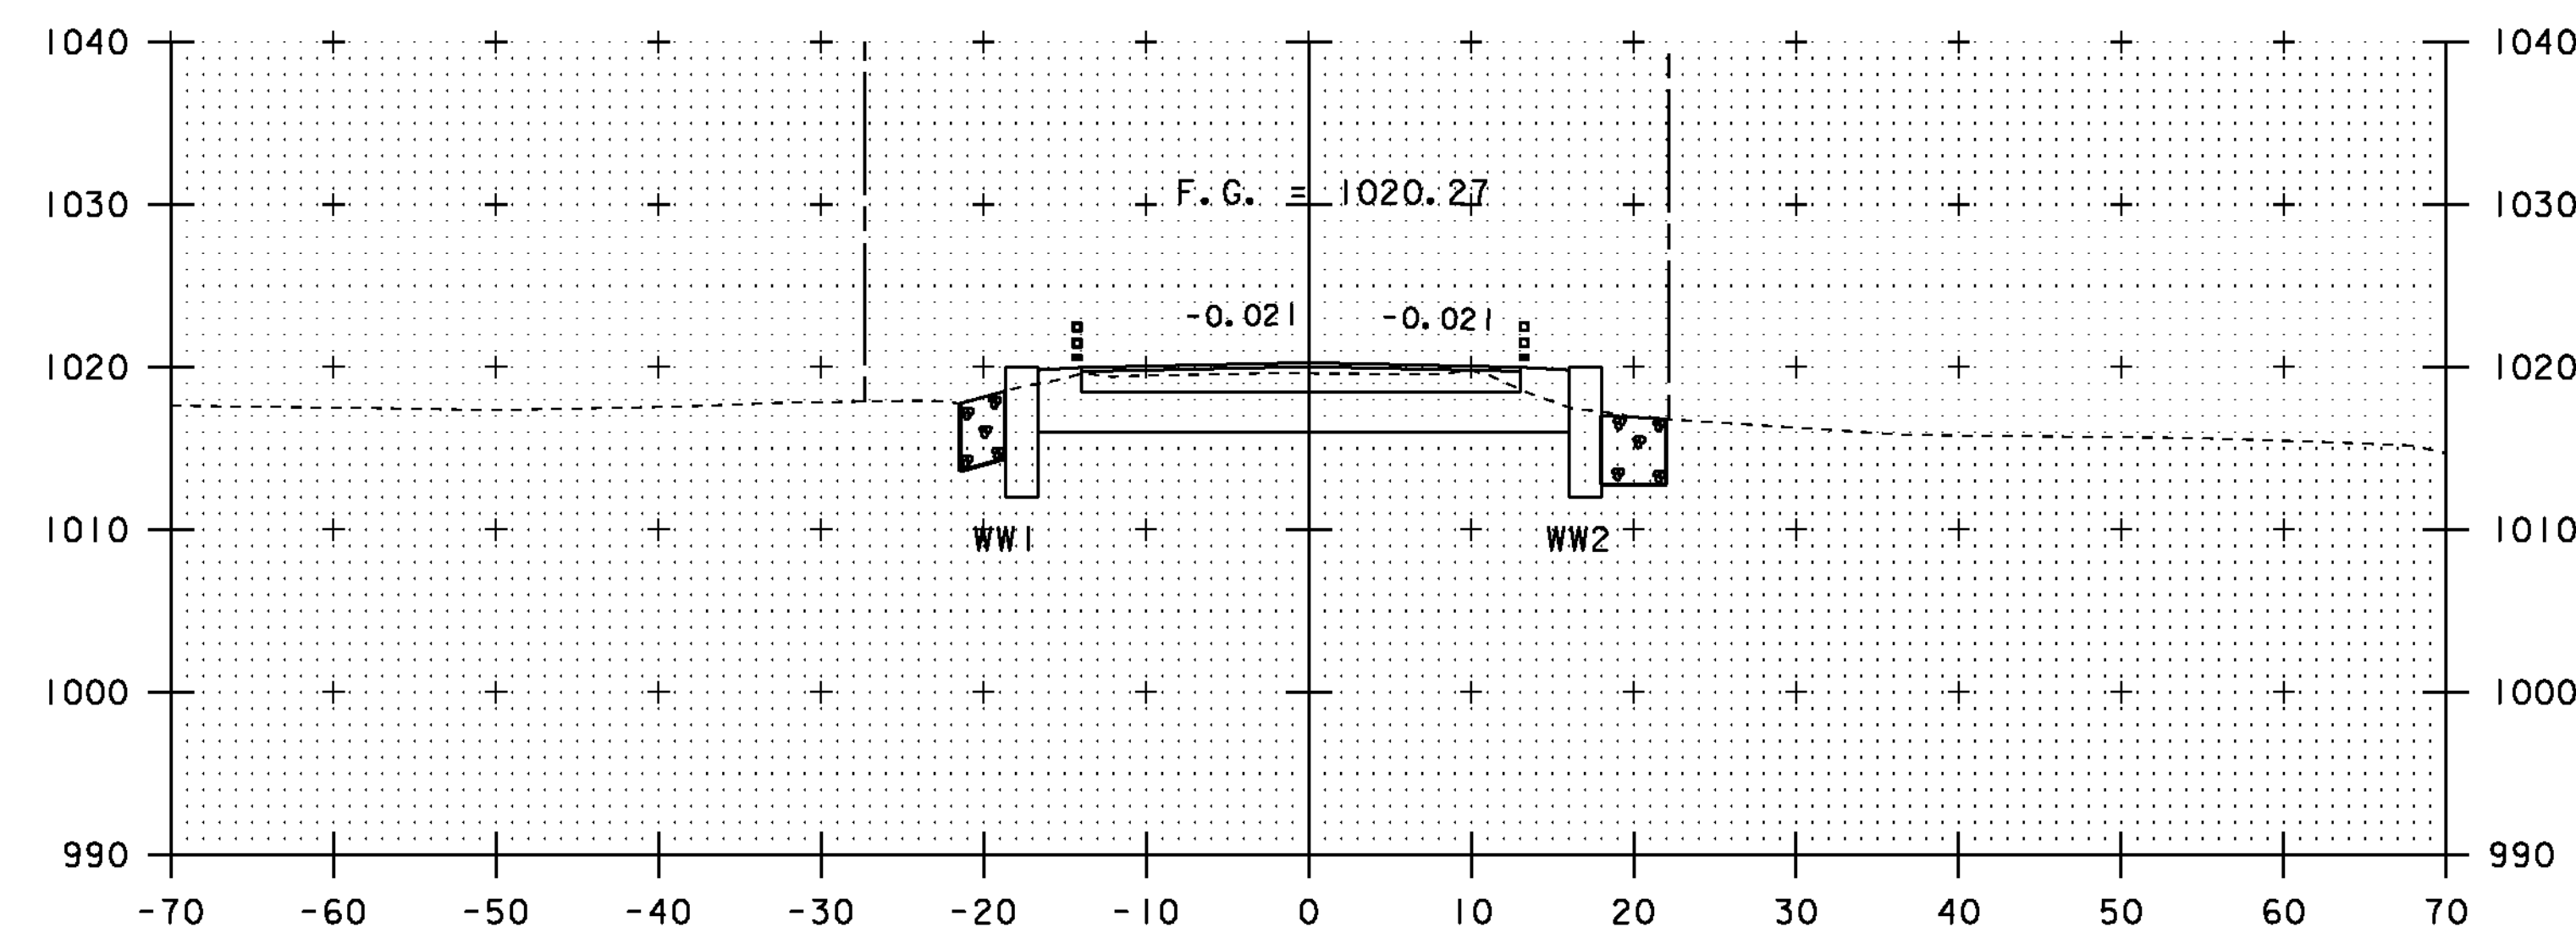


97+00
BEGIN BRIDGE

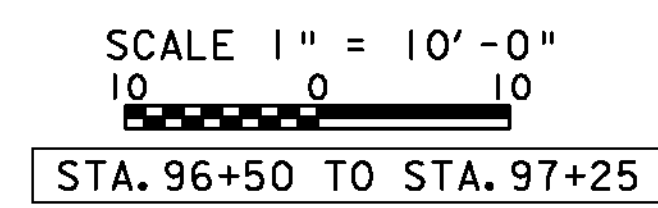


PROJECT NAME:	EAST HAVEN	PLOT DATE:	08-AUG-2011
PROJECT NUMBER:	BRF 0269(II)	DRAWN BY:	R. PELLETT
FILE NAME:	s00cl62xs.dgn	CHECKED BY:	J. LACROIX
PROJECT LEADER:	K. HIGGINS	SHEET	36 OF 40
DESIGNED BY:	J. LACROIX	MAINLINE SECTIONS #2	

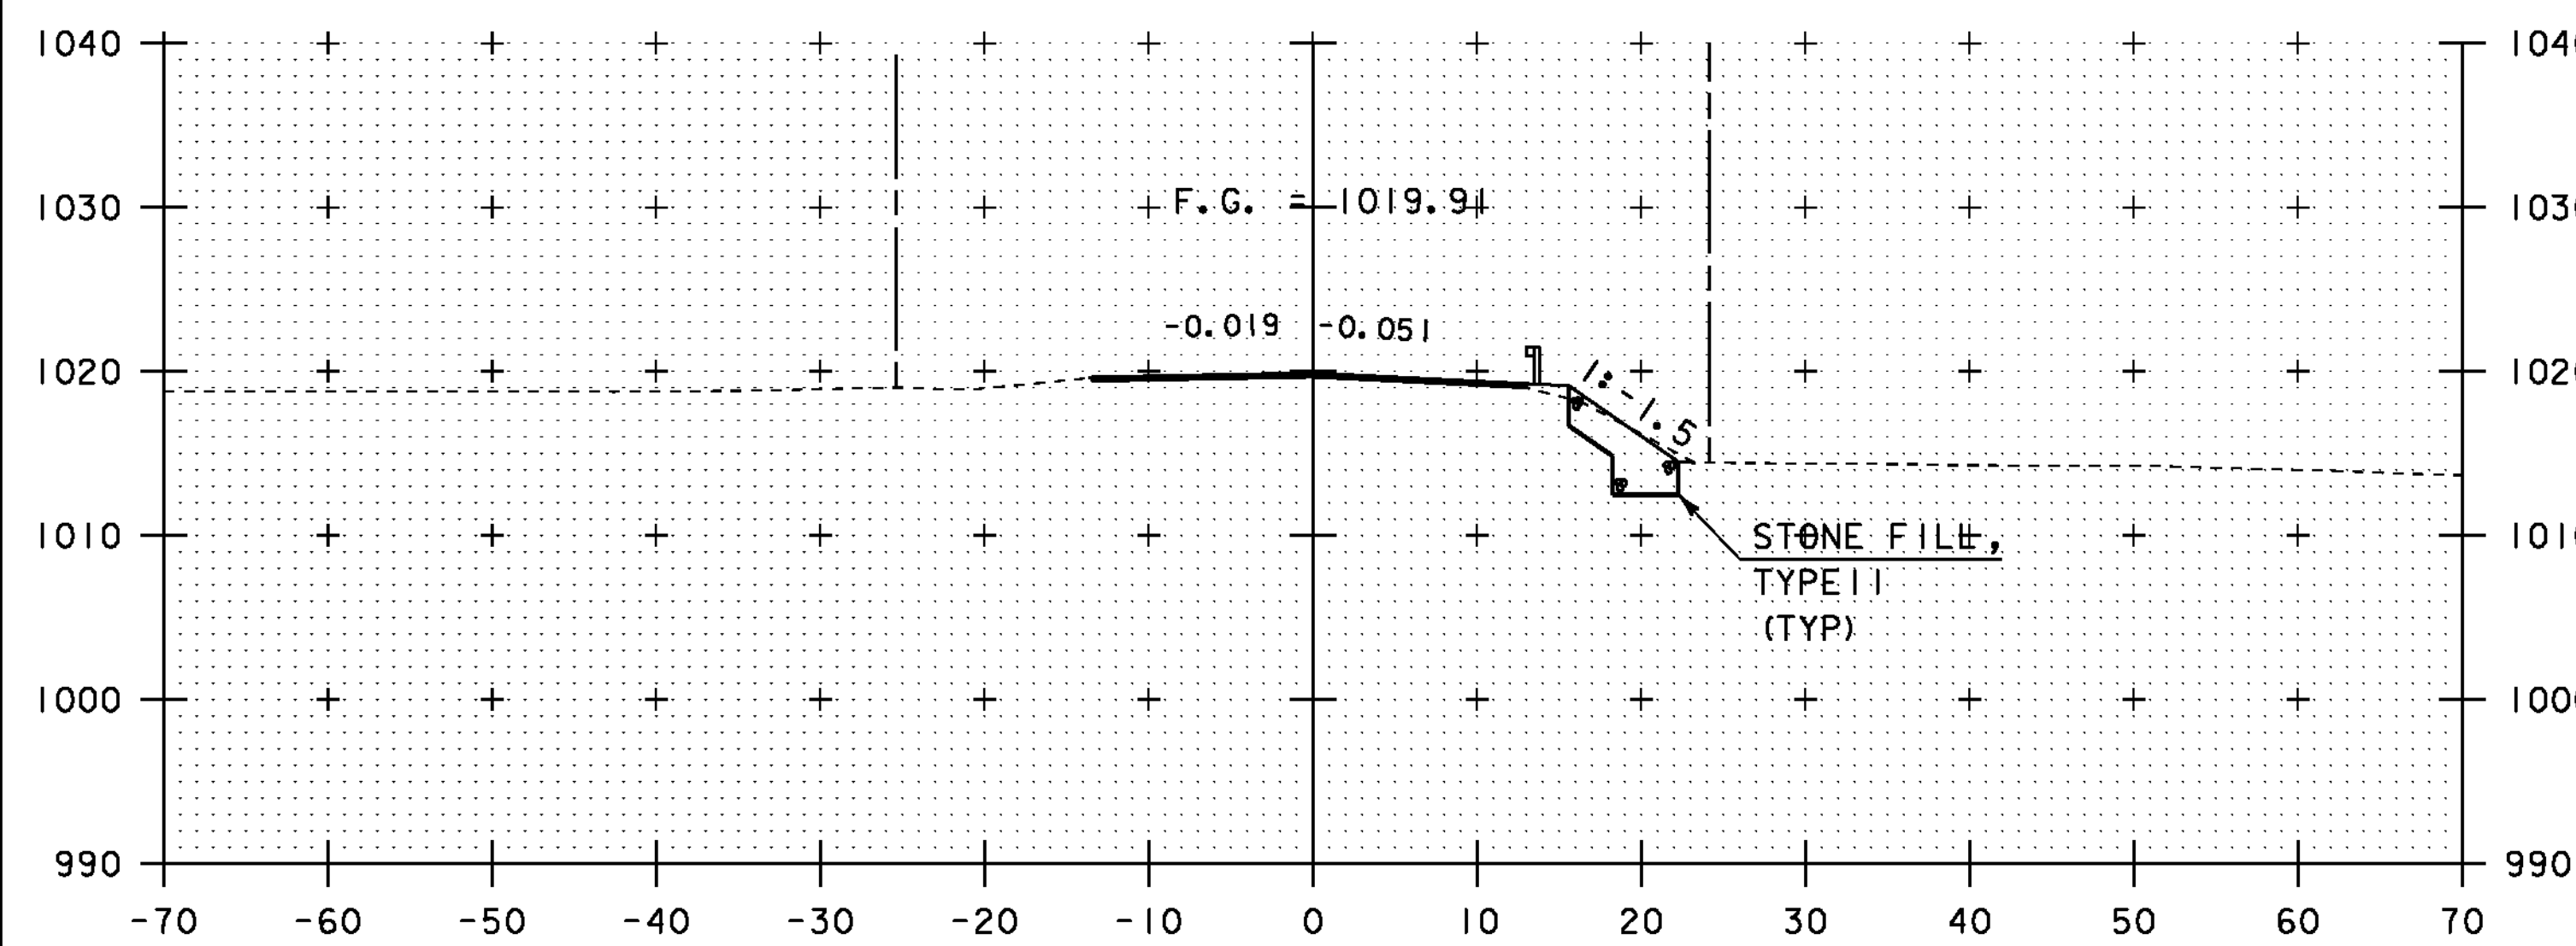


95+75

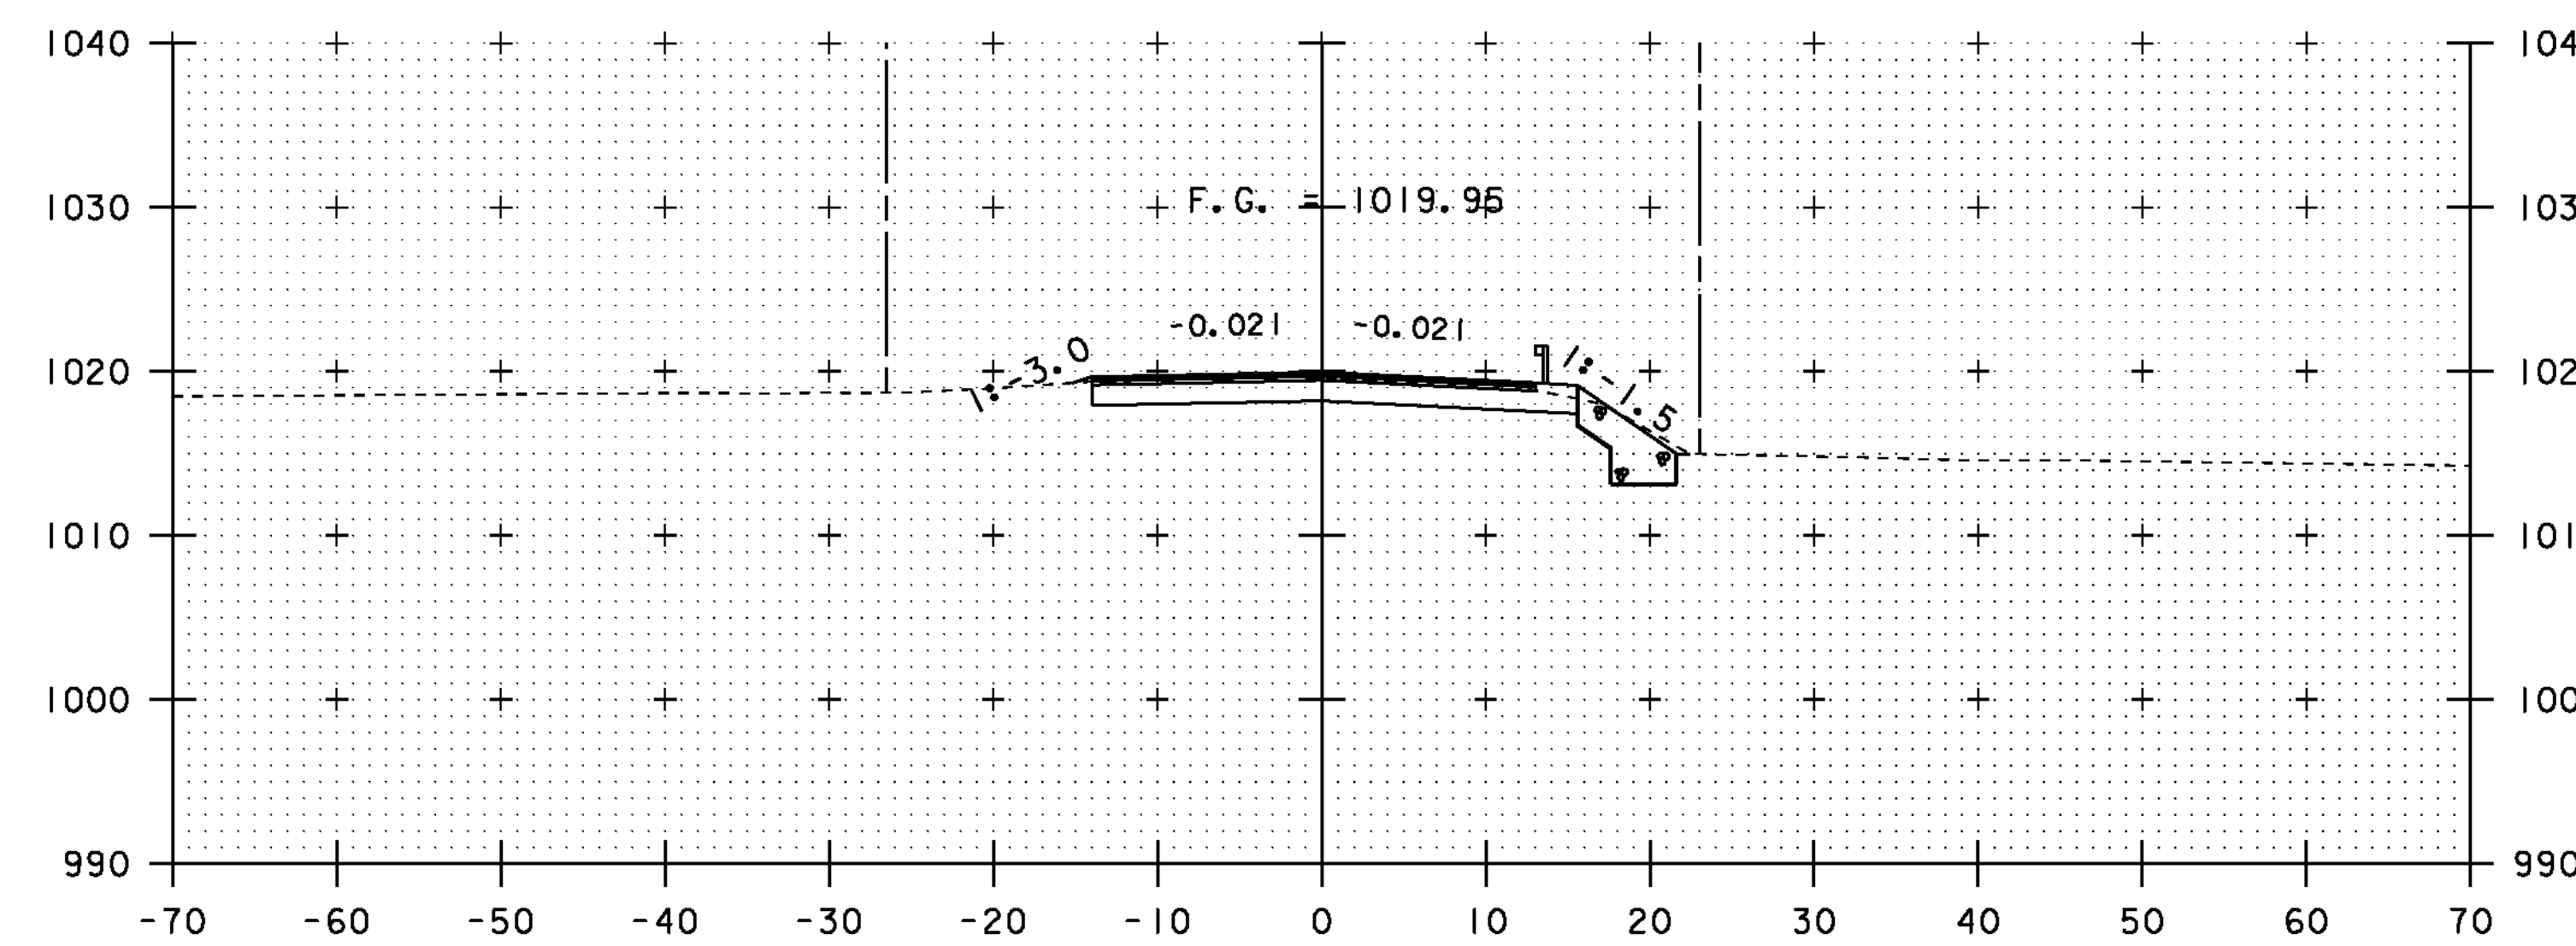


96+25

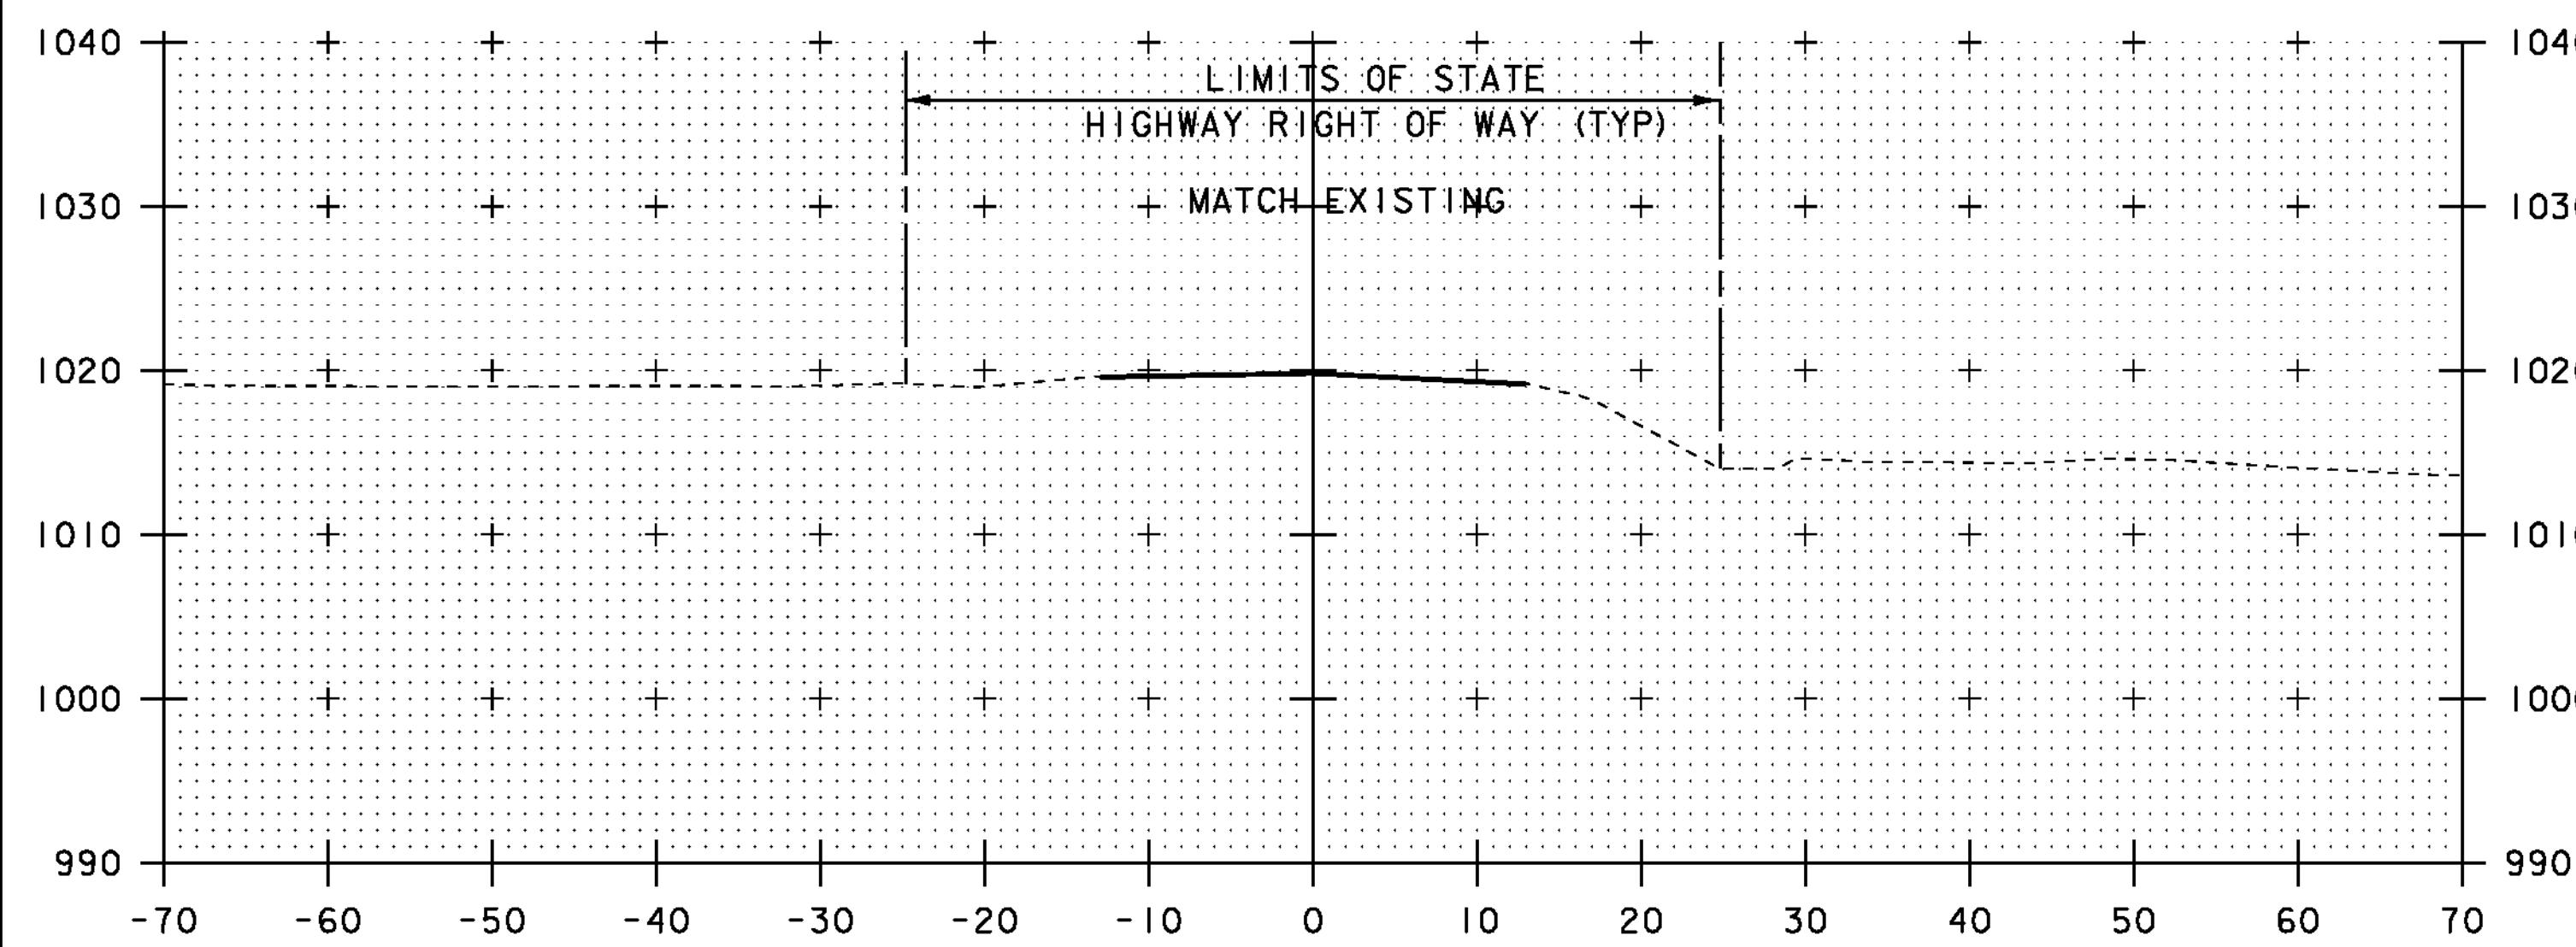


95+50
BEGIN APPROACH

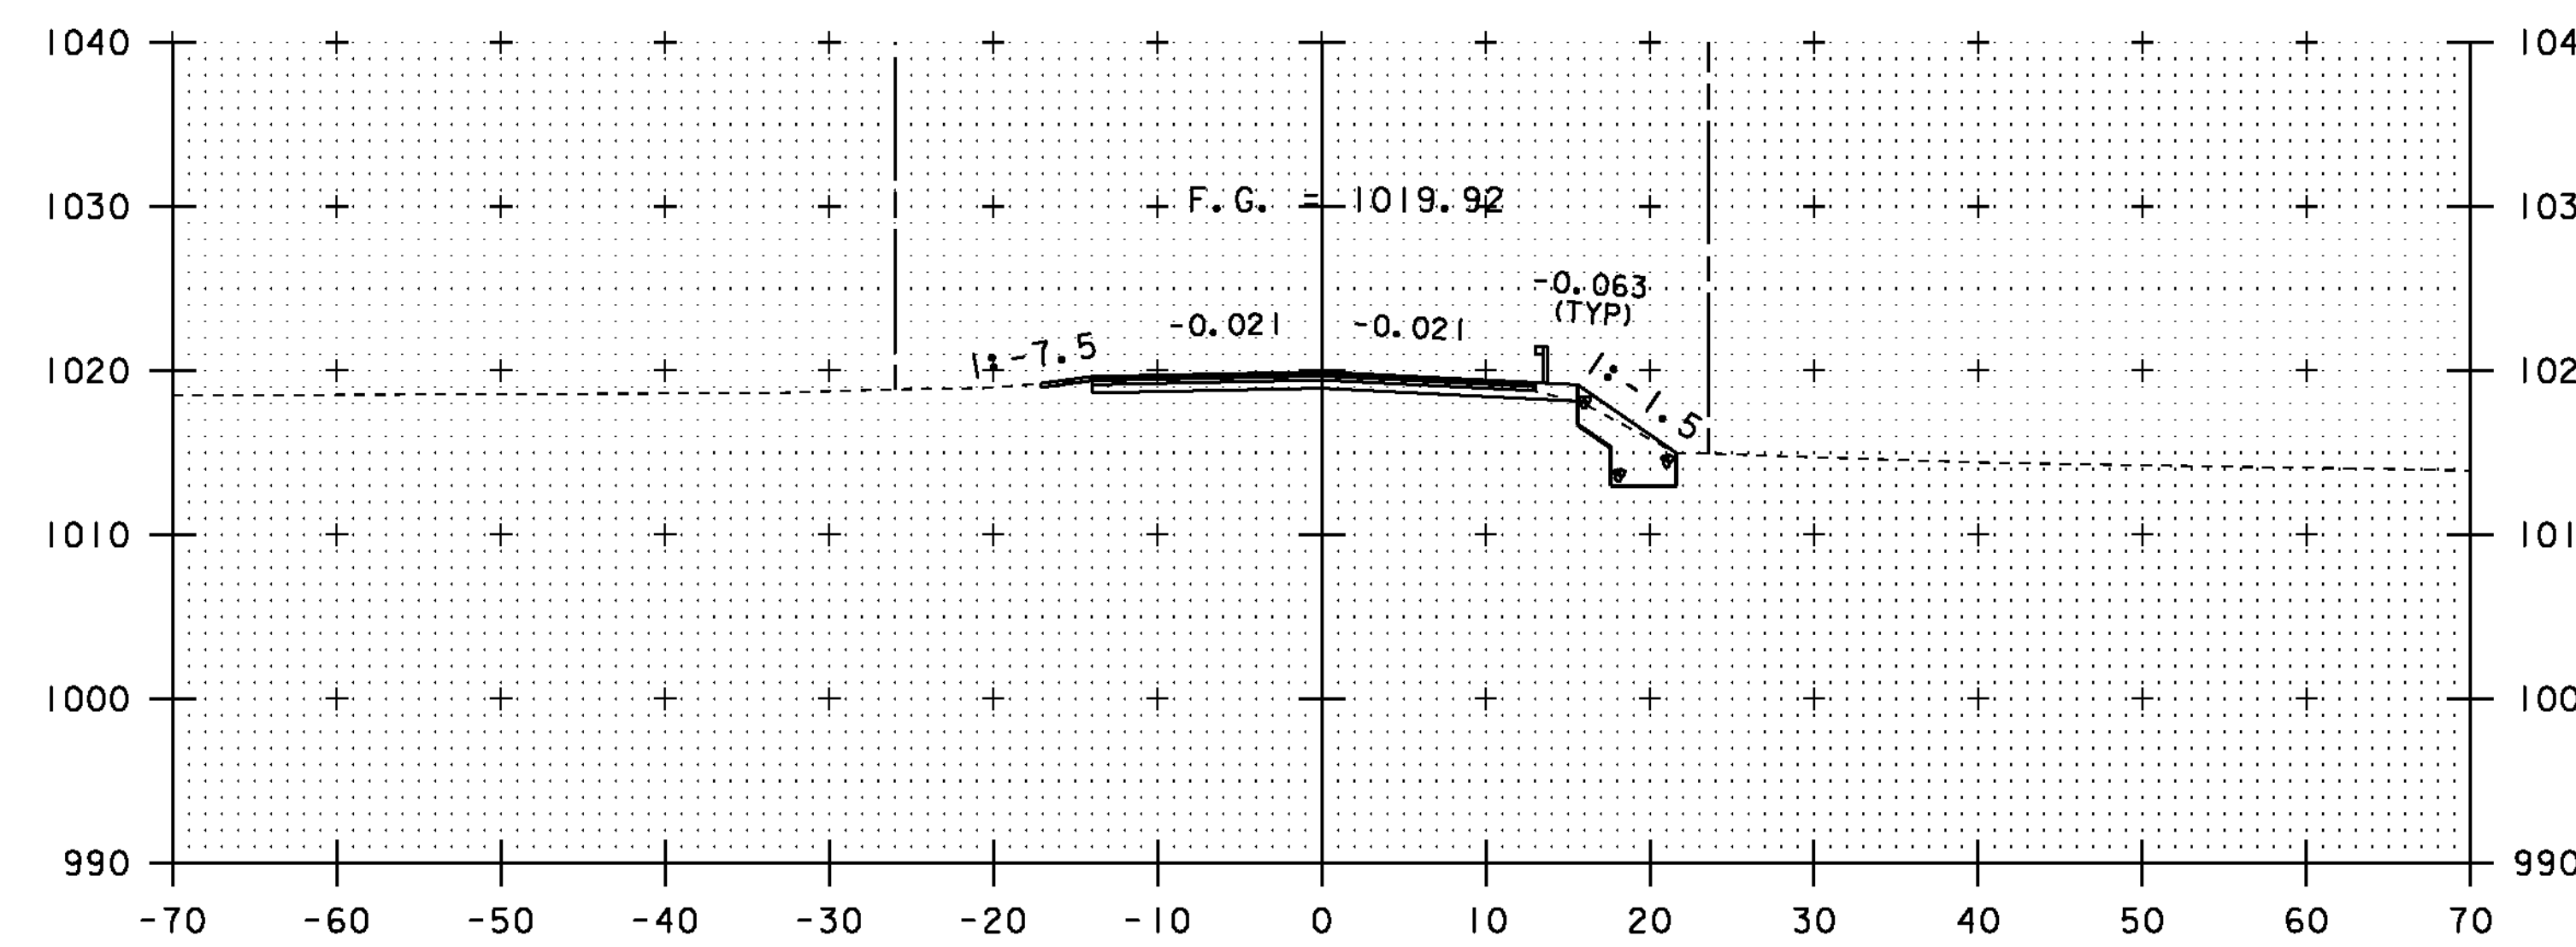

96+00

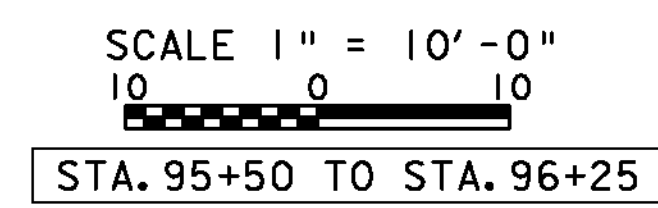

PROJECT NAME: EAST HAVEN	PLOT DATE: 08-AUG-2011
PROJECT NUMBER: BRF 0269(II)	DRAWN BY: R. PELLETT
FILE NAME: s00cl62xs.dgn	CHECKED BY: J. LACROIX
PROJECT LEADER: K. HIGGINS	SHEET 35 OF 40
DESIGNED BY: J. LACROIX	
MAINLINE SECTIONS #1	

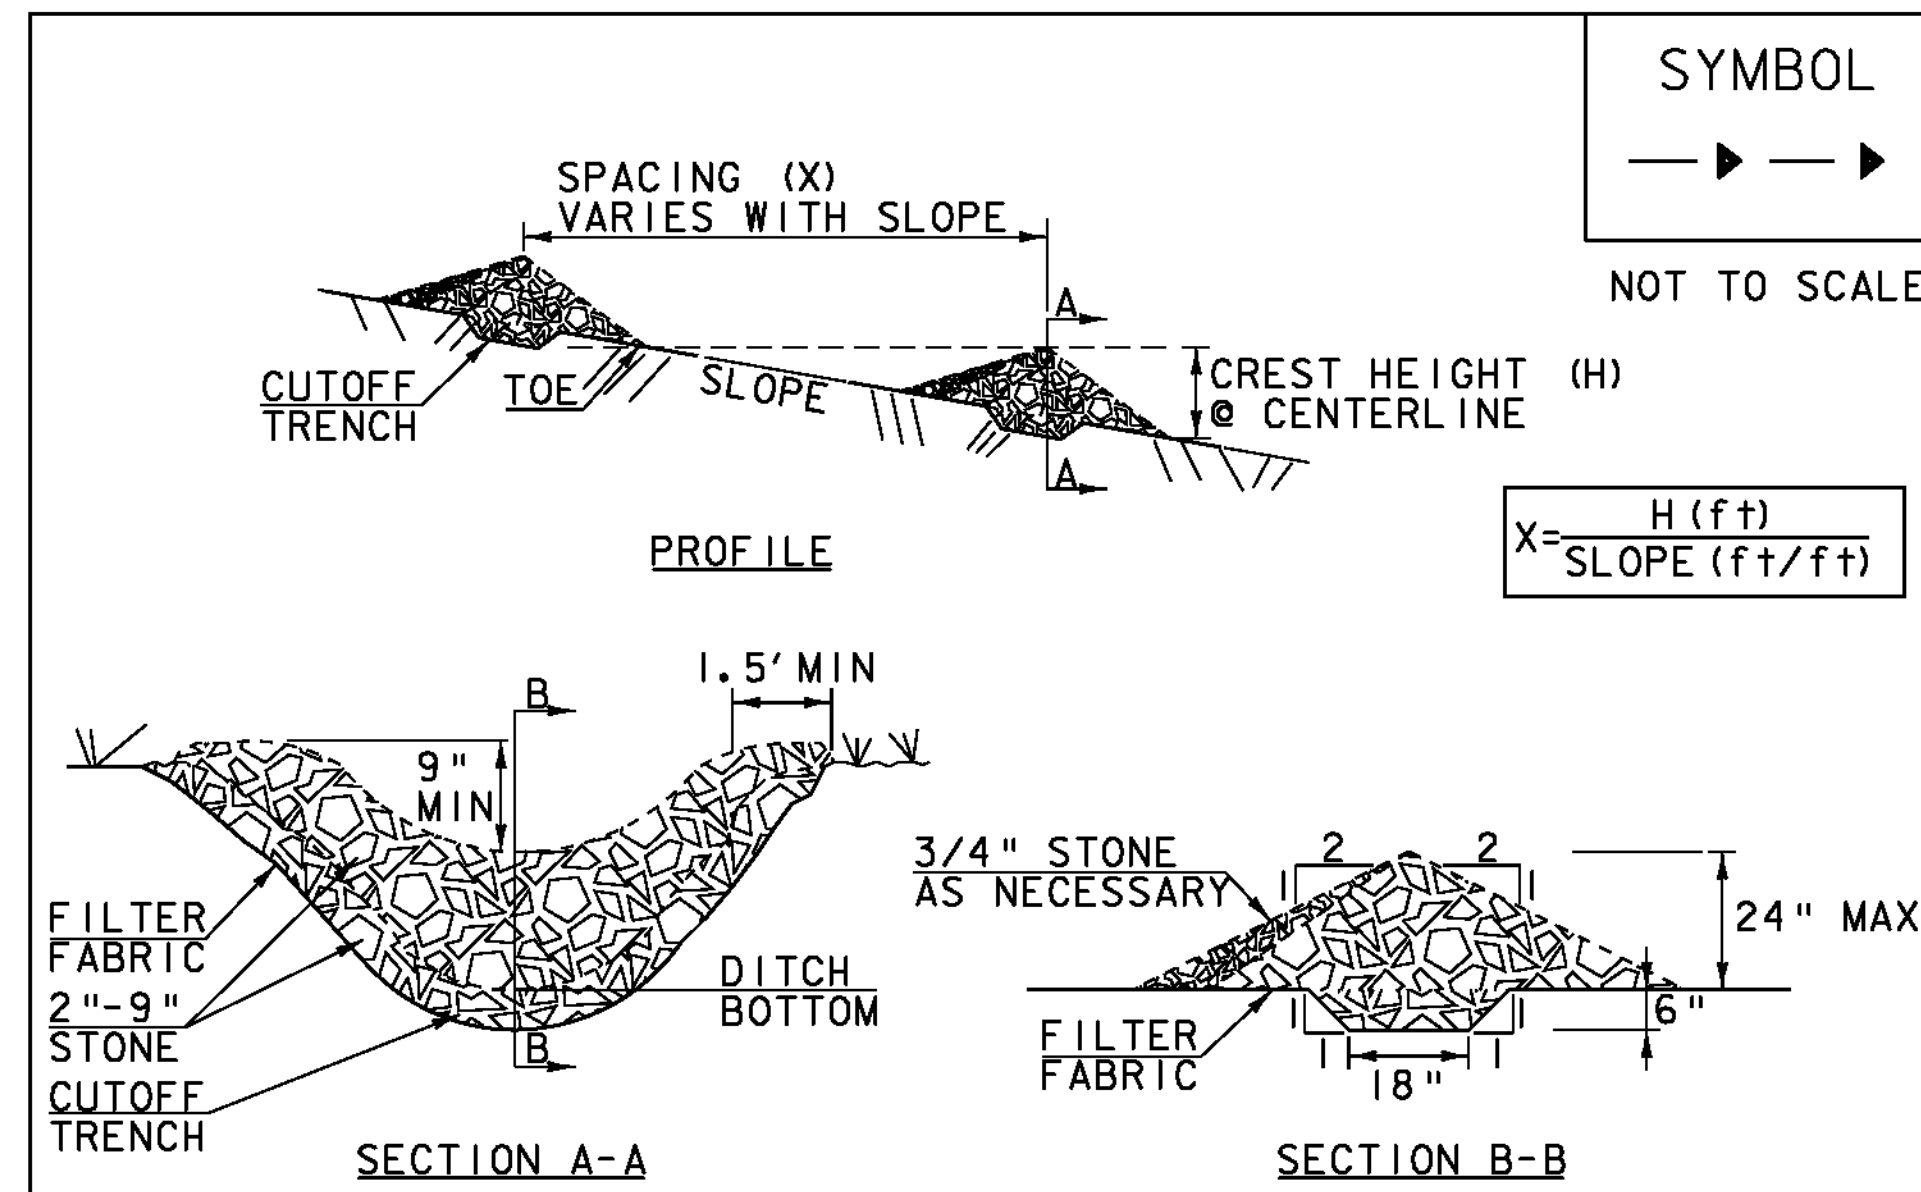

CONSTRUCTION SPECIFICATIONS

1. STONE WILL BE PLACED ON A FILTER FABRIC FOUNDATION.
2. CHECK DAMS SHALL BE SPACED SO THAT THE ELEVATION OF THE CREST OF THE DOWNSTREAM DAM IS AT THE SAME ELEVATION AS THE TOE OF THE UPSTREAM DAM.
3. 3/4" FILTERING STONE MAY BE ADDED TO THE FACE OF THE CHECK DAM AS NECESSARY.
4. EXTEND THE STONE A MINIMUM OF 1.5' BEYOND THE DITCH BANKS TO PREVENT CUTTING AROUND THE DAM.
5. PROTECT CHANNEL DOWNSTREAM OF THE LOWEST CHECK DAM FROM SCOUR AND EROSION WITH STONE OR LINER AS APPROPRIATE.
6. ENSURE THAT CHANNEL APPURTENANCES SUCH AS CULVERT ENTRANCES BELOW CHECK DAMS ARE NOT SUBJECT TO DAMAGE OR BLOCKAGE FROM DISPLACED STONE.
7. MAXIMUM DRAINAGE AREA 2 ACRES.


ADAPTED FROM DETAILS PROVIDED BY: NEW YORK STATE DEC
ORIGINALLY DEVELOPED BY USDA-NRCS
VERMONT DEPARTMENT OF ENVIRONMENTAL CONSERVATION

CHECK DAM

NOTES:
REFER TO "THE VERMONT STANDARDS & SPECIFICATIONS FOR EROSION PREVENTION & SEDIMENT CONTROL -2006-" FROM THE VT AGENCY OF NATURAL RESOURCES FOR ADDITIONAL GUIDANCE.

THIS WORK SHALL BE PERFORMED IN ACCORDANCE WITH SECTION 653 FOR TEMPORARY STONE CHECK DAM, TYPE I (PAY ITEM 653.25)

REVISIONS	
MARCH 21, 2008	WHF
JANUARY 8, 2009	WHF

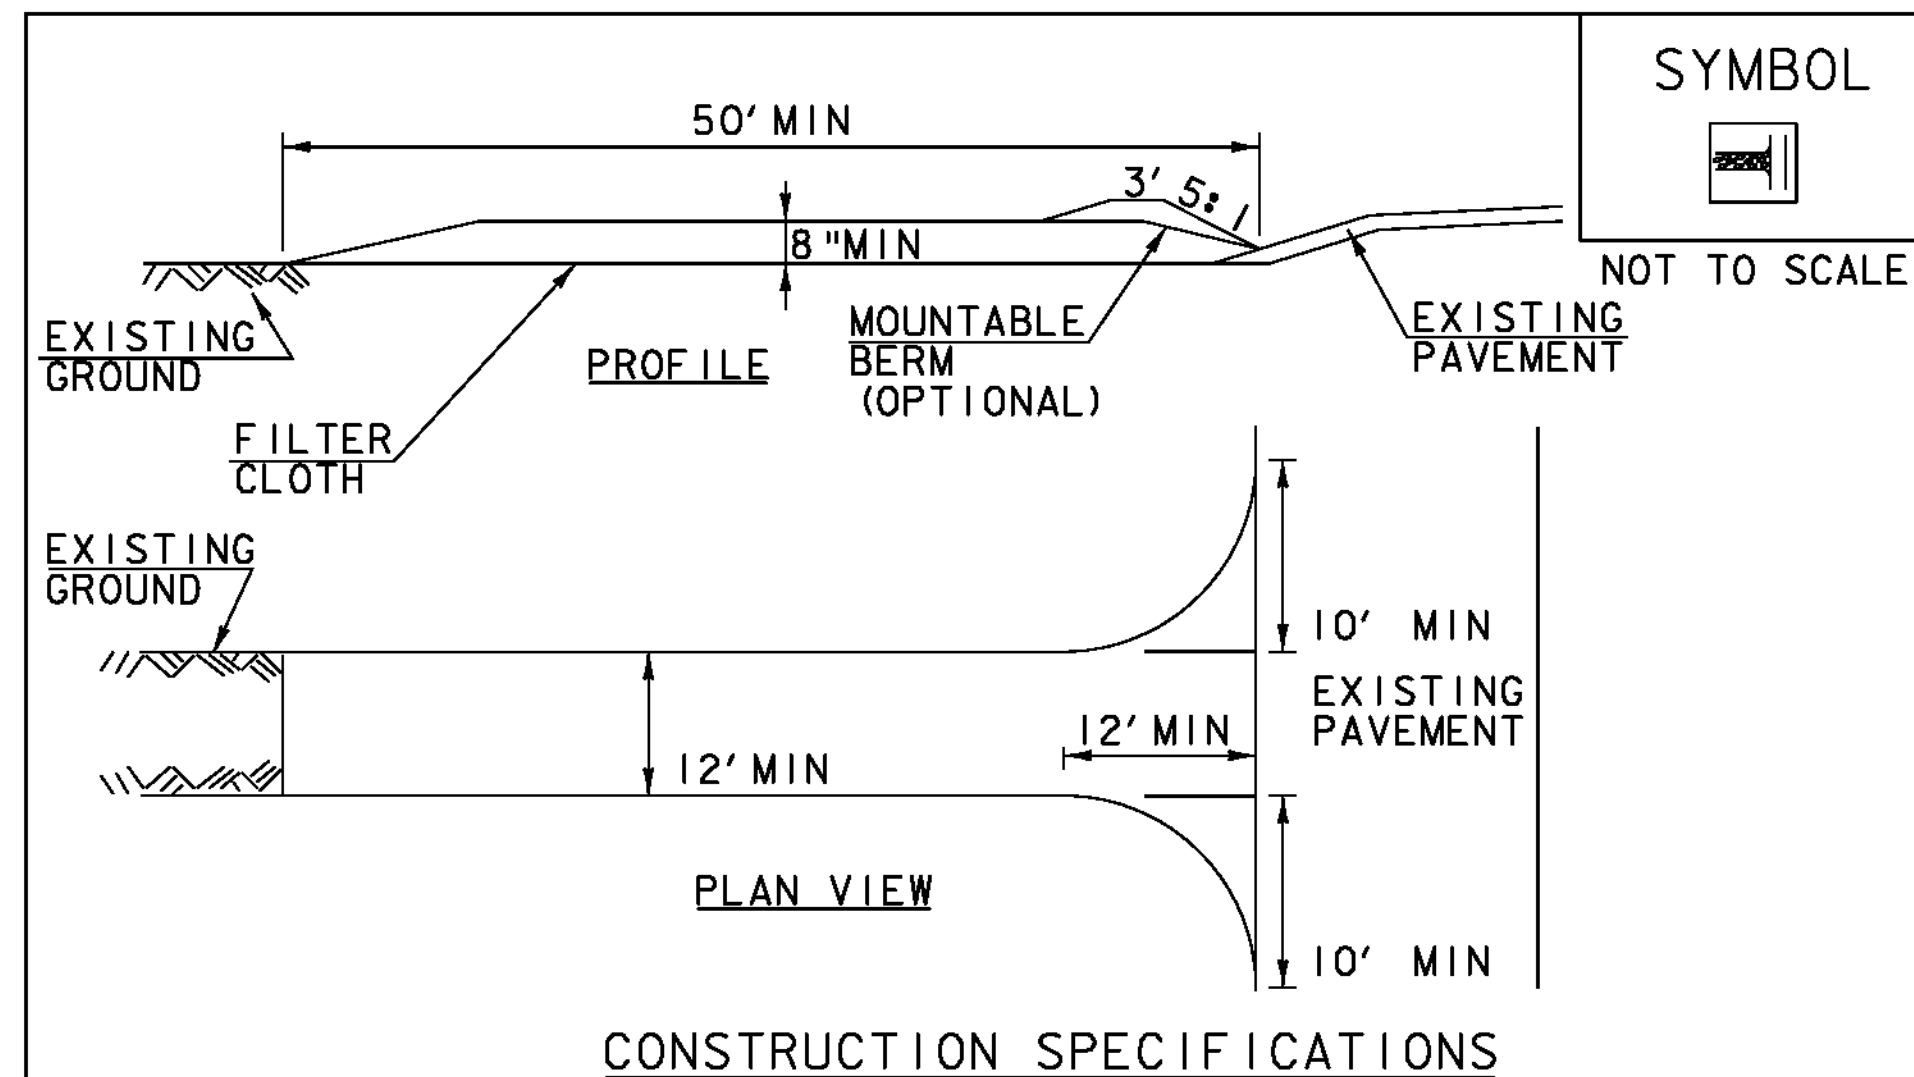

CONSTRUCTION SPECIFICATIONS

1. STONE SIZE- USE 1-4" STONE, RECLAIMED OR RECYCLED CONCRETE EQUIVALENT.
2. LENGTH- NOT LESS THAN 50' (EXCEPT ON A SINGLE RESIDENCE LOT WHERE A 30' MINIMUM LENGTH APPLIES).
3. THICKNESS- NOT LESS THAN 8".
4. WIDTH- 12' MINIMUM, BUT NOT LESS THAN THE FULL WIDTH AT POINTS WHERE INGRESS OR EGRESS OCCURS. 24' IF SINGLE ENTRANCE TO SITE.
5. GEOTEXTILE MUST BE PLACED OVER THE ENTIRE AREA PRIOR TO PLACING STONE.
6. SURFACE WATER- ALL SURFACE WATER FLOWING OR DIVERTED TOWARD CONSTRUCTION ENTRANCES SHALL BE PIPED BENEATH THE ENTRANCE. IF PIPING IS IMPRACTICAL, A MOUNTABLE BERM WITH 5:1 SLOPES WILL BE PERMITTED.
7. MAINTENANCE- THE ENTRANCE SHALL BE MAINTAINED IN A CONDITION WHICH WILL PREVENT TRACKING OR FLOWING OF SEDIMENT ONTO PUBLIC RIGHTS-OF-WAY, ALL SEDIMENT SPILLED, DROPPED, WASHED OR TRACKED ONTO PUBLIC RIGHTS-OF-WAY MUST BE REMOVED IMMEDIATELY.
8. WHEN WASHING IS REQUIRED, IT SHALL BE DONE ON AN AREA STABILIZED WITH STONE AND WHICH DRAINS INTO AN APPROVED SEDIMENT TRAPPING DEVICE.
9. PERIODIC INSPECTION AND NEEDED MAINTENANCE SHALL BE PROVIDED ACCORDING TO PERMIT REQUIREMENTS.

ADAPTED FROM DETAILS PROVIDED BY: NEW YORK STATE DEC
ORIGINALLY DEVELOPED BY USDA-NRCS
VERMONT DEPARTMENT OF ENVIRONMENTAL CONSERVATION

STABILIZED CONSTRUCTION ENTRANCE

NOTES:
REFER TO "THE VERMONT STANDARDS & SPECIFICATIONS FOR EROSION PREVENTION & SEDIMENT CONTROL -2006-" FROM THE VT AGENCY OF NATURAL RESOURCES FOR ADDITIONAL GUIDANCE.

THIS WORK SHALL BE PERFORMED IN ACCORDANCE WITH SECTION 653 FOR VEHICLE TRACKING PAD (PAY ITEM 653.35) OR AS SPECIFIED IN THE CONTRACT.

REVISIONS	
MARCH 24, 2008	WHF
JANUARY 13, 2009	WHF

VAOT RURAL AREA MIX					
% WEIGHT	LBS/AC		NAME	GERM %	PURITY %
	BROADCAST	HYDROSEED			
37.5%	22.5	45	CREeping RED FESCUE	85%	98%
37.5%	22.5	45	TALL FESCUE	90%	95%
5.0%	3	6	RED TOP	90%	95%
15.0%	9	18	BIRDSFOOT TREFOIL	85%	98%
5.0%	3	6	ANNUAL RYE GRASS	85%	95%
100%	60	120			

VAOT URBAN AREA MIX					
% WEIGHT	LBS/AC		NAME	GERM %	PURITY %
	BROADCAST	HYDROSEED			
42.5%	34	68	CREeping RED FESCUE	85%	98%
10.0%	8	16	PERENNIAL RYE GRASS	90%	95%
42.5%	34	68	KENTUCKY BLUE GRASS	85%	85%
5.0%	4	8	ANNUAL RYE GRASS	85%	95%
100%	80	160			

SOIL AMENDMENT GUIDANCE

FERTILIZER		LIME	
BROADCAST	HYDROSEED	BROADCAST	HYDROSEED
10-20-10	FOLLOW	PELLETIZED	FOLLOW
500 LBS/AC	MANUFACTURER	2 TONS/AC	MANUFACTURER

CONSTRUCTION GUIDANCE

1. RURAL SEED MIX: USE AS INDICATED IN THE PLANS AND/OR FOR ALL ESTABLISHED UPLAND (NON WETLAND) AREAS DISTURBED BY THE CONTRACTOR.
2. URBAN SEED MIX: USE AS INDICATED IN THE PLANS AND/OR FOR ALL ESTABLISHED LAWN AREAS DISTURBED BY THE CONTRACTOR.
3. ALL SEED MIXTURES: SHALL NOT HAVE A WEED CONTENT EXCEEDING 0.40% BY WEIGHT AND SHALL BE FREE OF ALL NOXIOUS SEED.
4. FERTILIZER AND LIMESTONE: SHALL FOLLOW RATES SHOWN ON PLAN OR AS DIRECTED BY THE ENGINEER
5. HAY MULCH: TO BE PLACED ON EARTH SLOPES AT THE RATE OF 2 TONS/ACRE, ACHIEVE 90% GROUND COVER OR AS DIRECTED BY THE ENGINEER.
6. TOPSOIL: TO BE USED WITH SEED AS INDICATED ON THE PLANS, OR AS DIRECTED BY THE ENGINEER.
7. HYDROSEEDING: ALTHOUGH GUIDANCE IS GIVEN ABOVE THE SITE CONDITIONS AND THE TYPE OF HYDROSEED WILL ULTIMATELY DICTATE THE AMOUNTS AND TYPES OF SOIL AMENDMENTS TO BE APPLIED
8. TURF ESTABLISHMENT: PLACING SEED, FERTILIZER, LIME AND MULCH PRIOR TO SEPTEMBER 15 AND AFTER APRIL 15 CAN BETTER ENSURE A VIGOROUS GROWTH OF GRASS.

ADAPTED FROM VTRANS TECHNICAL LANDSCAPE MANUAL FOR ROADWAYS AND TRANSPORTATION FACILITIES


TURF ESTABLISHMENT

REVISIONS	
JUNE 23, 2009	WHF
JANUARY 15, 2010	WHF
FEBRUARY 16, 2011	WHF

PROJECT NAME: EAST HAVEN
PROJECT NUMBER: BRF 0269(II)

FILE NAME: s00cl62erode1.dgn
PROJECT LEADER: K. HIGGINS
DESIGNED BY: J. LACROIX
EPSC DETAILS #2

PLOT DATE: 08-AUG-2011
DRAWN BY: R. PELLET
CHECKED BY: J. LACROIX
SHEET 34 OF 40

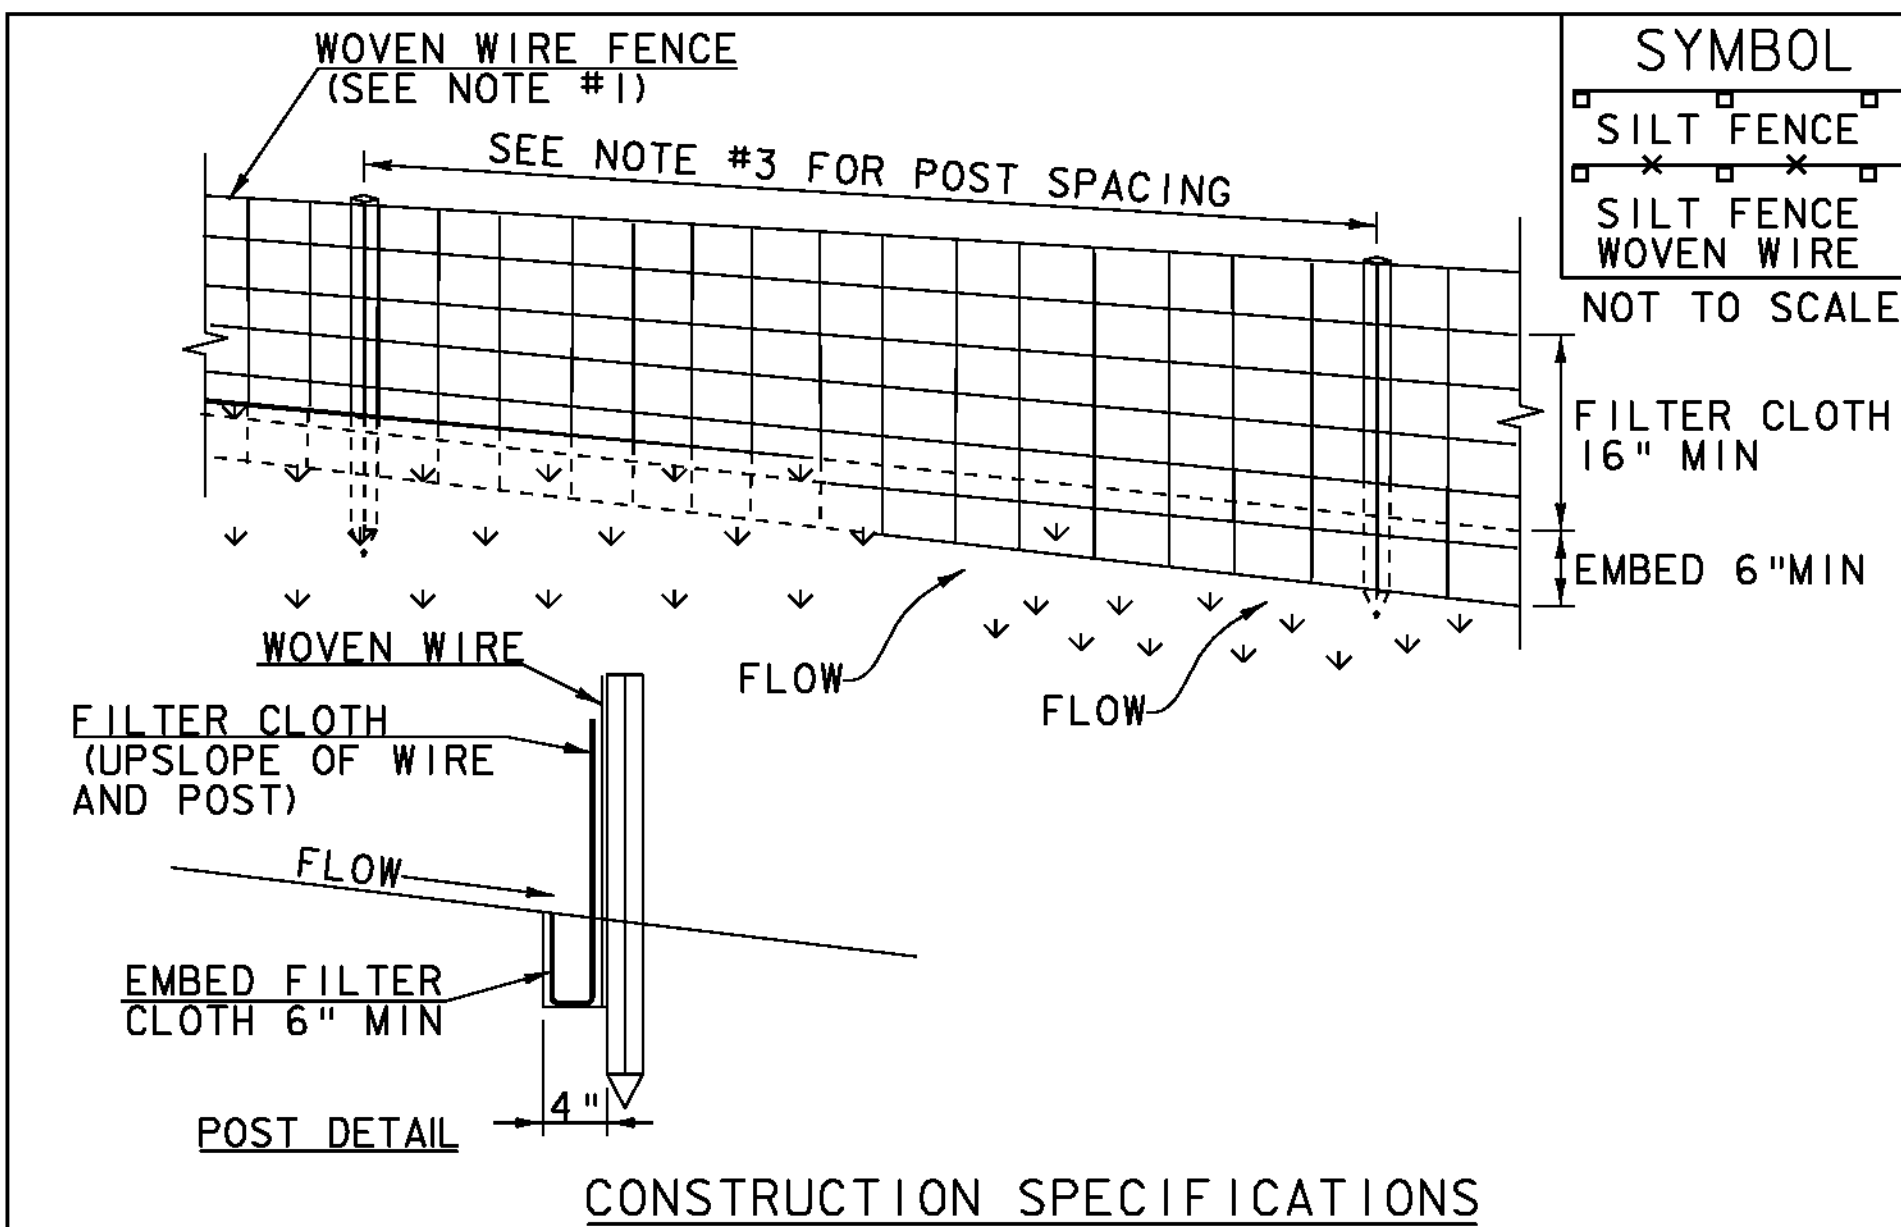

- CONSTRUCTION SPECIFICATIONS**
1. WOVEN WIRE REINFORCED FENCE IS REQUIRED WITHIN 100' UPSLOPE OF RECEIVING WATERS WHEN THE PROJECT FALLS UNDER A CONSTRUCTION STORMWATER PERMIT. WOVEN WIRE SHALL BE A MIN. 14 GAUGE WITH A 6" MAX. MESH OPENING.
 2. FILTER CLOTH SHALL BE EITHER FILTER X, MIRAF1100X, STABILINKA T140N OR APPROVED EQUIVALENT.
 3. POST SPACING FOR WIRE-BACKED FENCE SHALL BE 10' MAXIMUM. FOR FILTER-CLOTH FENCE, WHEN ELONGATION IS >50%, POST SPACING SHALL NOT EXCEED 4' AND WHEN ELONGATION IS <50%, POST SPACING SHALL NOT EXCEED 6'.
 4. WOVEN WIRE FENCE IS TO BE FASTENED SECURELY TO FENCE POSTS WITH WIRE TIES. FILTER CLOTH IS TO BE FASTENED SECURELY TO WOVEN WIRE FENCE WITH TIES SPACED EVERY 24" AT TOP AND MID SECTION.
 5. WHEN TWO SECTIONS OF FILTER CLOTH ADJOIN EACH OTHER THEY SHALL BE OVER-LAPPED BY 6" AND FOLDED.
 6. MAINTENANCE SHALL BE PERFORMED AS NEEDED AND MATERIAL REMOVED WHEN SEDIMENT REACHES HALF OF FABRIC HEIGHT.


ADAPTED FROM DETAILS PROVIDED BY: NEW YORK STATE DEC
ORIGINALLY DEVELOPED BY USDA-NRCS
VERMONT DEPARTMENT OF ENVIRONMENTAL CONSERVATION

SILT FENCE

NOTES:
REFER TO *THE VERMONT STANDARDS & SPECIFICATIONS FOR EROSION PREVENTION & SEDIMENT CONTROL -2006- *FROM THE VT AGENCY OF NATURAL RESOURCES FOR ADDITIONAL GUIDANCE.

THIS WORK SHALL BE PERFORMED IN ACCORDANCE WITH SECTION 649 AND AS SHOWN IN THE PLANS FOR ~~GEOTEXTILE FOR SILT FENCE (PAY ITEM 649.51) OR GEOTEXTILE FOR SILT FENCE, WOVEN WIRE REINFORCED (PAY ITEM 649.515).~~


REVISIONS	
MARCH 21, 2008	WHF
DECEMBER 11, 2008	WHF
JANUARY 13, 2009	WHF

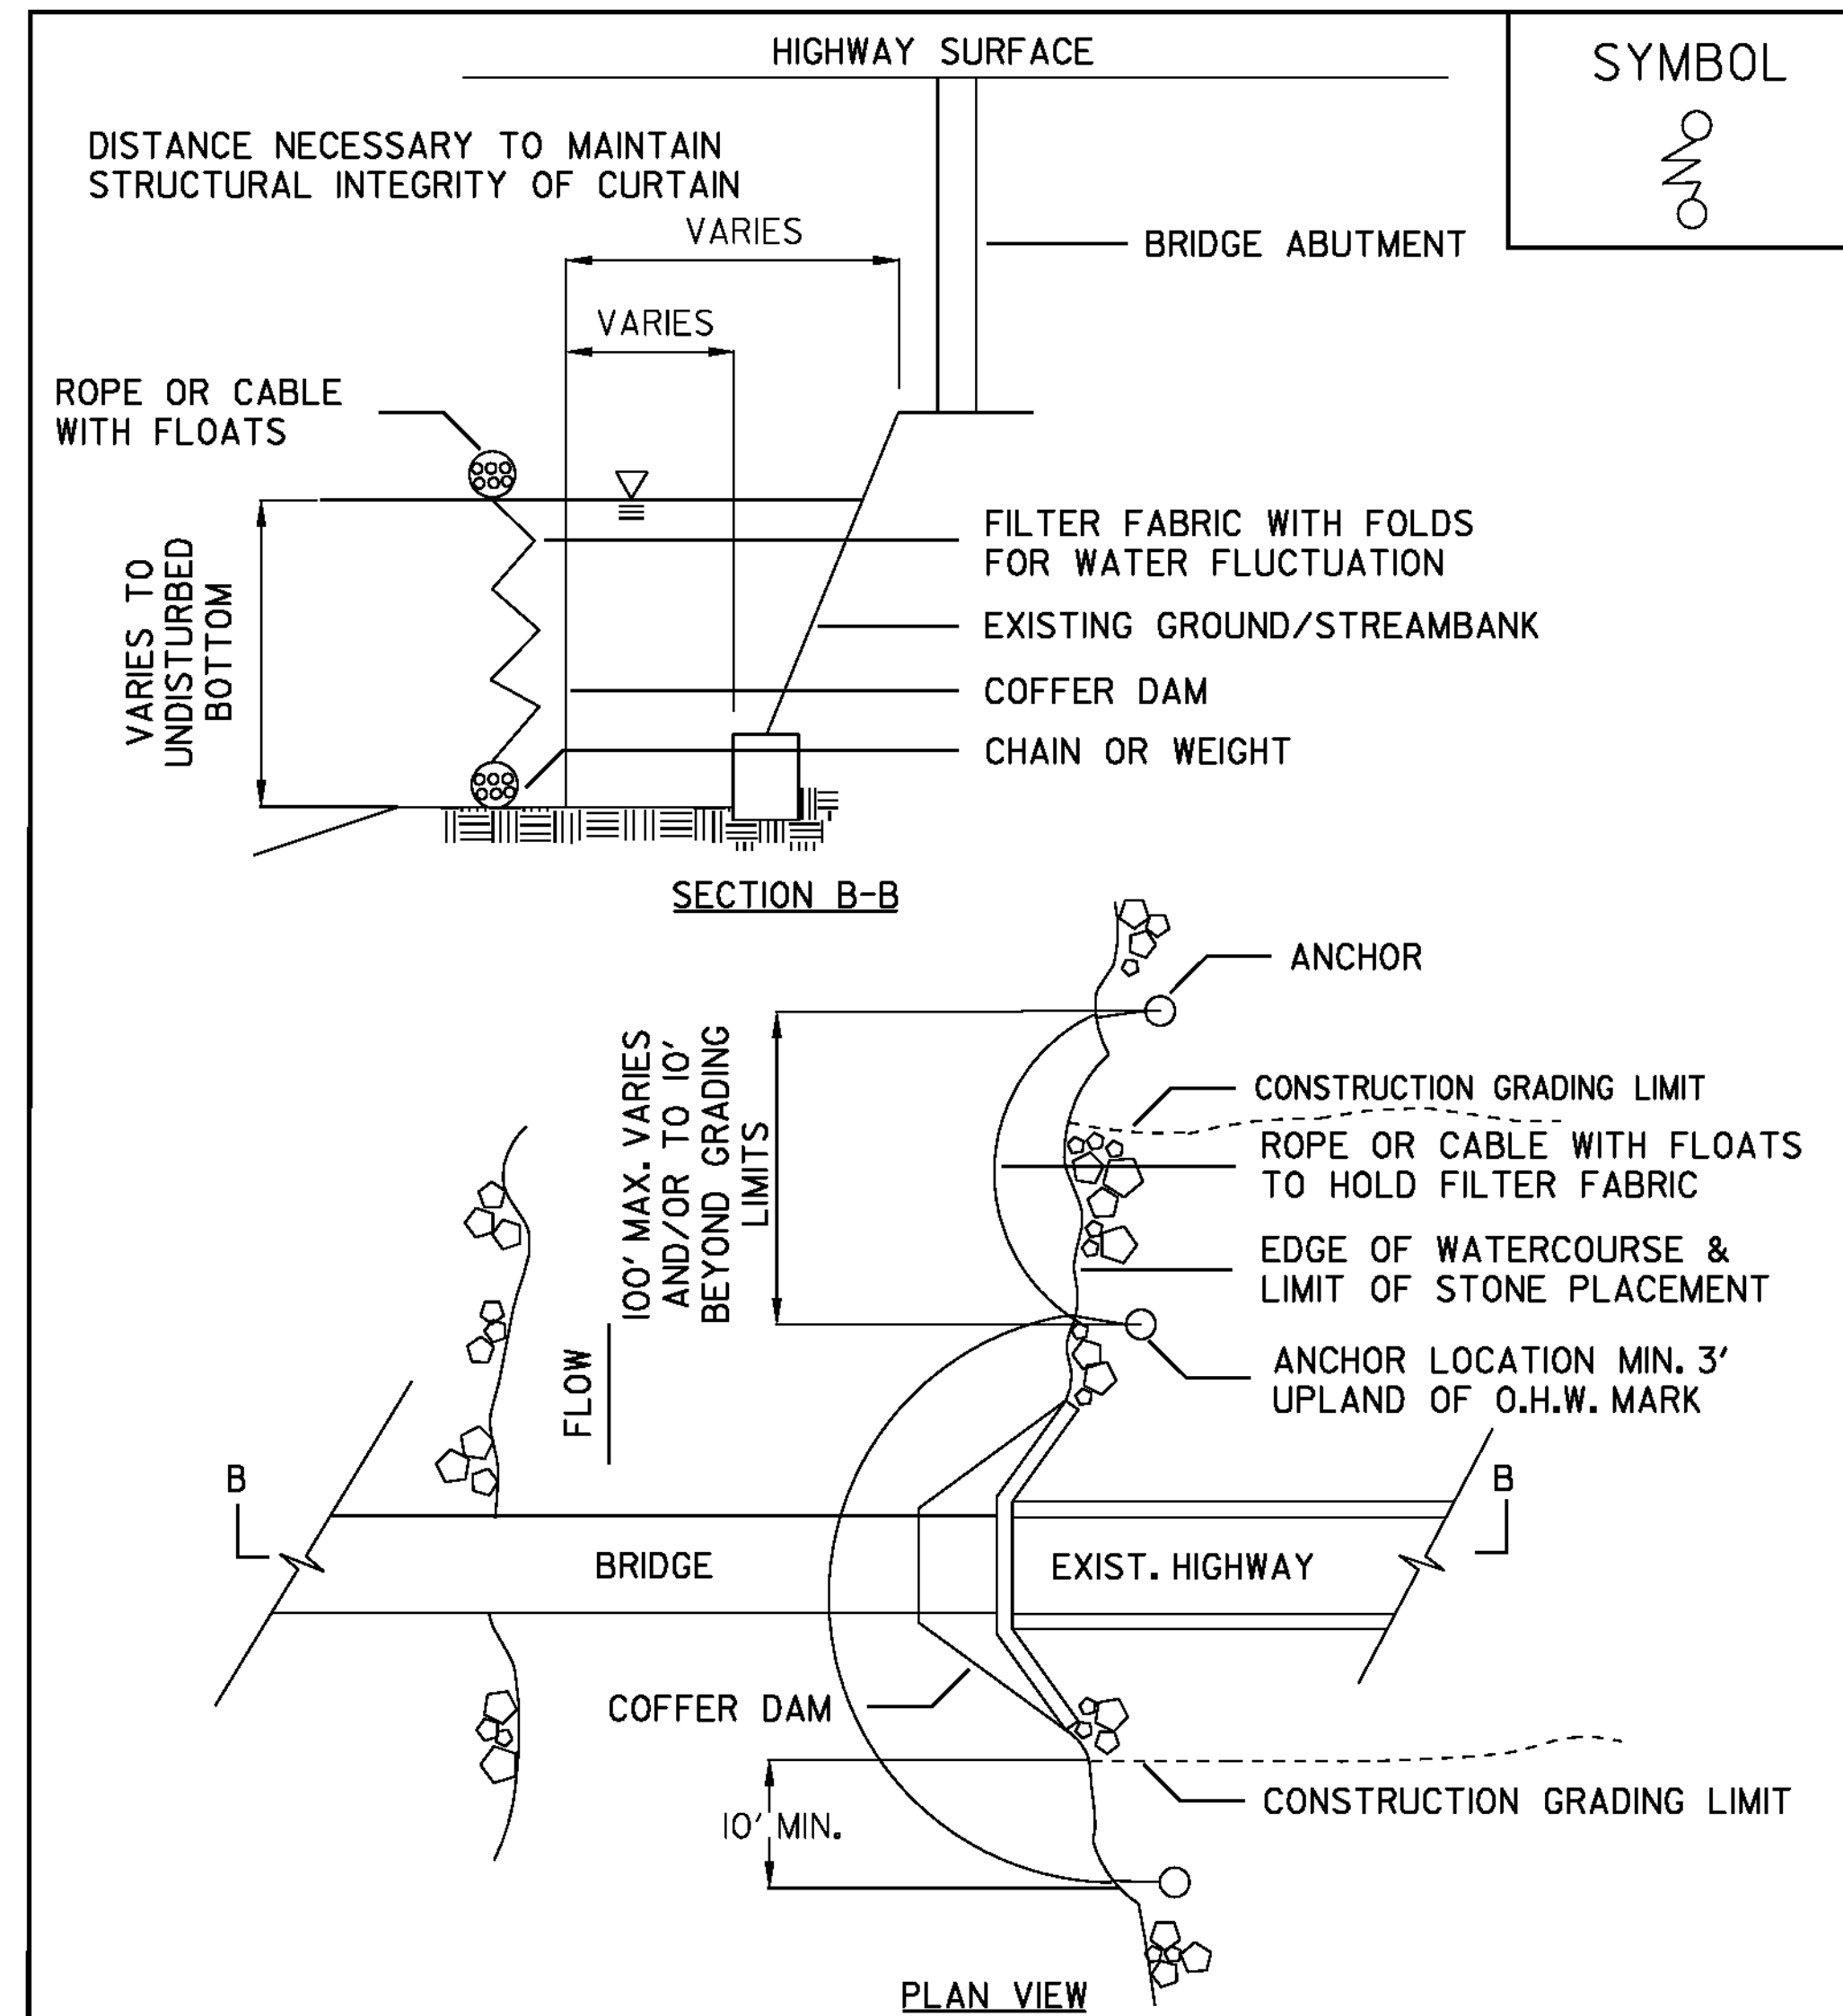

ADAPTED FROM DETAILS PROVIDED BY: NEW YORK STATE DEC
ORIGINALLY DEVELOPED BY USDA-NRCS
VERMONT AGENCY OF TRANSPORTATION

TURBIDITY CURTAIN

NOTES:
THIS ITEM SHALL BE PAID FOR UNDER ITEM 649.61 GEOTEXTILE FOR FILTER CURTAIN

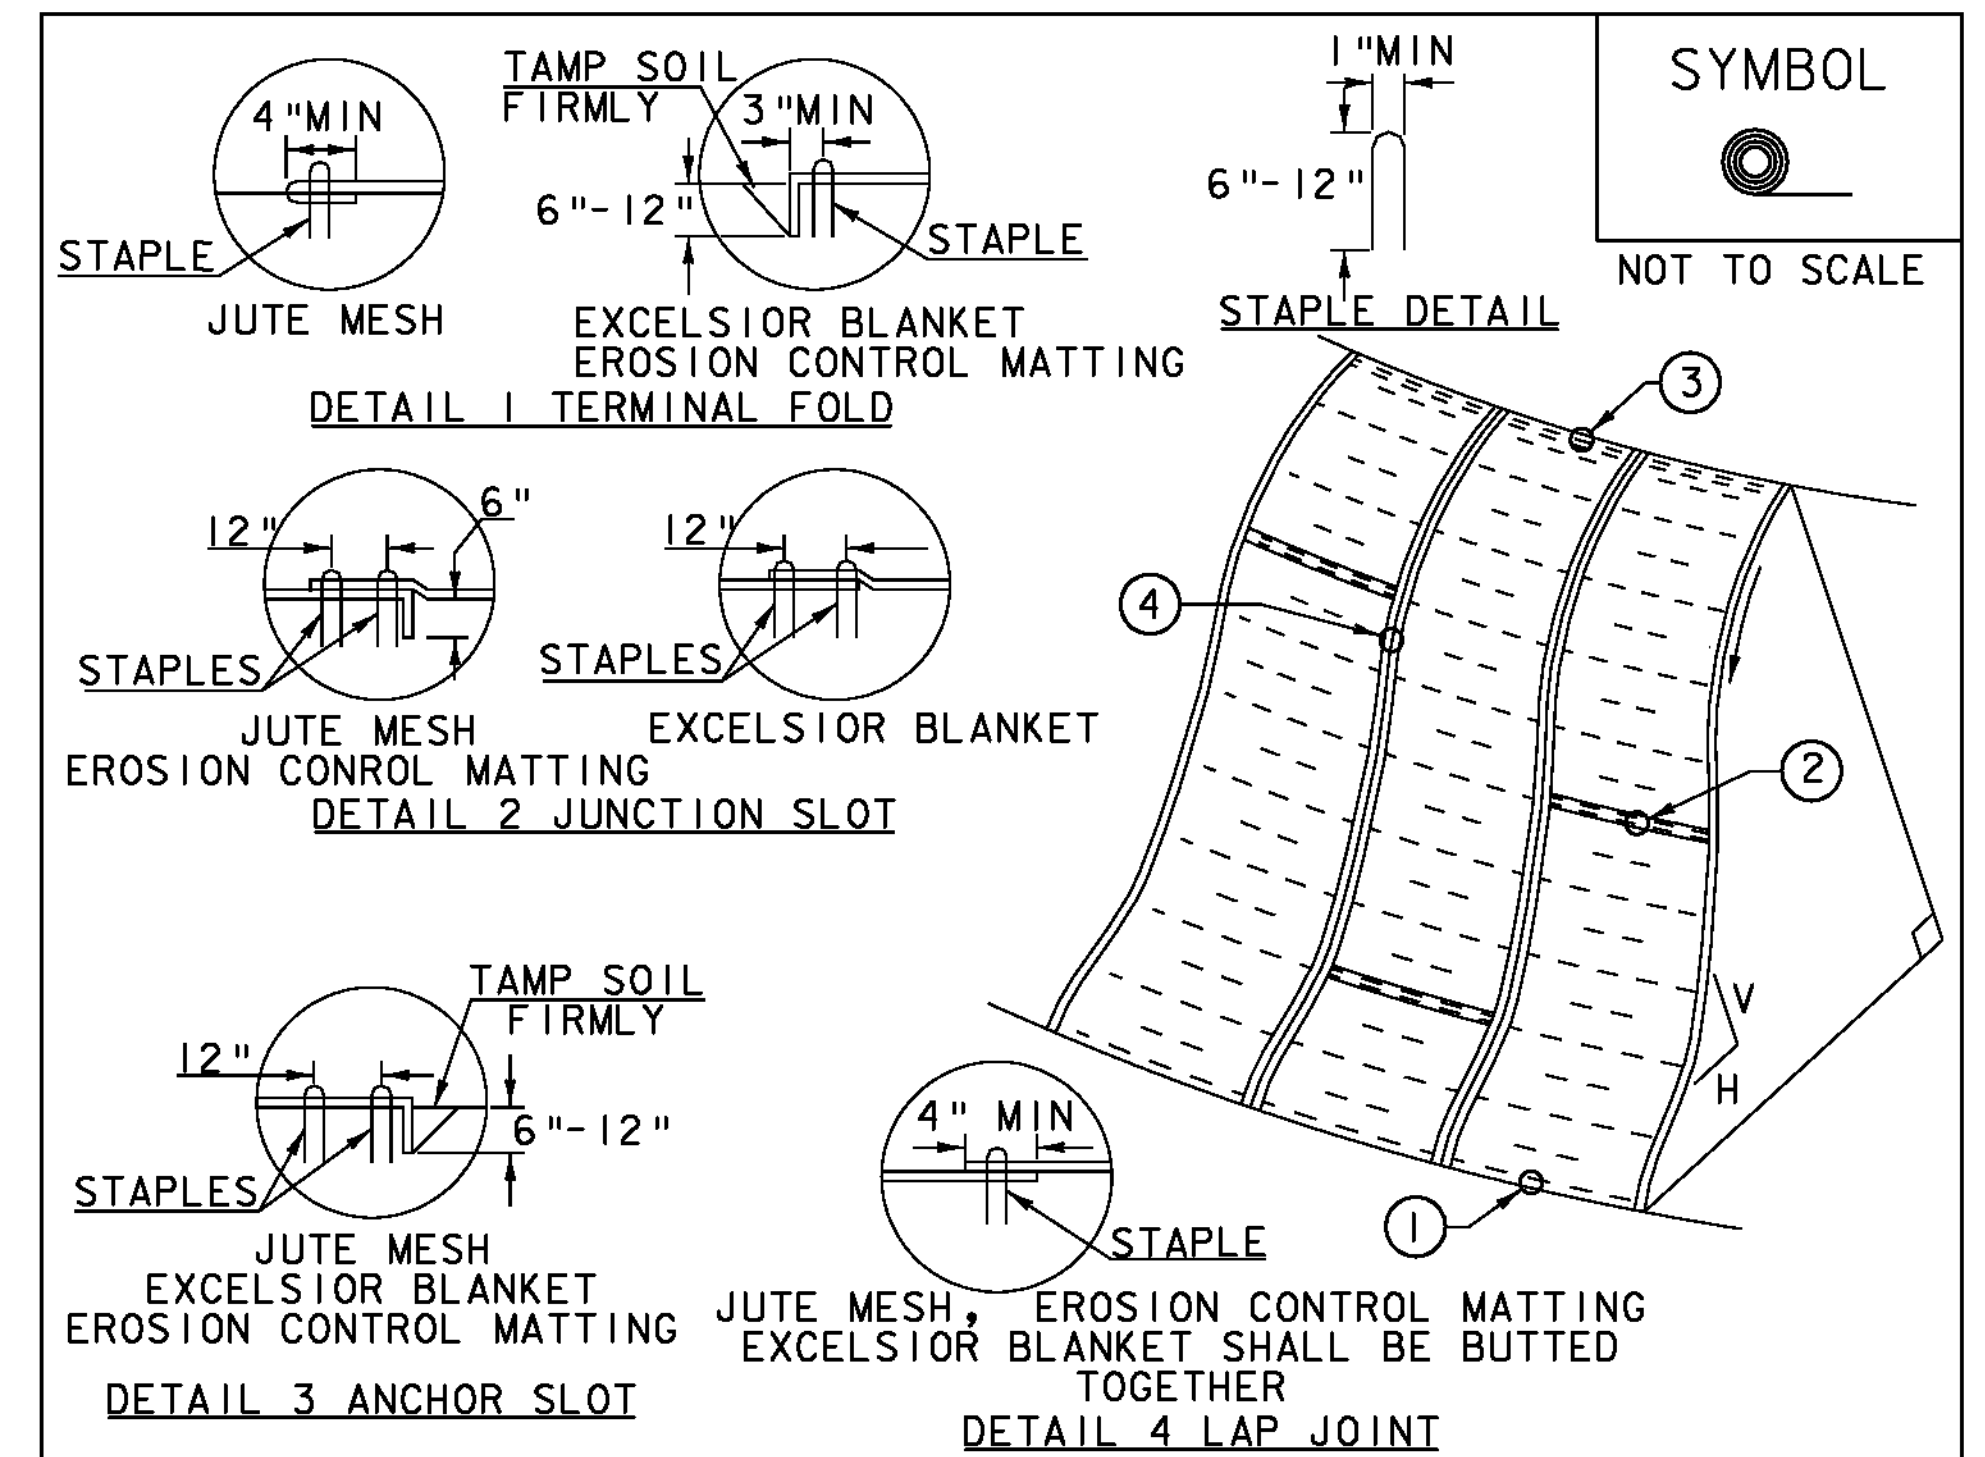



- CONSTRUCTION SPECIFICATIONS**
1. APPLY TO SLOPES GREATER THAN 3H:1V OR WHERE NECESSARY TO AID IN ESTABLISHING VEGETATION.
 2. APPLY FERTILIZER, LIME SEED PRIOR TO PLACING MATTING.
 3. STAPLES ARE TO BE PLACED ALTERNATELY, IN COLUMNS APPROXIMATELY 2' APART AND IN ROWS APPROXIMATELY 3' APART. APPROXIMATELY 175 STAPLES ARE REQUIRED PER 4' X 225' ROLL OF MATERIAL AND 125 STAPLES ARE REQUIRED PER 4' X 150' ROLL OF MATERIAL.
 4. DISTURBED AREAS SHALL BE SMOOTHLY GRADED. EROSION CONTROL MATERIAL SHALL BE PLACED LOOSELY OVER GROUND SURFACE. DO NOT STRETCH.
 5. ALL TERMINAL ENDS AND TRANSVERSE LAPS SHALL BE STAPLED AT APPROXIMATELY 12" INTERVALS.

ADAPTED FROM DETAILS PROVIDED BY: NEW YORK STATE DEC
ORIGINALLY DEVELOPED BY USDA-NRCS
VERMONT DEPARTMENT OF ENVIRONMENTAL CONSERVATION

ROLLED EROSION CONTROL PRODUCT (RECP) SIDE SLOPE

NOTES:
REFER TO *THE VERMONT STANDARDS & SPECIFICATIONS FOR EROSION PREVENTION & SEDIMENT CONTROL -2006- *FROM THE VT AGENCY OF NATURAL RESOURCES FOR ADDITIONAL GUIDANCE.
THIS WORK SHALL BE PERFORMED IN ACCORDANCE WITH SECTION 653 AND AS SHOWN IN THE PLANS FOR TEMPORARY EROSION MATTING (PAY ITEM 653.20) OR PERMANENT EROSION MATTING (PAY ITEM 653.21).

REVISIONS	
APRIL 16, 2007	JMF
JANUARY 13, 2009	WHF

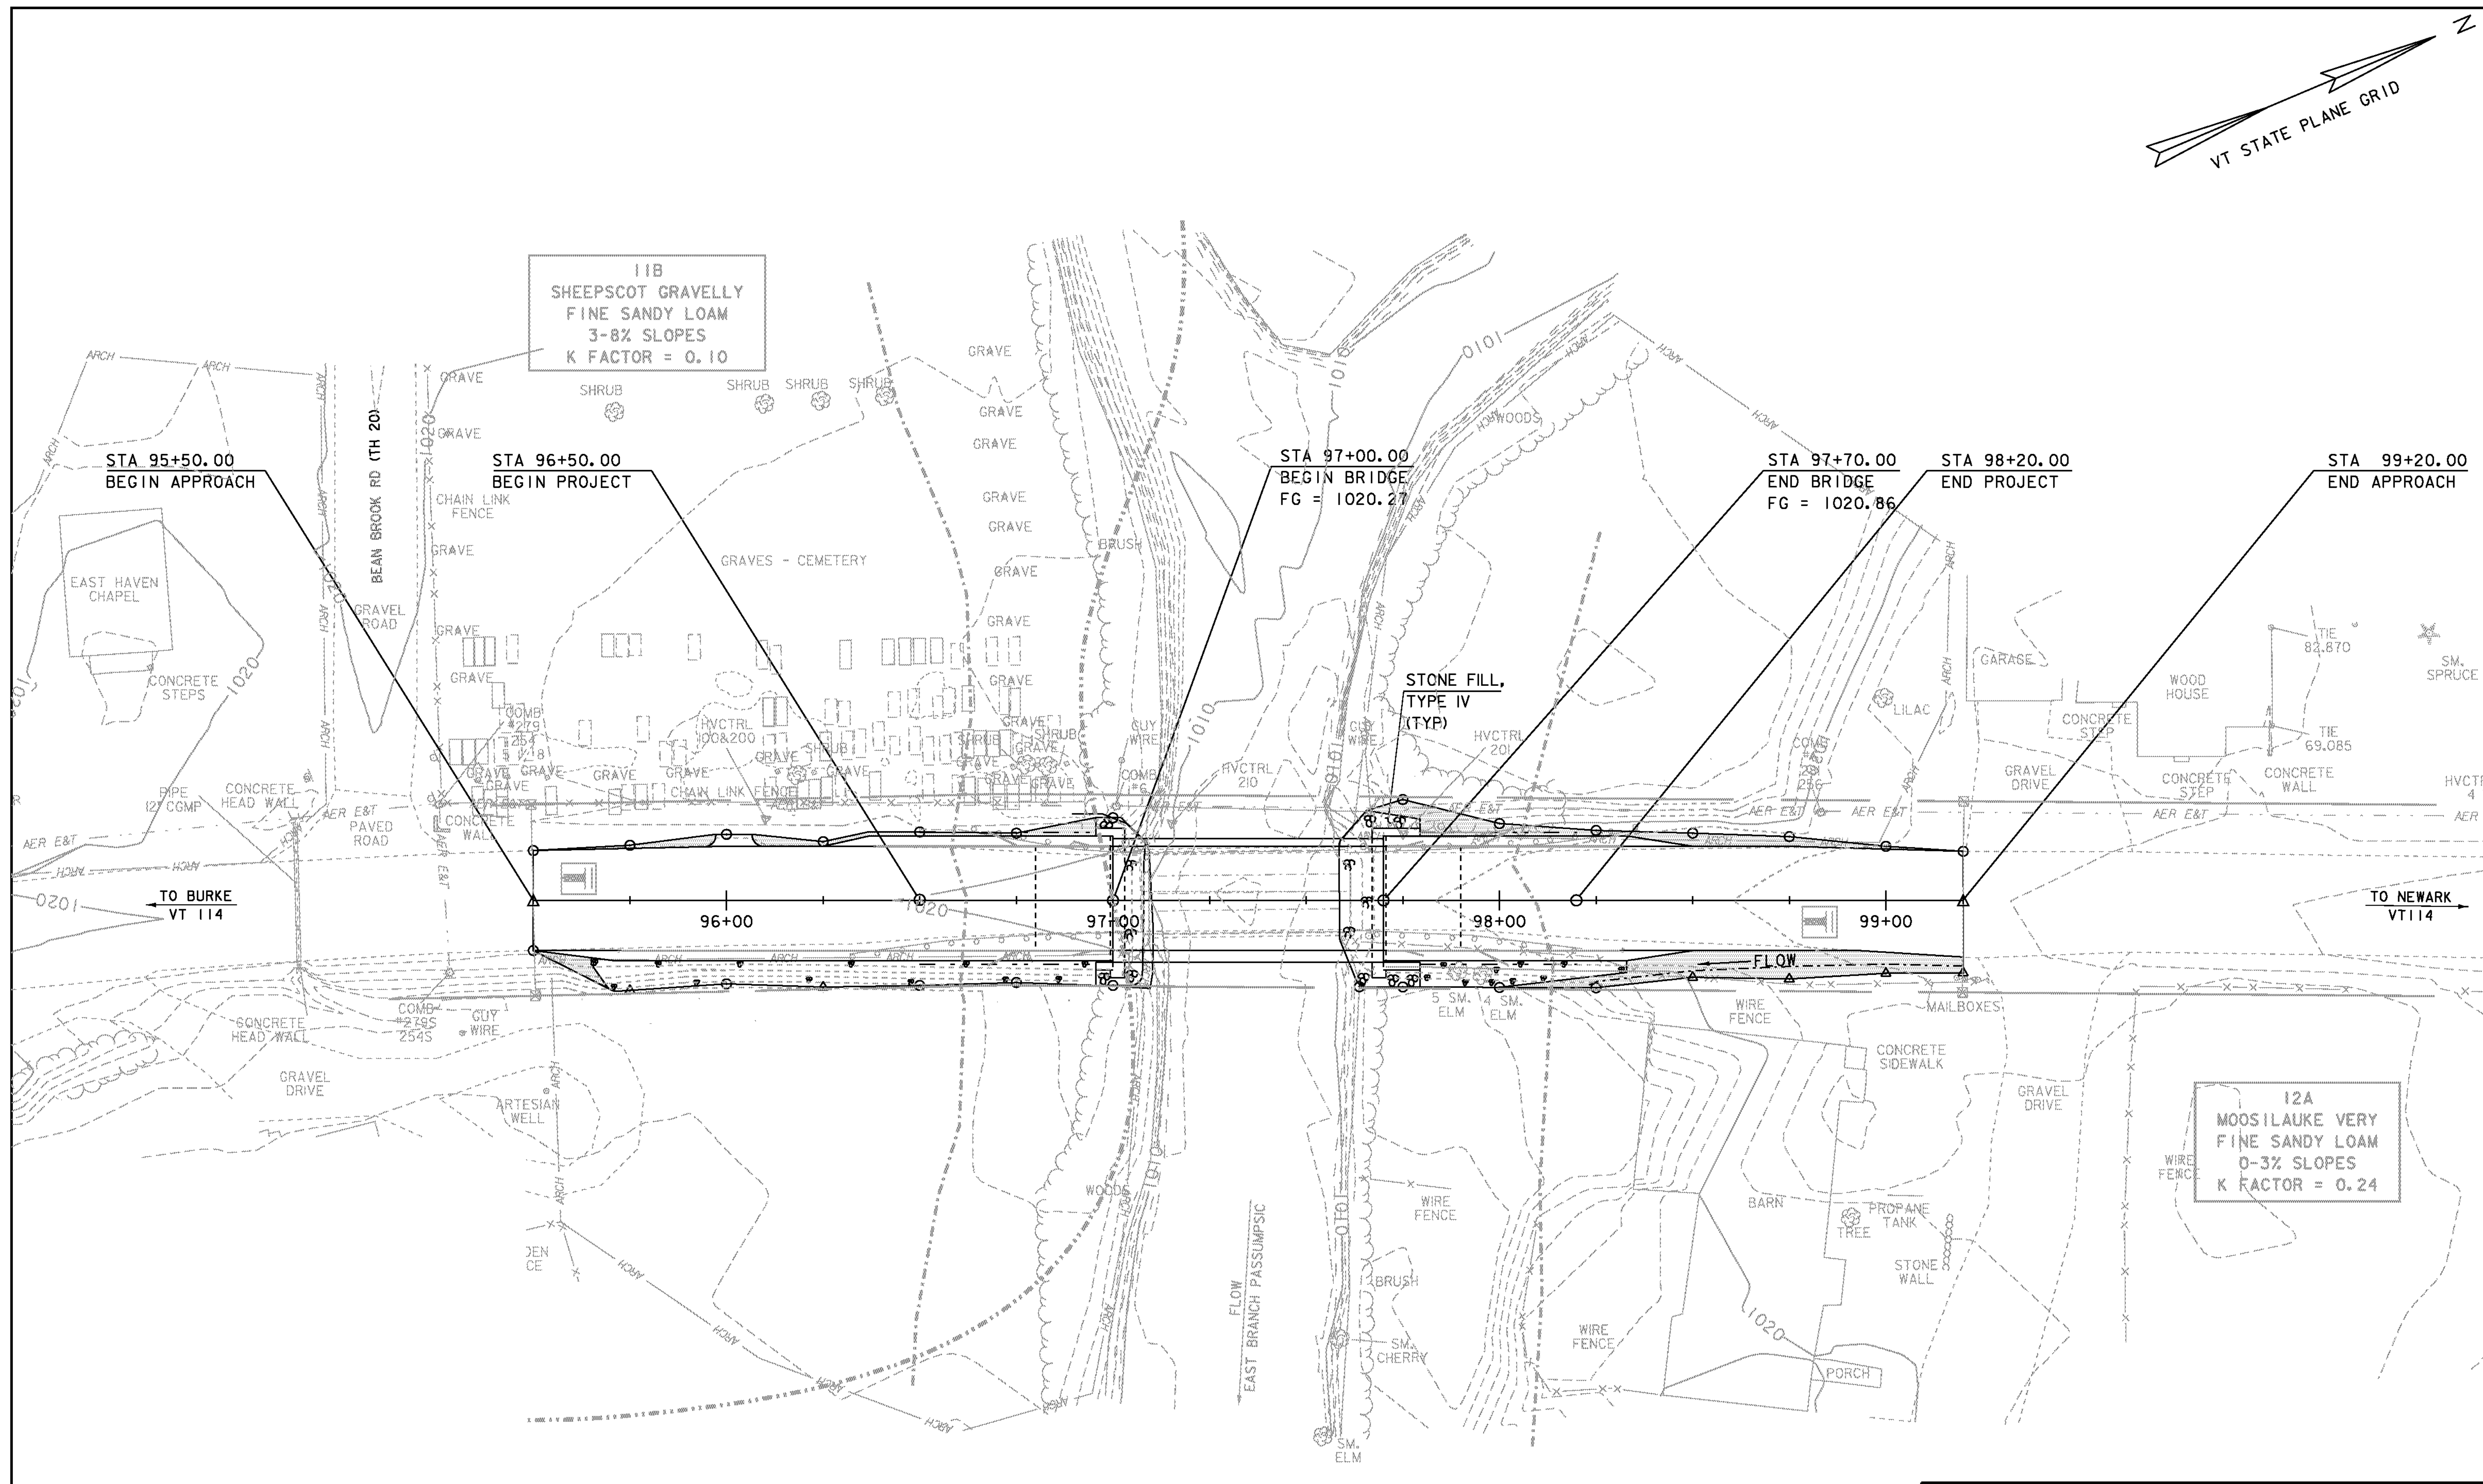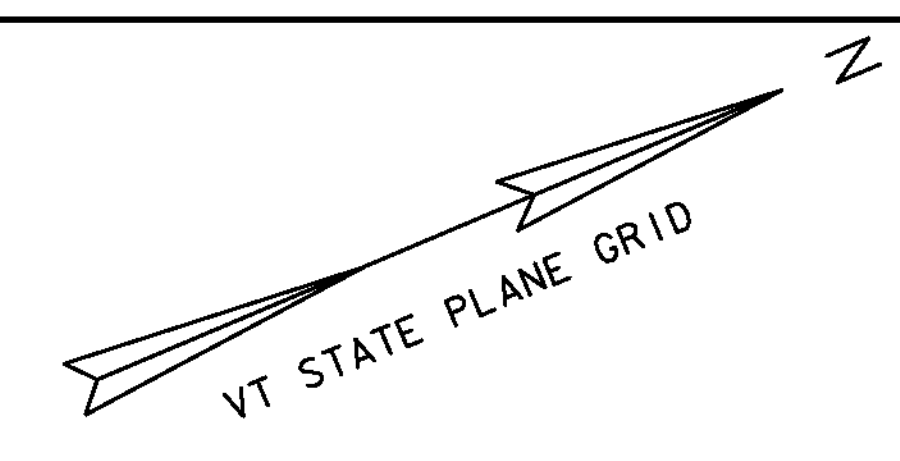

11B
SHEEPSFOOT GRAVELLY
FINE SANDY LOAM
3-8% SLOPES
K FACTOR = 0.10

12A
MOOSILAUKE VERY
FINE SANDY LOAM
0-3% SLOPES
K FACTOR = 0.24

EPSC FINAL SITE PLAN

SCALE 1" = 20' - 0"
20 0 20

AREAS OF EARTH DISTURBANCE
THAT WILL REQUIRE REVEGETATION.

PROJECT NAME: EAST HAVEN
PROJECT NUMBER: BRF 0269(II)
FILE NAME: s00c162erobdr.dgn
PROJECT LEADER: K. HIGGINS
DESIGNED BY: J. LACROIX
EPSC FINAL SITE PLAN
PLOT DATE: 08-AUG-2011
DRAWN BY: R. PELLET
CHECKED BY: J. LACROIX
SHEET 32 OF 40



TEMPORARY EROSION MATTING
 STA 95+50.00 - 96+96.83 RT
 STA 97+79.17 - 99+20.00 RT

**GEOTEXTILE FOR SILT FENCE,
 WOVEN WIRE REINFORCED**
 STA 95+50.00 - 95+97.19 LT
 STA 95+50.00 - 97+00.00 RT
 STA 96+06.62 - 96+90.00 LT
 STA 97+65.00 - 99+20.00 LT/RT

BARRIER FENCE
 STA 95+50.00 - 95+97.19 LT
 STA 96+06.62 - 96+90.00 LT

PROJECT DEMARCATION FENCE
 STA 95+50.00 - 97+05.00 RT
 STA 97+65.00 - 99+20.00 LT/RT

TEMPORARY STONE CHECK DAM, TYPE I
 STA 98+25.00 - 99+25.00 RT

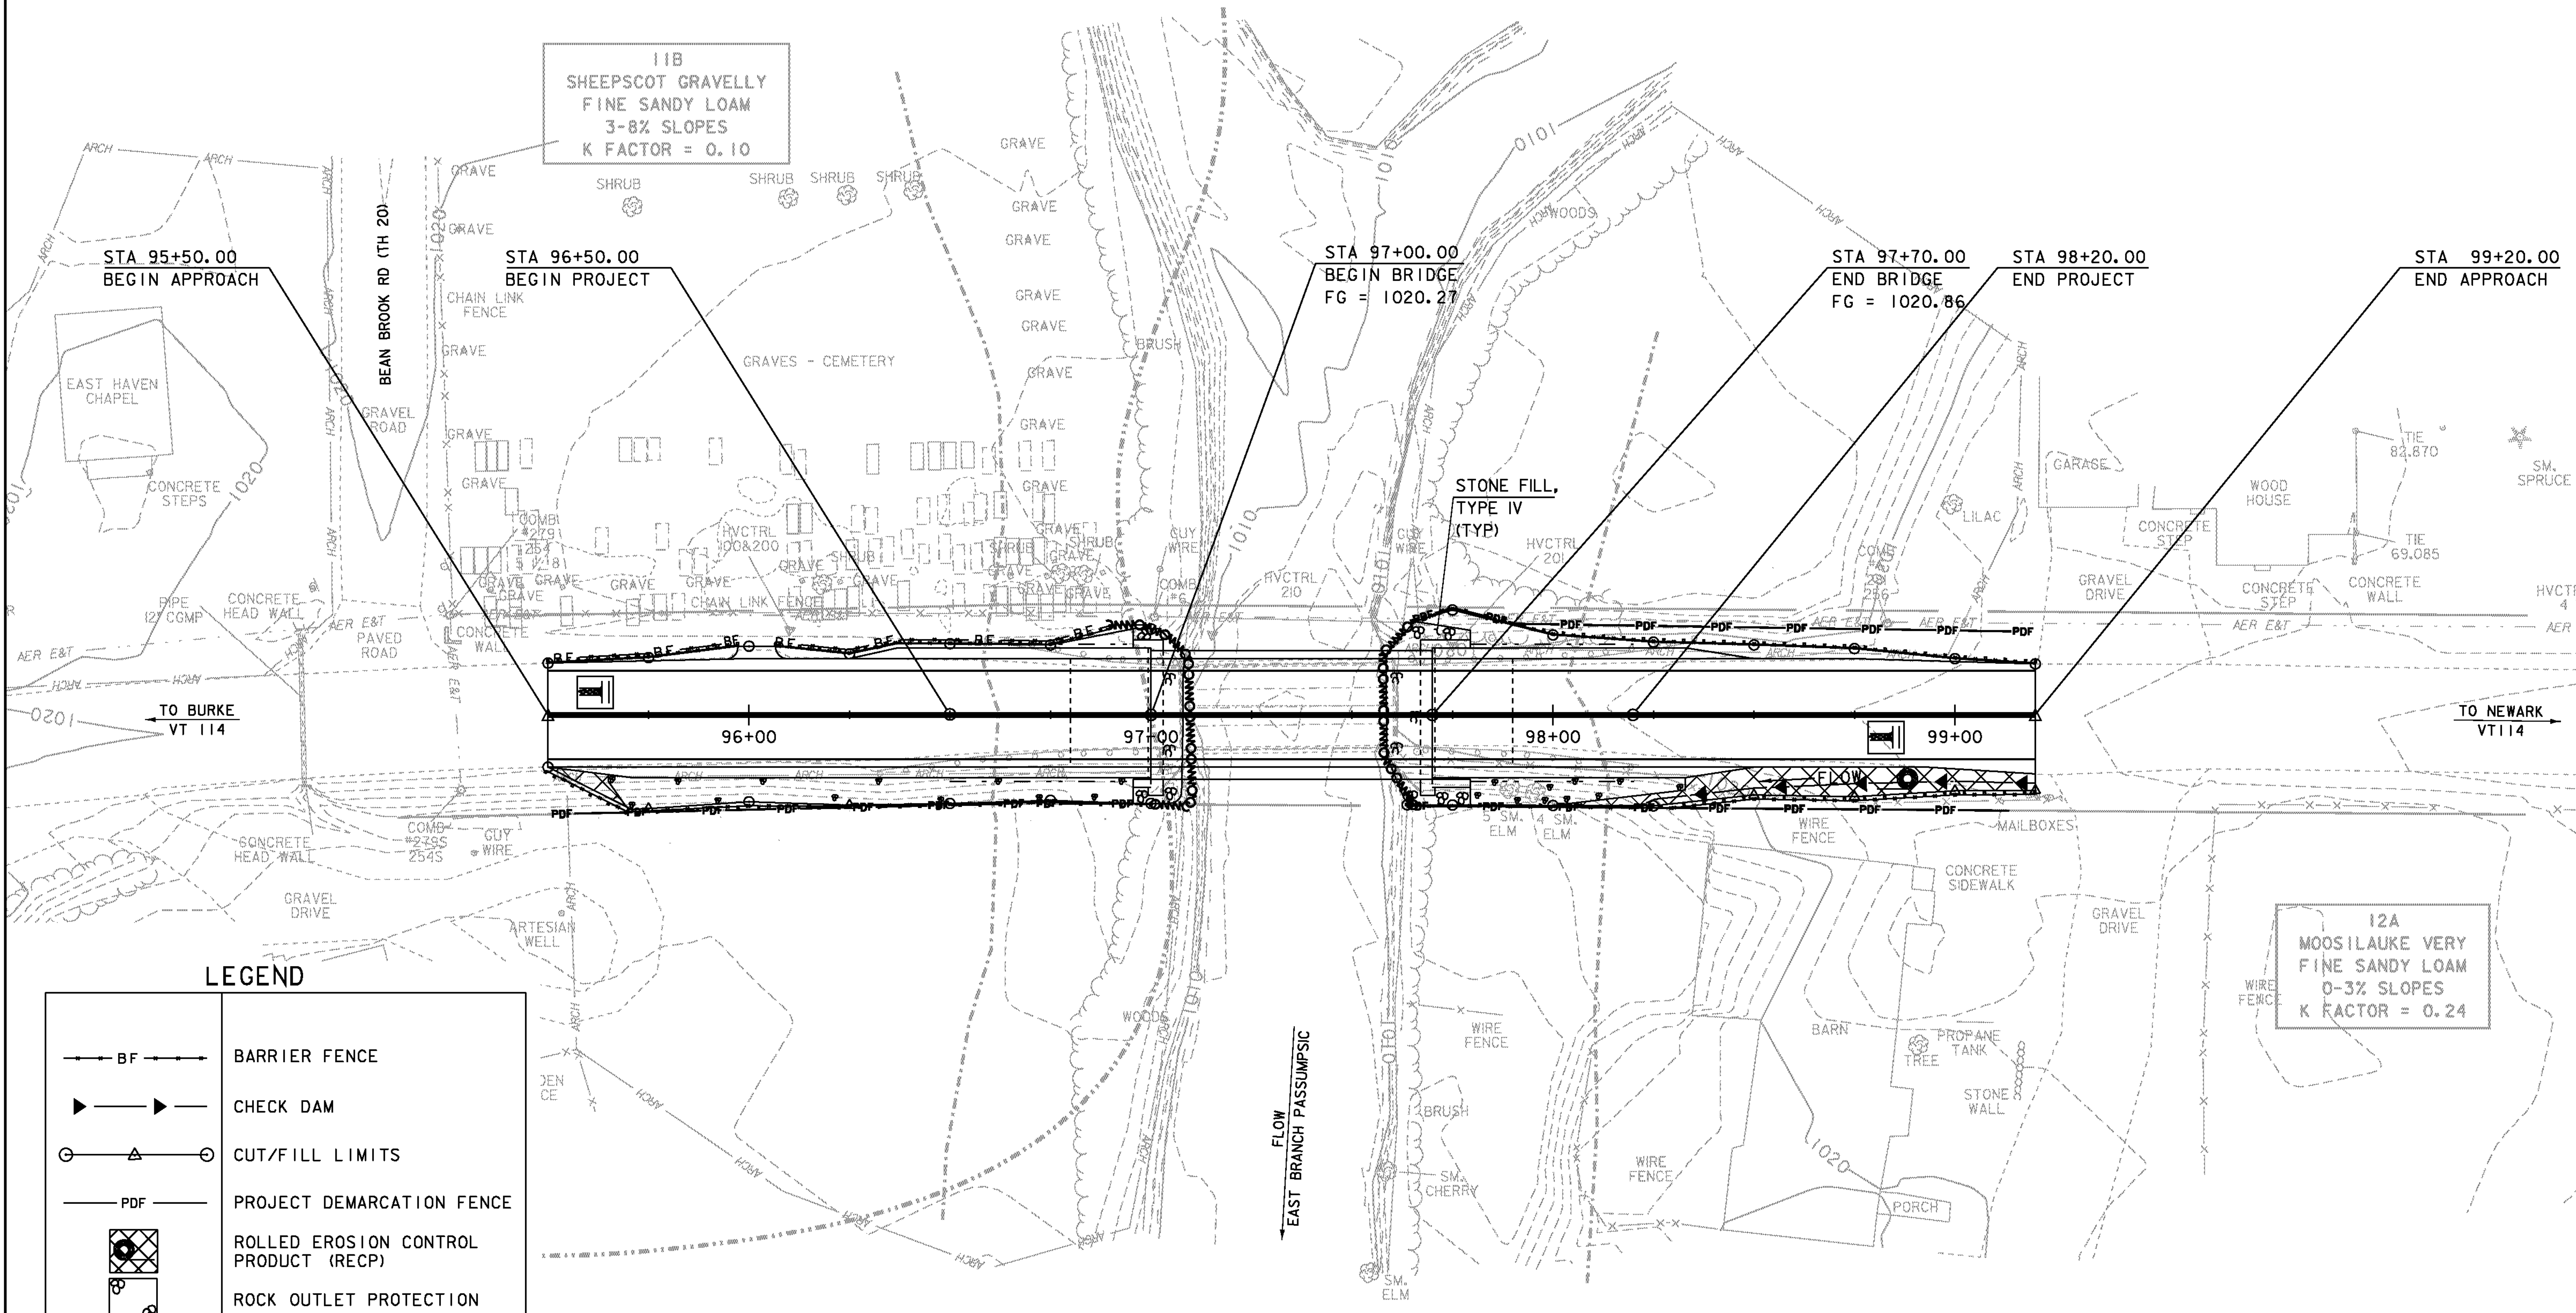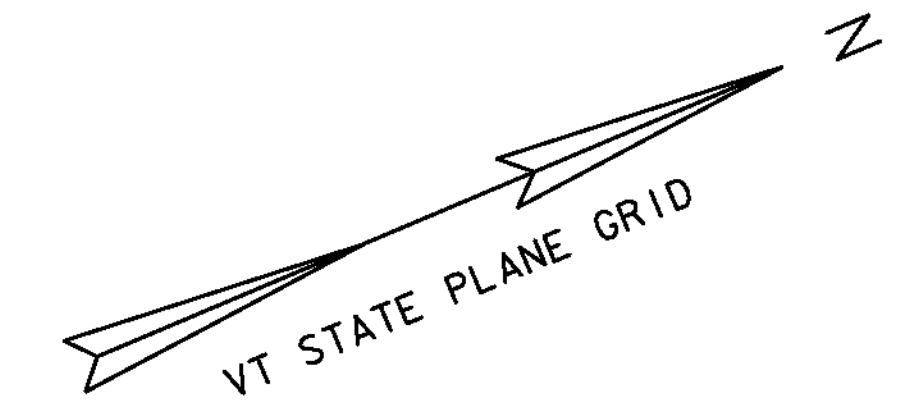


LEGEND

	BARRIER FENCE
	CHECK DAM
	CUT/FILL LIMITS
	PROJECT DEMARCATION FENCE
	ROLLED EROSION CONTROL PRODUCT (RECP)
	ROCK OUTLET PROTECTION
	SILT FENCE, WIRE WOVEN REINFORCED
	STABILIZED CONSTRUCTION ENTRANCE
	TURBIDITY CURTAIN


EPSC CONSTRUCTION SITE PLAN

SCALE 1" = 20' - 0"
 20 0 20

PROJECT NAME: EAST HAVEN	PLOT DATE: 08-AUG-2011
PROJECT NUMBER: BRF 0269(II)	DRAWN BY: R. PELLET
FILE NAME: s00cl62erobdr.dgn	CHECKED BY: J. LACROIX
PROJECT LEADER: K. HIGGINS	SHEET 31 OF 40
DESIGNED BY: J. LACROIX	
EPSC CONSTRUCTION SITE PLAN	

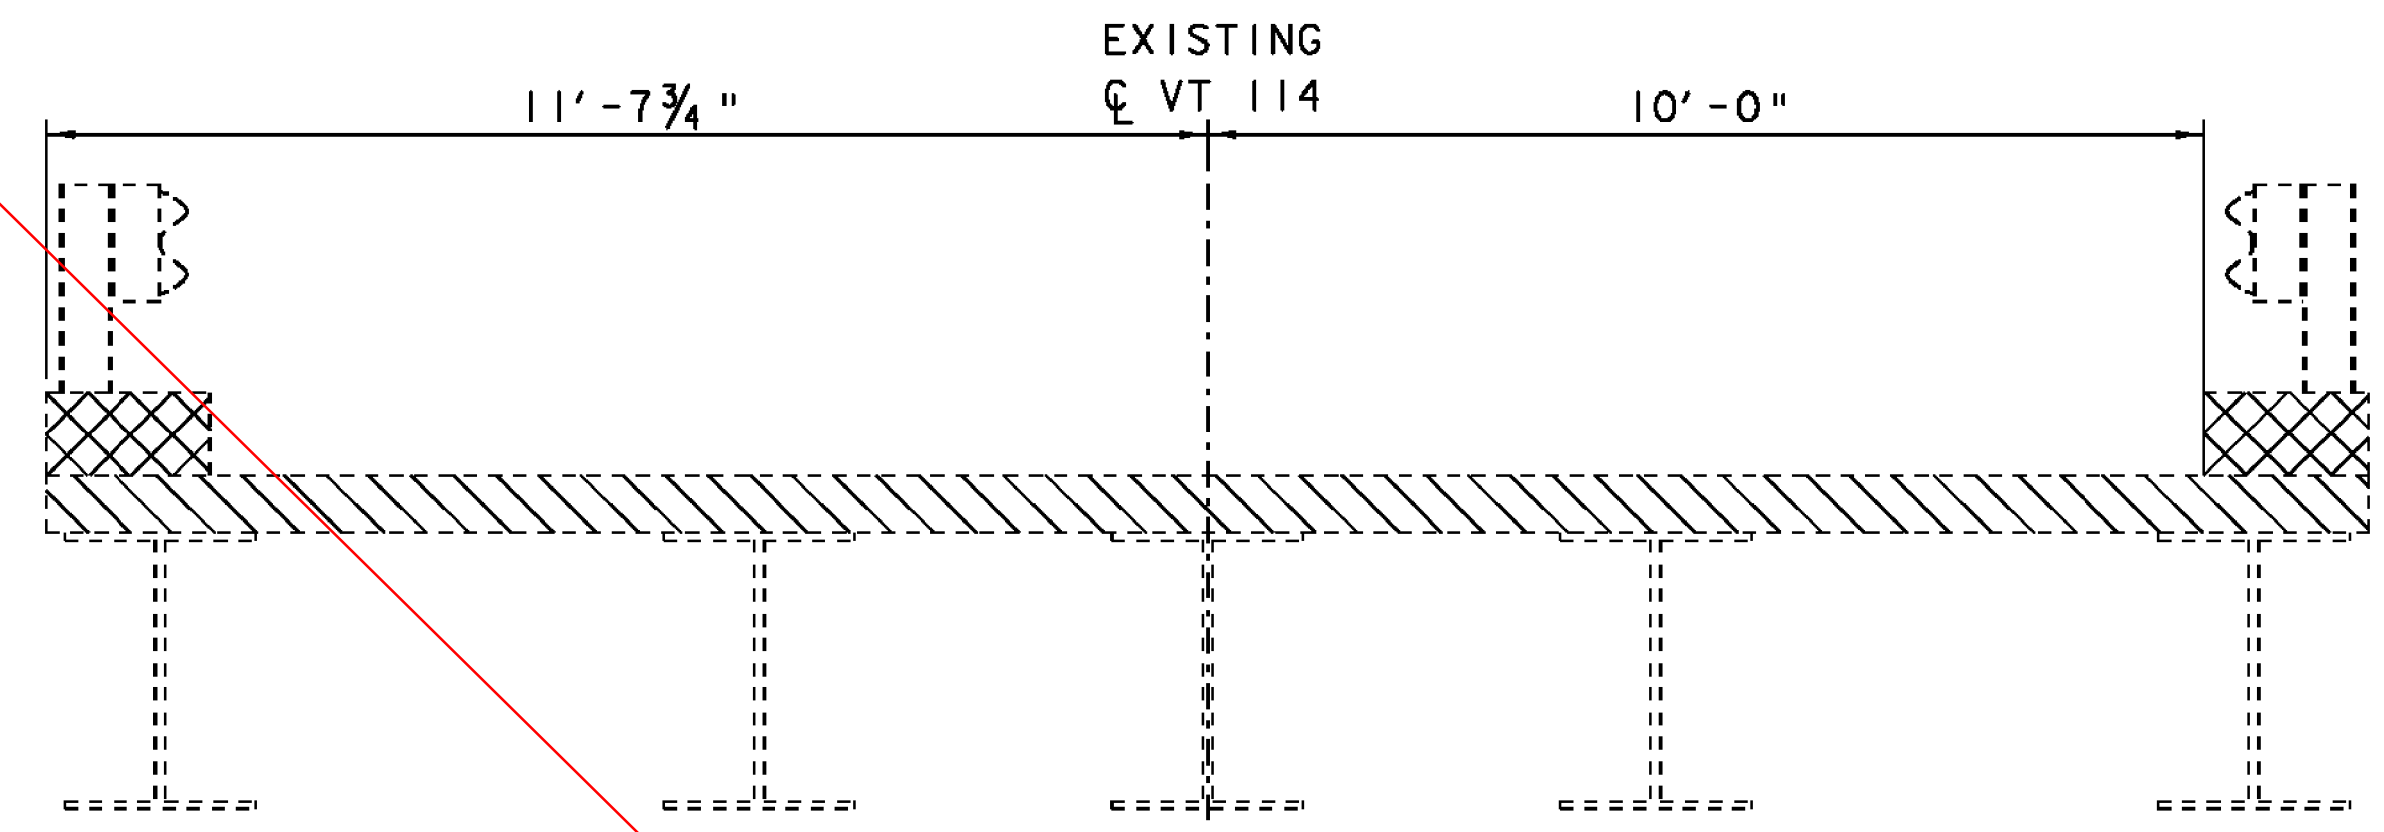


EXISTING TYPICAL SECTION

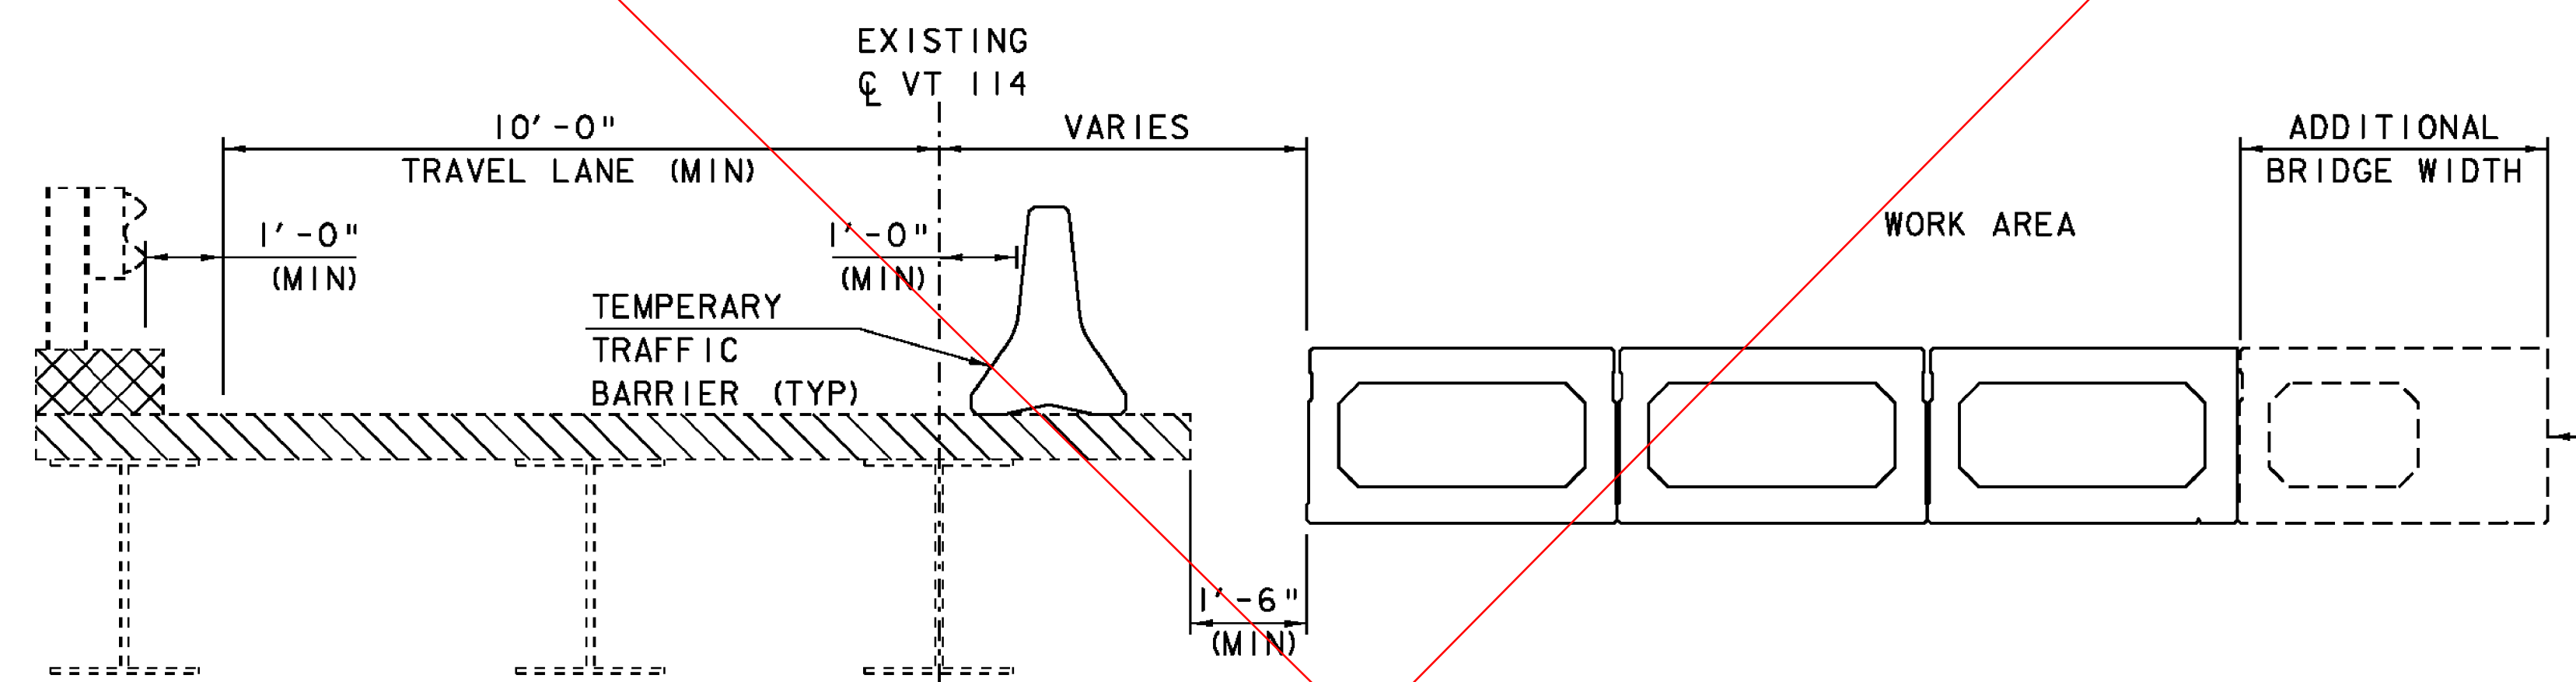


PHASE I

- VOID -

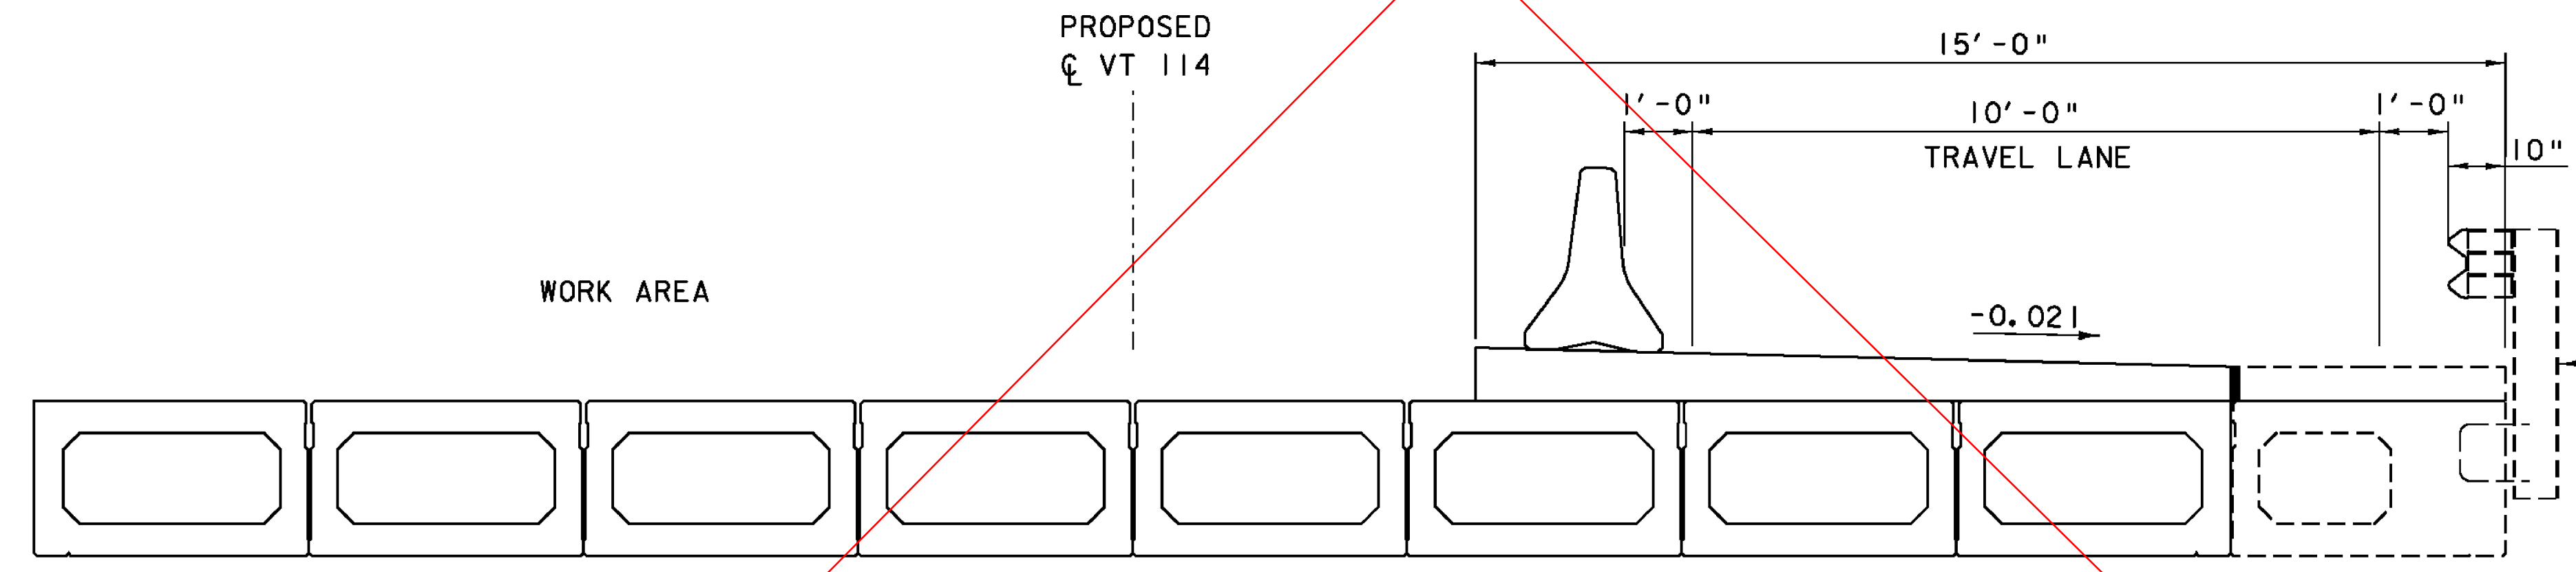

PHASE II

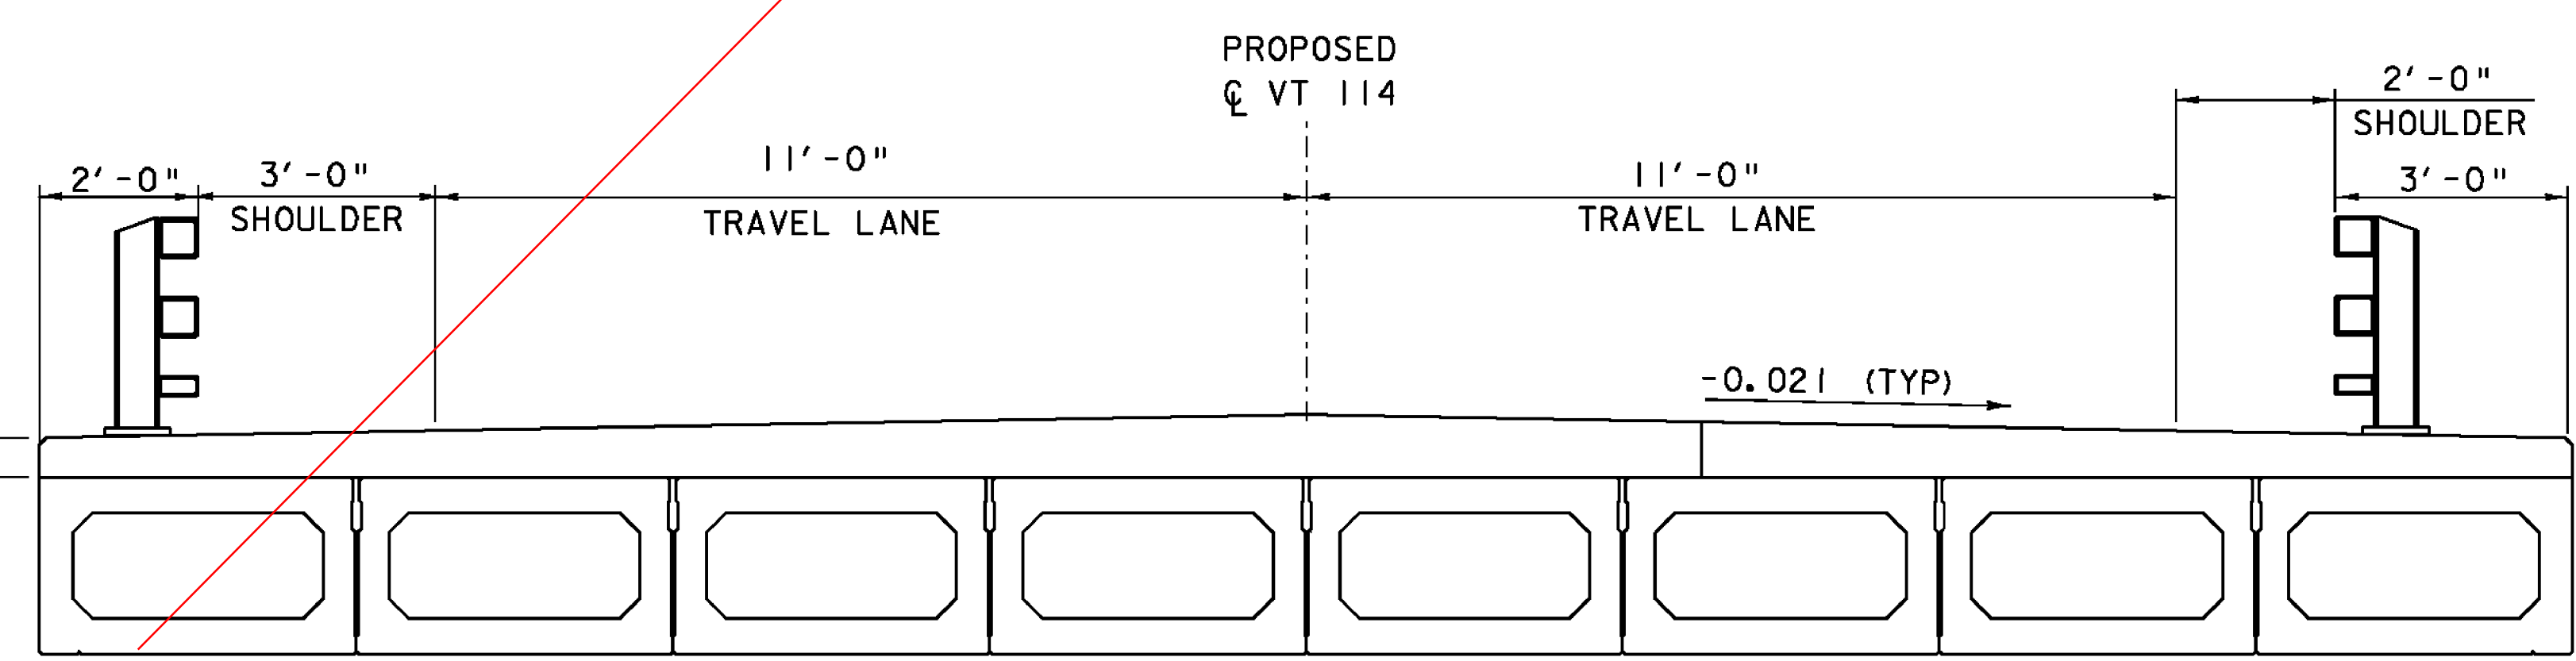

FINAL CONDITION


NOTE:

THE TRAFFIC CONTROL PHASING SHOWN IS OF A CONCEPTUAL NATURE ONLY. THE CONTRACTOR SHALL SUPPLY A DETAILED TRAFFIC CONTROL PLAN, WHICH NEED NOT UTILIZE PHASING OR THE PHASING SHOWN HERE. SEE THE TRAFFIC CONTROL NOTES AND THE SPECIFICATIONS FOR ITEM 900.645 SPECIAL PROVISION (TRAFFIC CONTROL, ALL-INCLUSIVE) FOR MORE DETAILS.


CONTRACTOR TO PROVIDE ADDITIONAL WIDTH FOR PHASED CONSTRUCTION. SEE SPECIAL PROVISIONS FOR ITEM 900.645 SPECIAL PROVISION (TEMPORARY BRIDGE WIDENING FOR PHASED CONSTRUCTION)

NOTE - THIS PHASED CONCEPTUAL DESIGN WAS NOT USED. THE CONTRACTOR WAS ABLE TO INSTALL A ONE-WAY TEMPORARY BRIDGE & CONSTRUCT A NEW BRIDGE IN A SINGLE PHASE.


TEMPORARY BRIDGE RAILING, AASHTO TL-2 (MIN) (PAID FOR UNDER SPECIAL PROVISION (TEMPORARY BRIDGE WIDENING FOR PHASED CONSTRUCTION))

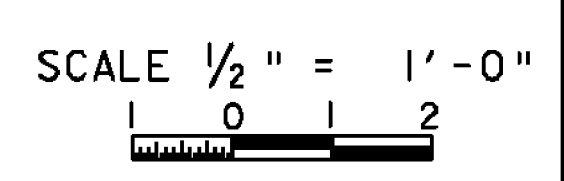


PROJECT NAME: EAST HAVEN	PLOT DATE: 08-AUG-2011
PROJECT NUMBER: BRP 0269(II)	DRAWN BY: R. PELLETT
FILE NAME: s00cl62phasing.dgn	CHECKED BY: J. LACROIX
PROJECT LEADER: K. HIGGINS	SHEET II OF 40
DESIGNED BY: J. LACROIX	
TRAFFIC PHASING TYPICALS	

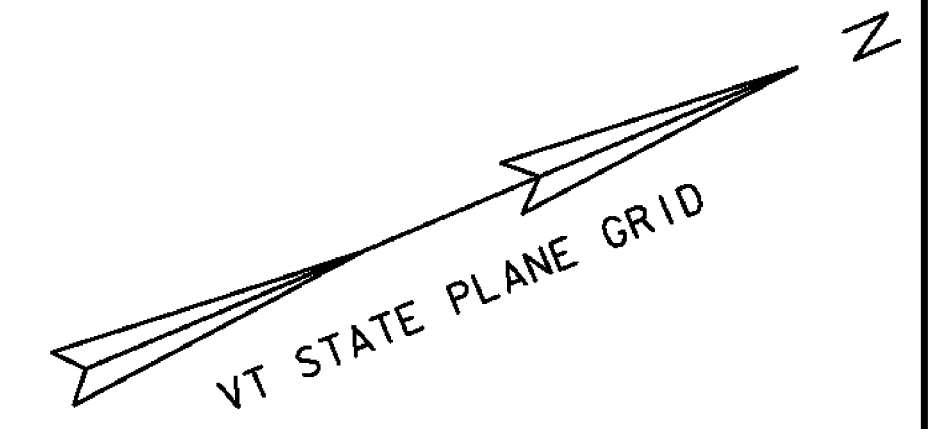

SEE NOTE SHEET II

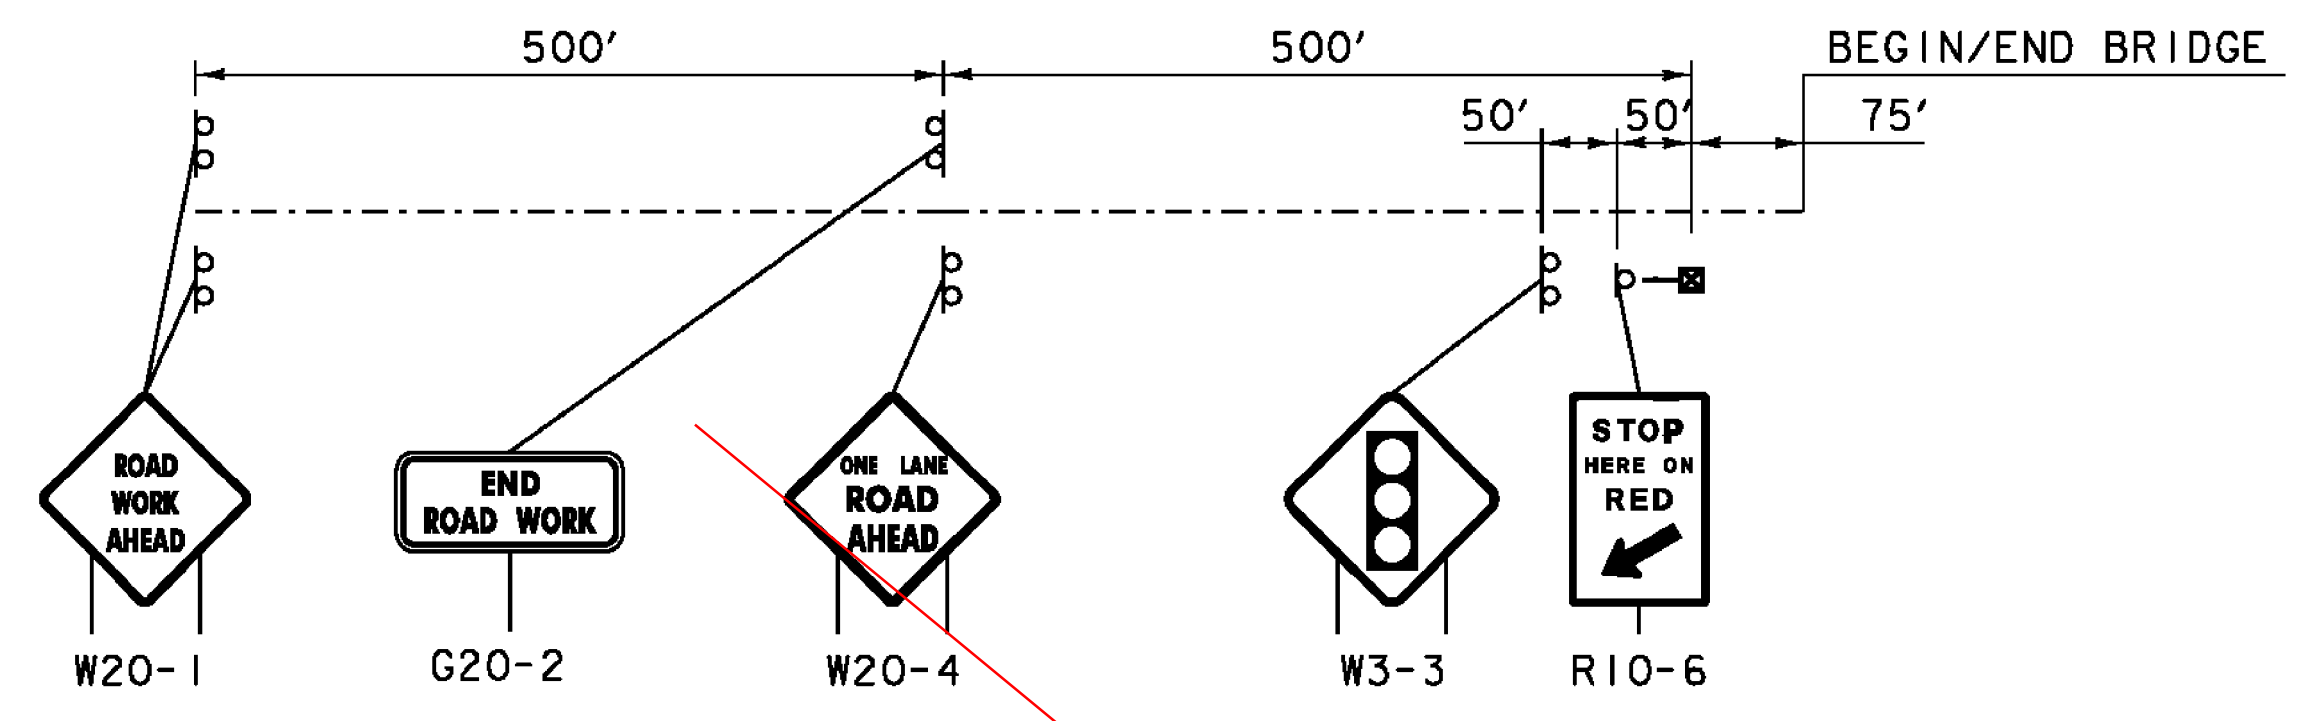


APPROACH SIGNS
NOT TO SCALE

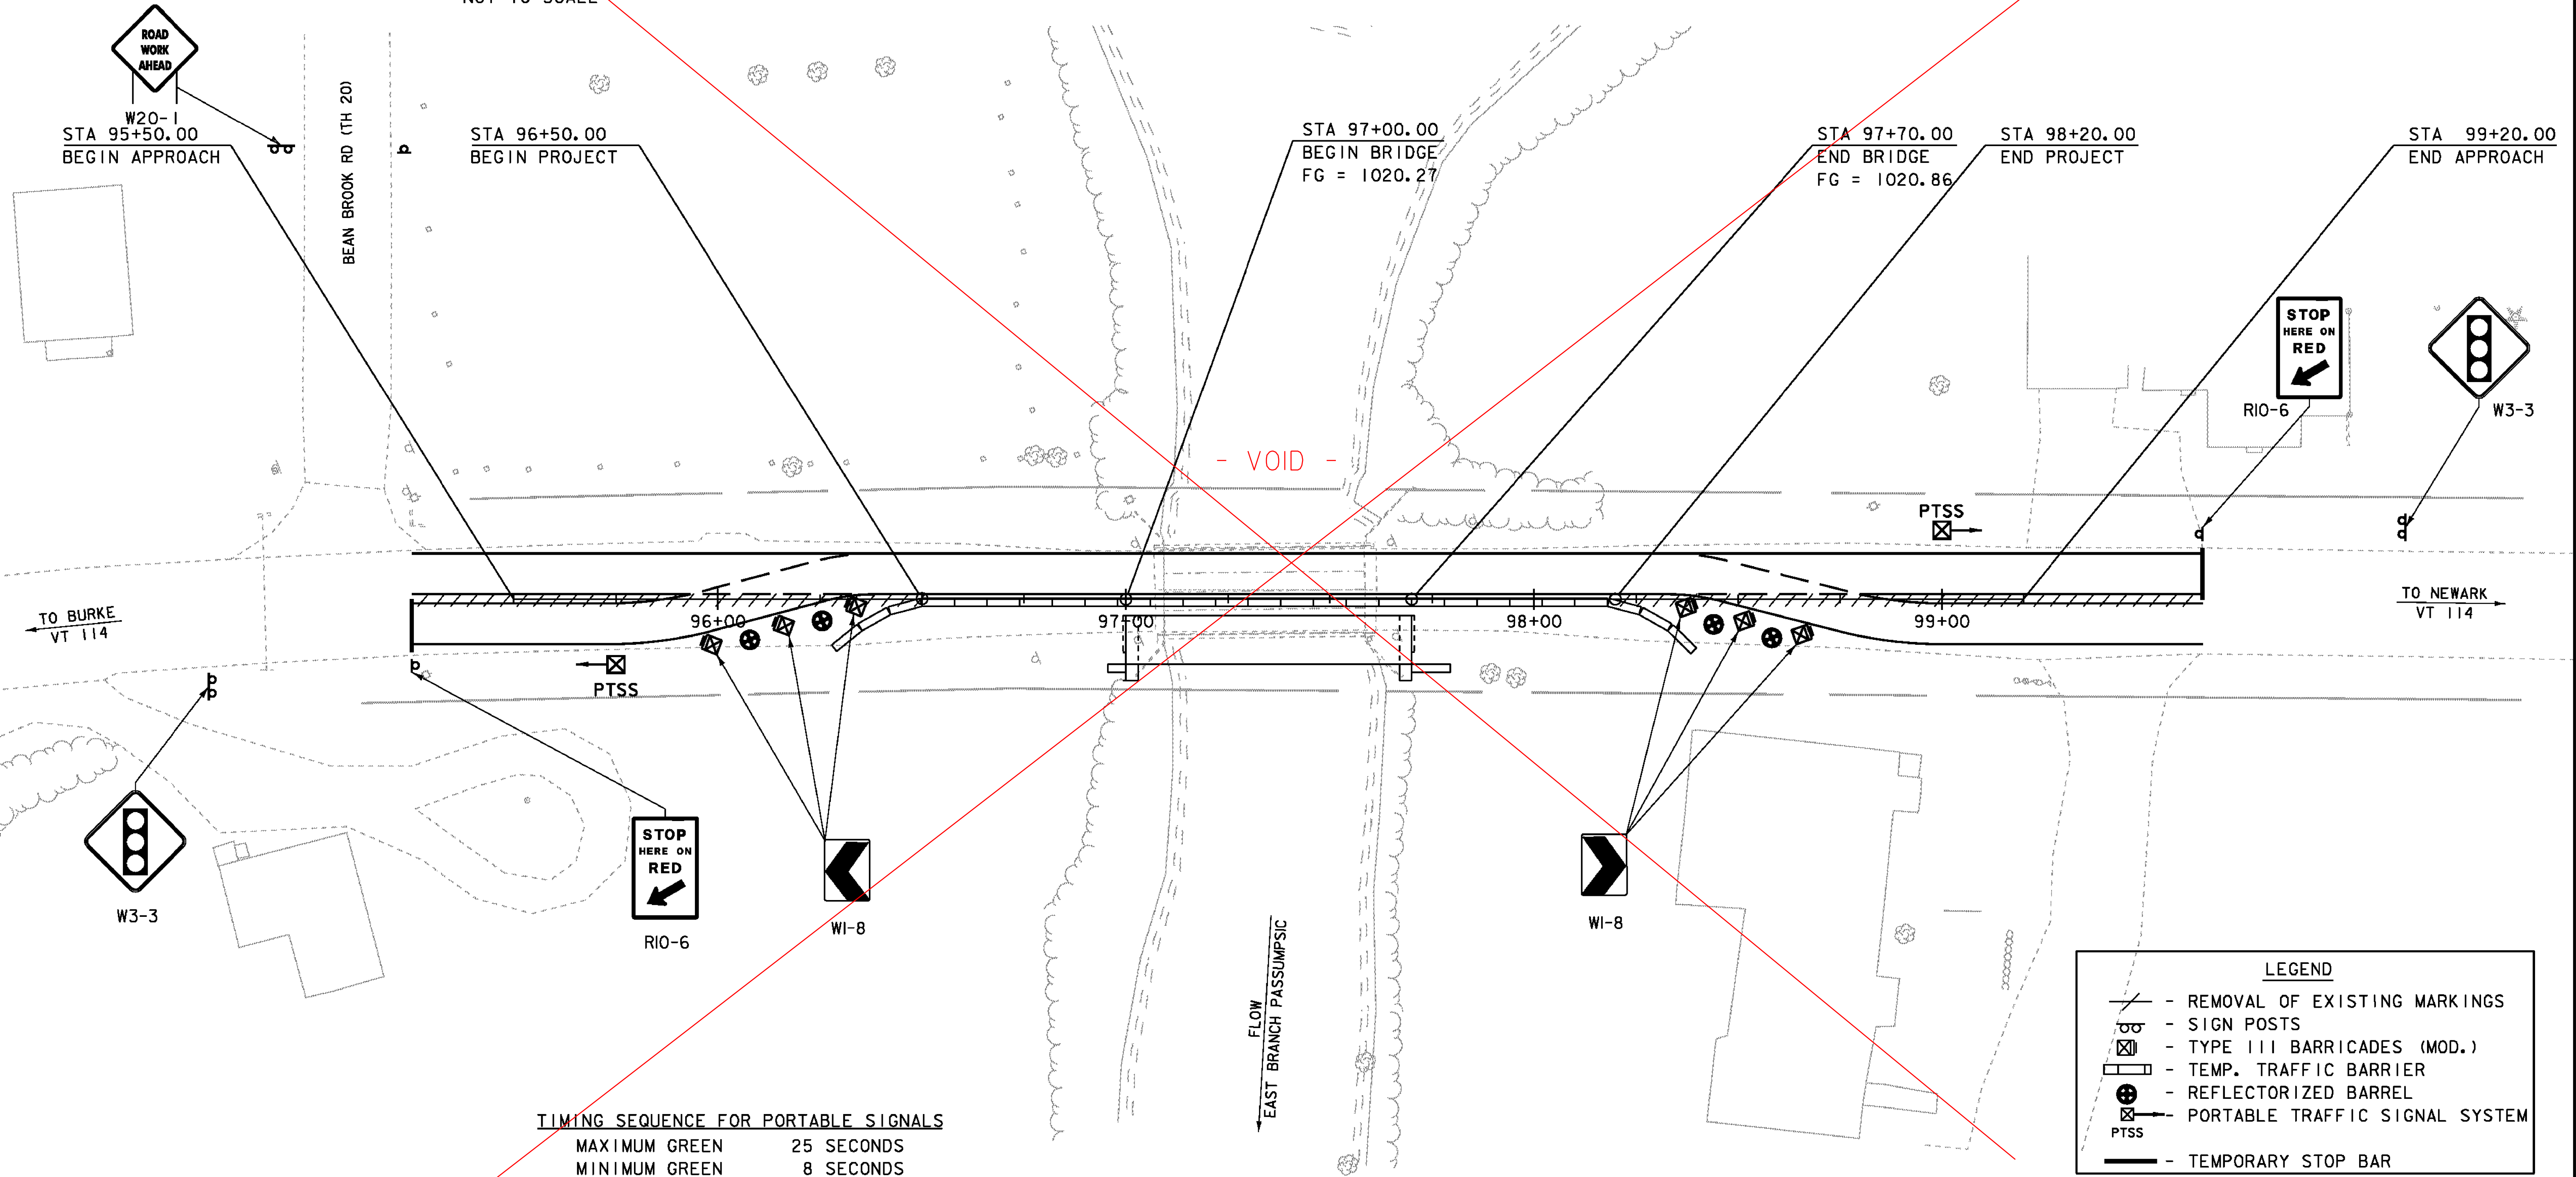

TIMING SEQUENCE FOR PORTABLE SIGNALS

MAXIMUM GREEN	25 SECONDS
MINIMUM GREEN	8 SECONDS
EXTENSION	2 SECONDS
ALL-RED CLEARANCE	16 SECONDS


TRAFFIC CONTROL - PHASE I

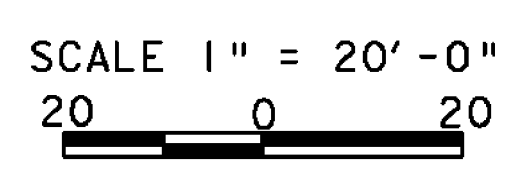


LEGEND

- REMOVAL OF EXISTING MARKINGS
- SIGN POSTS
- TYPE III BARRICADES (MOD.)
- TEMP. TRAFFIC BARRIER
- REFLECTORIZED BARREL
- PORTABLE TRAFFIC SIGNAL SYSTEM
- TEMPORARY STOP BAR

PROJECT NAME:	EAST HAVEN	PLOT DATE:	08-AUG-2011
PROJECT NUMBER:	BRF 0269(II)	DRAWN BY:	R. PELLETT
FILE NAME:	s00c162ph1a.dgn	CHECKED BY:	J. SALVATORI
PROJECT LEADER:	K. HIGGINS	TRAFFIC CONTROL - PHASE I	SHEET 12 OF 40

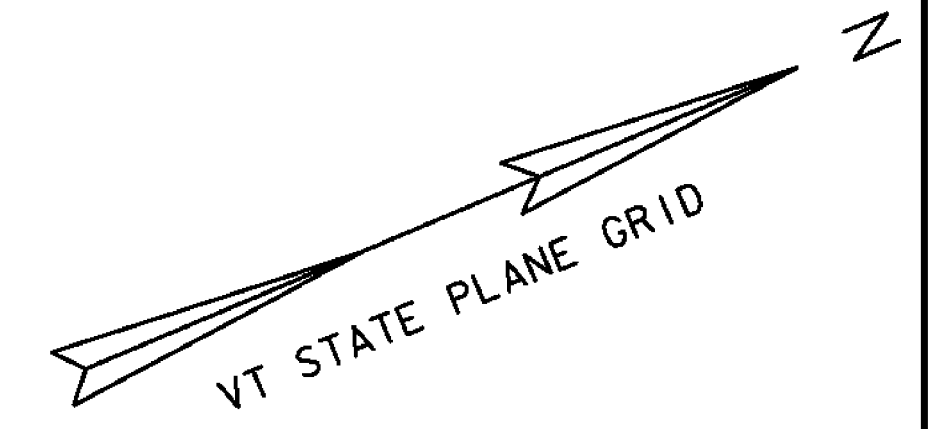

SEE NOTE - SHEET II

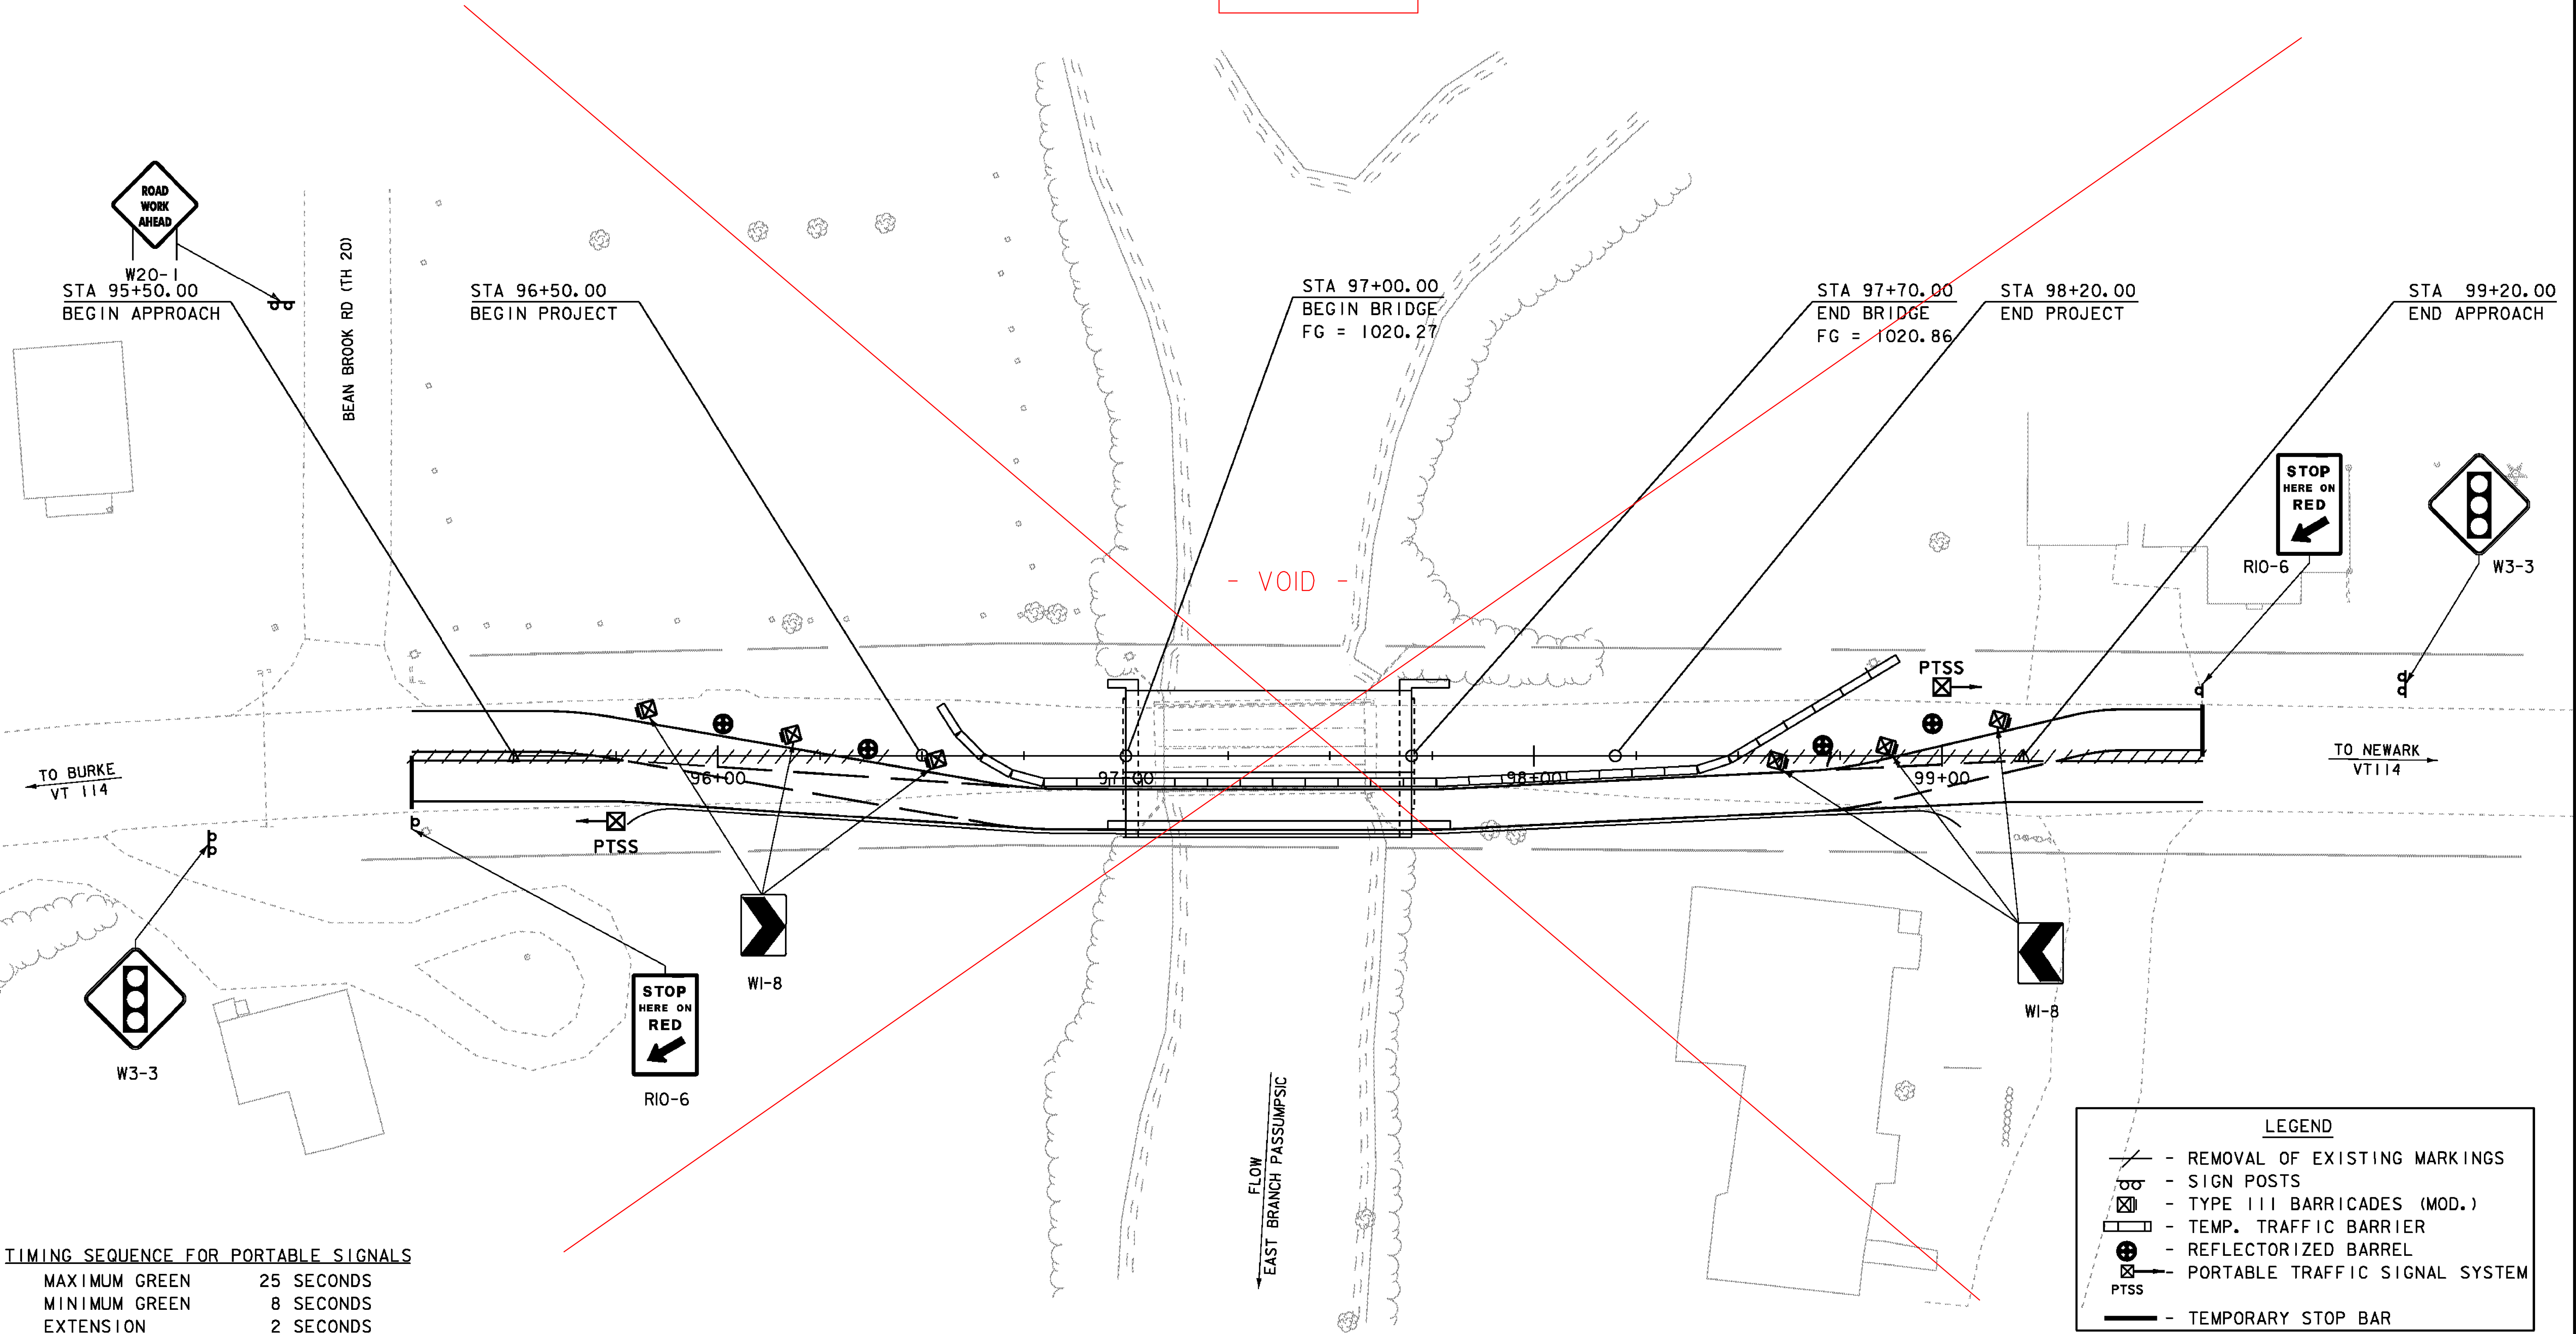


TIMING SEQUENCE FOR PORTABLE SIGNALS

MAXIMUM GREEN	25 SECONDS
MINIMUM GREEN	8 SECONDS
EXTENSION	2 SECONDS
ALL-RED CLEARANCE	16 SECONDS

LEGEND

- REMOVAL OF EXISTING MARKINGS
- SIGN POSTS
- TYPE III BARRICADES (MOD.)
- TEMP. TRAFFIC BARRIER
- REFLECTORIZED BARREL
- PORTABLE TRAFFIC SIGNAL SYSTEM (PTSS)
- TEMPORARY STOP BAR

TRAFFIC CONTROL - PHASE II

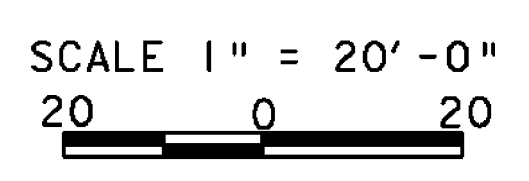

PROJECT NAME: EAST HAVEN	PLOT DATE: 08-AUG-2011
PROJECT NUMBER: BRF 0269(II)	DRAWN BY: R. PELLETT
FILE NAME: s00c162ph1a2.dgn	CHECKED BY: J. SALVATORI
PROJECT LEADER: K. HIGGINS	SHEET 13 OF 40
DESIGNED BY: J. SALVATORI	
TRAFFIC CONTROL - PHASE II	


STATE OF VERMONT
AGENCY OF TRANSPORTATION

REINFORCING STEEL SCHEDULE

ITEM	EACH	SIZE	LENGTH	MARK	TYPE	A	B	C	D	E	F	G	H	J	K	R	O	ITEM	EACH	SIZE	LENGTH	MARK	TYPE	A	B	C	D	E	F	G	H	J	K	R	O		
DECK																																					
	66	5	36'-3"	ES501	STR	36'-3"																															
△	73	5	10'-6"	ES502	STR	10'-6"																															
	71	5	20'-6"	ES503	STR	20'-6"																															
	66	5	4'-8"	ES504	17		2'-2"	2'-6"	---																												
△	132	6	23'-2"	ES601	3	0'-8"	2'-6"	20'-0"	---	---	---	---	17'-4"	0'-6"	10'-0"																						
APPROACH SLAB #1																																					
	21	5	8'-6"	1EAS501	STR	8'-6"																															
	21	5	17'-6"	1EAS502	STR	17'-6"																															
	33	9	20'-9"	1EAS901	1	1'-3"	19'-6"																														
APPROACH SLAB #2																																					
	21	5	8'-6"	2EAS501	STR	8'-6"																															
	21	5	17'-6"	2EAS502	STR	17'-6"																															
	33	9	20'-9"	2EAS901	1	1'-3"	19'-6"																														
ABUTMENT #1																																					
	19	5	16'-6"	1A501	STR	16'-6"																															
	19	5	21'-2"	1A502	STR	21'-2"																															
	78	6	10'-3"	1A601	S10		3'-6"	3'-3"	3'-6"																												
△	8	5	12'-6"	1EA501	STR	12'-6"																															
	8	5	21'-2"	1EA502	STR	21'-2"																															
				1EA503	BAR NOT USED																																
	33	5	3'-9"	1EA504	1	0'-7"	2'-7"																														
	3	5	10'-3"	1EA505	S10		4'-7"	1'-1"	4'-7"																												
	33	6	7'-1"	1EA601	S10		3'-0"	1'-1"	3'-0"																												
WINGWALL #1																																					
△	10	5	7'-9"	1W501	STR	7'-9"																															
	12	5	9'-2"	1W502	22		2'-2"	7'-0"	---																												
	4	5	5'-11"	1W503	S10		2'-2"	1'-7"	2'-2"																												
	8	5	7'-0"	1EW501	S10		2'-2"	4'-10"	---																												
	4	5	5'-11"	1EW502	S10		2'-2"	1'-7"	2'-2"																												
WINGWALL #2																																					
	8	5	4'-9"	2W501	STR	4'-9"																															
	12	5	9'-2"	2W502	22		2'-2"	7'-0"	---																												
	4	5	5'-11"	2W503	S10		2'-2"	1'-7"	2'-2"																												
	8	5	4'-10"	2EW501	STR	4'-10"																															
	4	5	3'-11"	2EW502	S10		1'-9"	2'-2"	---																												
	4	5	2'-4"	2EW503	S10		0'-2"	2'-2"	---																												
	6	5	7'-7"	2EW504	S10		3'-0"	1'-7"	3'-0"																												
ABUTMENT #2																																					
	19	5	16'-6"	2A501	STR	16'-6"																															
	19	5	21'-2"	2A502	STR	21'-2"																															
	78	6	11'-1"	2A601	S10		3'-11"	3'-3"	3'-11"																												
△	8	5	12'-6"	2EA501	STR	12'-6"																															
	8	5	21'-2"	2EA502	STR	21'-2"																															
				2EA503	BAR NOT USED																																
	33	5	3'-9"	2EA504	1	0'-7"	2'-7"																														
	3	5	10'-3"	2EA505	S10		4'-7"	1'-1"	4'-7"																												
	33	6	7'-1"	2EA601	S10		3'-0"	1'-1"	3'-0"																												
WINGWALL #3																																					
△	22	5	8'-3"	3W501	STR	8'-3"																															
	12	5	14'-2"	3W502	22		2'-2"	12'-0"	---																												
	10	5	5'-11"	3W503	S10		2'-2"	1'-7"	2'-2"																												
	8	5	12'-0"	3EW501	22		2'-2"	9'-10"	---																												
	10	5	5'-11"	3EW502	S10		2'-2"	1'-7"	2'-2"																												
WINGWALL #4																																					
	20	5	5'-3"	4W501	STR	5'-3"																															
	12	5	14'-2"	4W502	22		2'-2"	12'-0"	---																												
	10	5	5'-11"	4W503	S10		2'-2"	1'-7"	2'-2"																												
	8	5	9'-10"	4EW501	STR	9'-10"																															
	4	5	3'-11"	4EW502	S10		1'-9"	2'-2"	---																												
	4	5	2'-4"	4EW503	S10		0'-2"	2'-2"	---																												
	12	5	7'-7"	4EW504	S10		3'-0"	1'-7"	3'-0"																												


~ NOTES ~

- UNLESS OTHERWISE DESIGNATED, ALL BAR REINFORCEMENT FOR CONCRETE IN SIZES UP TO AND INCLUDING NO. 18 SHALL CONFORM TO THE REQUIREMENTS OF THE "SPECIFICATIONS FOR DEFORMED BILLET-STEEL BARS FOR CONCRETE REINFORCEMENT", AASHTO M 31 (ASTM A 615-S1). ALL BARS SHALL BE GRADE 60, UNLESS OTHERWISE DESIGNATED.
- FOR TYPICAL BENDING DETAILS, RECOMMENDED PIN DIAMETER "D" OF BENDS AND HOOKS, AND OTHER STANDARD PRACTICE, SEE CURRENT CONCRETE REINFORCING STEEL INSTITUTE "MANUAL OF STANDARD PRACTICE".
- BARS WHICH REQUIRE MORE ACCURATE BENDING THAN STANDARD PRACTICES SHOULD HAVE LIMITS INDICATED.
- ALL DIMENSIONS ARE OUT TO OUT OF BAR EXCEPT "A" AND "G" ON STANDARD 180 DEGREE AND 135 DEGREE HOOKS.
- "J" DIMENSION ON 180 DEGREE HOOKS TO BE SHOWN ONLY WHERE NECESSARY TO RESTRICT HOOK SIZE. OTHERWISE, STANDARD HOOKS ARE TO BE USED.
- "H" DIMENSION ON STIRRUPS TO BE SHOWN ONLY WHEN NECESSARY TO MAINTAIN CLEARANCES.
- WHERE SLOPE DIFFERS FROM 45 DEGREES, DIMENSIONS "H" AND "K" MUST BE SHOWN.
- ▲ DENOTES BARS TO BE CUT IN FIELD.
- * DENOTES ONE EXTRA BAR ADDED FOR TESTING PURPOSES.
- △ DENOTES TWO EXTRA BARS ADDED FOR TESTING PURPOSES.
- E IN BAR MARK PREFIX DENOTES EPOXY COATED REINFORCING STEEL.

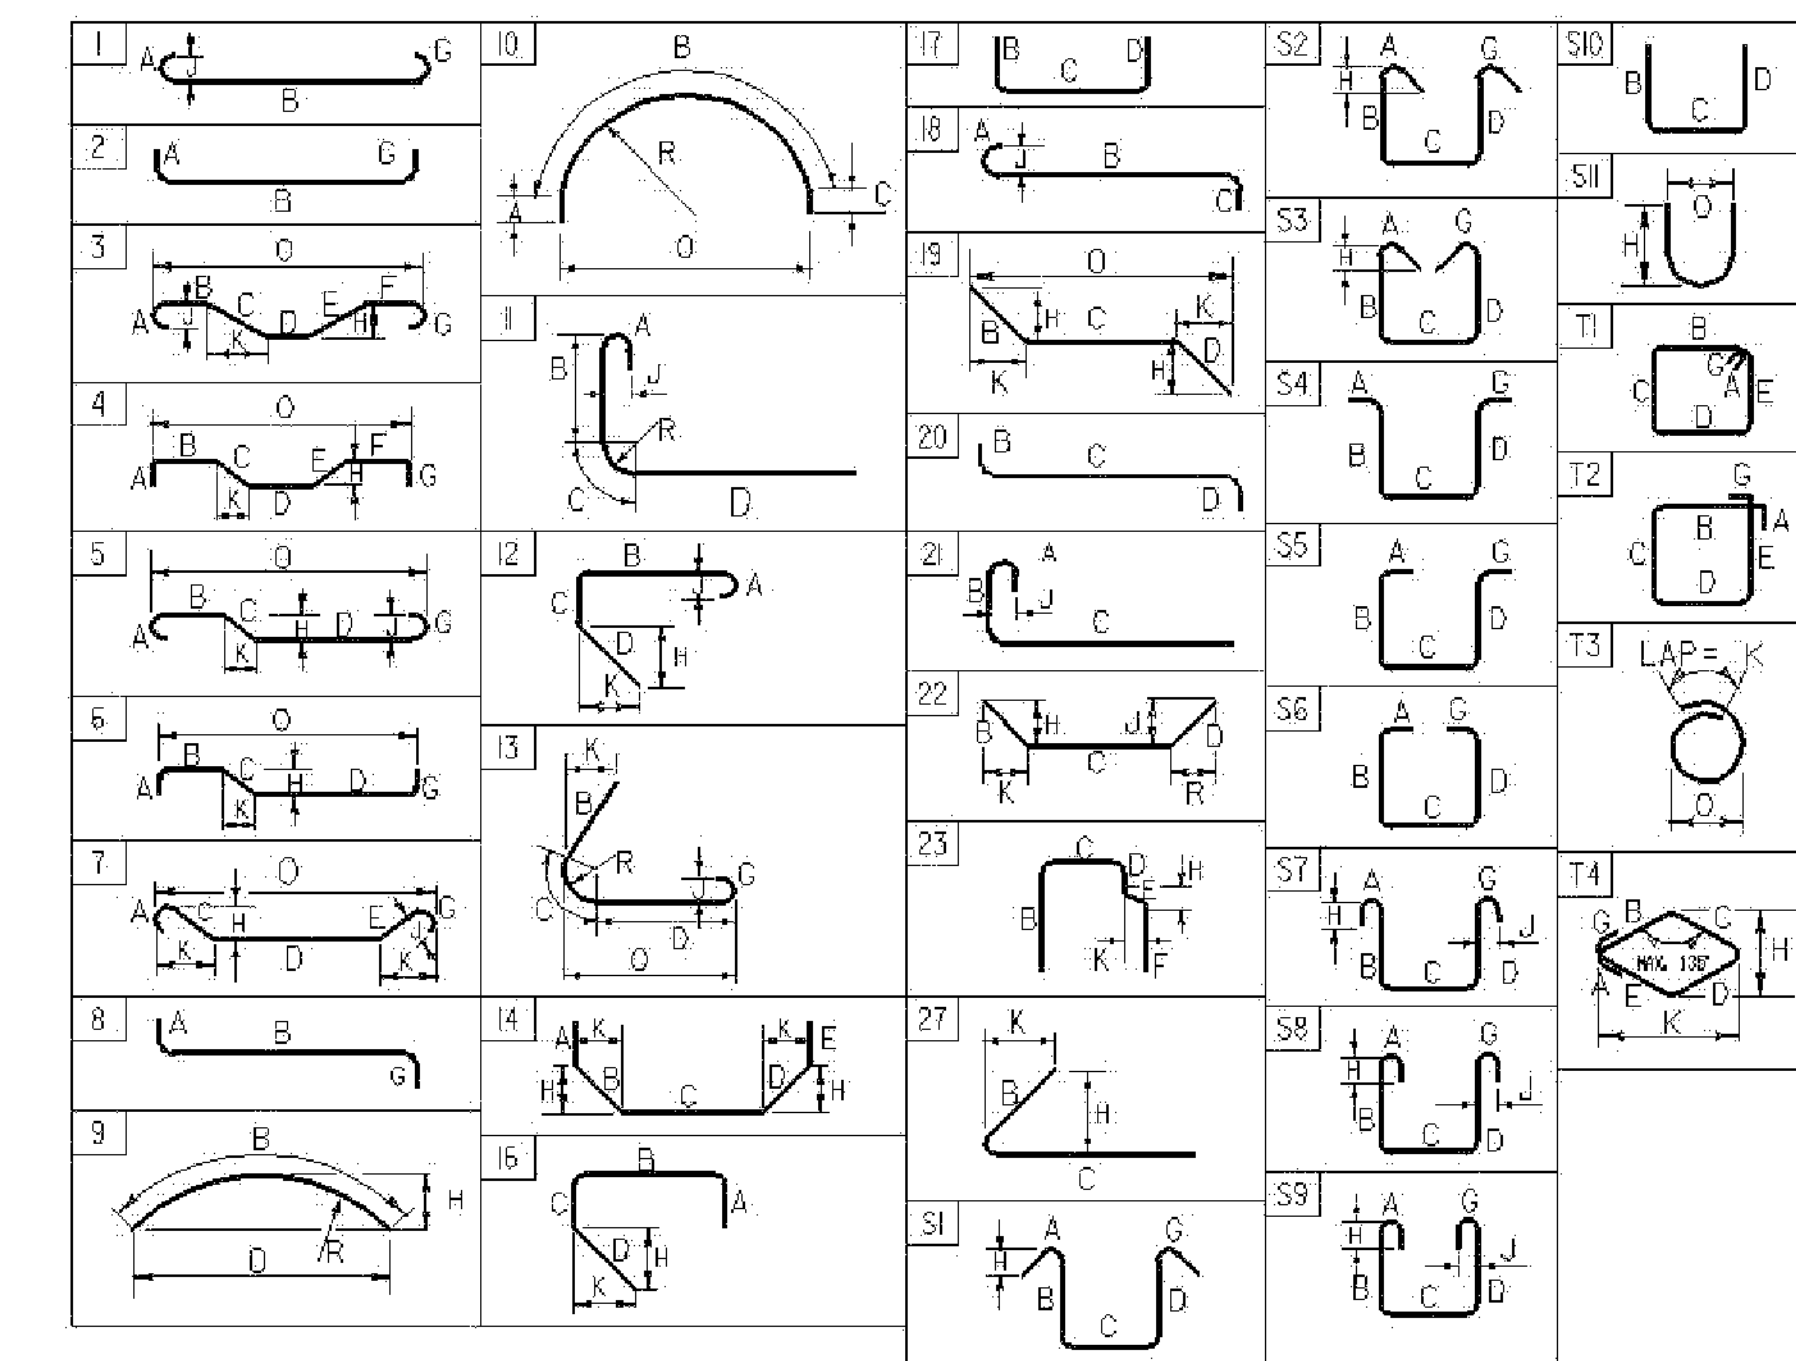


ASTM STANDARD REINFORCING BARS				
BAR SIZE DESIGNATION	WEIGHT POUNDS PER FOOT	NOMINAL DIMENSIONS ROUND SECTION		
		DIAMETER INCHES	AREA INCHES ²	PERIMETER INCHES
#3	0.376	0.375	0.11	1.178
#4	0.668	0.500	0.20	1.571
#5	1.043	0.625	0.31	1.963
#6	1.502	0.750	0.44	2.356
#7	2.044	0.875	0.60	2.749
#8	2.670	1.000	0.79	3.142
#9	3.400	1.128	1.00	3.544
#10	4.303	1.270	1.27	3.990
#11	5.313	1.410	1.56	4.430
#14	7.65	1.693	2.25	5.32
#18	13.60	2.257	4.00	7.09

PROJECT NAME: EAST HAVEN
PROJECT NUMBER: BRF 0269(11)
FILE NAME: s00c152rss.xls PLOT DATE: 8/2/2011
PROJECT MANAGER: K. HIGGINS DRAWN BY: R. PELLETT
DESIGNED BY: J. LACROIX CHECKED BY: J. LACROIX
REINFORCING STEEL SCHEDULE SHEET 27 OF 40

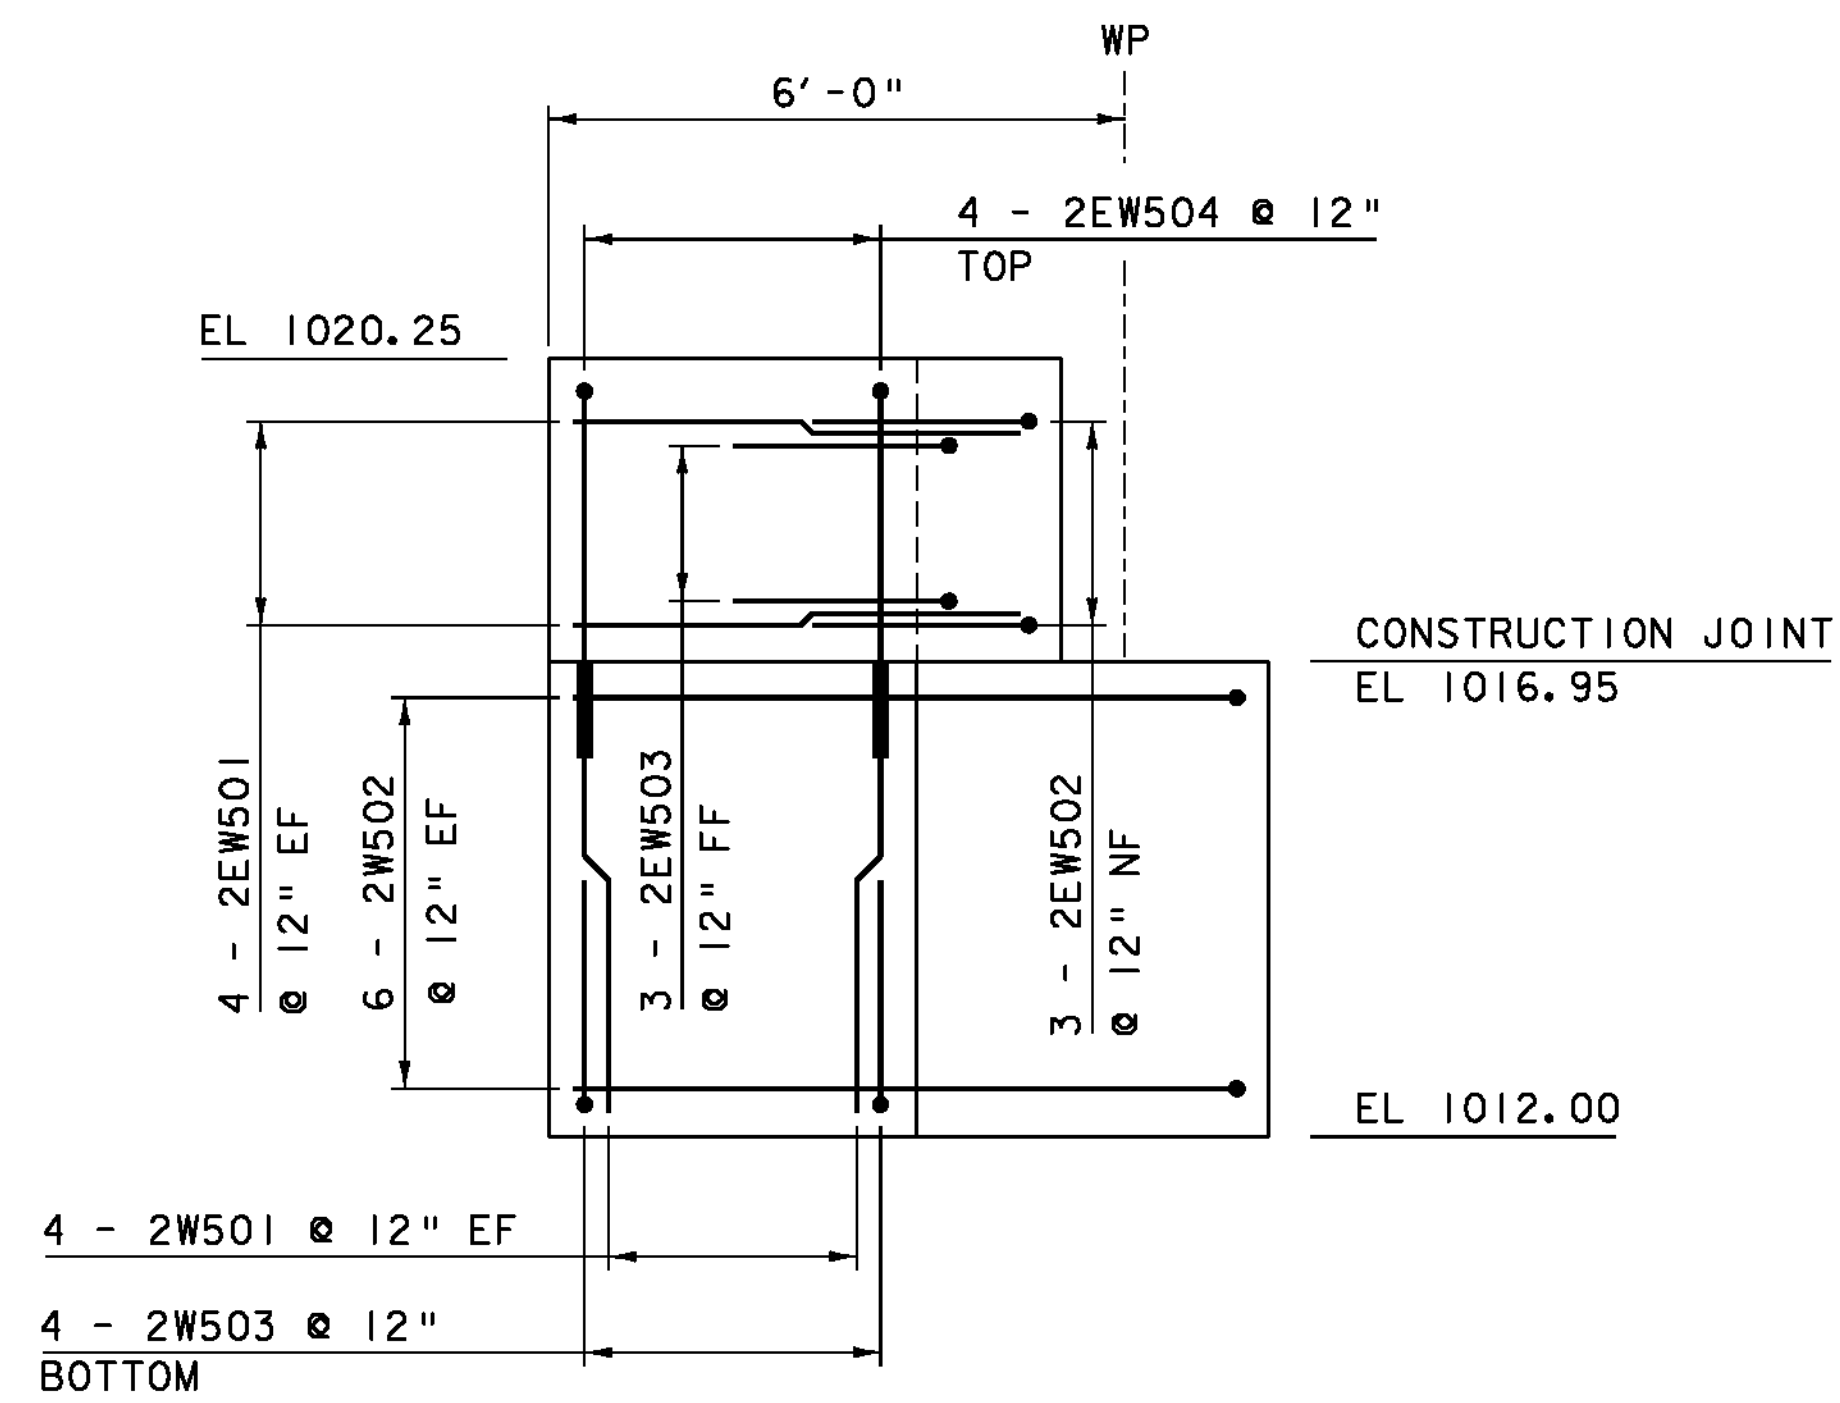


WINGWALL #2 ELEVATION VIEW

SCALE 1/2" = 1'-0"

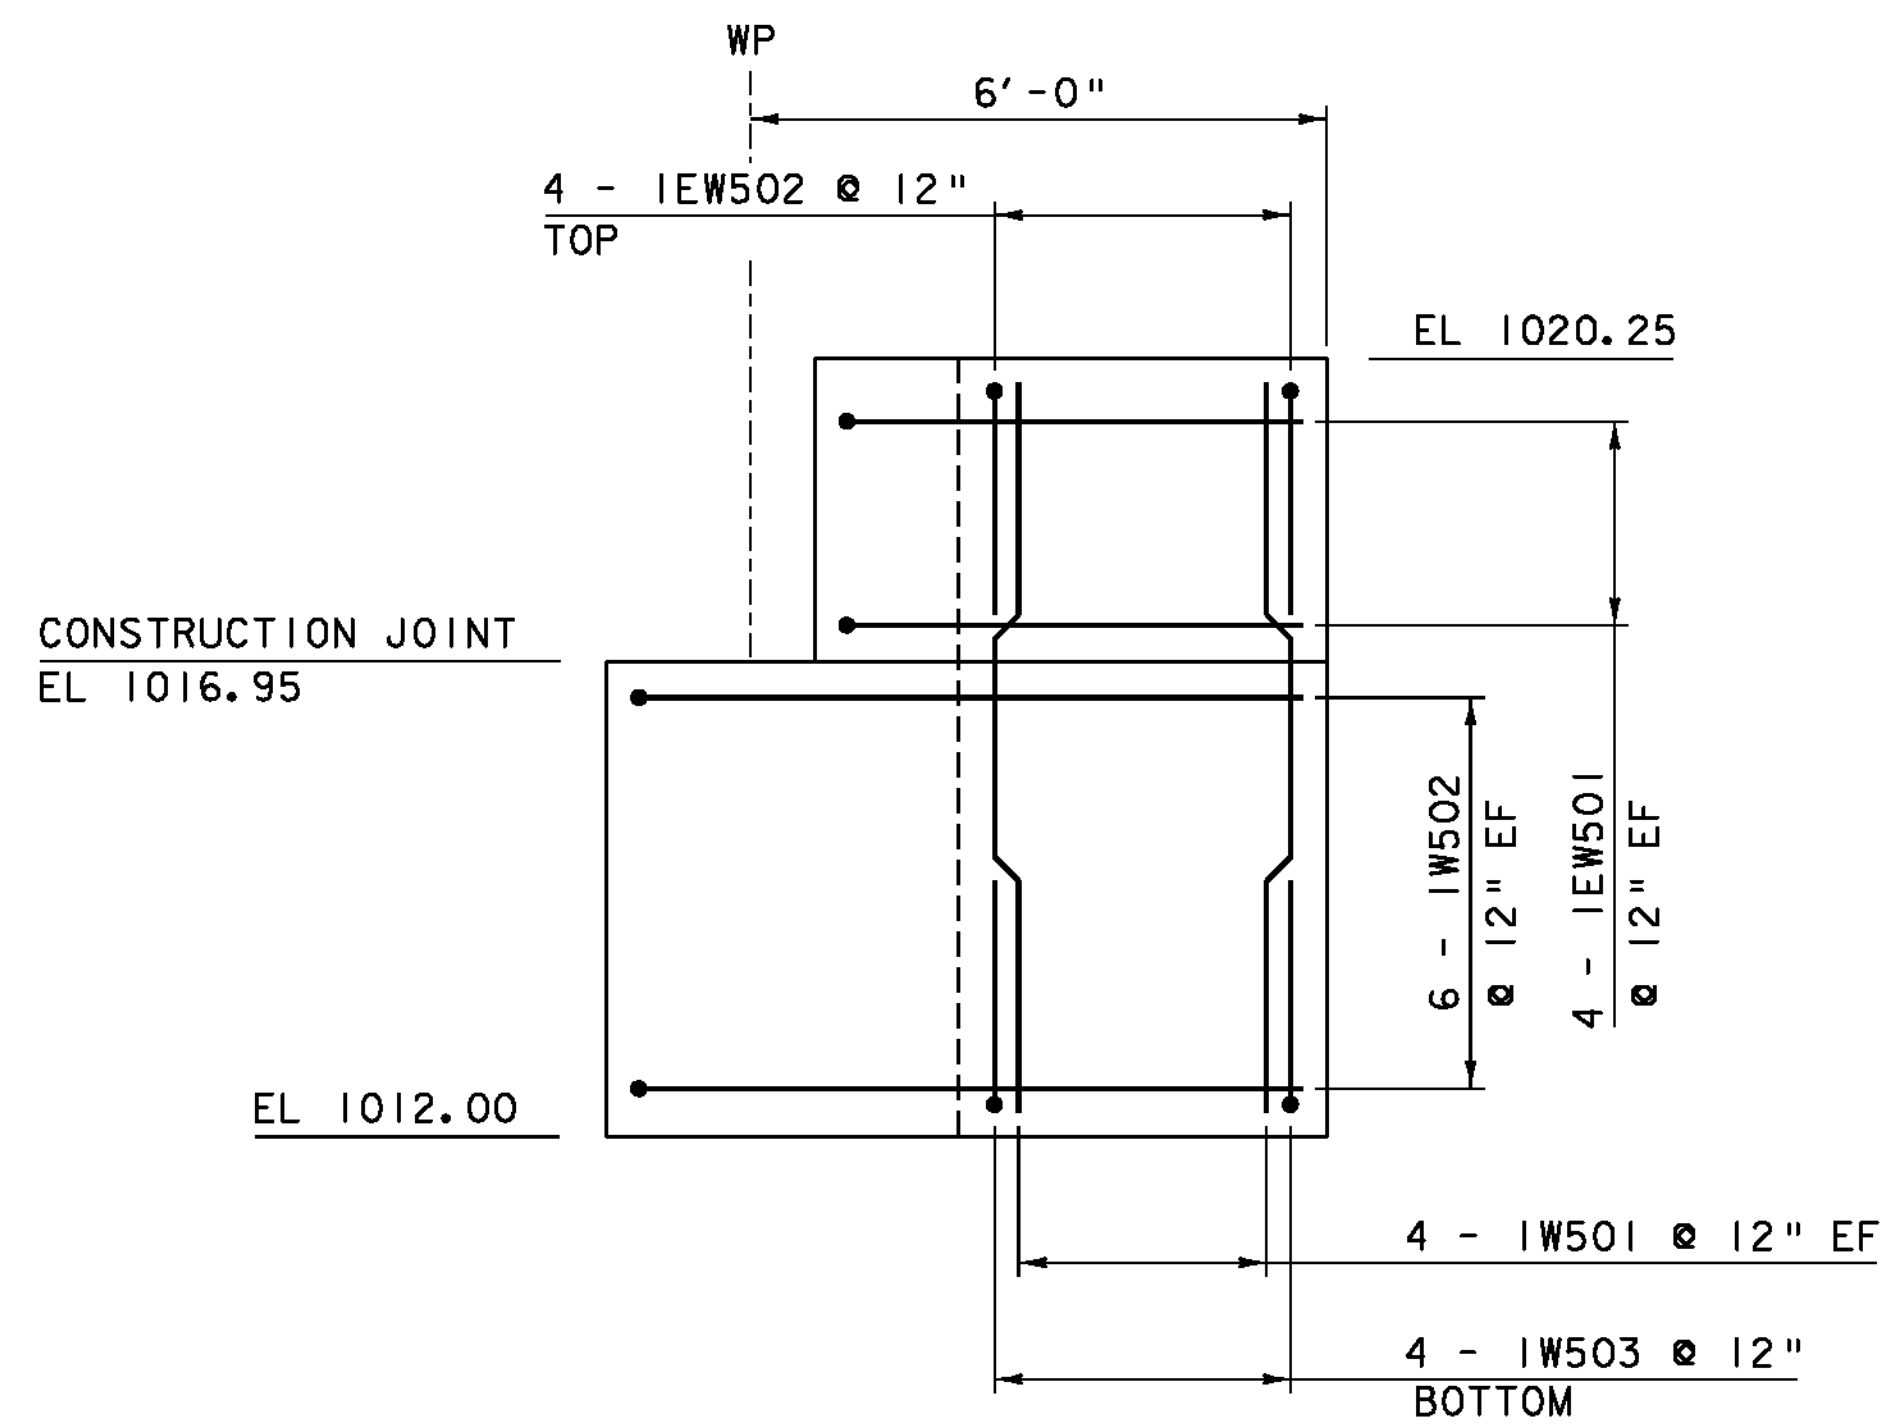


WINGWALL #1 ELEVATION VIEW

SCALE 1/2" = 1'-0"

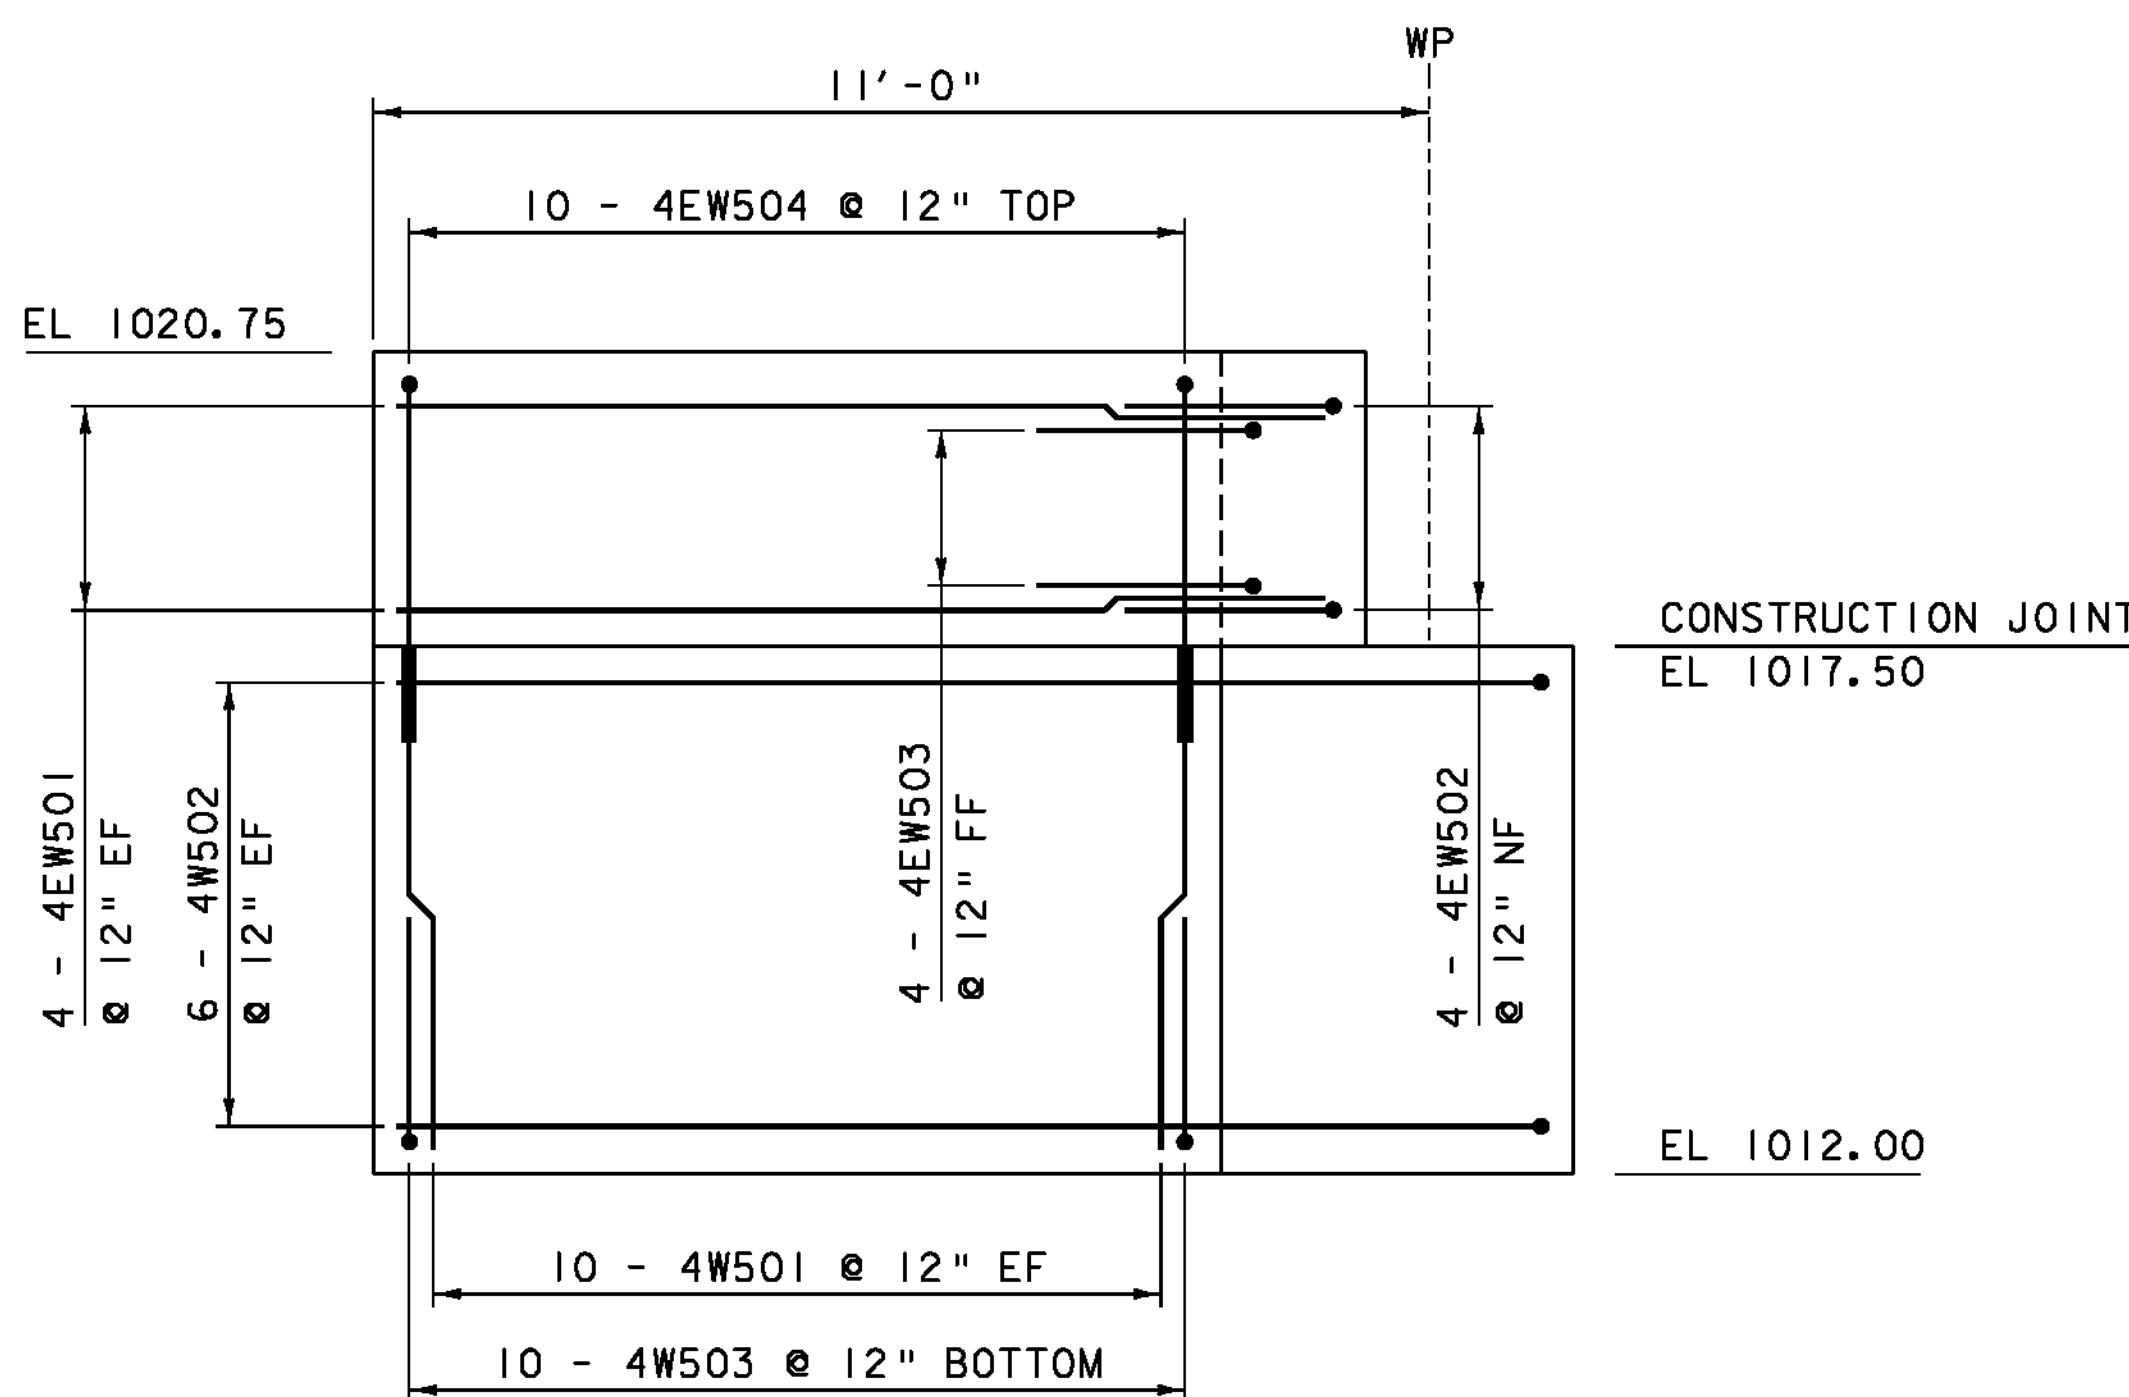


WINGWALL #4 ELEVATION VIEW

SCALE 1/2" = 1'-0"

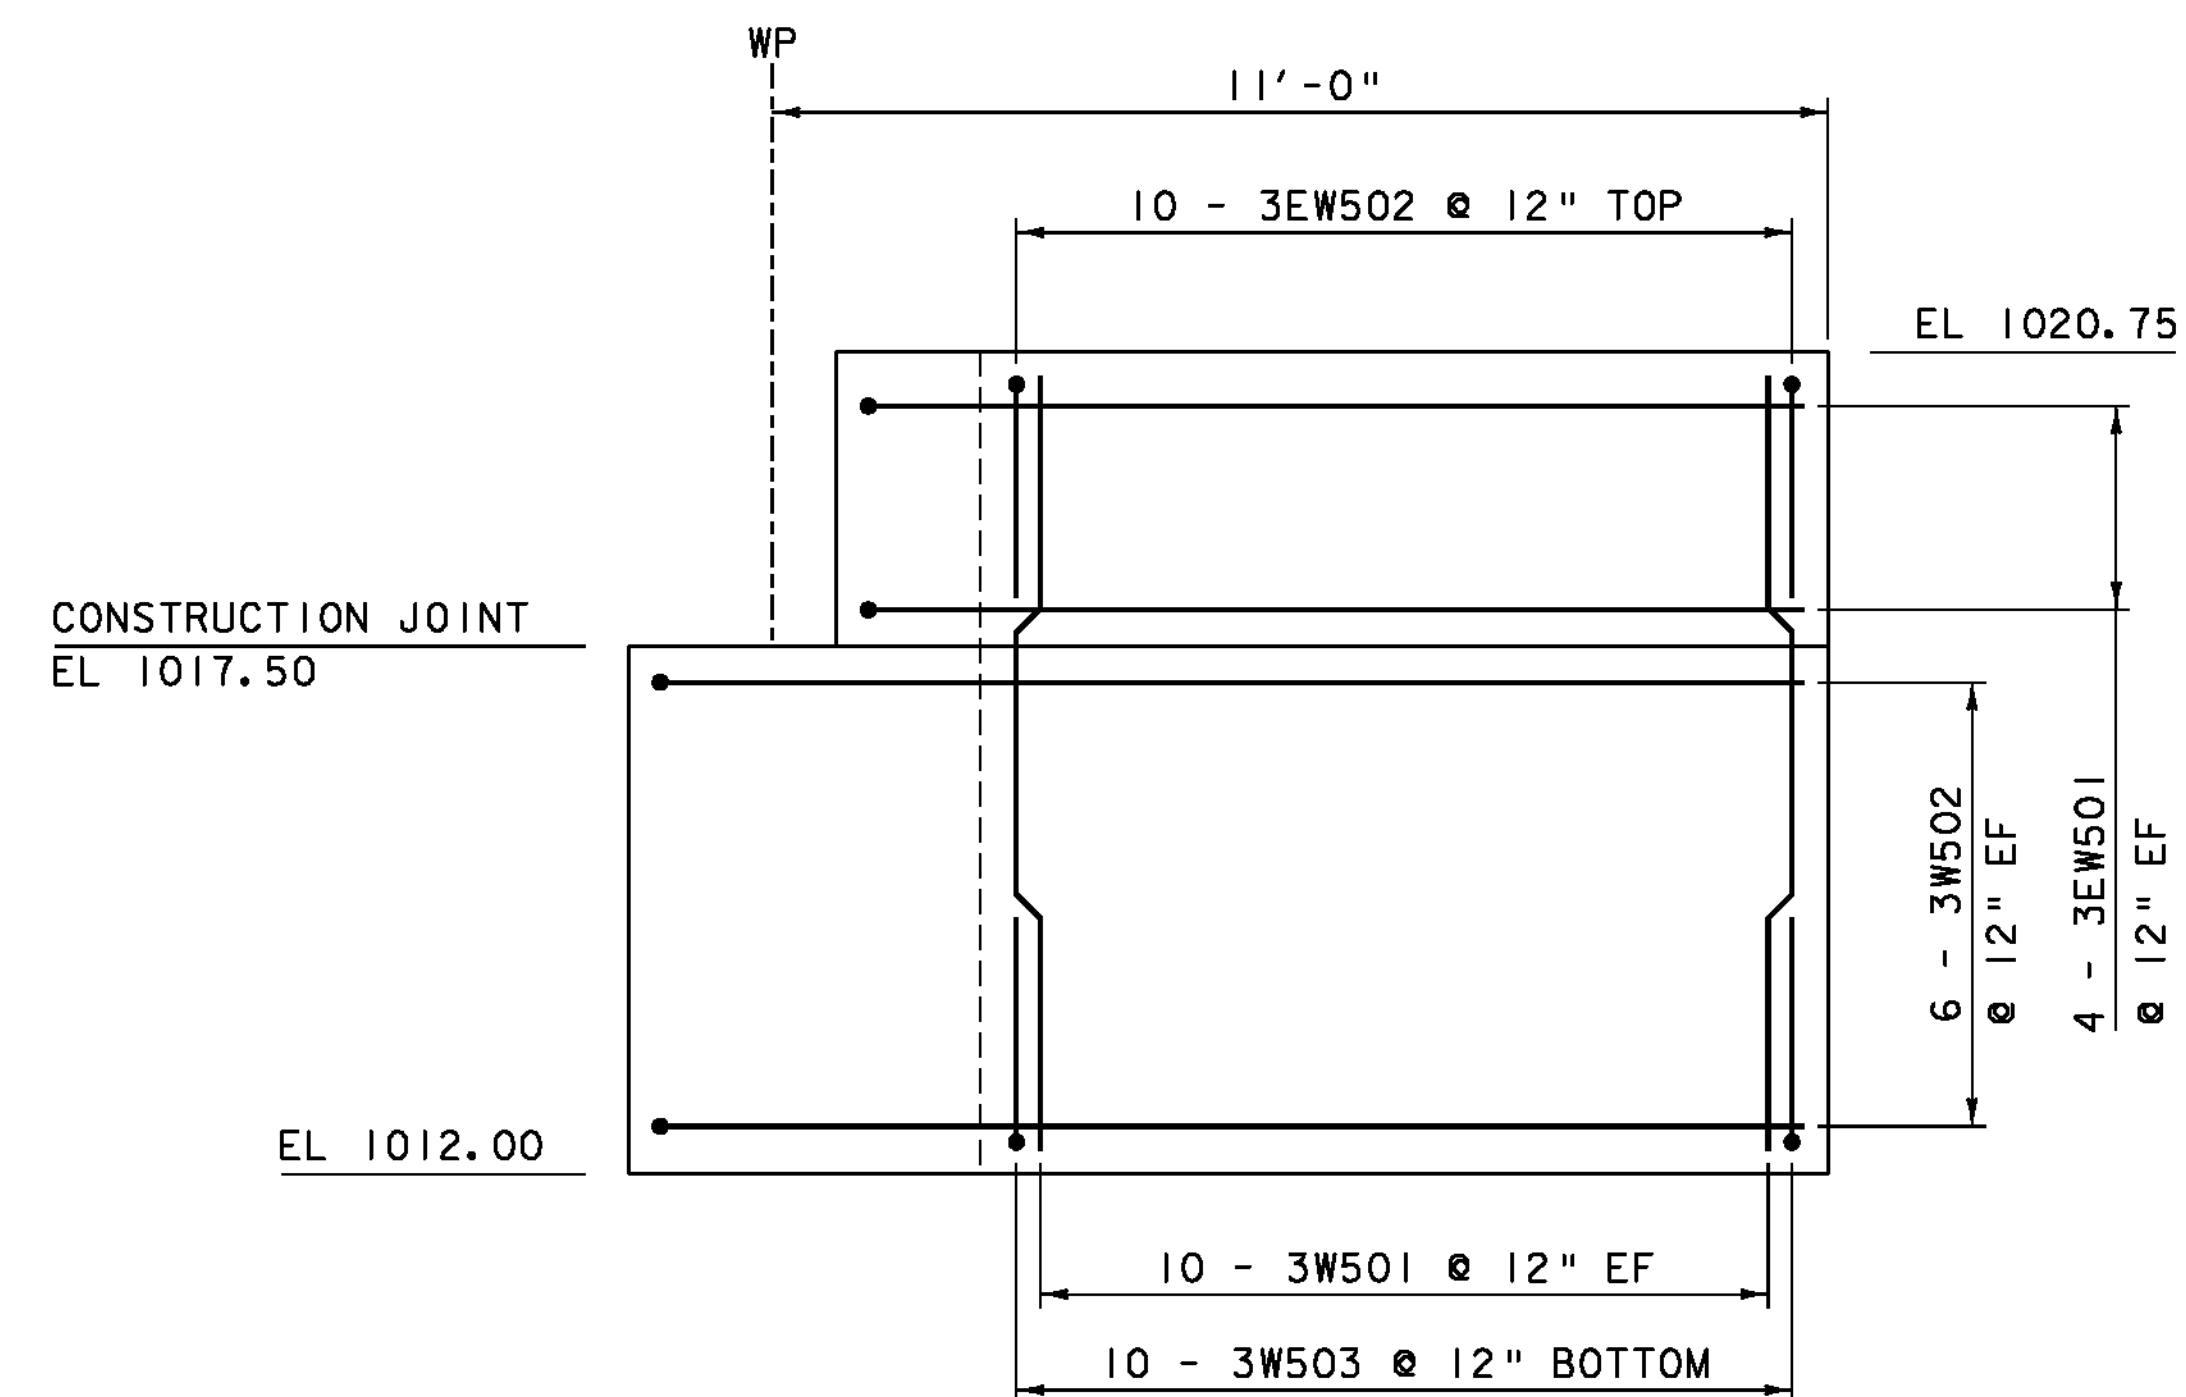

WINGWALL #3 ELEVATION VIEW

SCALE 1/2" = 1'-0"

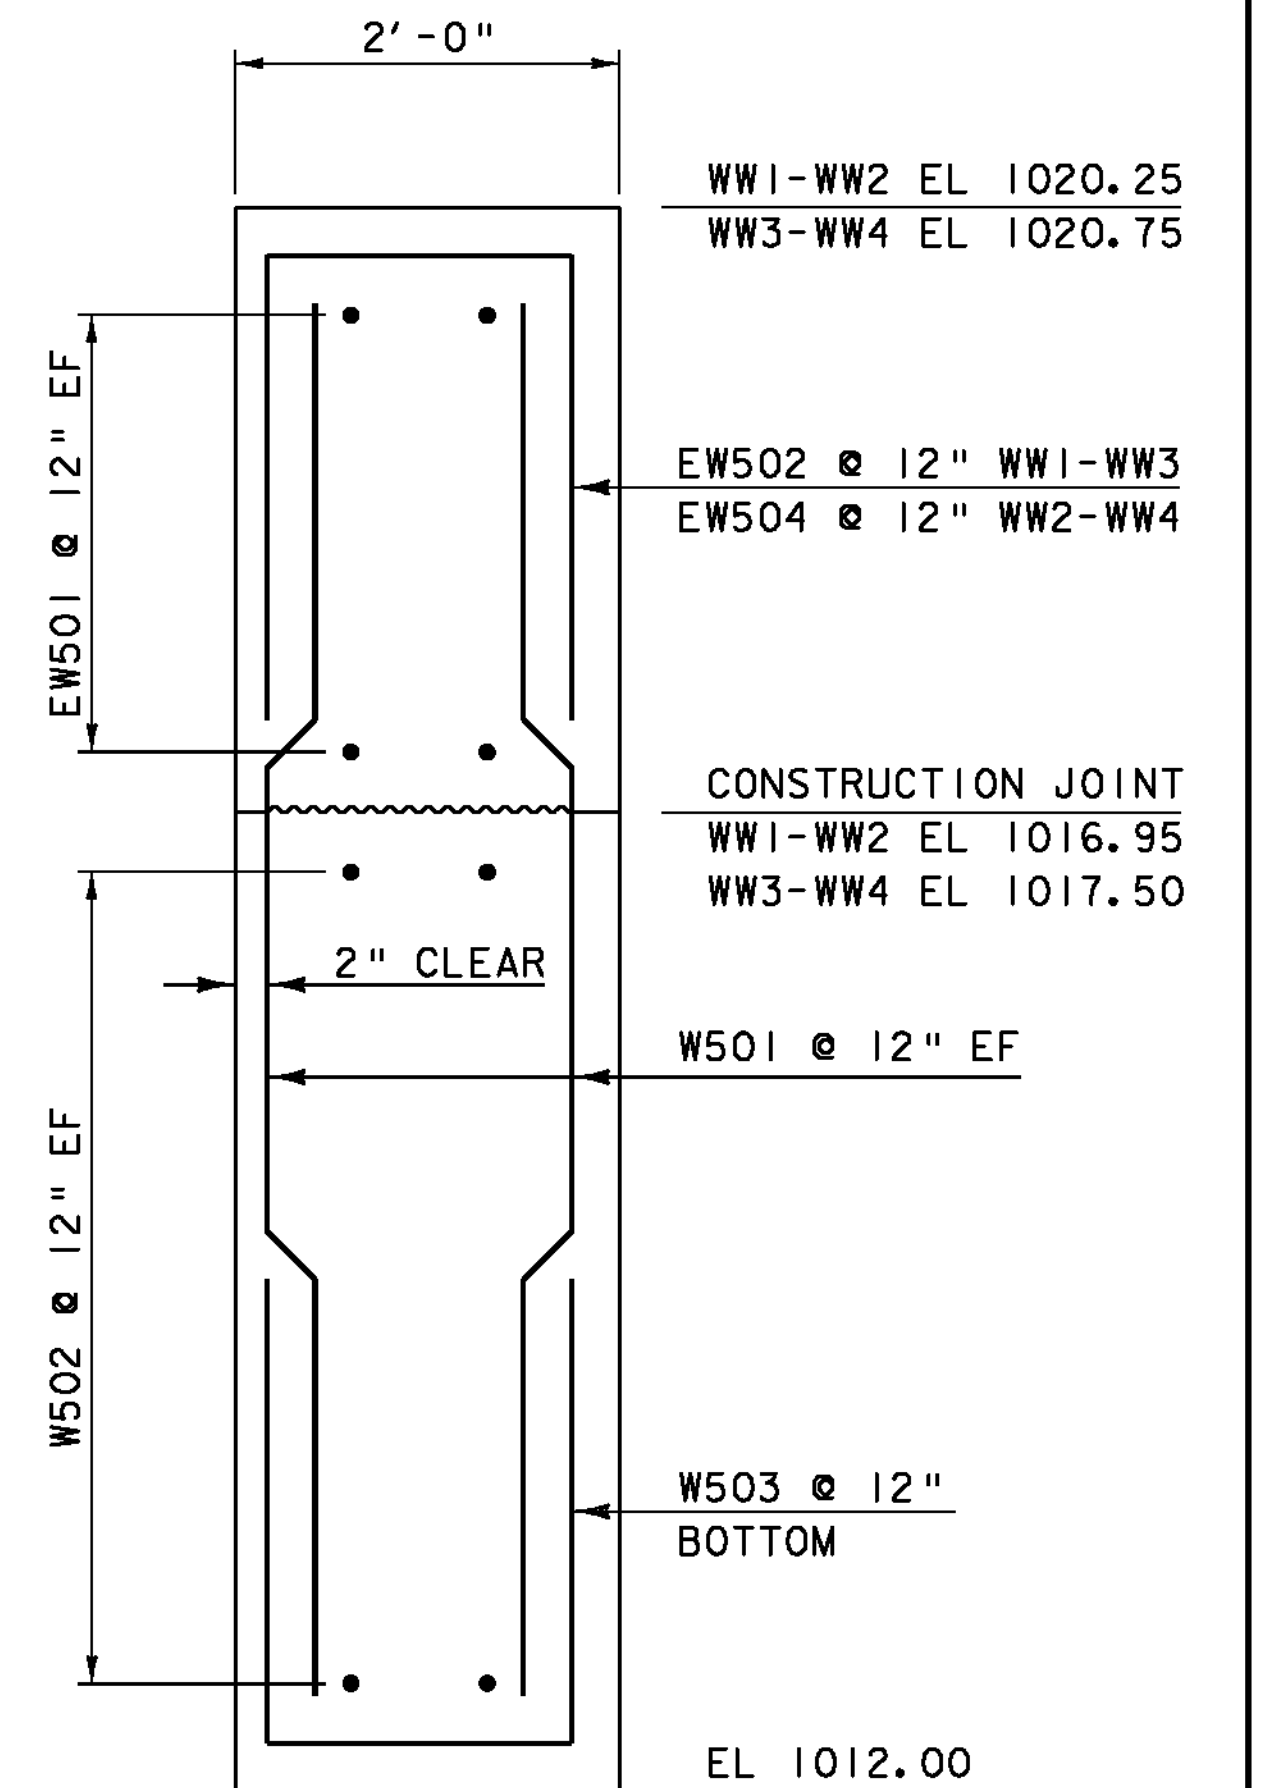

WINGWALL TYPICAL

SCALE 1" = 1'-0"




NOTE:

- NF = NEAR FACE
- FF = FAR FACE
- EF = EACH FACE
- ▲ = CUT TO FIT IN FIELD
- 3" CLEAR, UNLESS OTHERWISE SPECIFIED ON THE PLANS.
- 2'-2" BAR LAP UNLESS OTHERWISE SPECIFIED ON THE PLANS.


PROJECT NAME: EAST HAVEN
PROJECT NUMBER: BRF 0269(II)

FILE NAME: s00cl62sub.dgn
PROJECT LEADER: K. HIGGINS
DESIGNED BY: J. GRIFFIN
WINGWALL DETAILS


PLOT DATE: 08-AUG-2011
DRAWN BY: J. SALVATORI
CHECKED BY: J. LACROIX
SHEET 26 OF 40

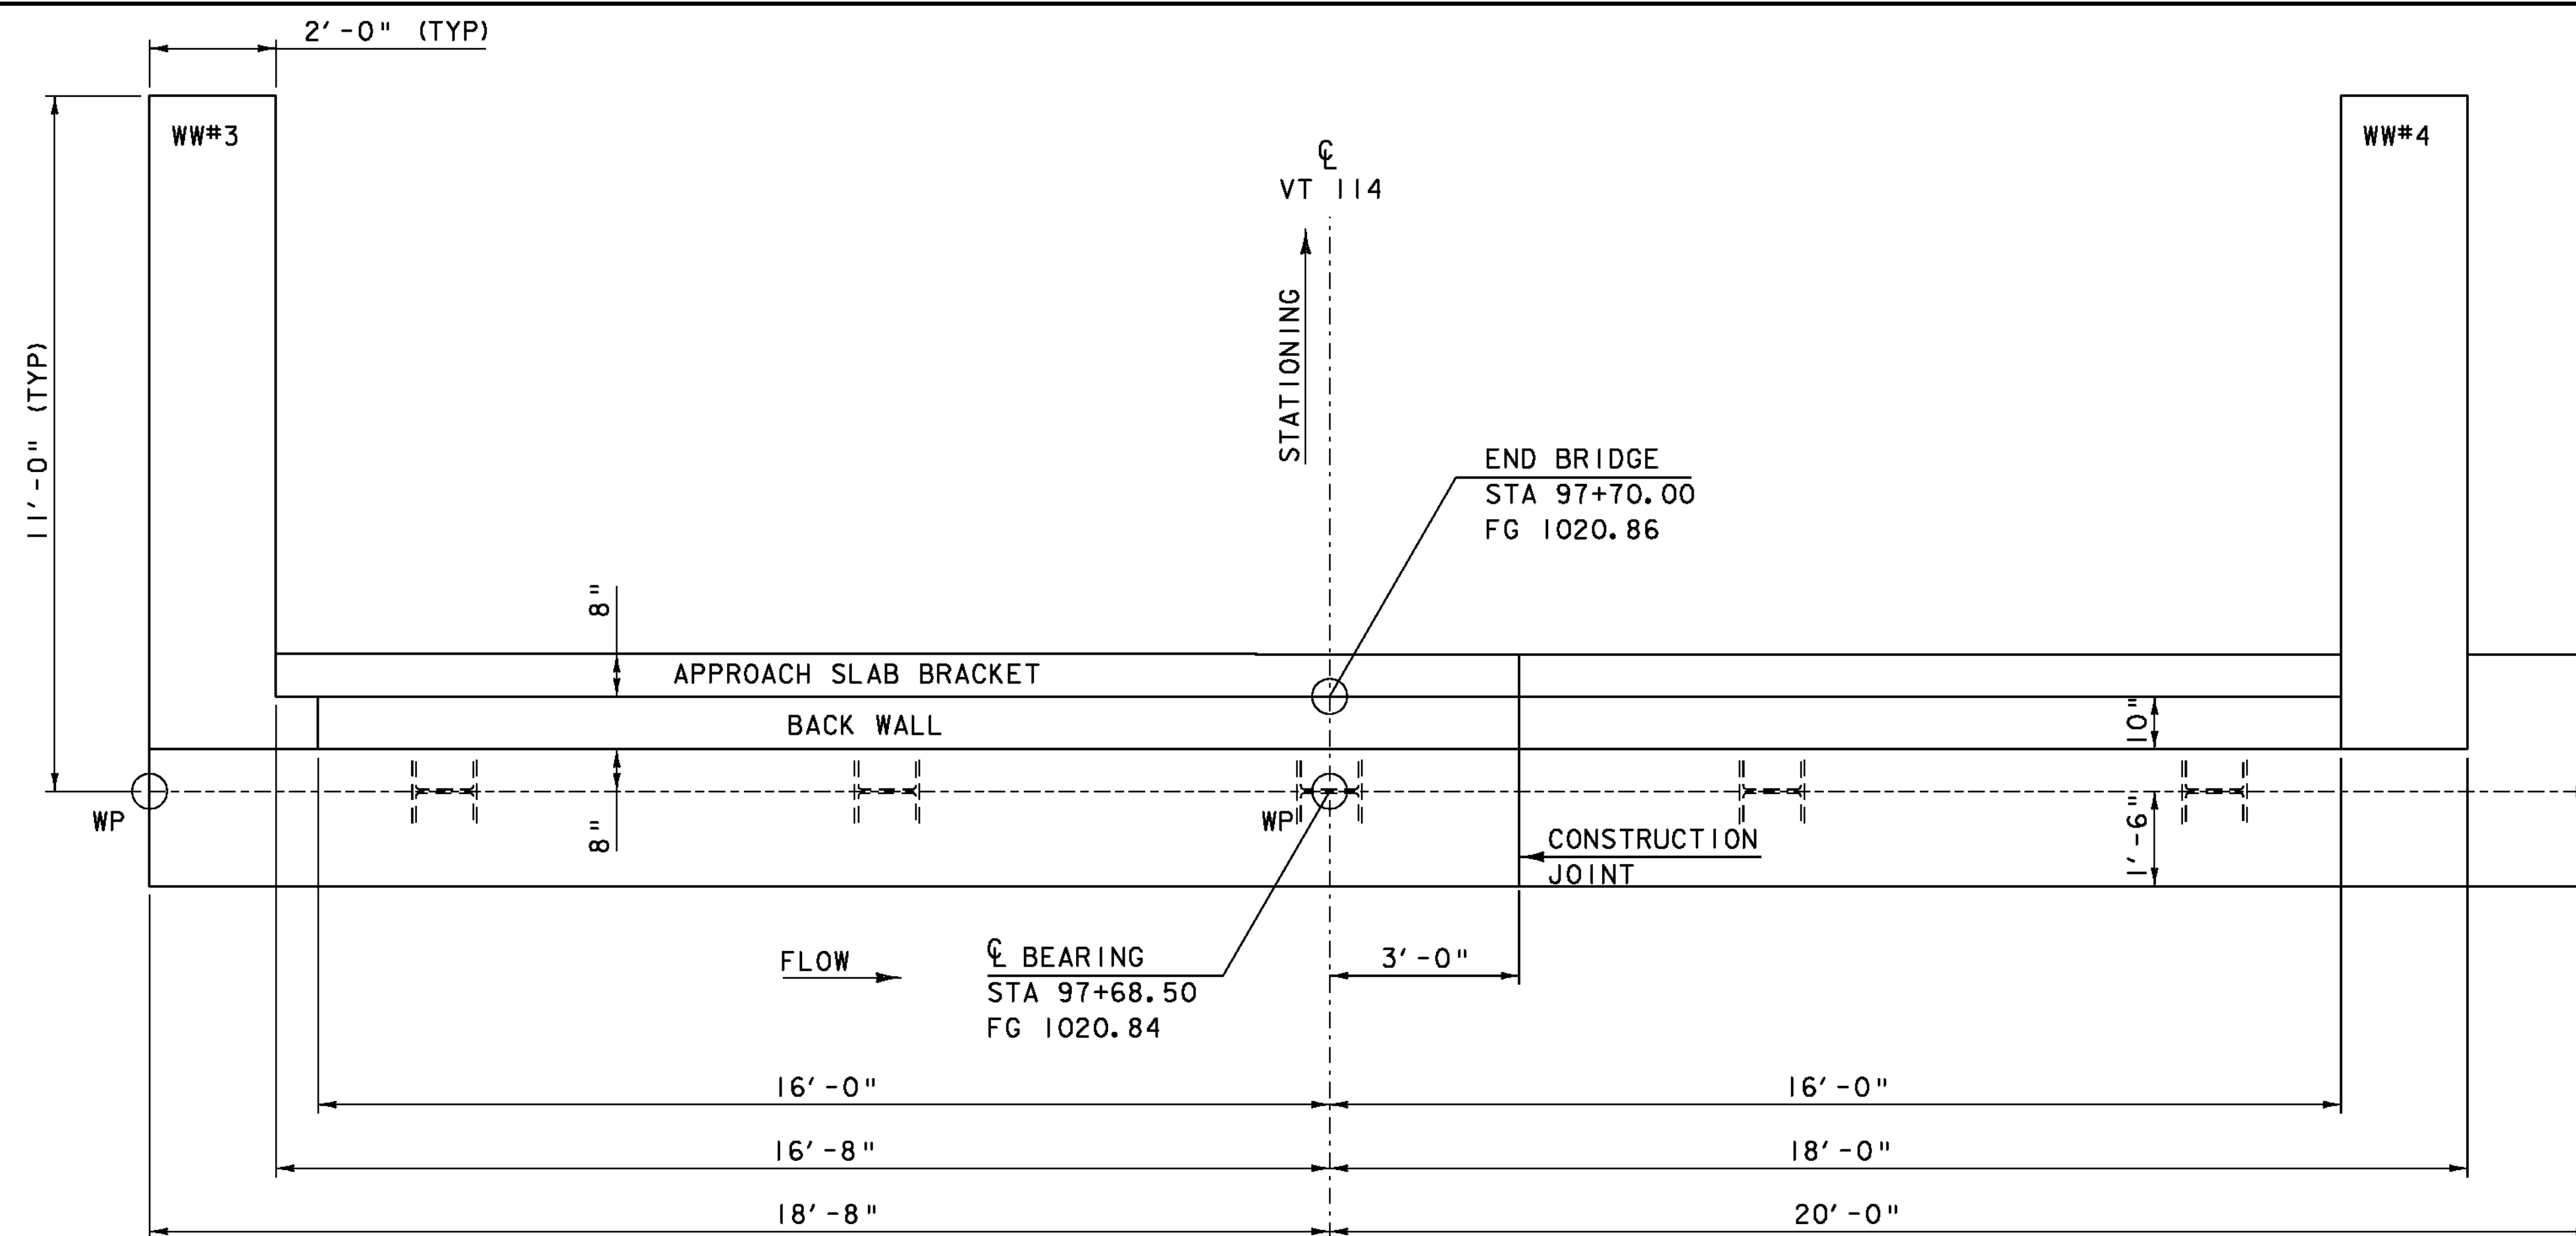


ABUTMENT #2 PLAN VIEW

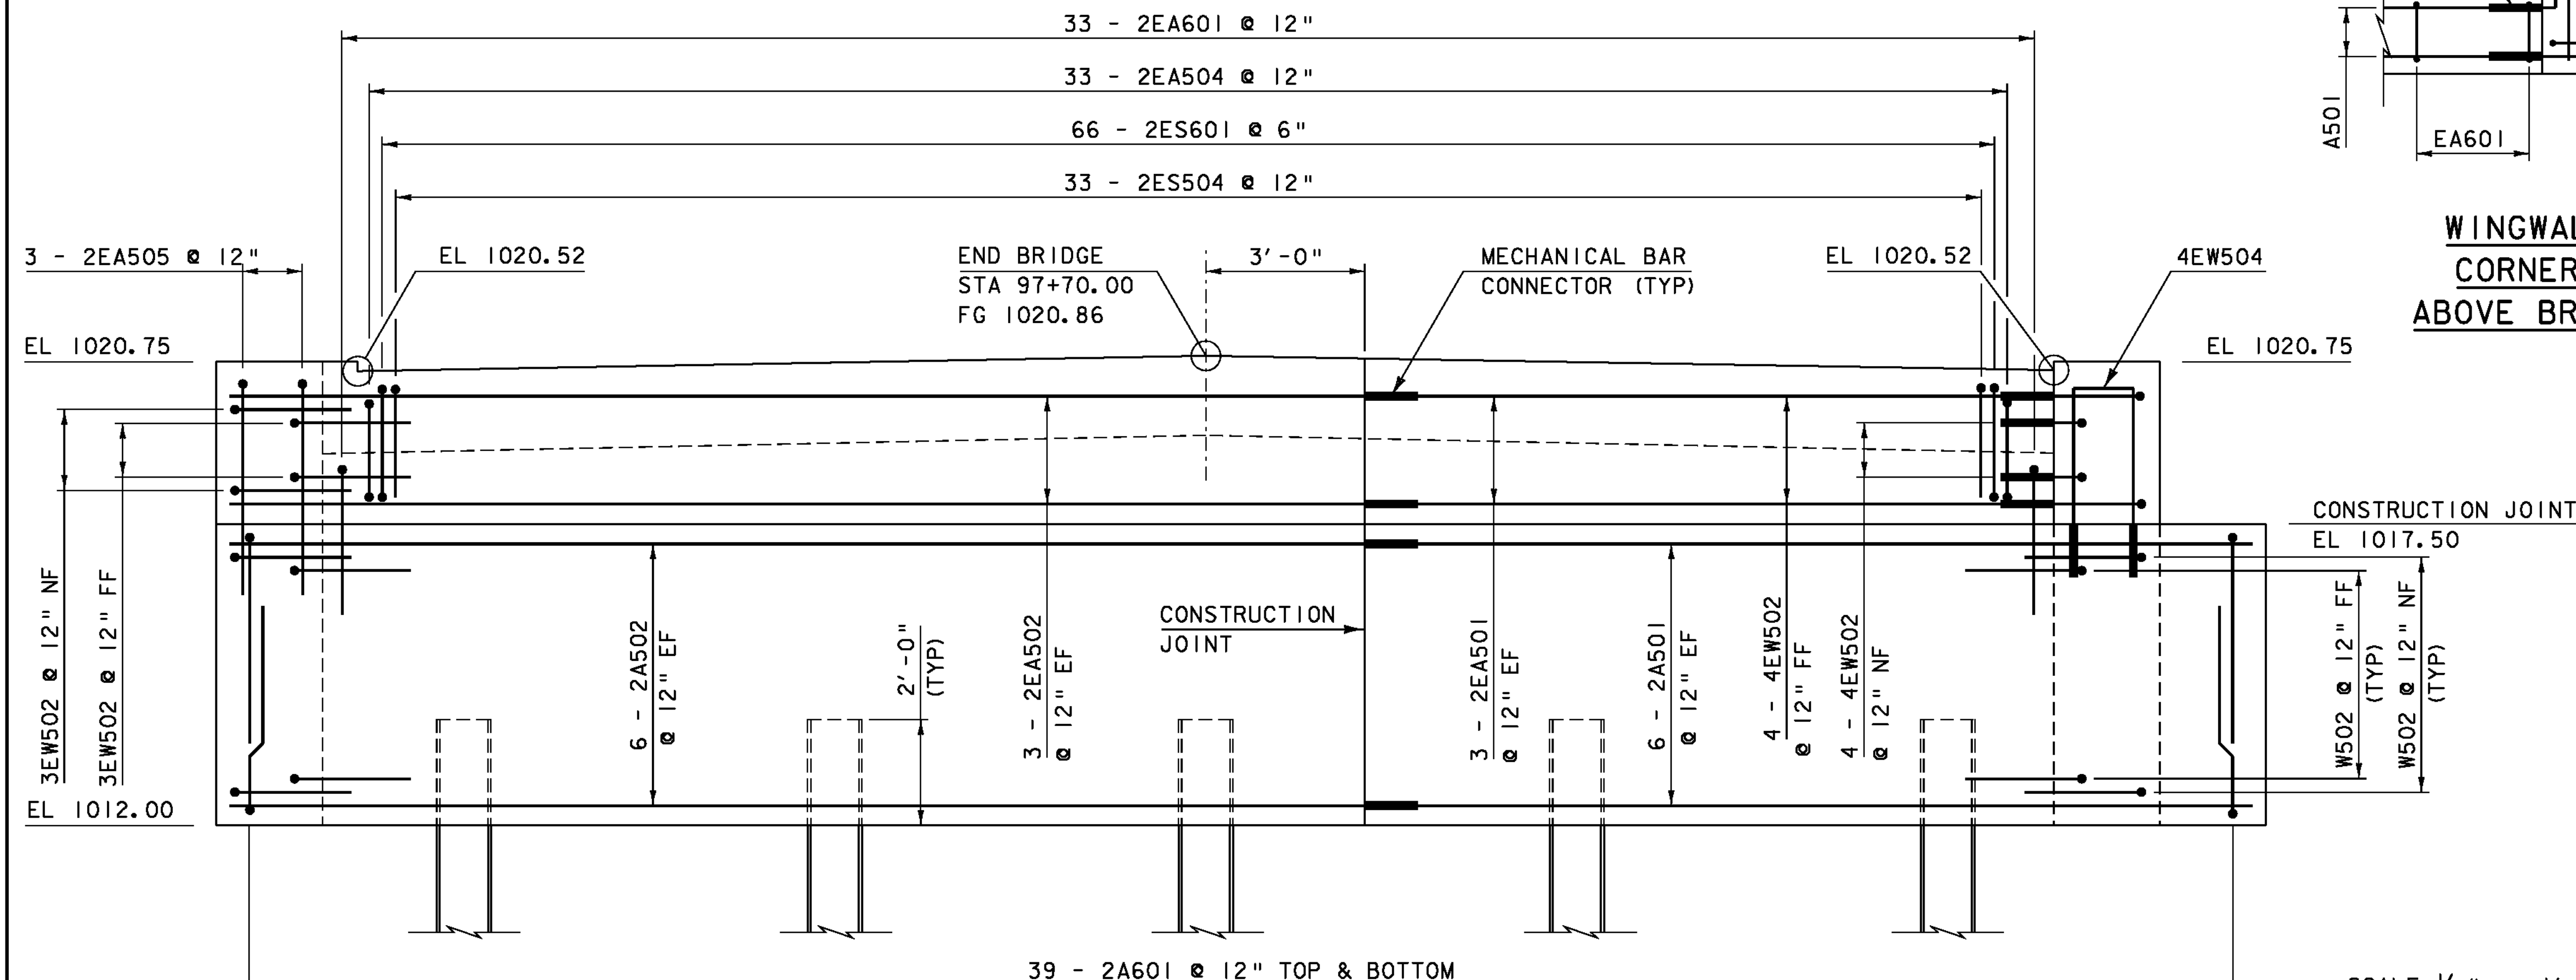


ABUTMENT #2 ELEVATION VIEW

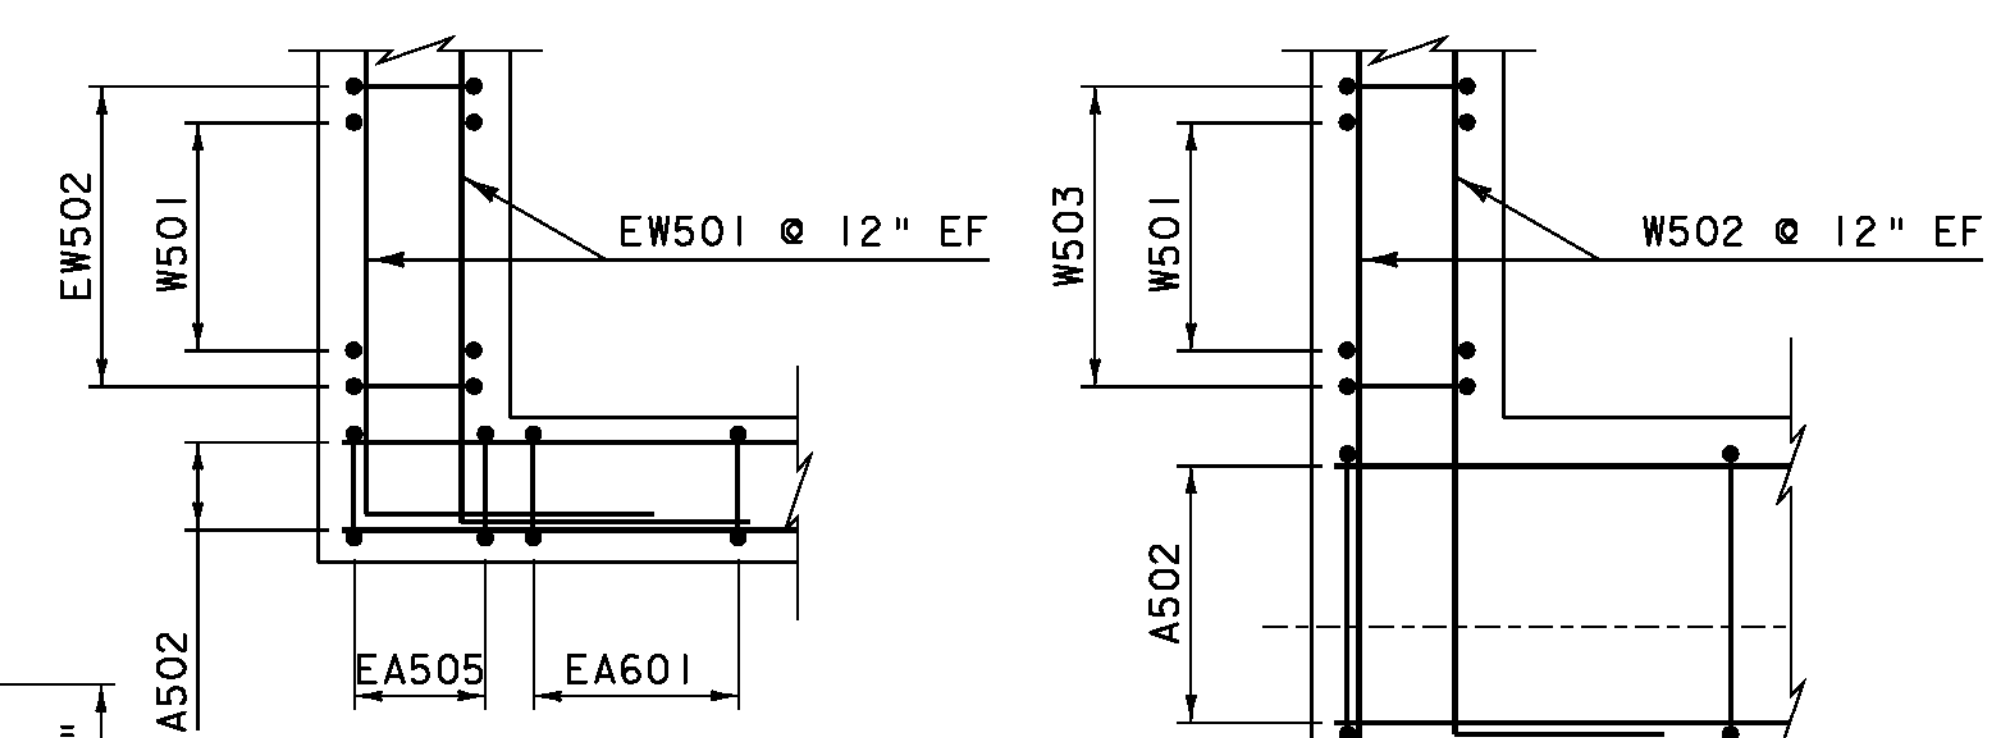


WINGWALL 1 & 3 CORNER DETAIL ABOVE BRIDGE SEAT

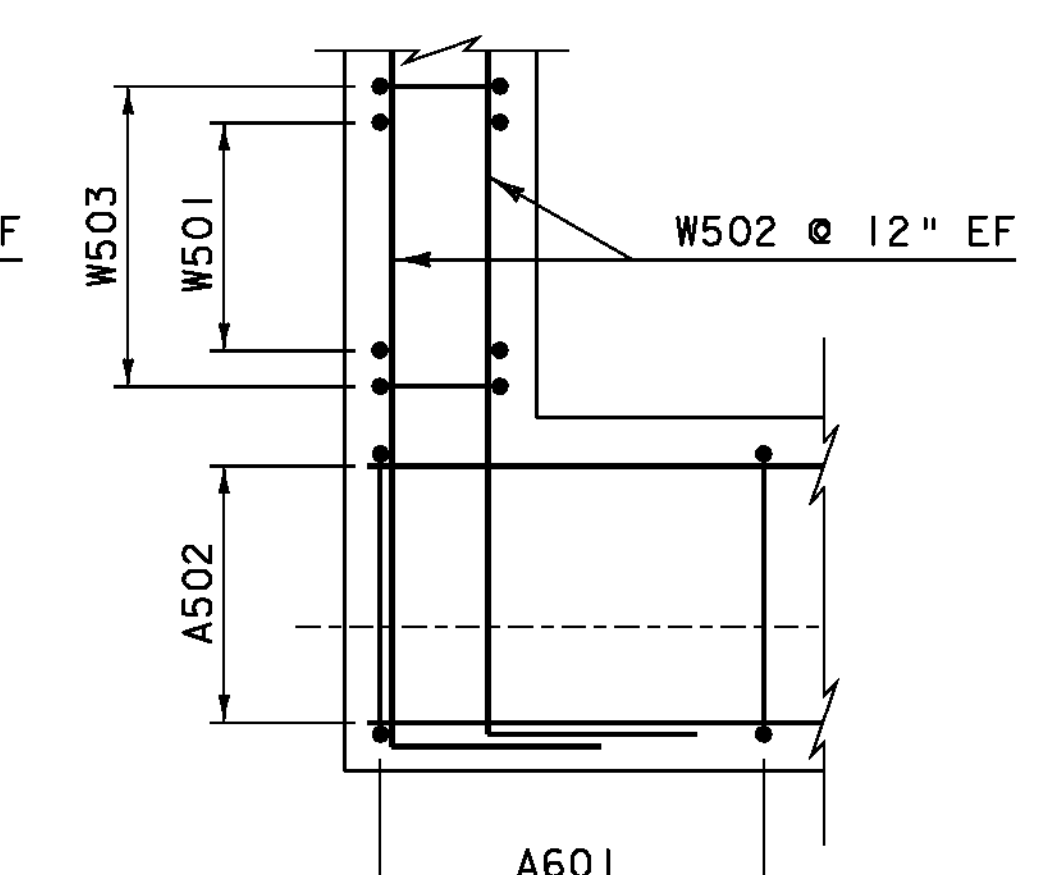

WINGWALL 1 & 3 CORNER DETAIL BELOW BRIDGE SEAT

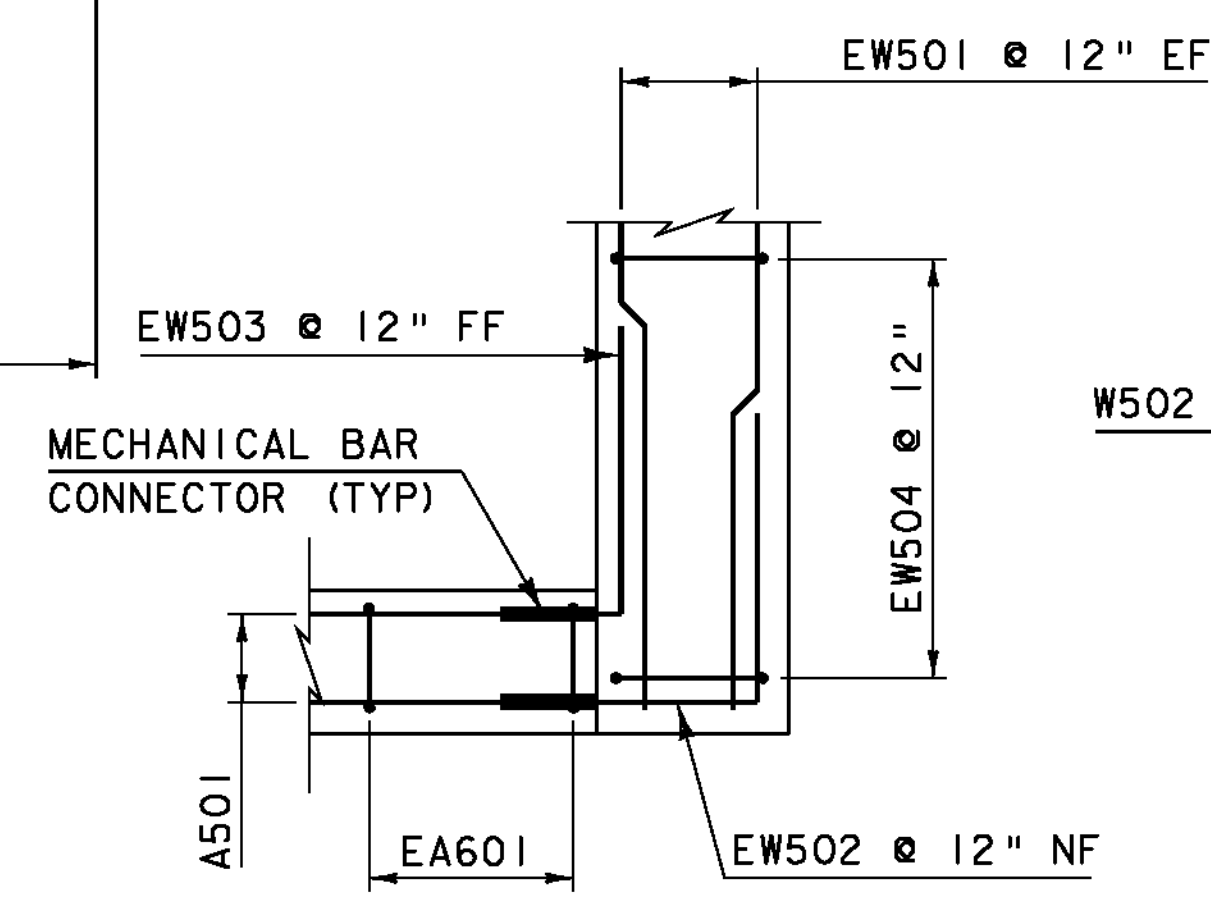


WINGWALL 2 & 4 CORNER DETAIL ABOVE BRIDGE SEAT

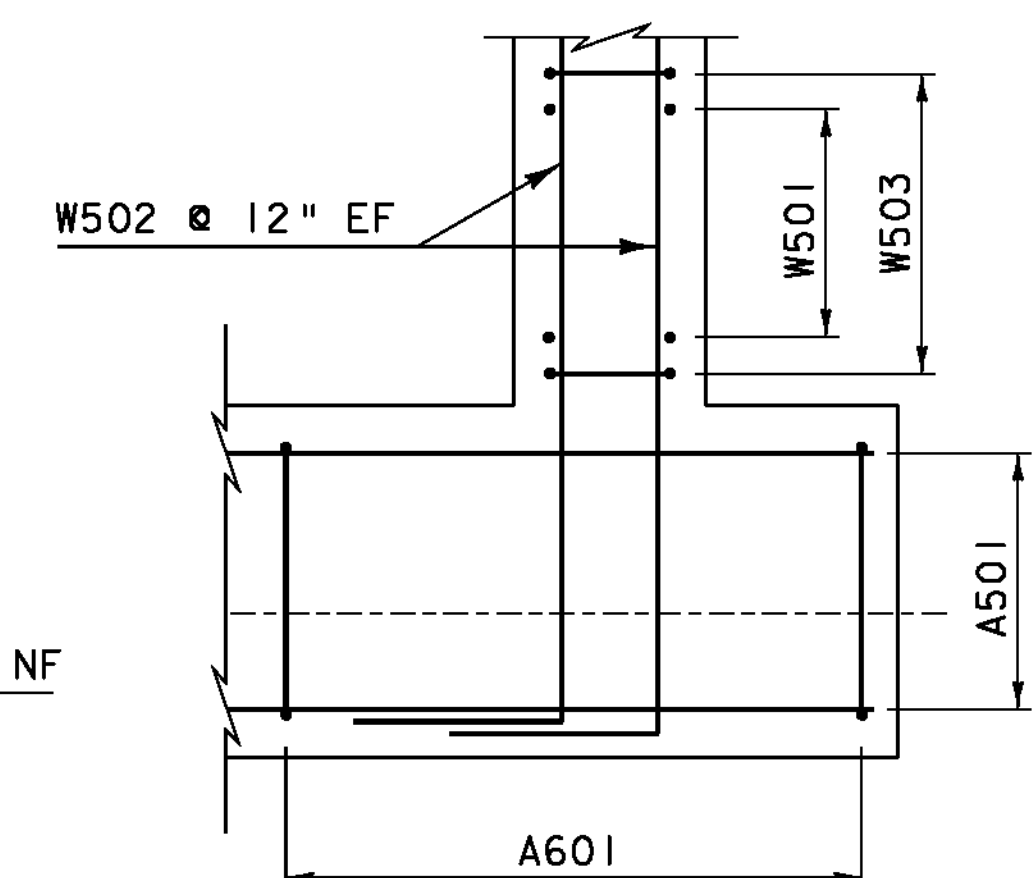


WINGWALL 2 & 4 CORNER DETAIL BELOW BRIDGE SEAT

NOTE:
 NF = NEAR FACE
 FF = FAR FACE
 EF = EACH FACE
 ▲ = CUT TO FIT IN FIELD
 3" CLEAR, UNLESS OTHERWISE SPECIFIED ON THE PLANS.
 2'-2" BAR LAP UNLESS OTHERWISE SPECIFIED ON THE PLANS.


PROJECT NAME:	EAST HAVEN	FILE NAME:	s00cl62sub.dgn	PLOT DATE:	08-AUG-2011
PROJECT NUMBER:	BRF 0269(II)	PROJECT LEADER:	K. HIGGINS	DRAWN BY:	J. SALVATORI
		DESIGNED BY:	J. GRIFFIN	CHECKED BY:	J. LACROIX
		ABUTMENT #2 DETAILS		SHEET	25 OF 40

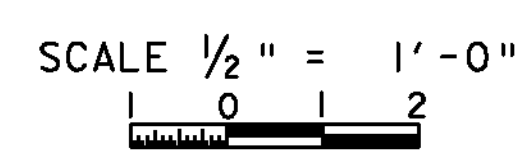

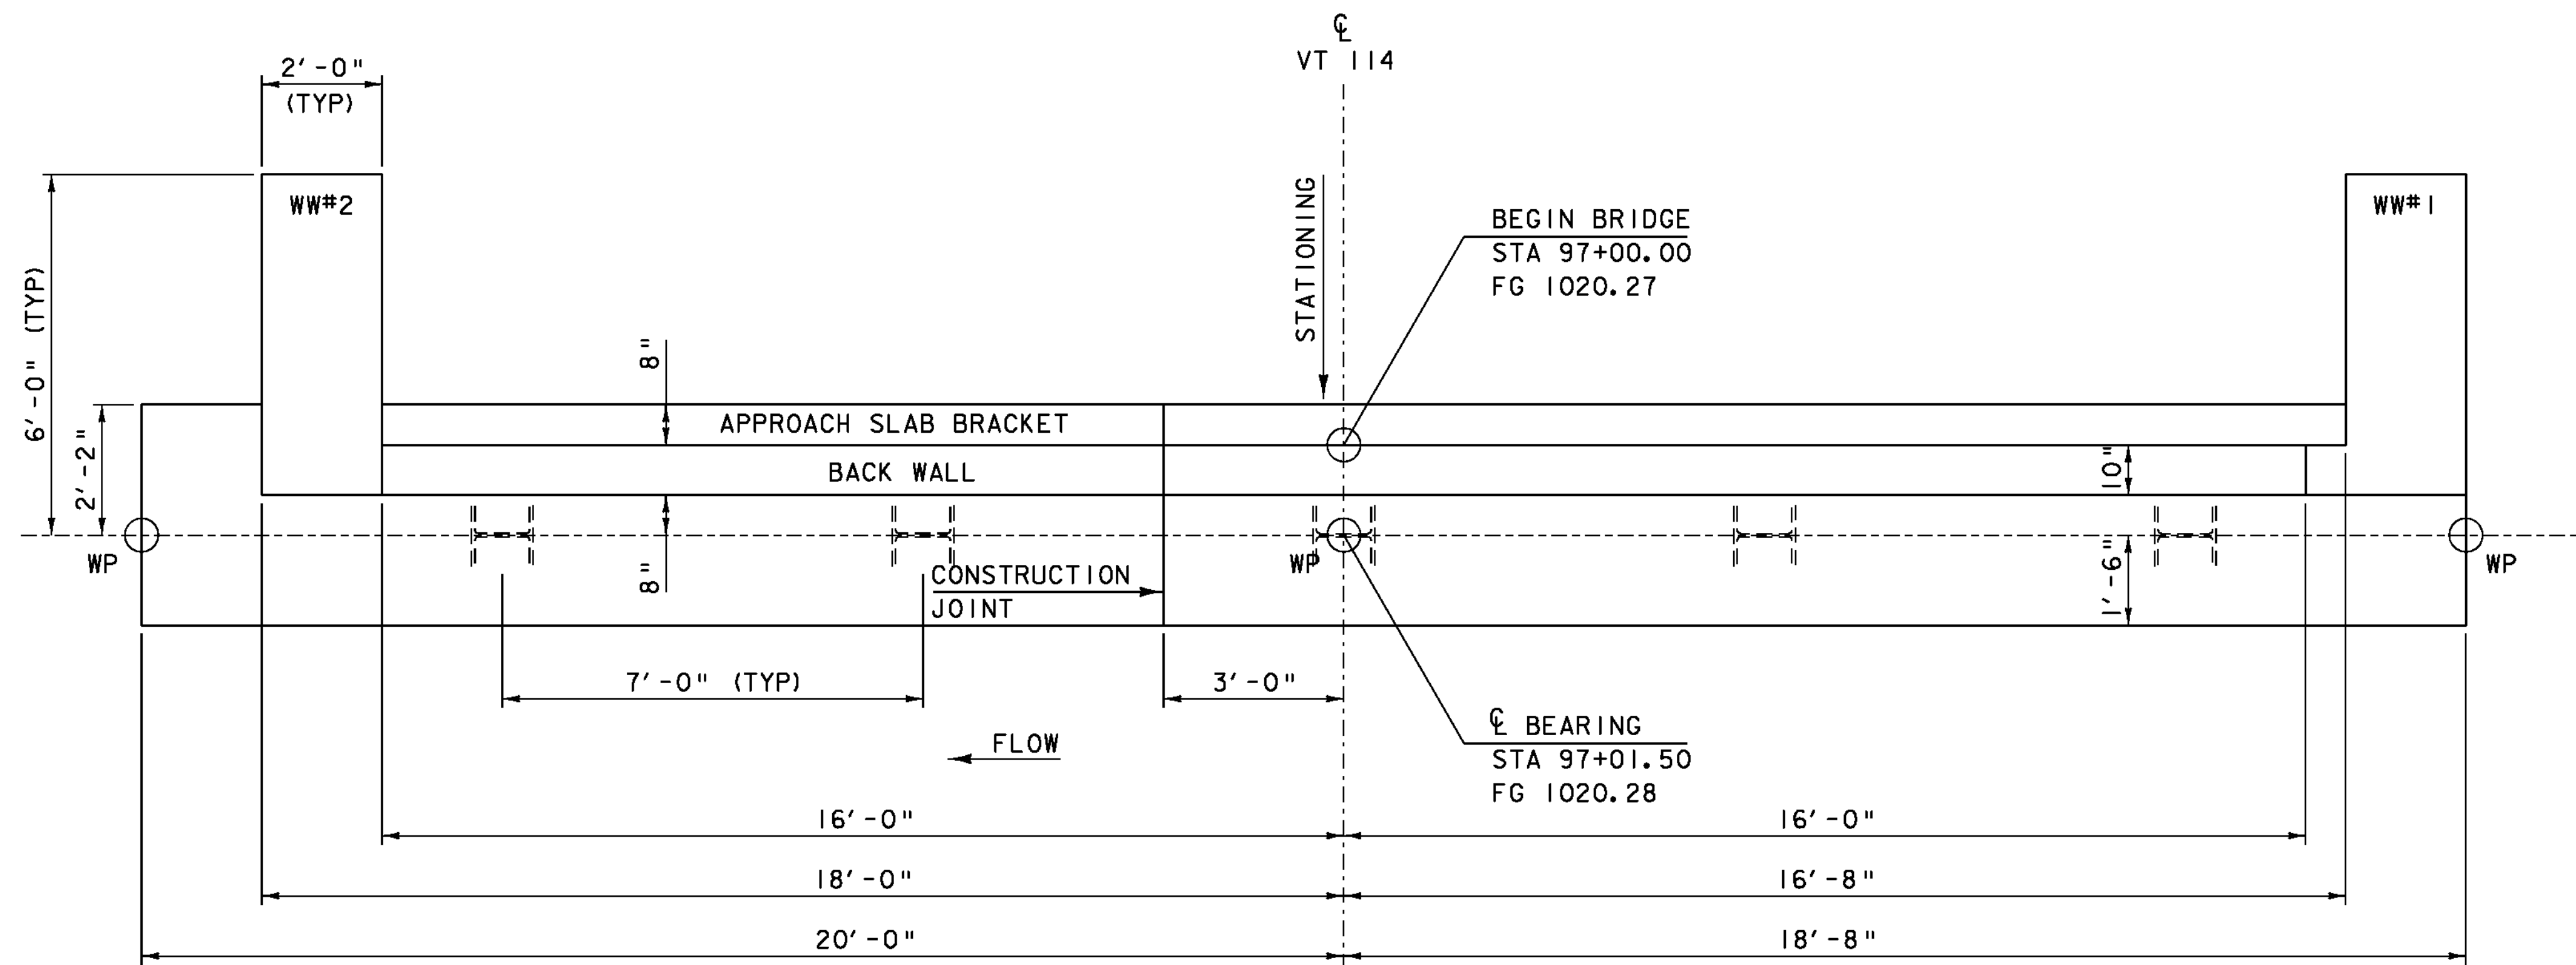


ABUTMENT #1 PLAN VIEW

SCALE 1/2" = 1'-0"

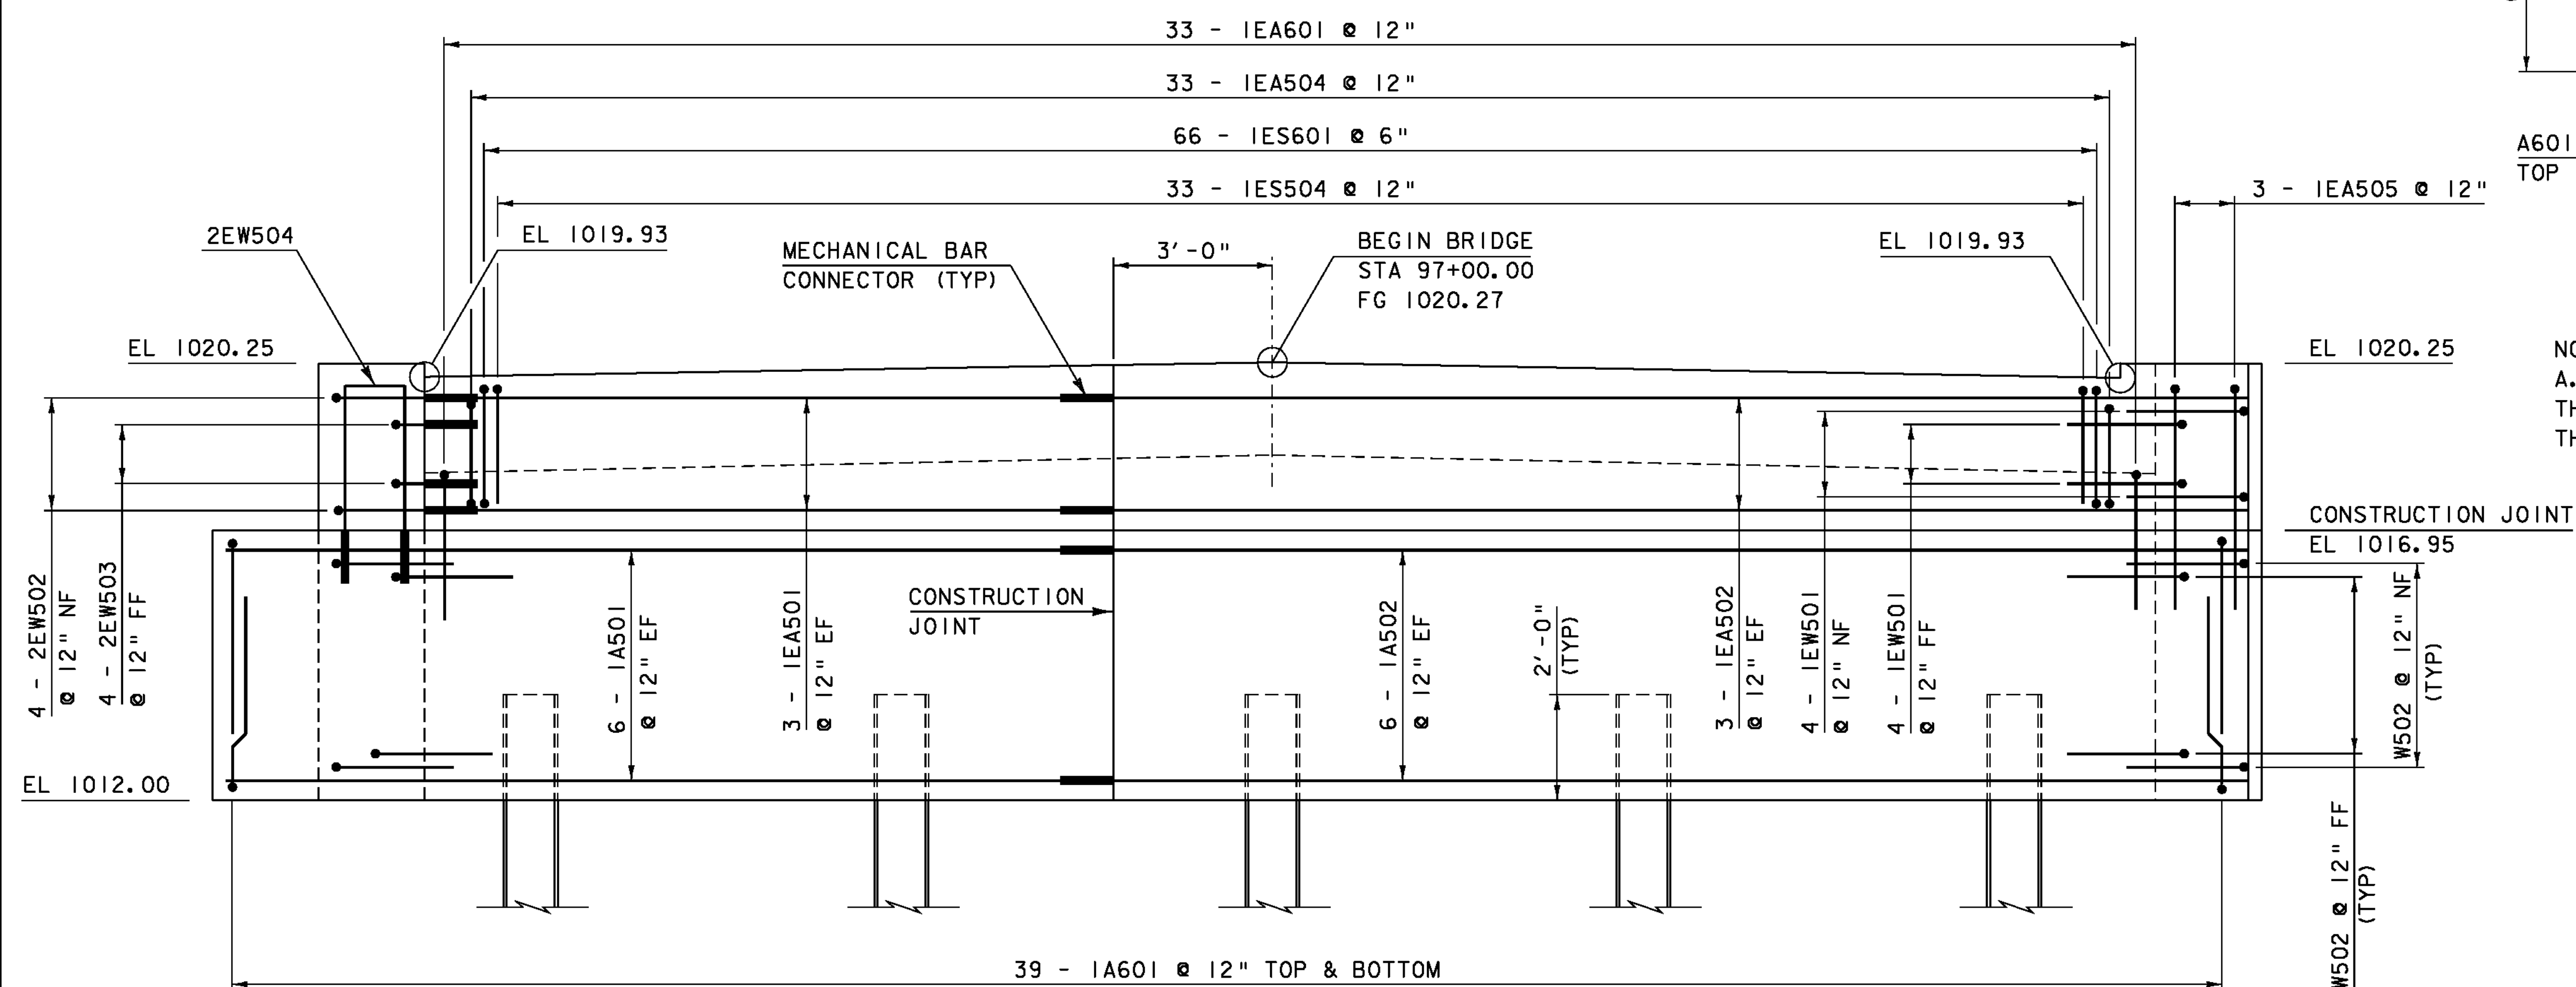

ABUTMENT #1 ELEVATION VIEW

SCALE 1/2" = 1'-0"

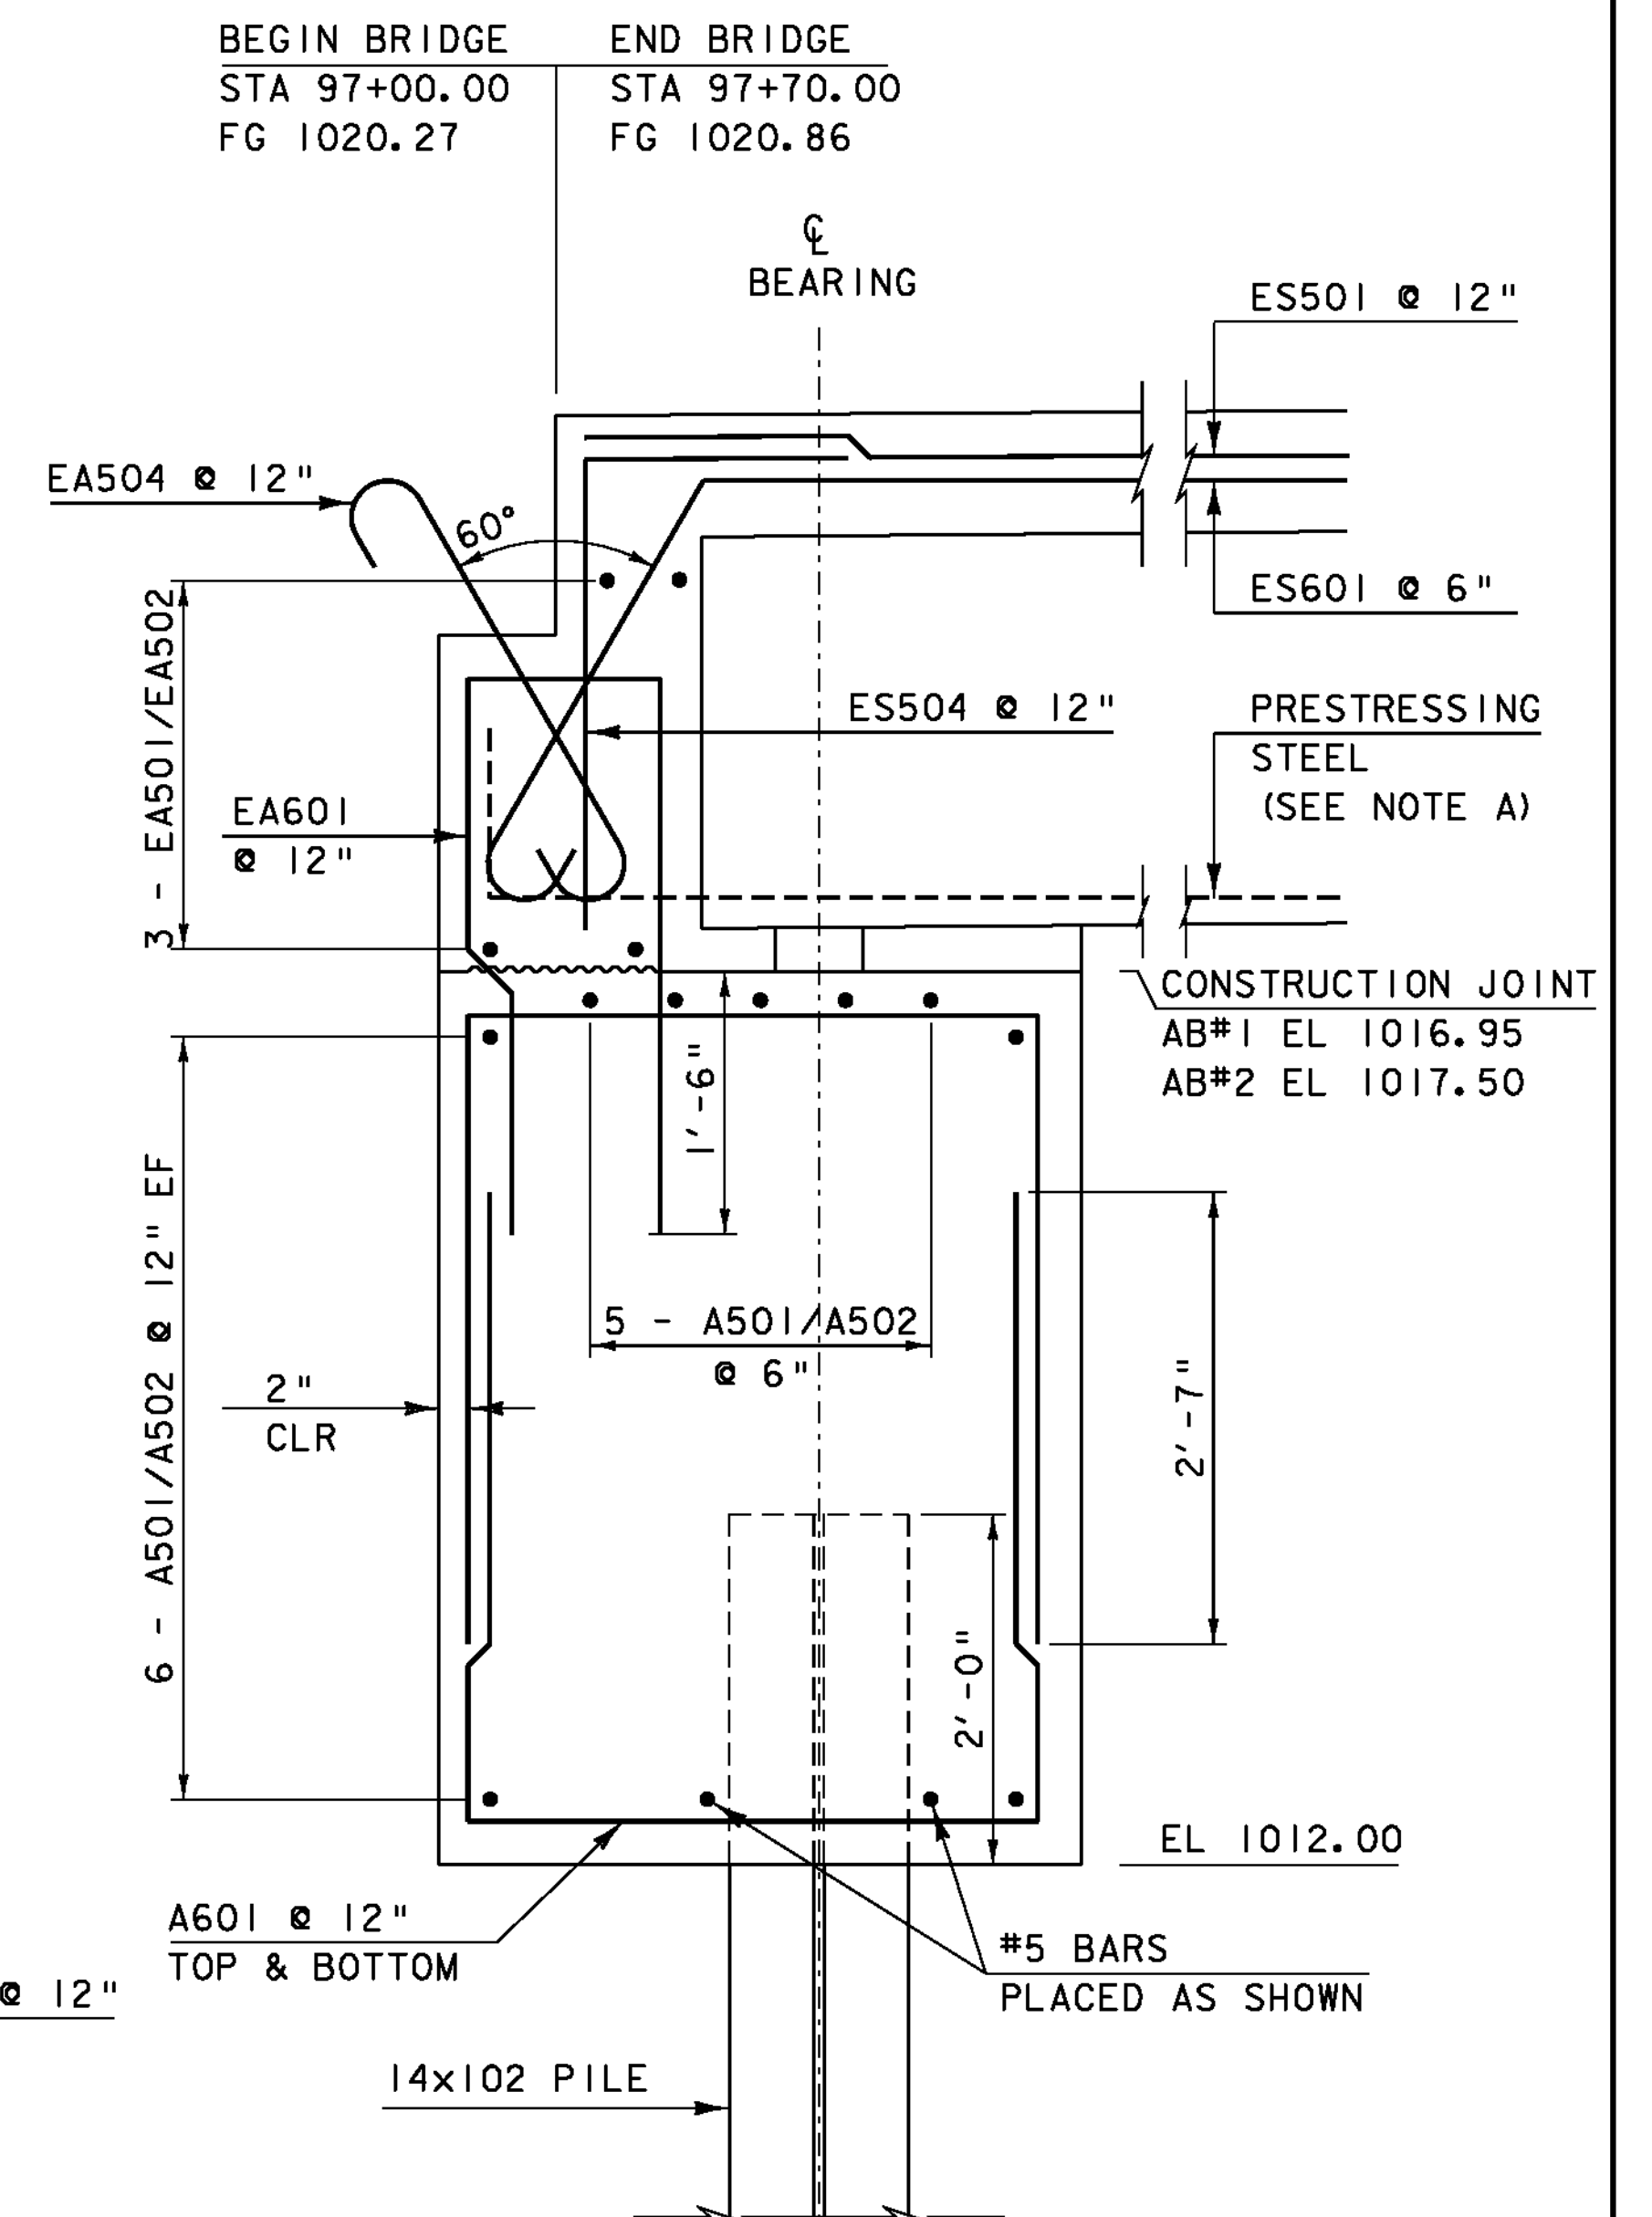

NOTE:
 A. EXTEND EVERY OTHER BONDED PRESTRESSED STRANDS ON THE BOTTOM ROW 2'-8". IN LIEU OF EXTENDING THE STRANDS, THE CONTRACTOR MAY PROPOSE AN ALTERNATE DETAIL.

ABUTMENT TYPICAL

SCALE 1" = 1'-0"



NOTE:

- NF = NEAR FACE
- FF = FAR FACE
- EF = EACH FACE
- ▲ = CUT TO FIT IN FIELD
- 3" CLEAR, UNLESS OTHERWISE SPECIFIED ON THE PLANS.
- 2'-2" BAR LAP UNLESS OTHERWISE SPECIFIED ON THE PLANS.

PROJECT NAME: EAST HAVEN

PROJECT NUMBER: BRF 0269(II)

FILE NAME: s00cl62sub.dgn

PROJECT LEADER: K. HIGGINS

DESIGNED BY: J. GRIFFIN


ABUTMENT #1 DETAILS

PLOT DATE: 08-AUG-2011


DRAWN BY: J. SALVATORI

CHECKED BY: J. LACROIX


SHEET 24 OF 40

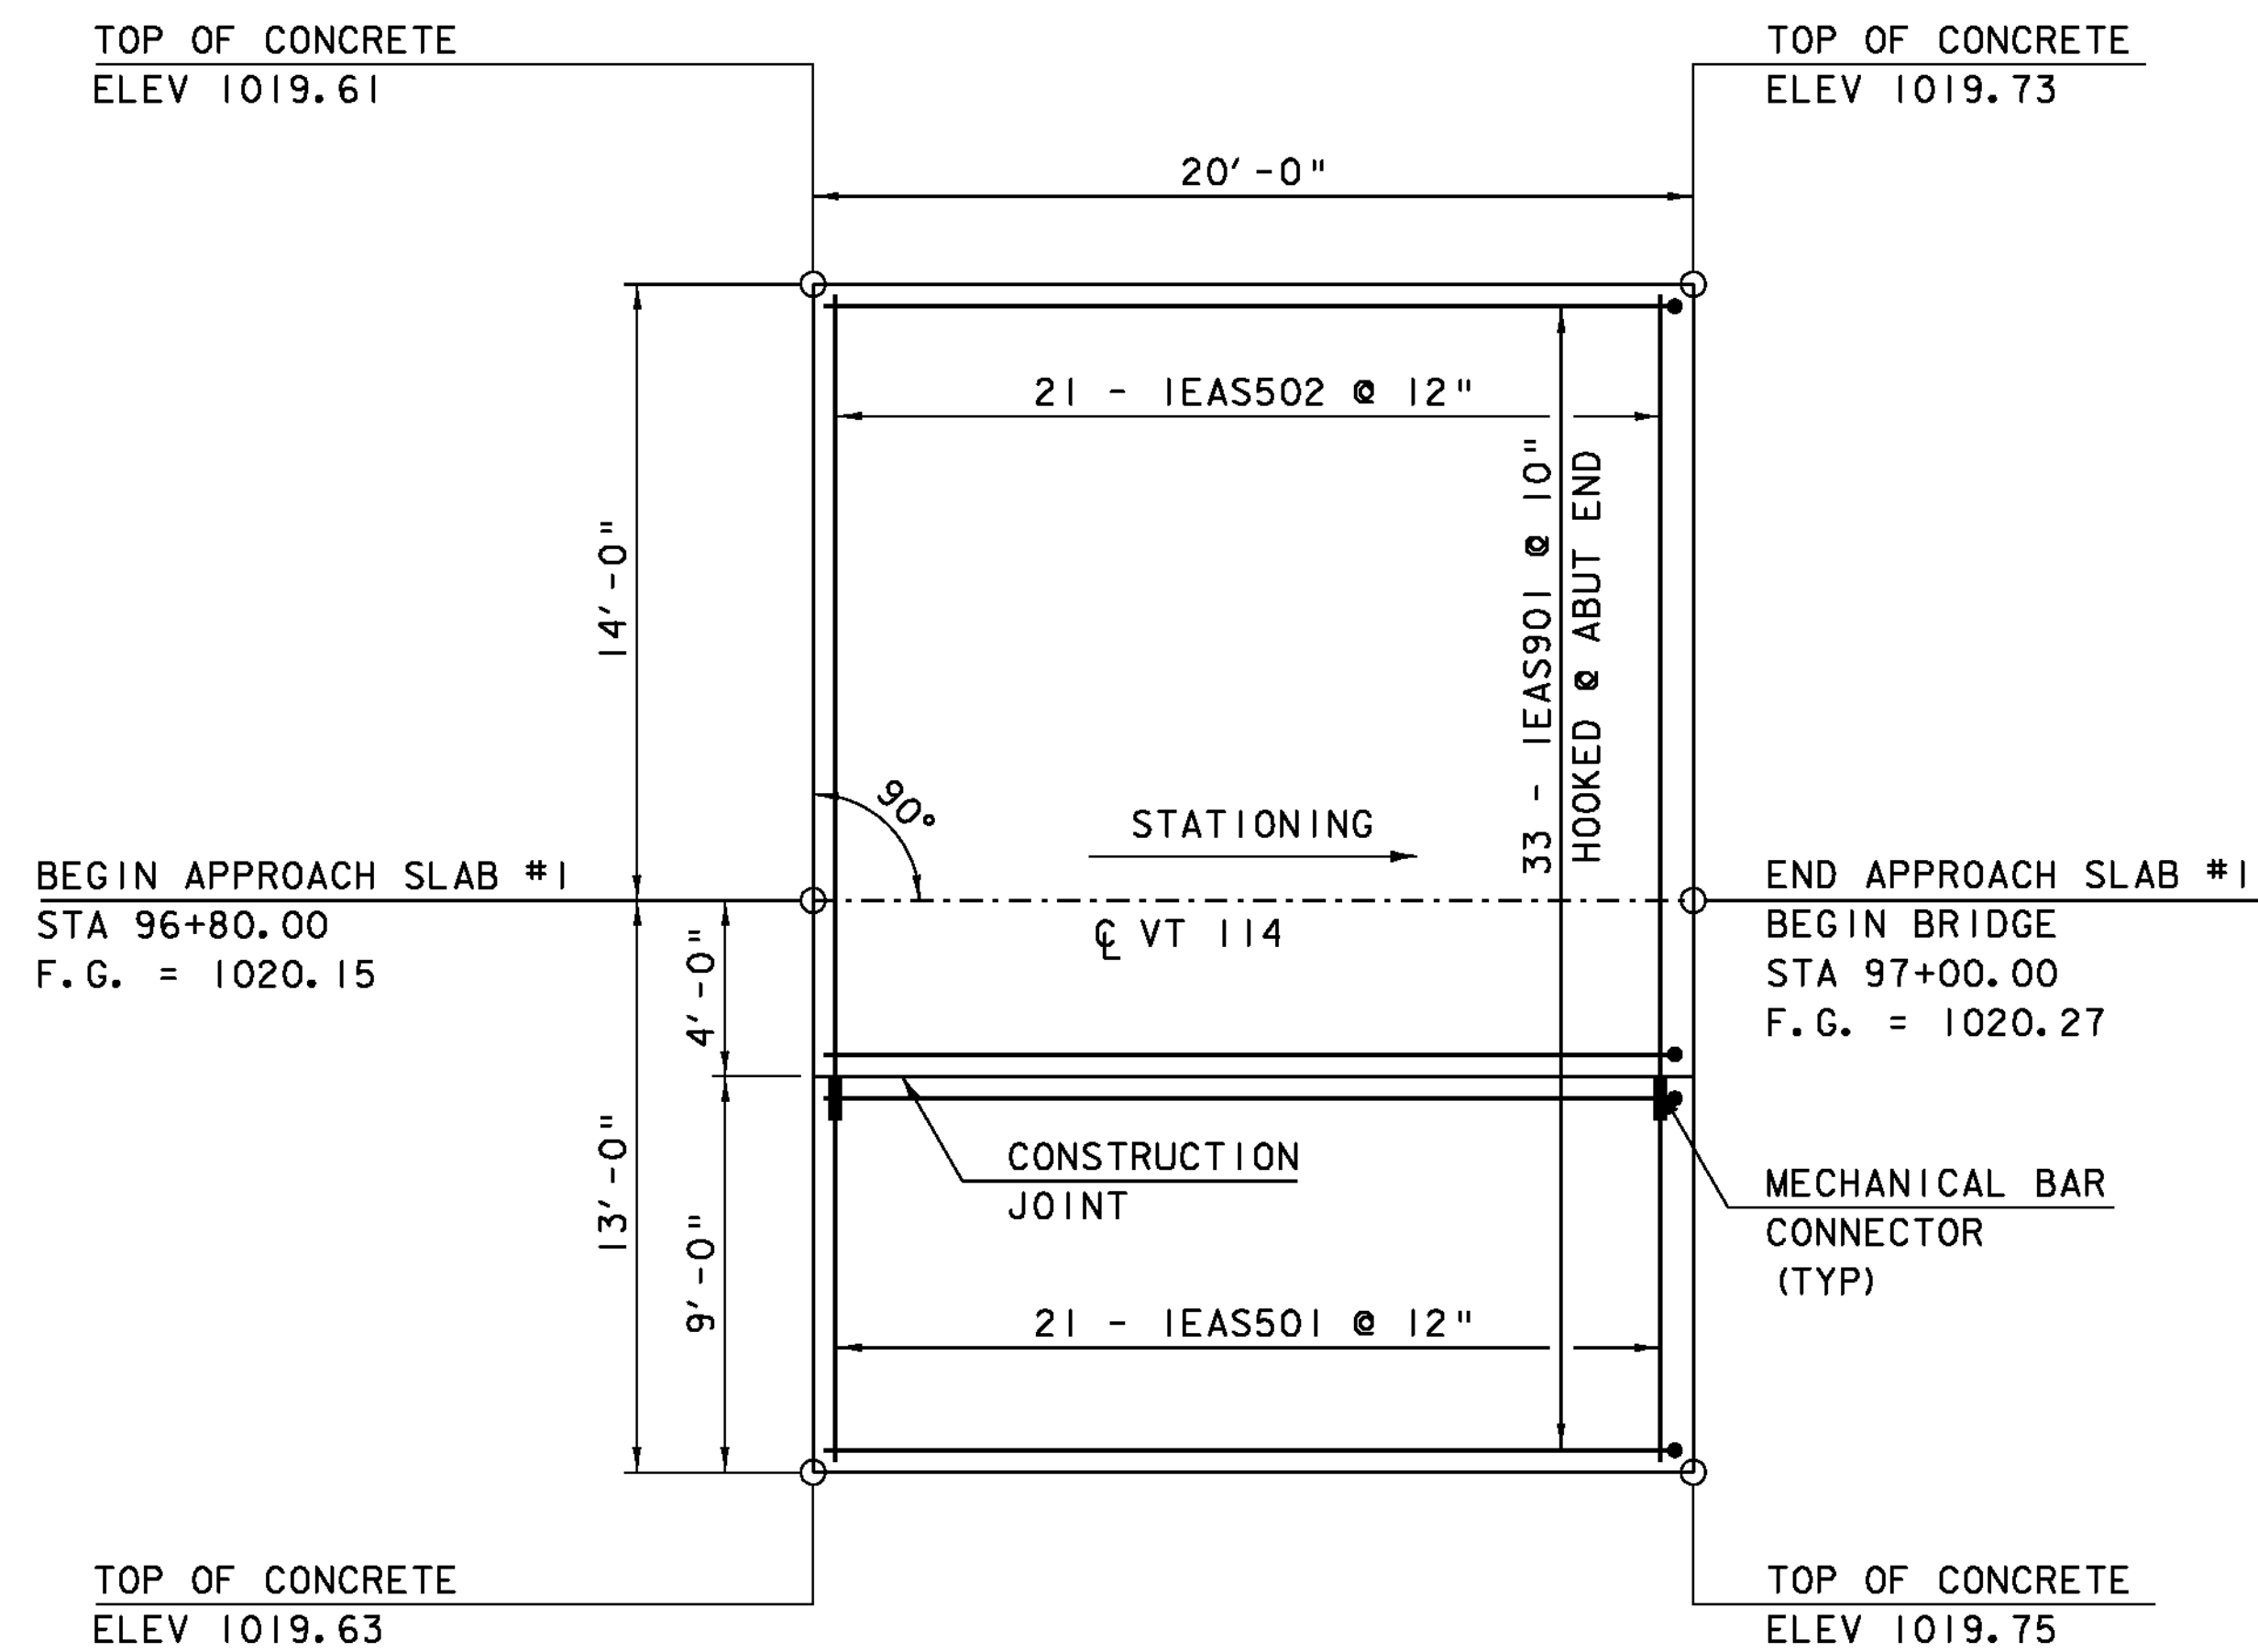

APPROACH SLAB #1 PLAN
 SCALE 1/4" = 1'-0"

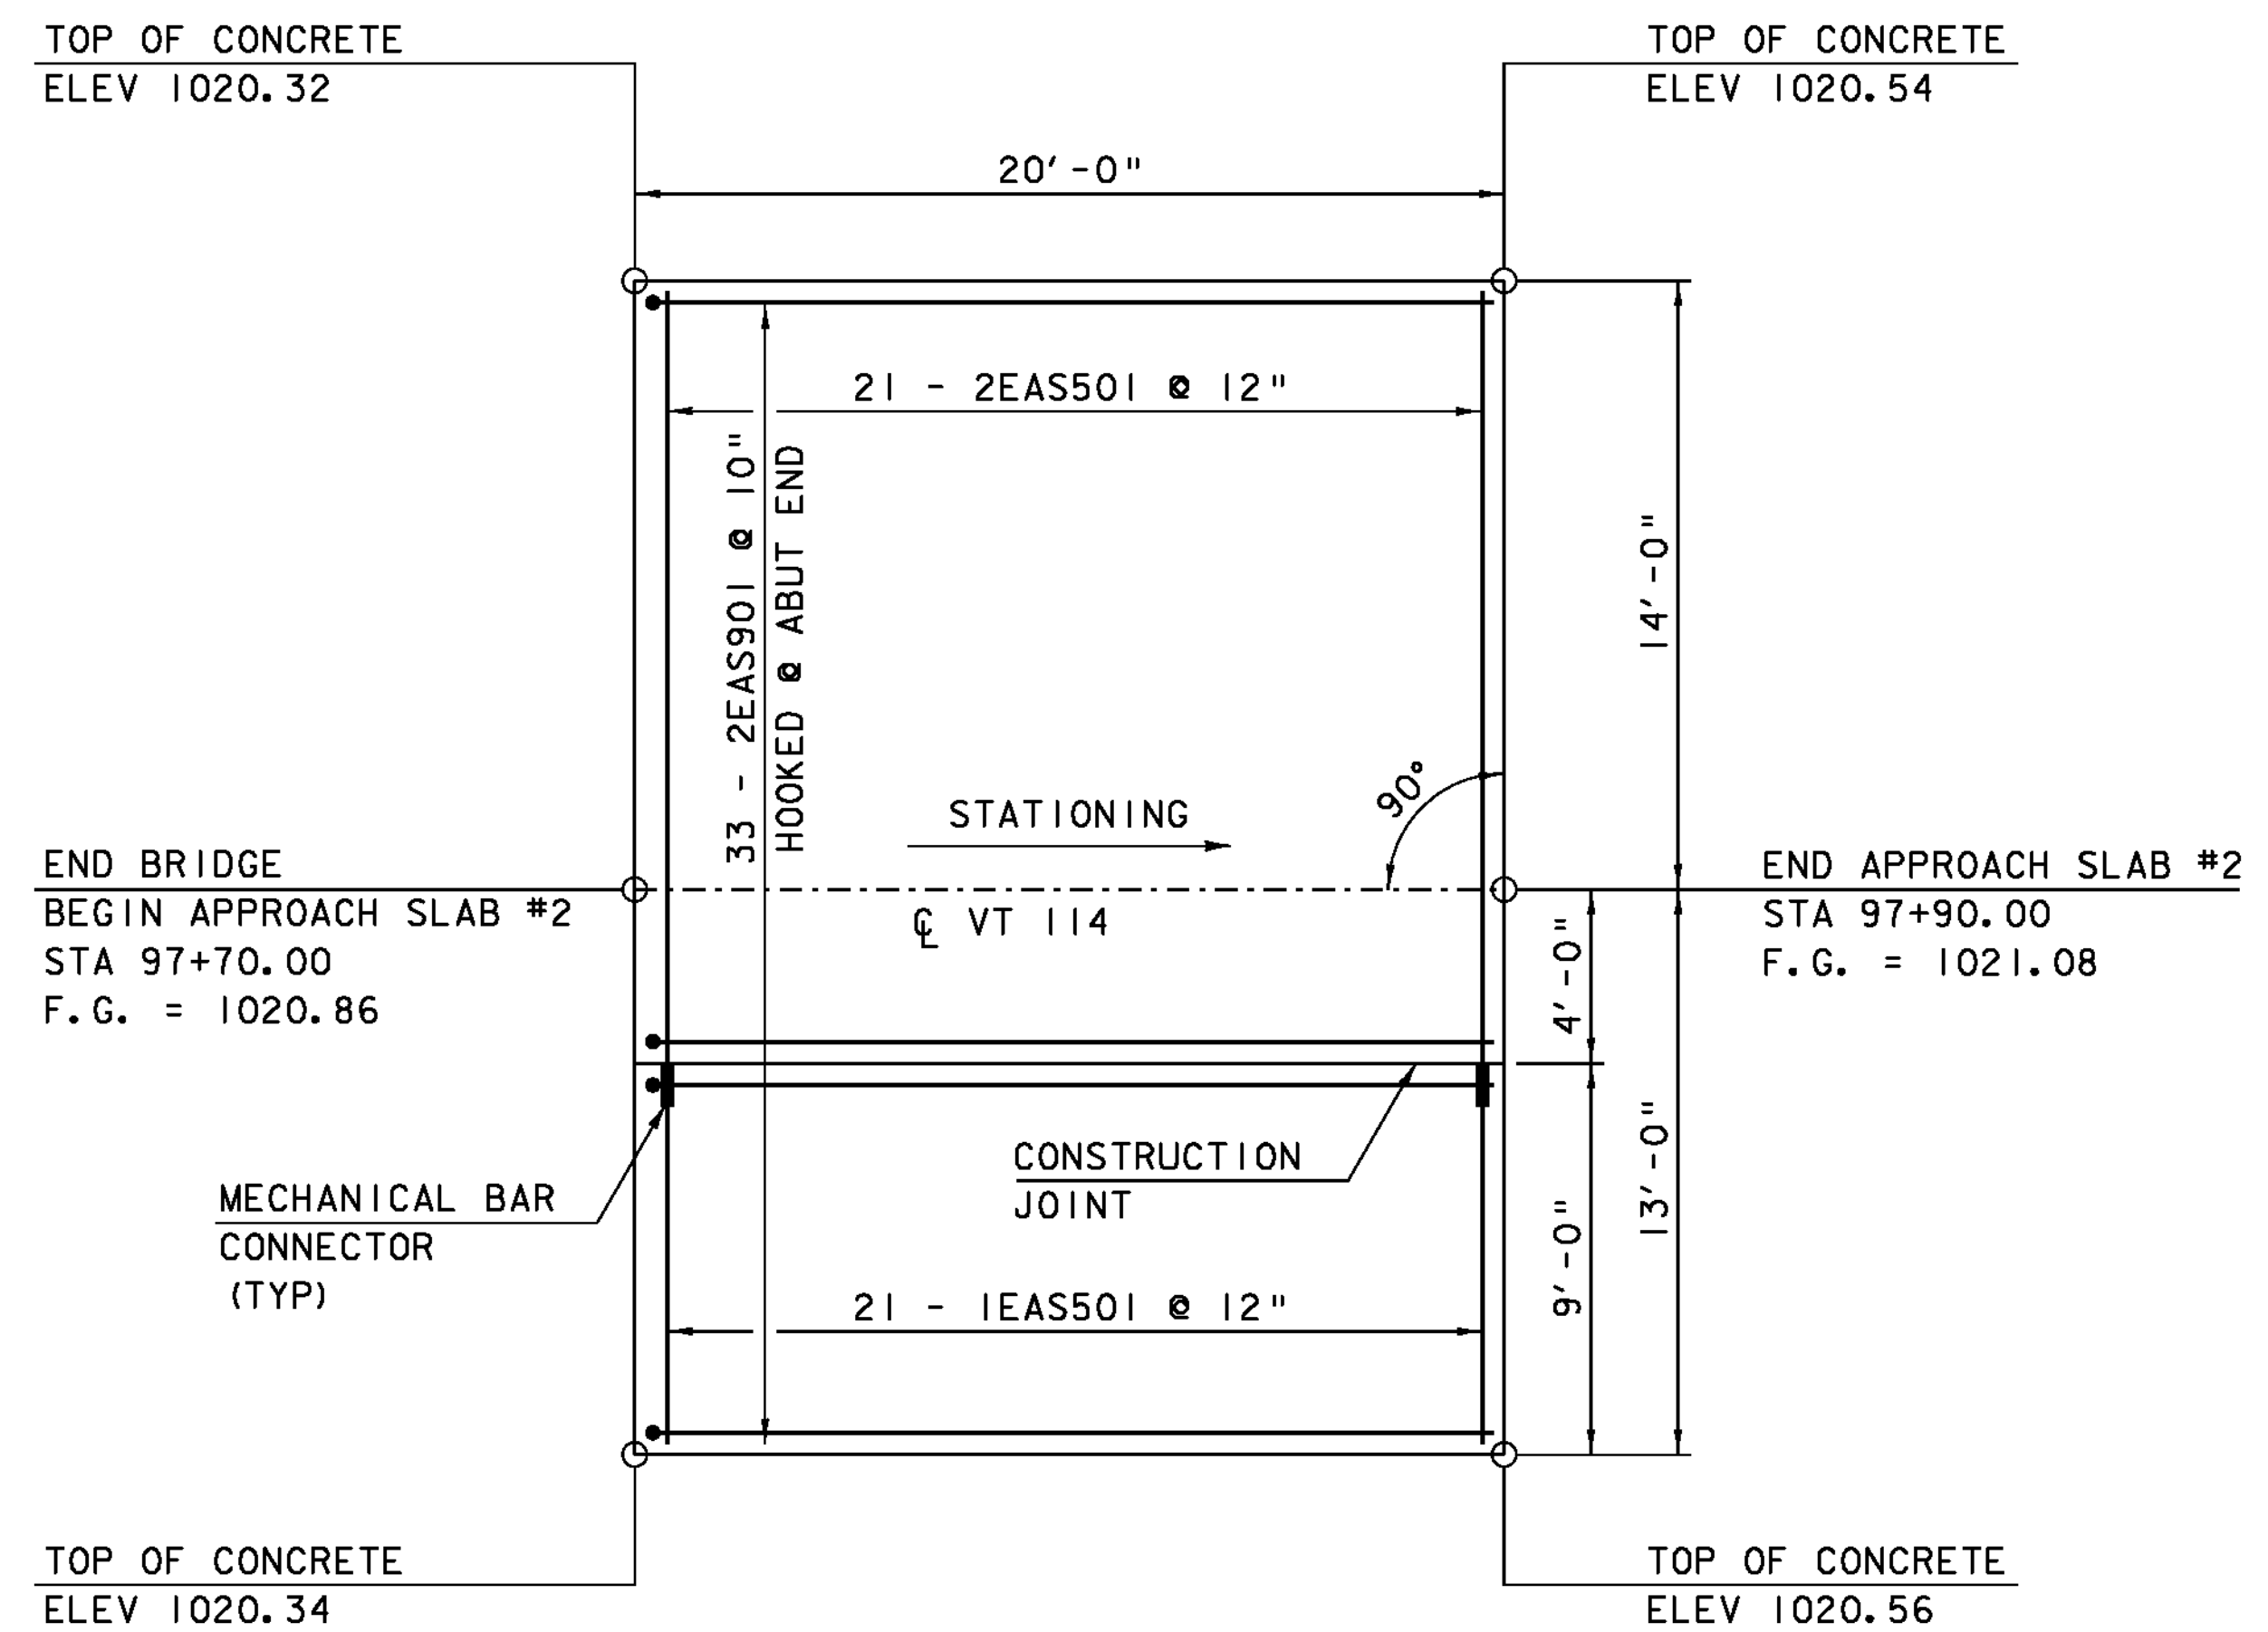


APPROACH SLAB #2 PLAN
 SCALE 1/4" = 1'-0"

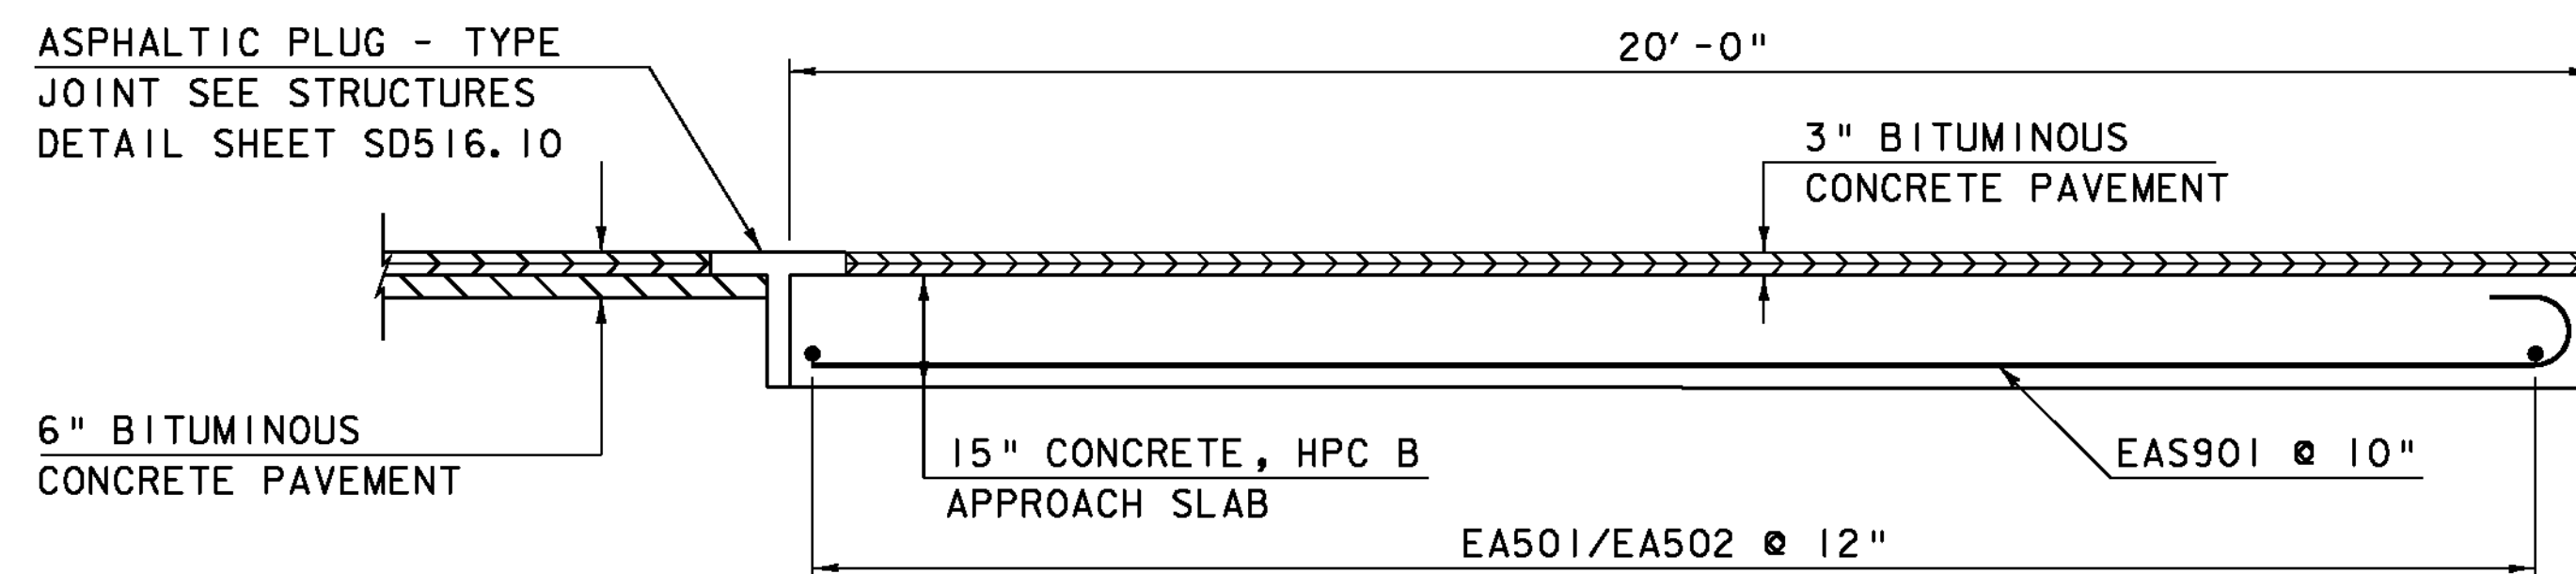

APPROACH SLAB ELEVATION (TYP)
 SCALE 1/2" = 1'-0"

NOTE:
 E = EPOXY COATED REINFORCING
 NF = NEAR FACE
 FF = FAR FACE
 EF = EACH FACE
 ▲ = CUT TO FIT IN FIELD
 3" CLEAR, UNLESS OTHERWISE SPECIFIED ON THE PLANS.
 3'-0" BAR LAP UNLESS OTHERWISE SPECIFIED ON THE PLANS.

PROJECT NAME:	EAST HAVEN
PROJECT NUMBER:	BRF 0269(II)
FILE NAME:	s00cl62app.dgn
PROJECT LEADER:	K. HIGGINS
DESIGNED BY:	R. PELLETT
APPROACH SLABS	
PLOT DATE:	08-AUG-2011
DRAWN BY:	R. PELLETT
CHECKED BY:	J. GRIFFIN
SHEET	23 OF 40

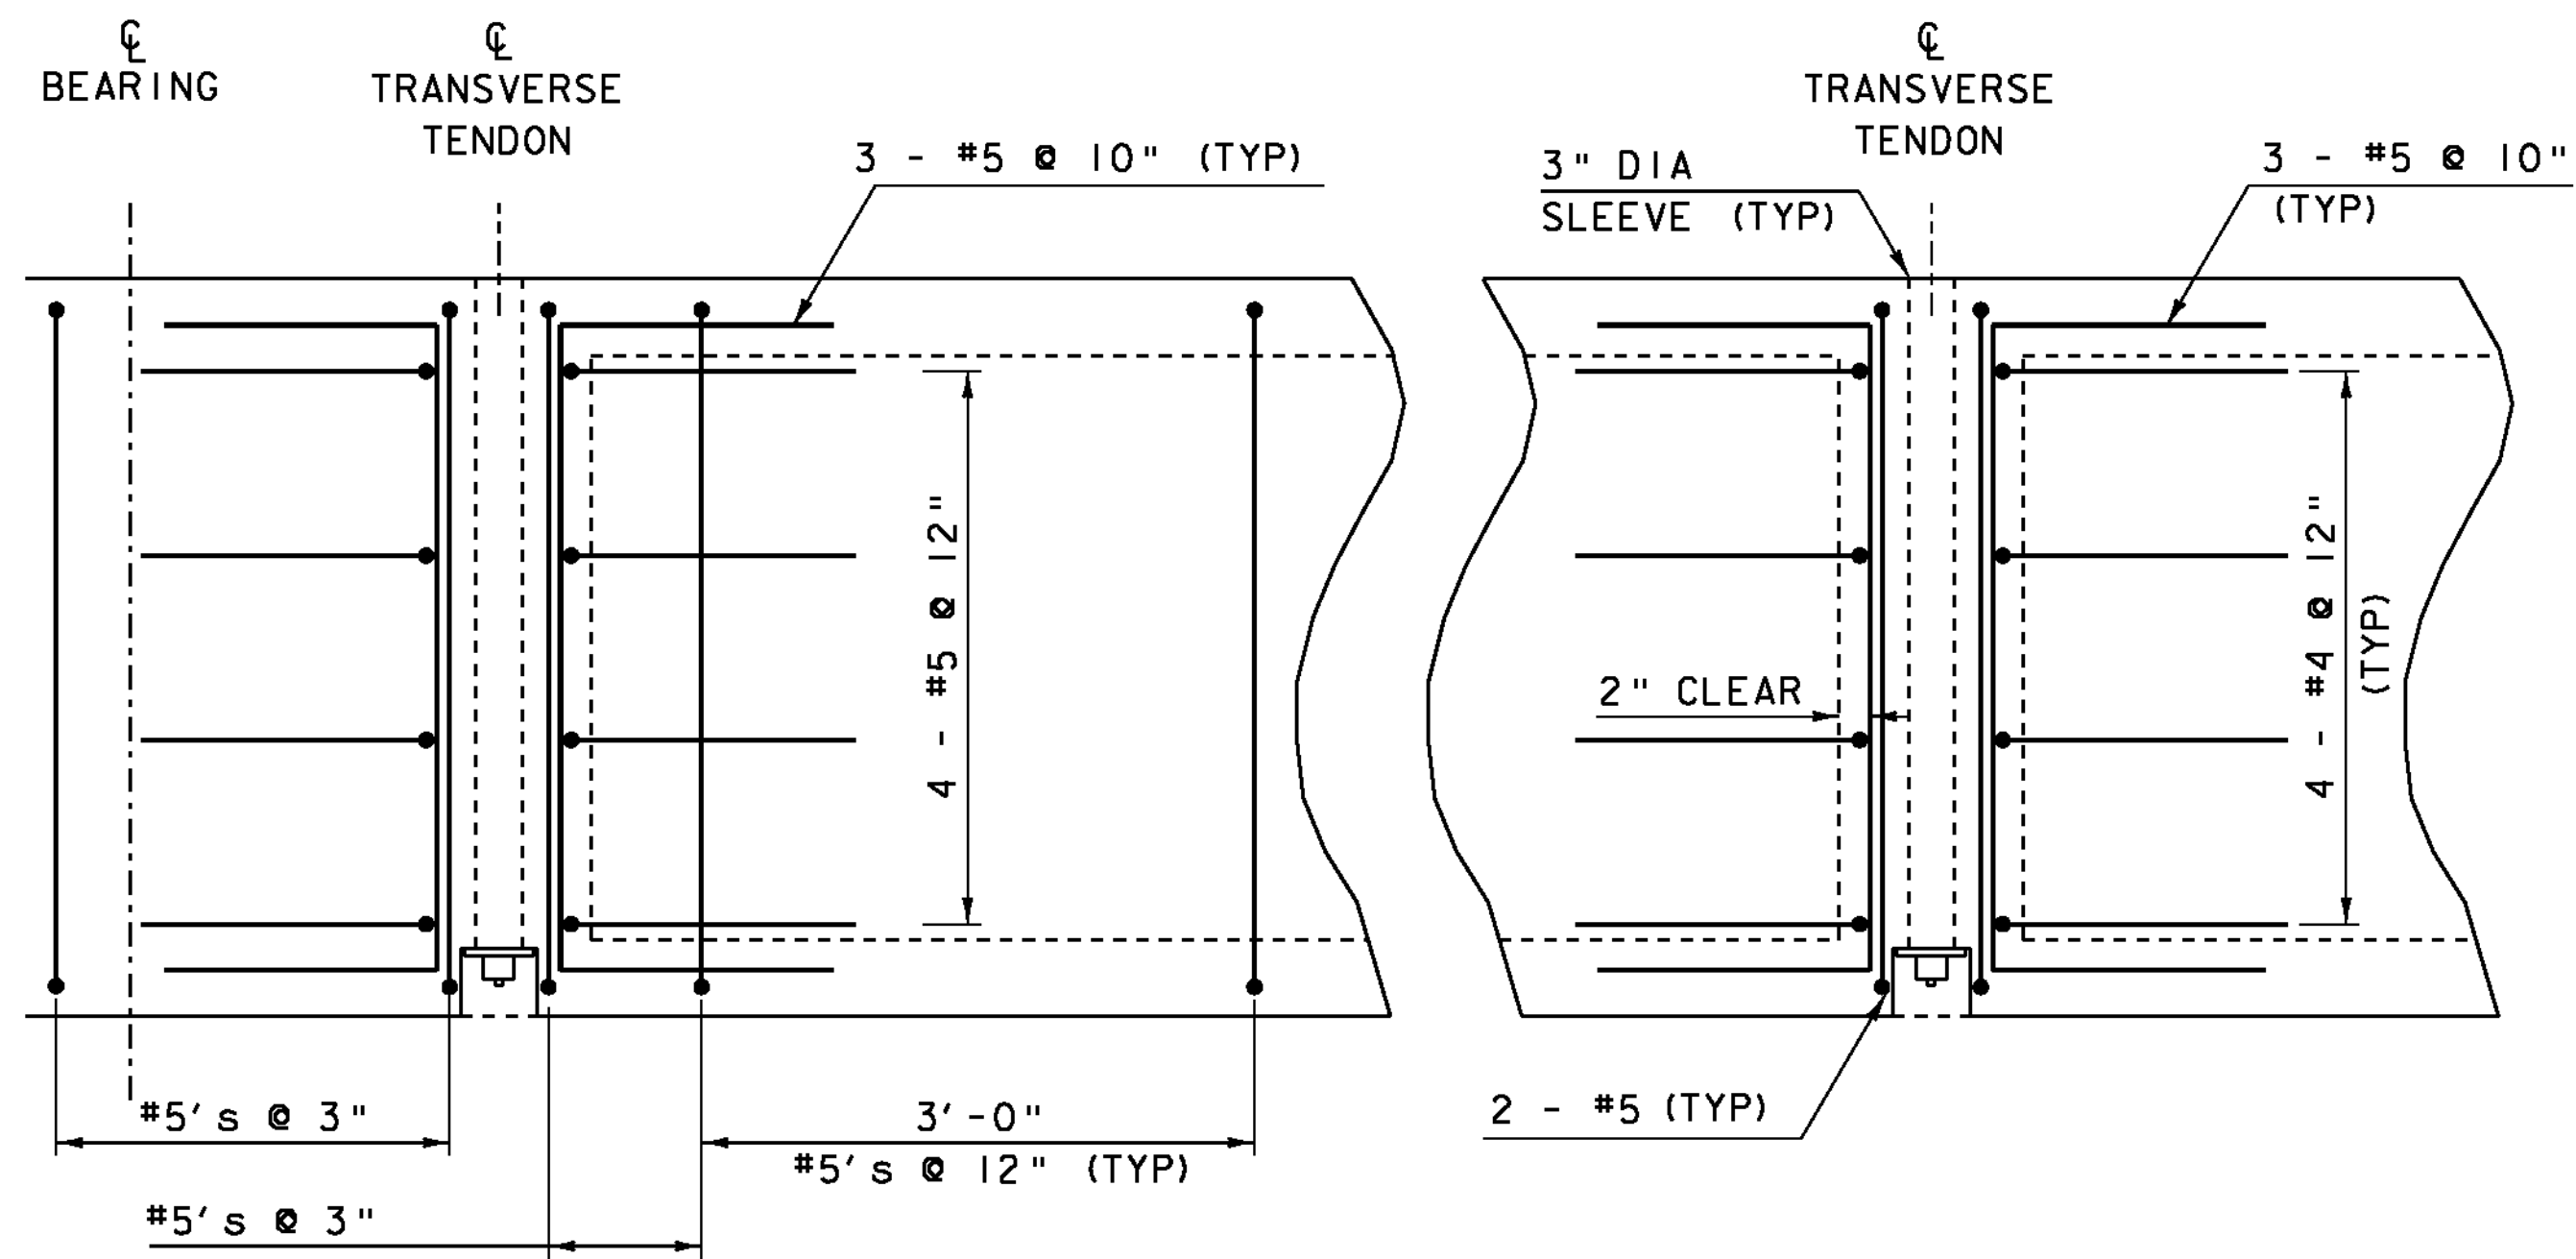


**END DIAPHRAGM REINFORCING
(INTERIOR & EXTERIOR)**

SCALE 1/2" = 1'-0"

**INTERMEDIATE DIAPHRAGM
REINFORCING
(INTERIOR & EXTERIOR)**


SCALE 1/2" = 1'-0"

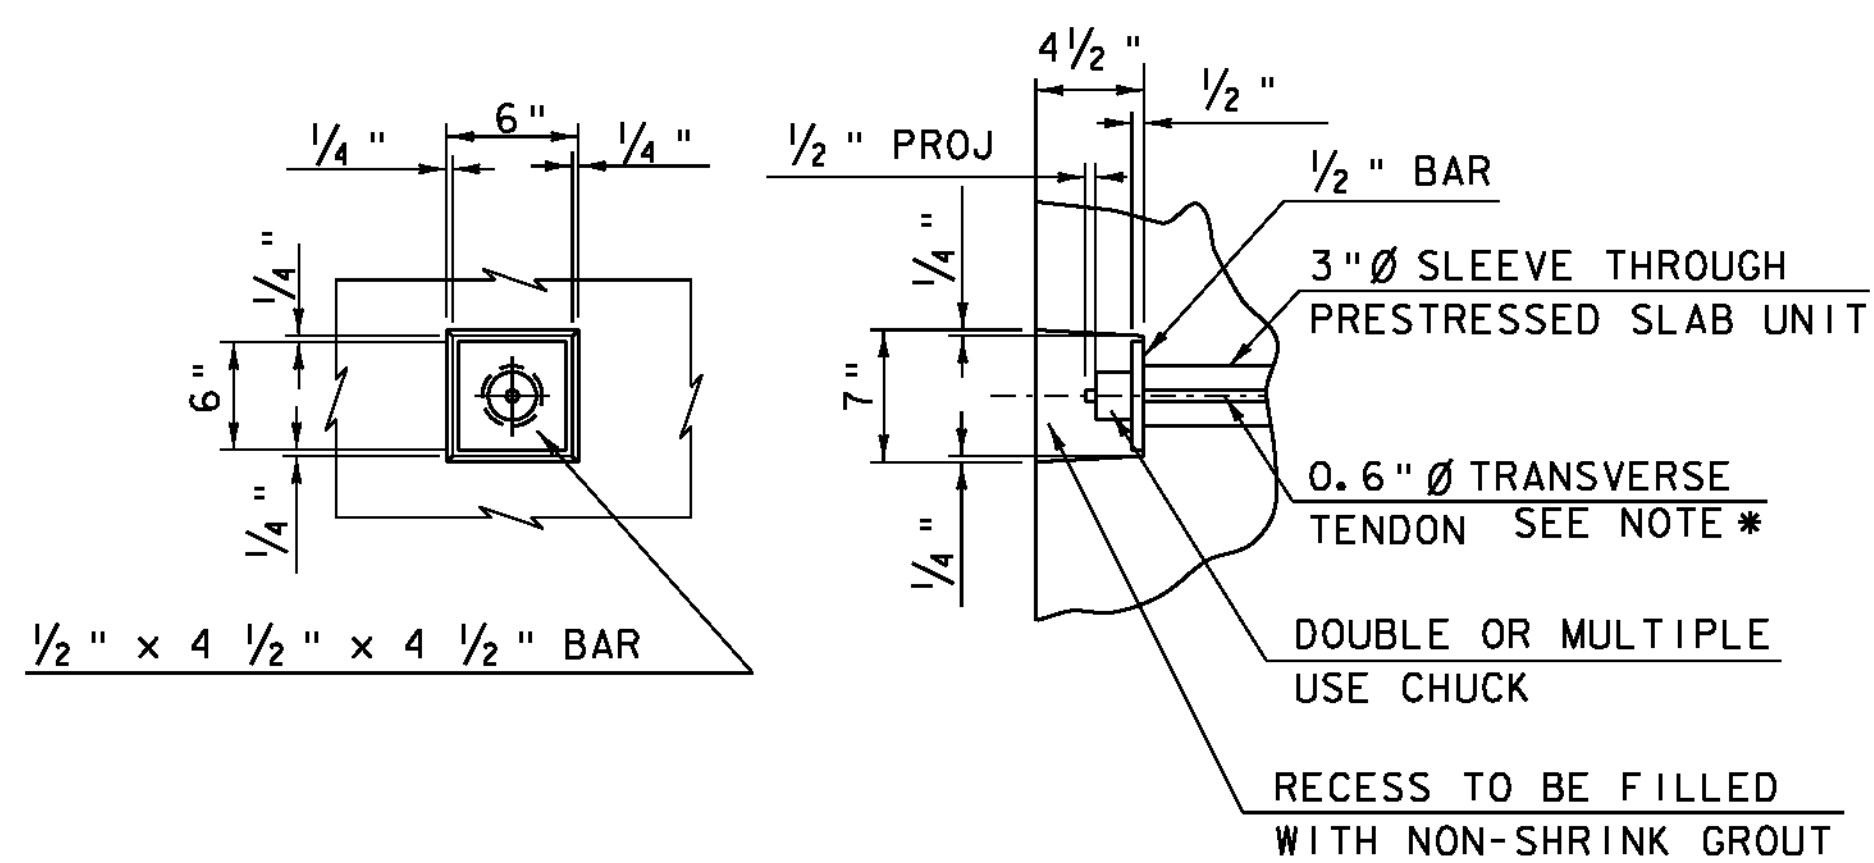

0.6" Ø TRANSVERSE TENDON DETAIL

(NOT TO SCALE)


*TRANSVERSE TIES SHALL BE COVERED BY SEAMLESS POLYPROPYLENE SHEATH (WITH CORROSION INHIBITOR GREASE BETWEEN SHEATH AND STRAND) FOR THE LENGTH OF STRAND, EXCEPT AT ANCHORAGE LOCATIONS, EACH STRAND SHALL BE TENSIONED TO 47 KIPS

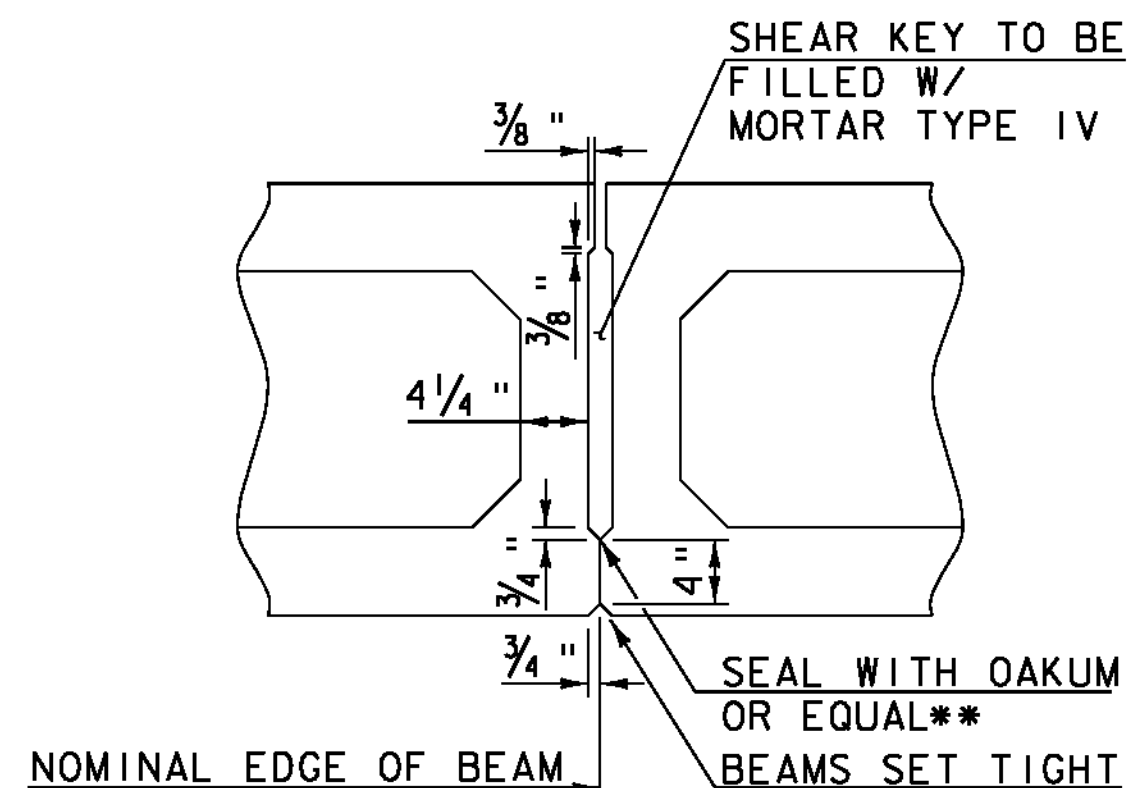

**SHEAR KEY DETAIL
FOR BOX BEAM**

** NOTES:

1. INSTALL OAKUM AFTER UNITS HAVE BEEN PLACED.
2. PAYMENT INCIDENTAL TO ITEM 510.21 PRESTRESSED CONCRETE BOX BEAMS

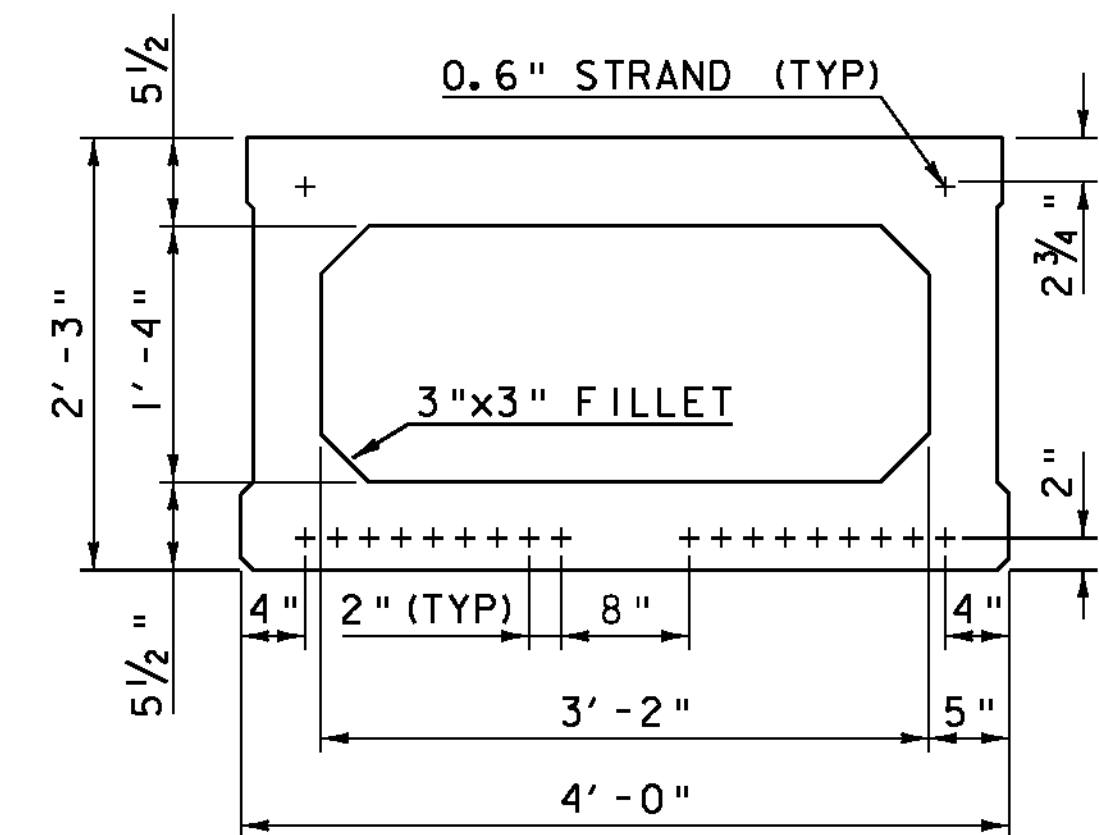


STRAND PATTERN (TYP)

SCALE 1/2" = 1'-0"


NOTES:

1. EXTEND EVERY OTHER BONDED PRESTRESSED STRANDS ON THE BOTTOM ROW 2'-8". IN LIEU OF EXTENDING THE STRANDS, THE CONTRACTOR MAY PROPOSE AN ALTERNATE DETAIL.
2. REINFORCING STEEL NOT SHOWN FOR CLARITY.

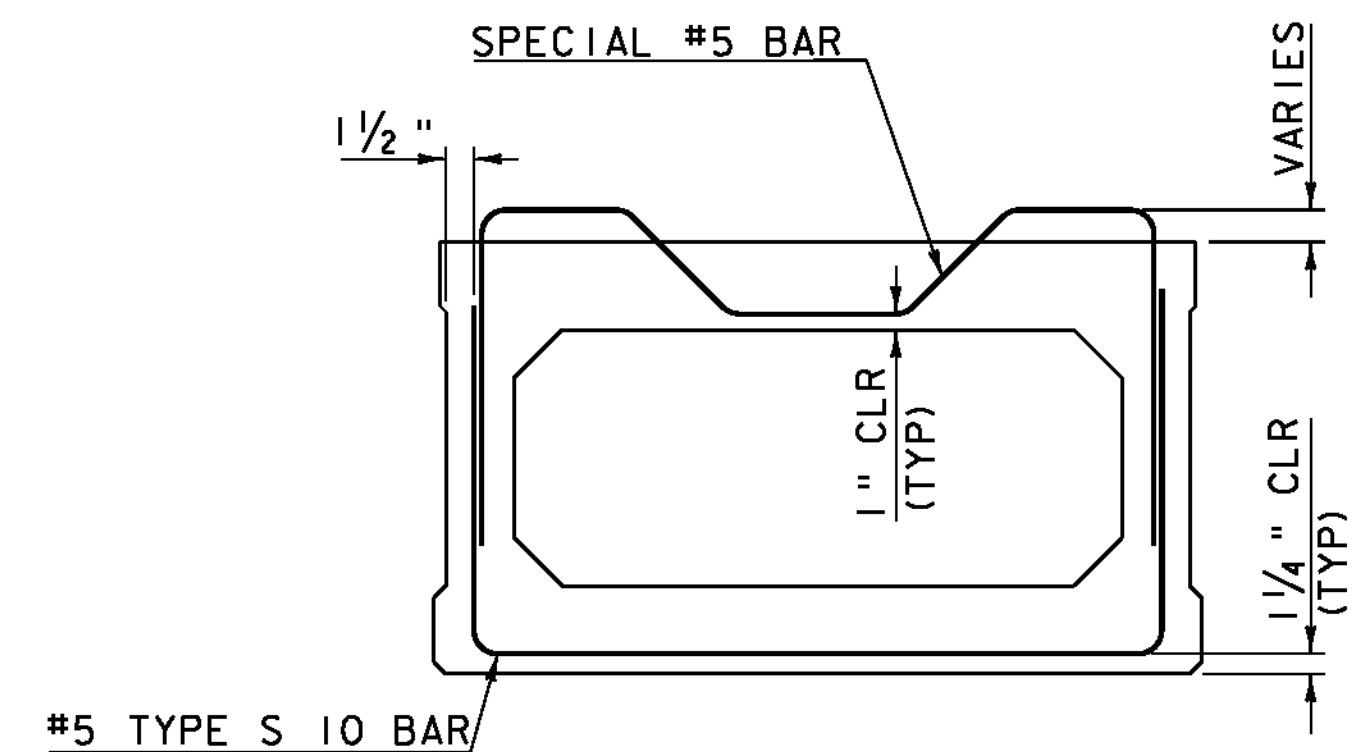

SHEAR REINFORCEMENT

SCALE 1/2" = 1'-0"
STRANDS NOT SHOWN FOR CLARITY

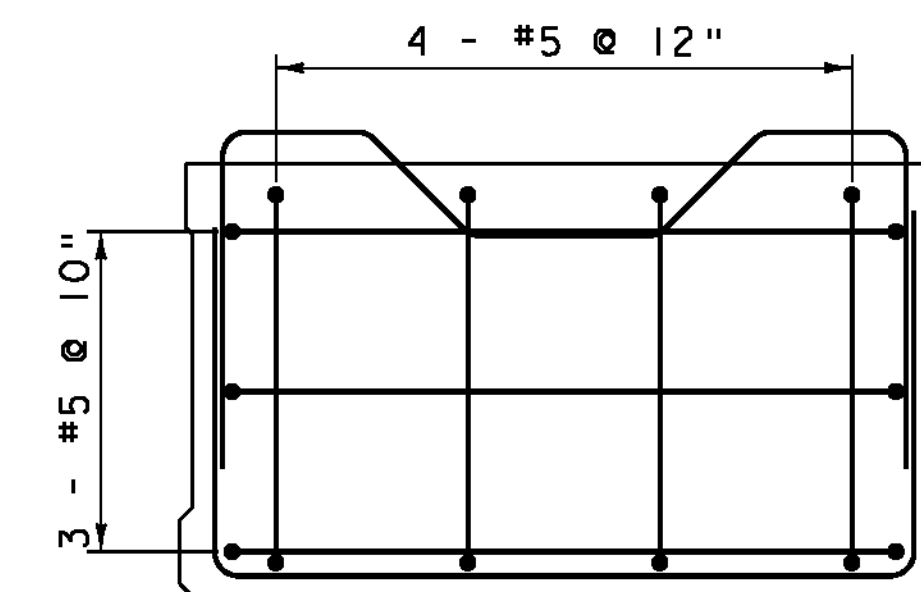

**BOX BEAM
REINFORCING LAYOUT**

BEG/END BRIDGE

SCALE 1/2" = 1'-0"






NOTES:

1. ONE MAT EACH SIDE OF TRANSVERSE DUCTS
2. STRANDS NOT SHOWN FOR CLARITY

PROJECT NAME: EAST HAVEN
PROJECT NUMBER: BRF 0269(II)

FILE NAME: s00cl62sup.dgn
PROJECT LEADER: K. HIGGINS
DESIGNED BY: J. GRIFFIN
SUPERSTRUCTURE REINFORCING 2






PLOT DATE: 17-AUG-2011
DRAWN BY: J. GRIFFIN
CHECKED BY: J. LACROIX
SHEET 22 OF 40

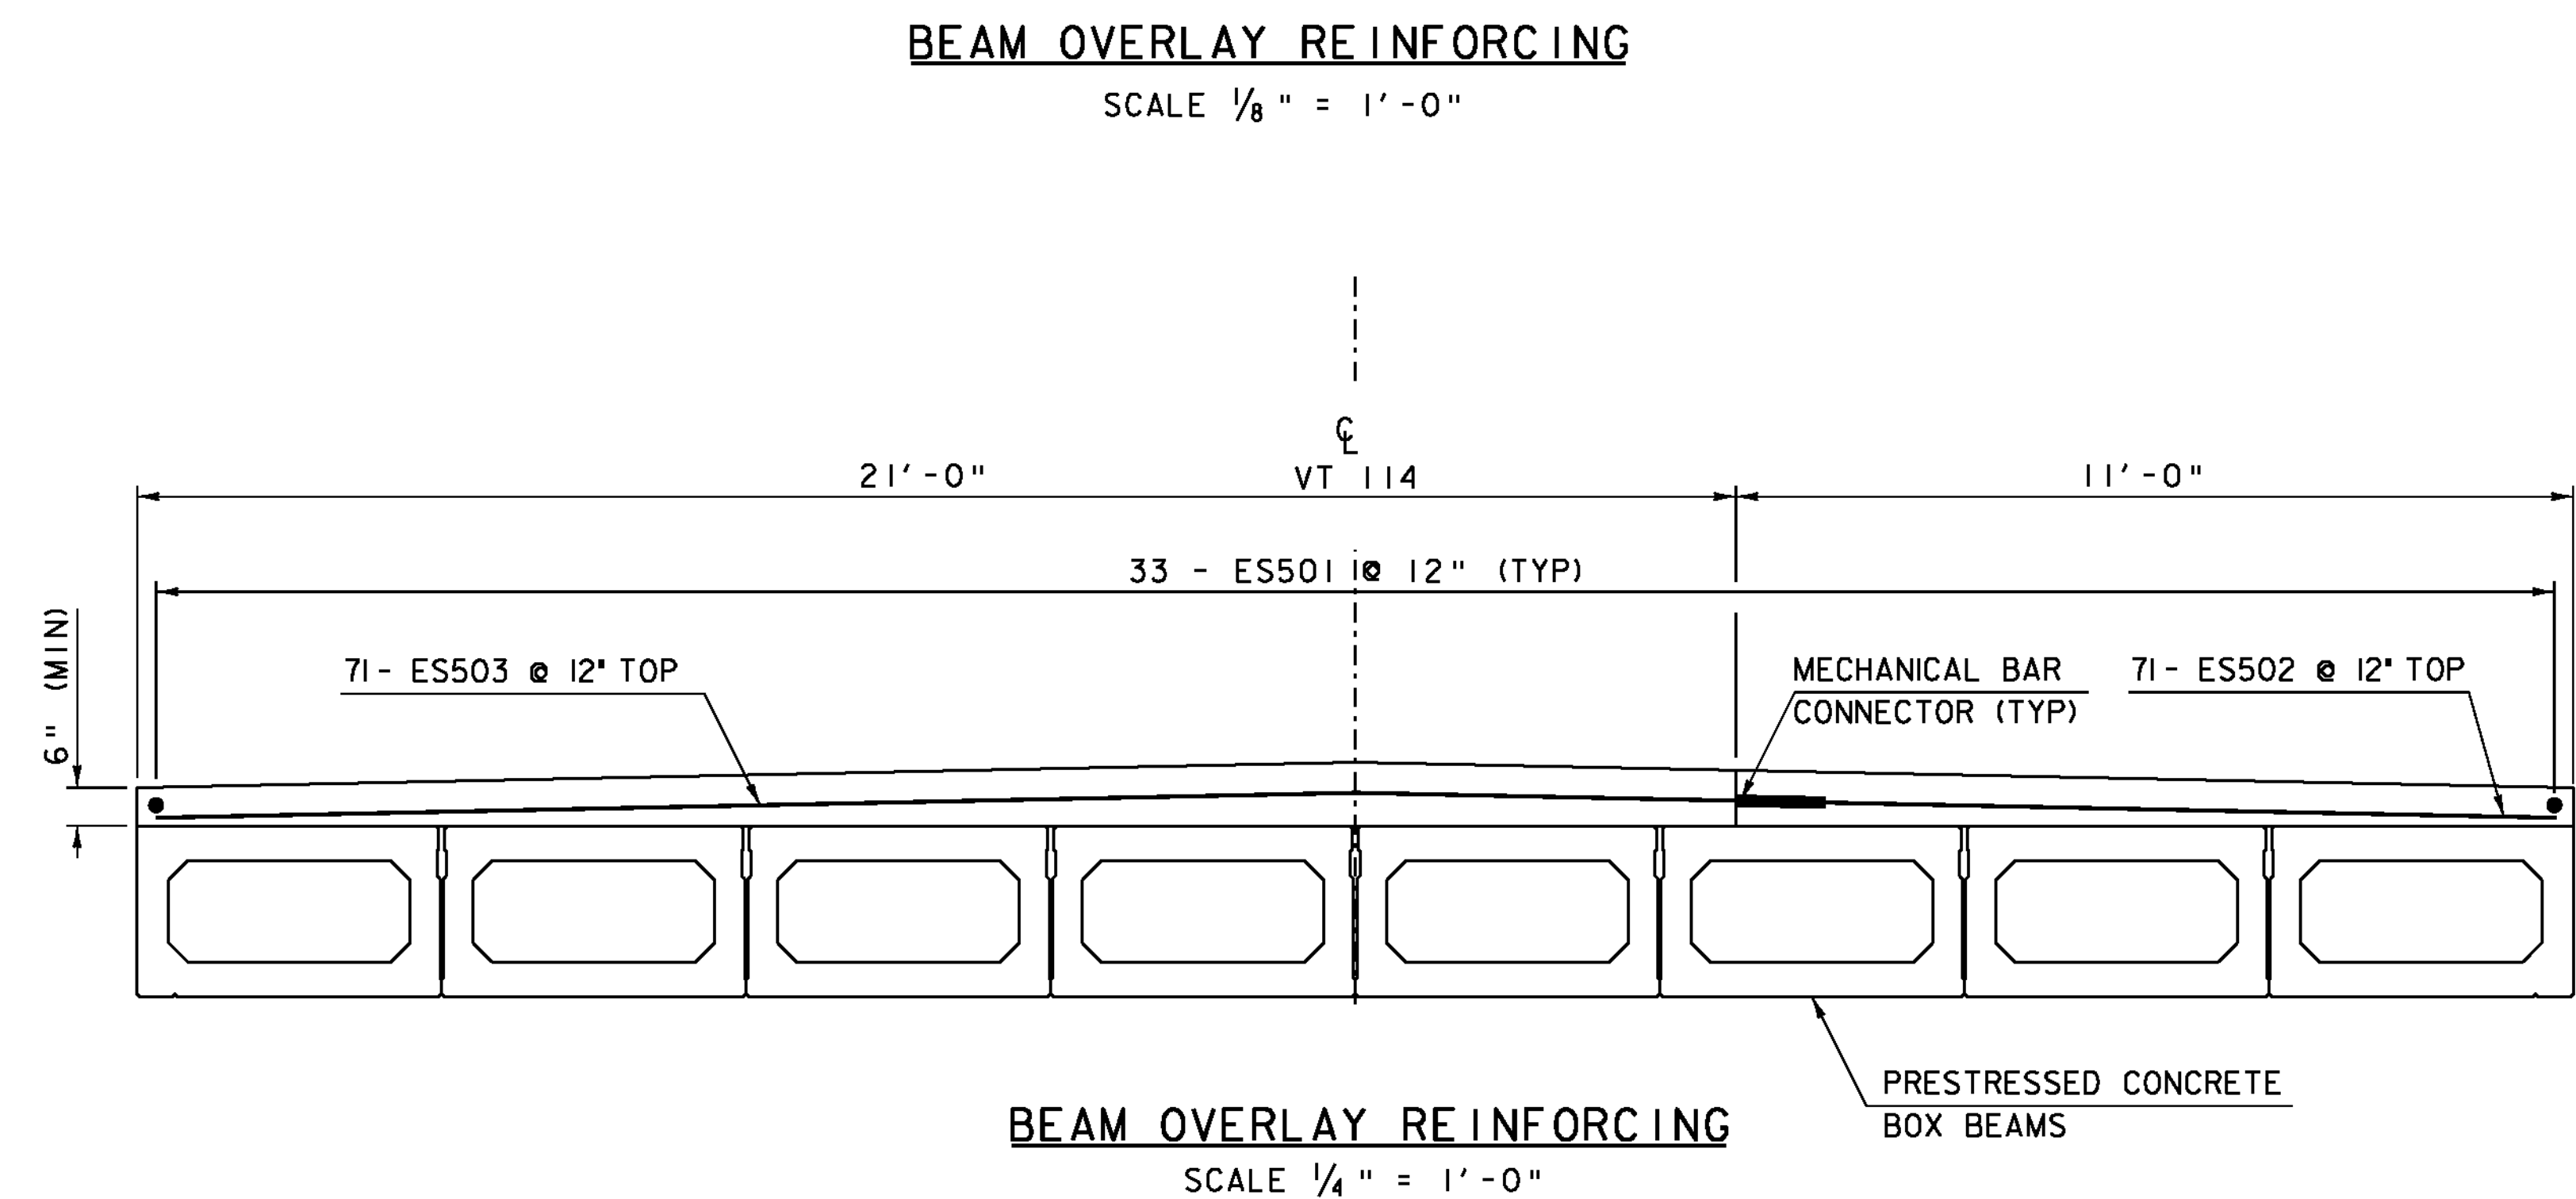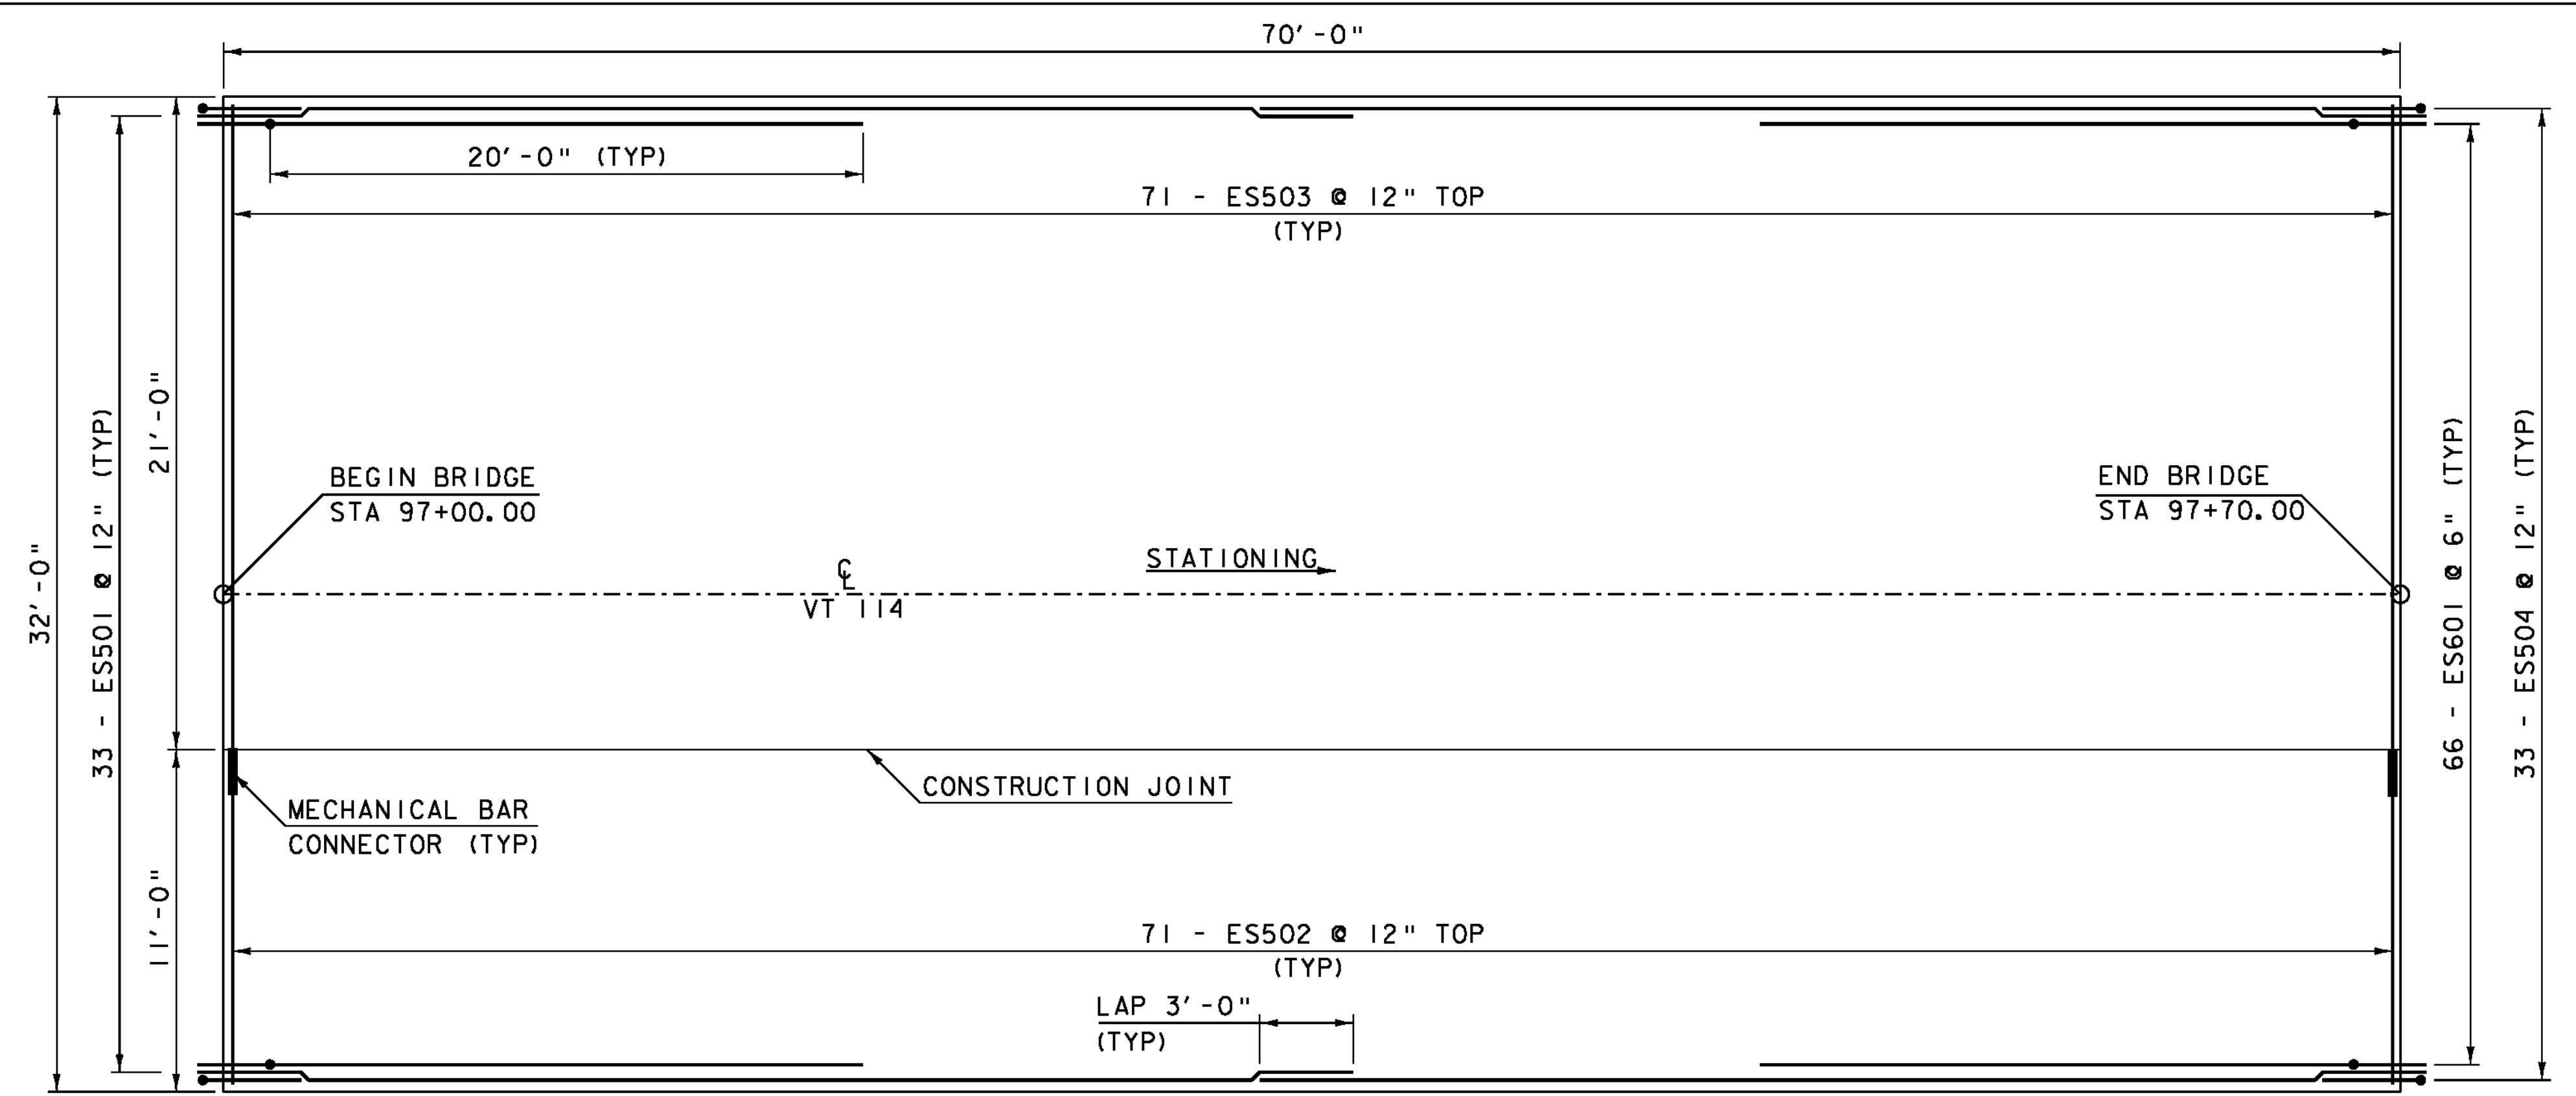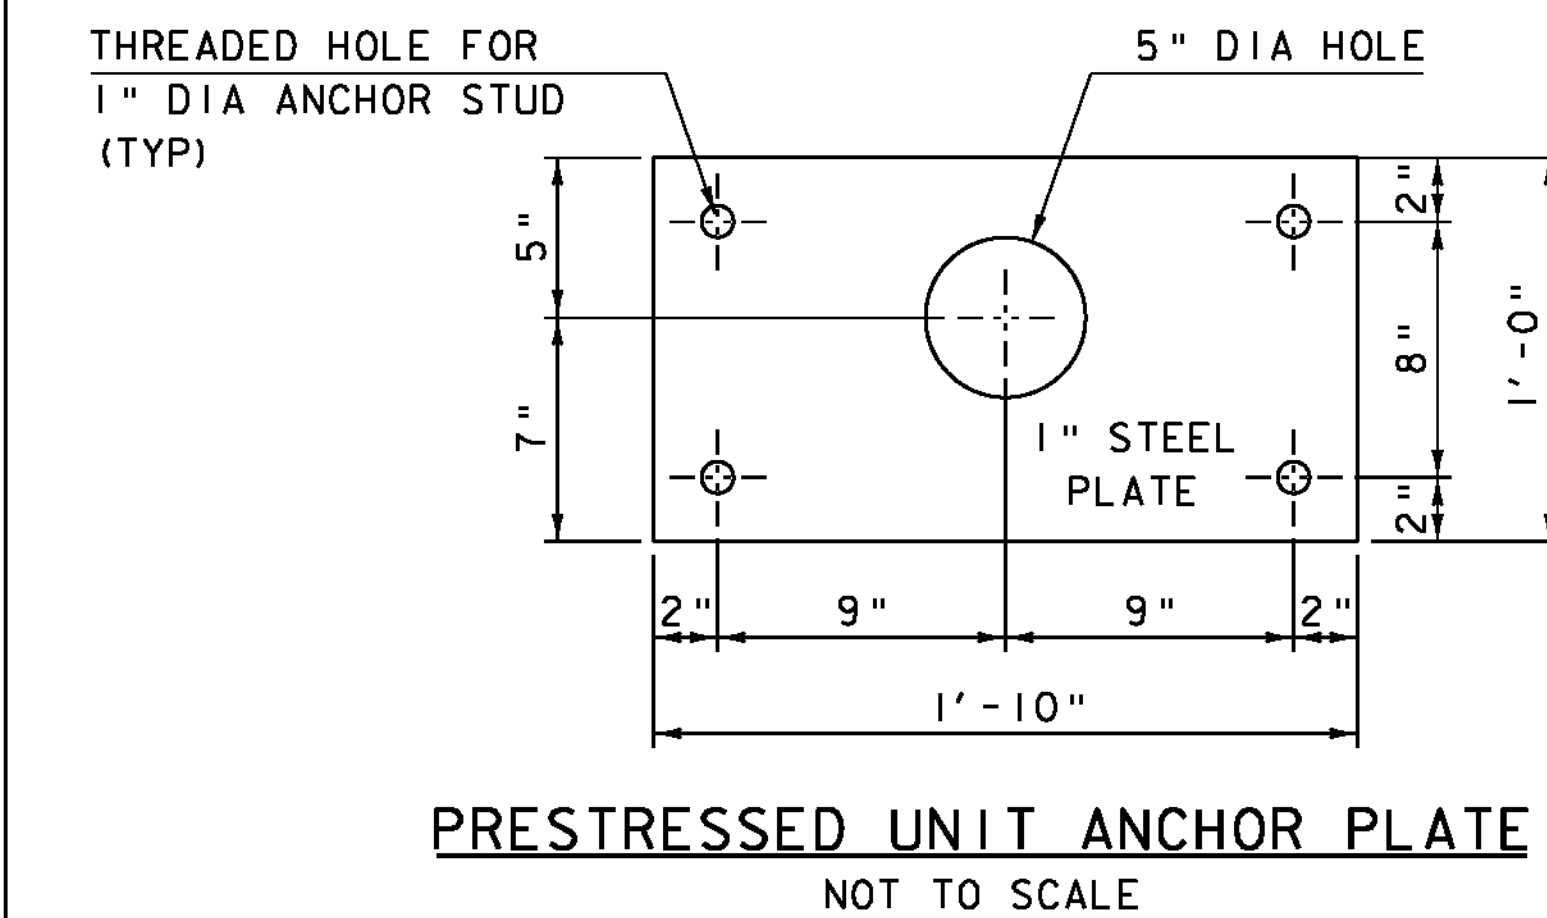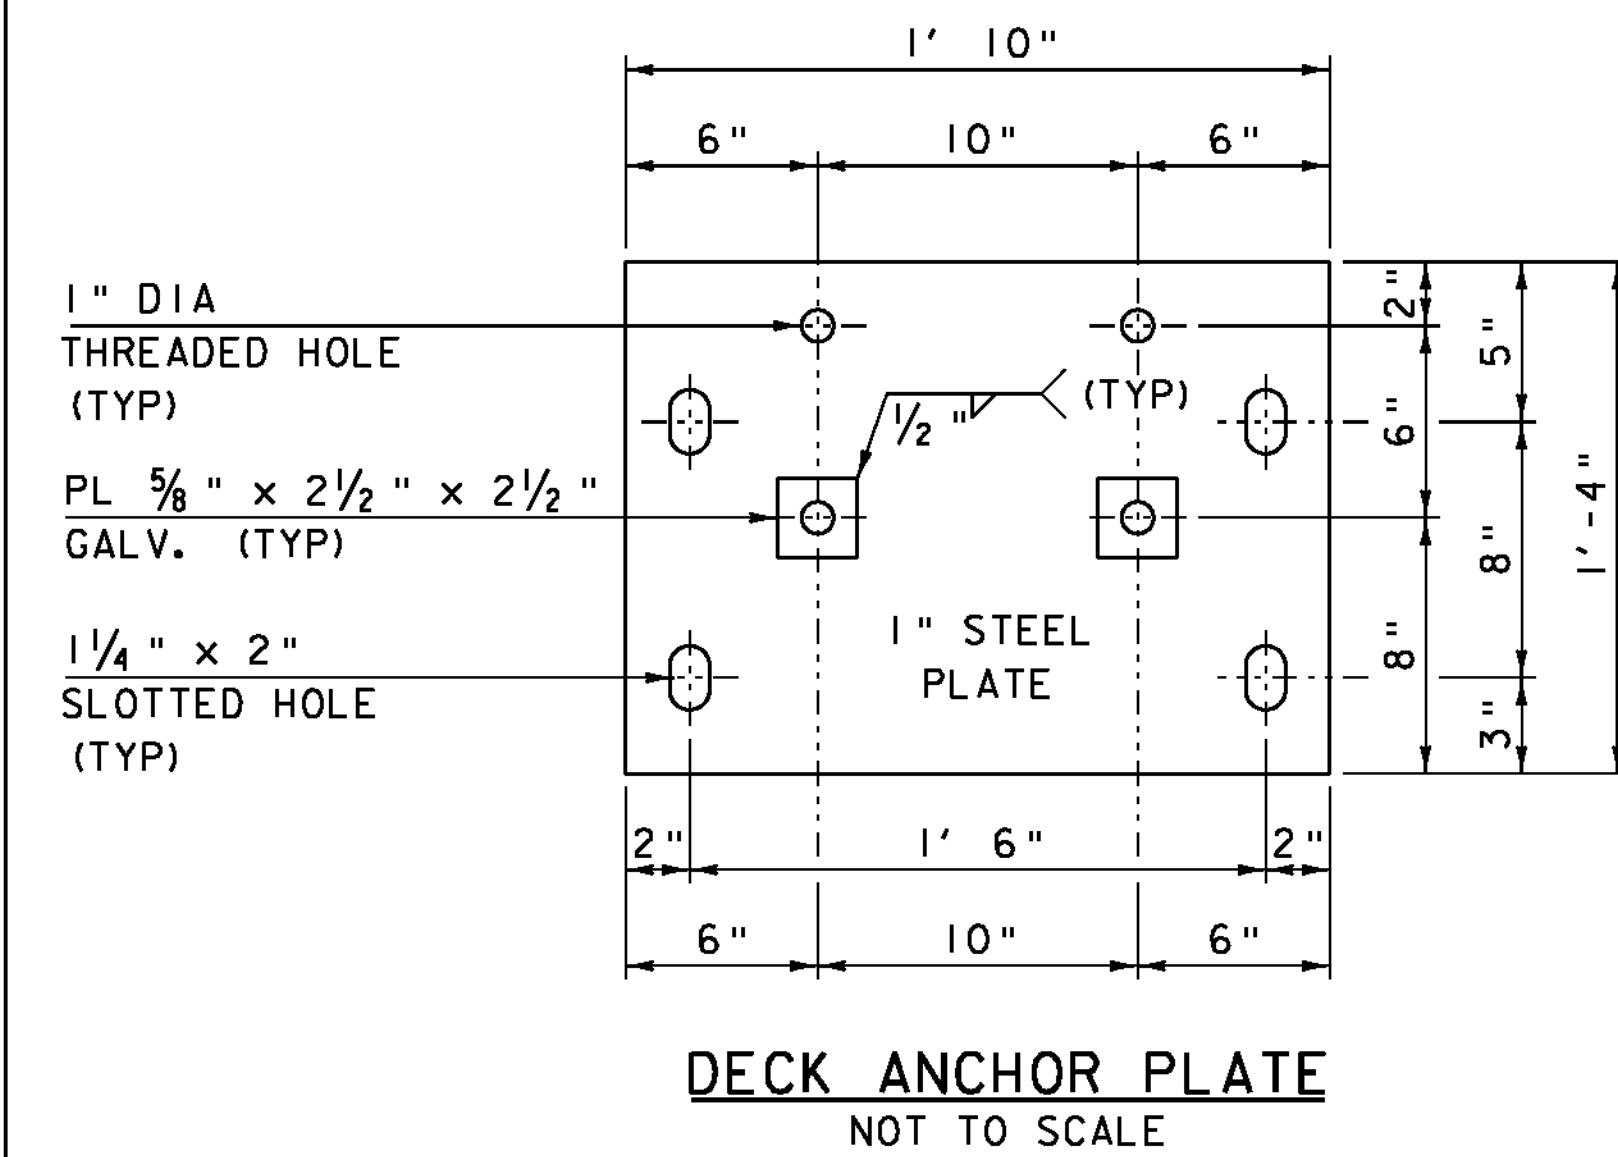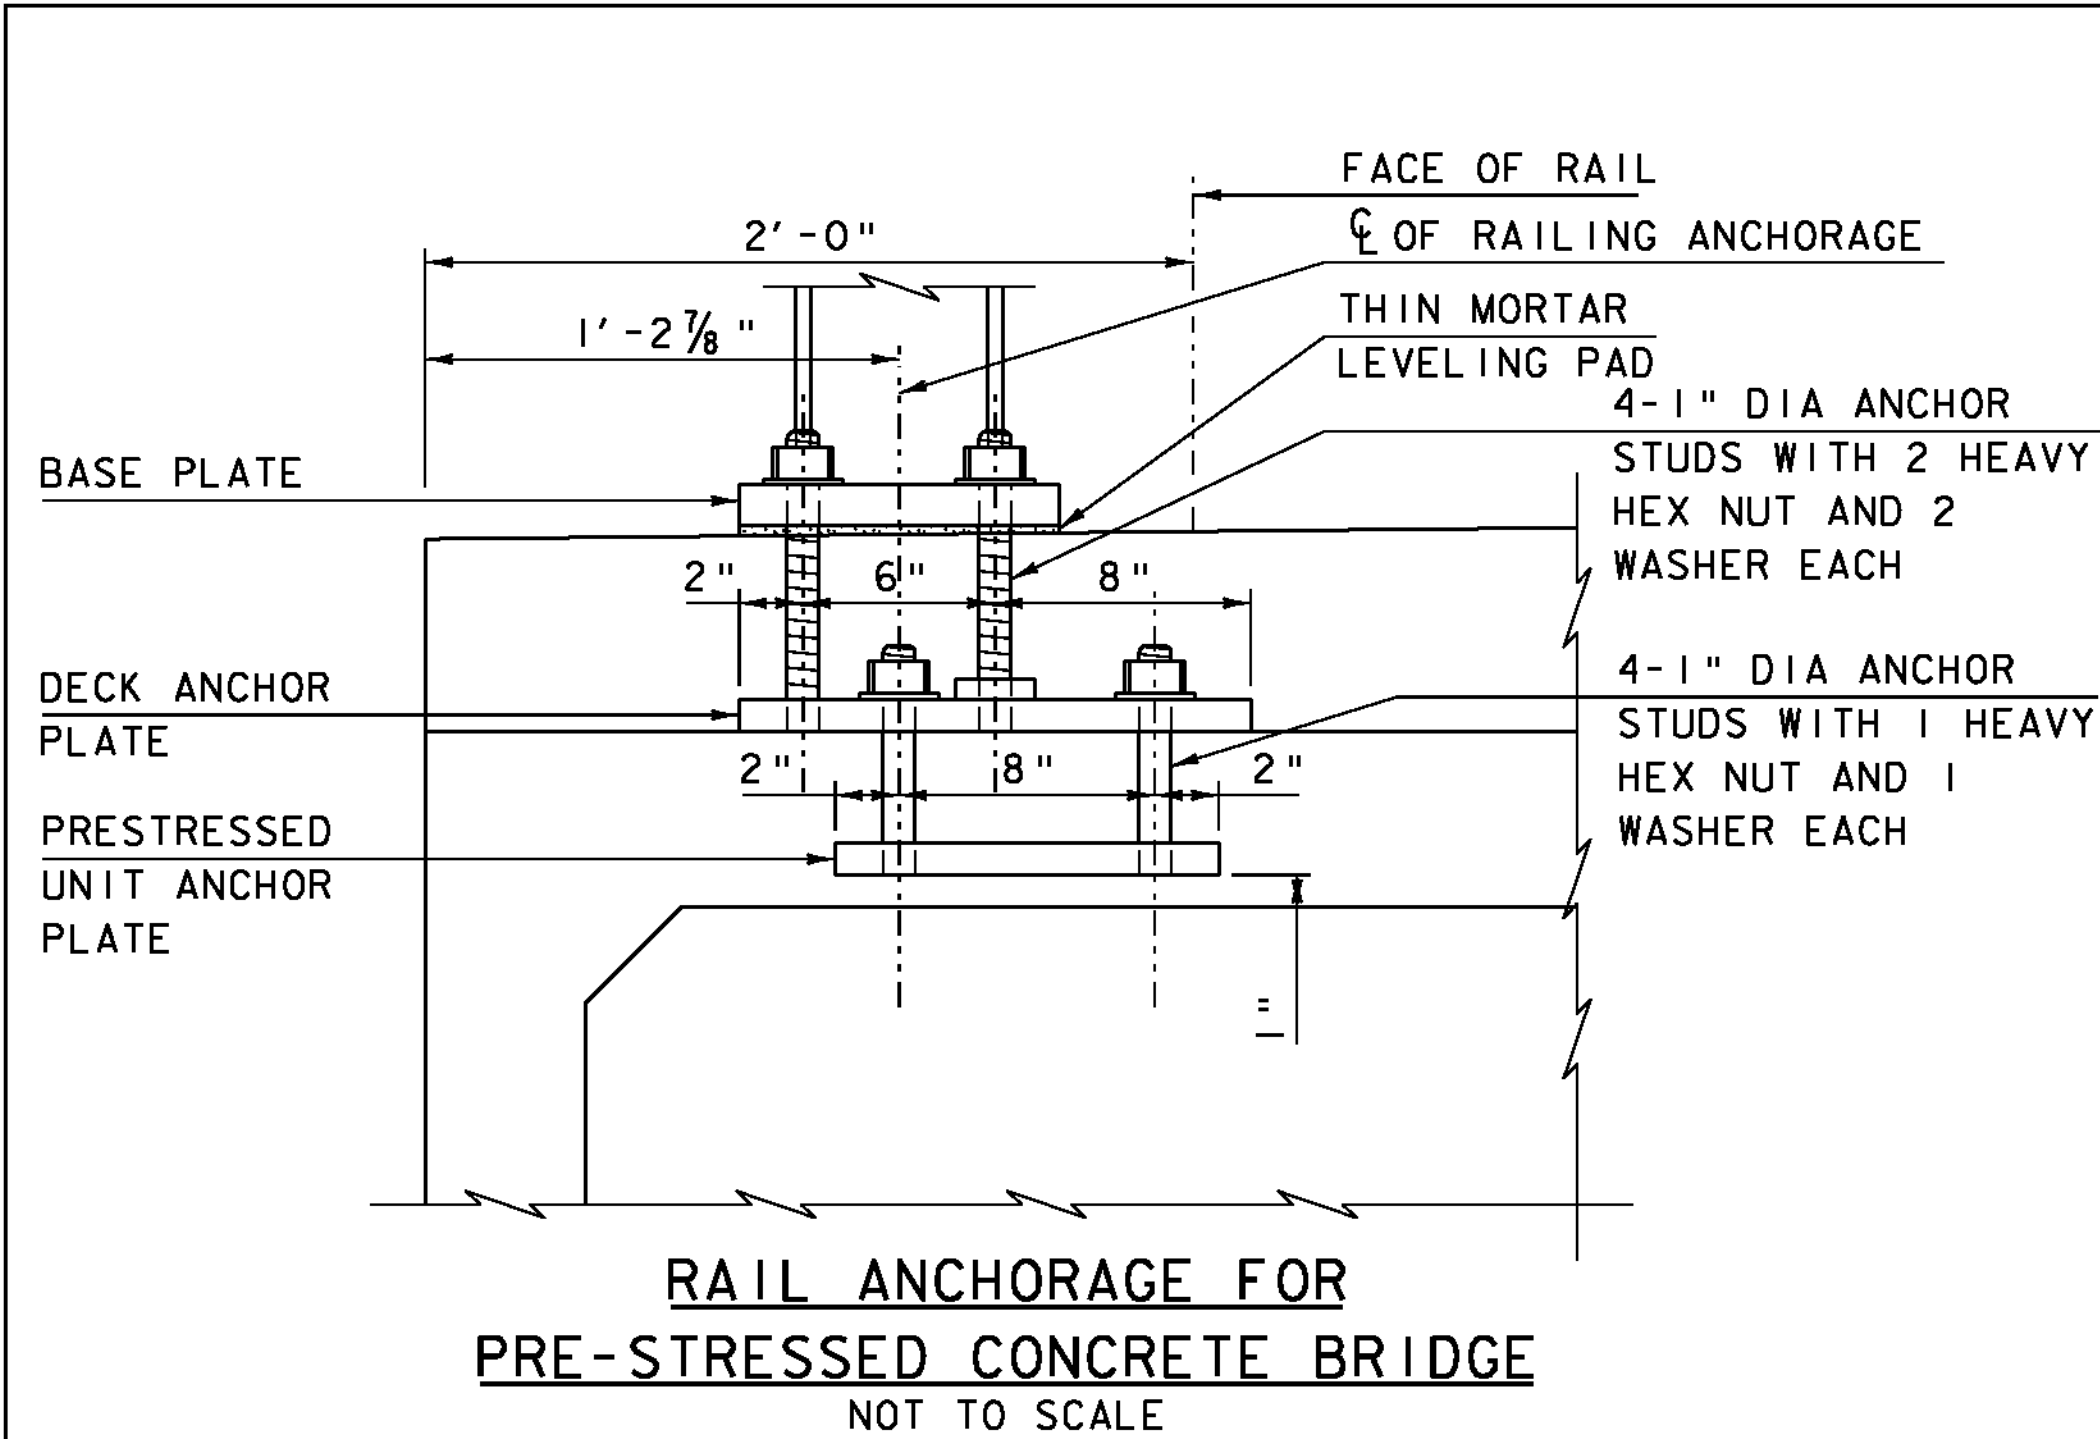

- NOTES:**
1. THE COST OF DECK ANCHOR PLATE AND THE RAILING ANCHOR STUDS SHALL BE INCLUDED IN THE BID PRICE BID FOR THE BRIDGE RAILING
 2. THE COST OF ANCHOR PLATE AND STUDS CAST INTO PRESTRESSED CONCRETE UNITS SHALL BE INCLUDED IN THE BID PRICE BID FOR THE PRESTRESSED UNIT.
 3. SEE STANDARD S-364A FOR BRIDGE RAIL DETAILS ABOVE THE TOP OF THE OVERLAY.

- NOTE:**
- NF = NEAR FACE
 - FF = FAR FACE
 - EF = EACH FACE
 - ▲ = CUT TO FIT IN FIELD
 - 3" CLEAR, UNLESS OTHERWISE SPECIFIED ON THE PLANS.
 - 3'-0" BAR LAP UNLESS OTHERWISE SPECIFIED ON THE PLANS.
 - E - EPOXY



PROJECT NAME: EAST HAVEN	PLOT DATE: 17-AUG-2011
PROJECT NUMBER: BRF 0269(II)	DRAWN BY: J. GRIFFIN
FILE NAME: s00cl62sup.dgn	CHECKED BY: J. LACROIX
PROJECT LEADER: K. HIGGINS	SHEET 21 OF 40
DESIGNED BY: J. GRIFFIN	
SUPERSTRUCTURE REINFORCING I	

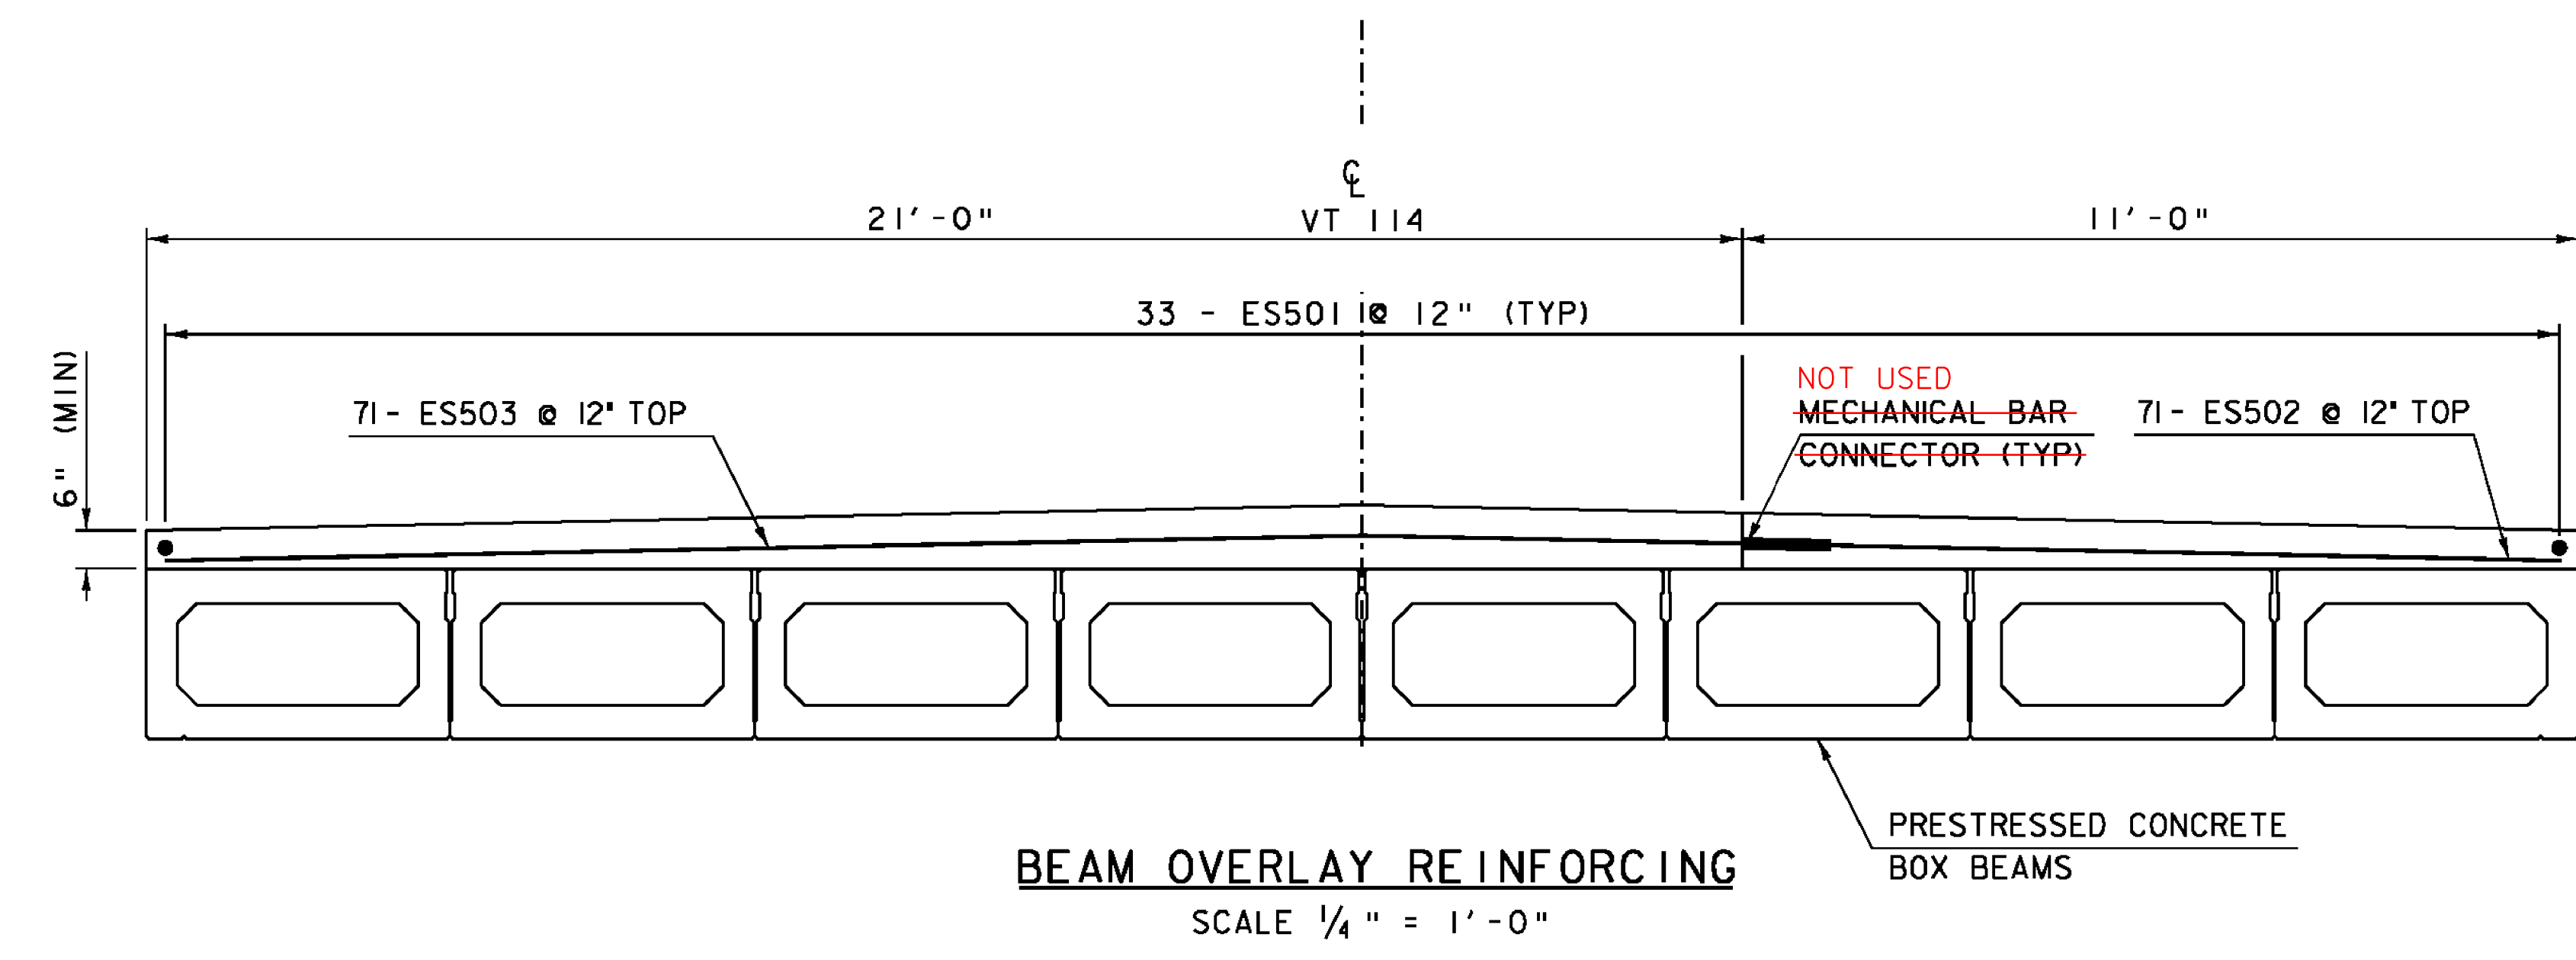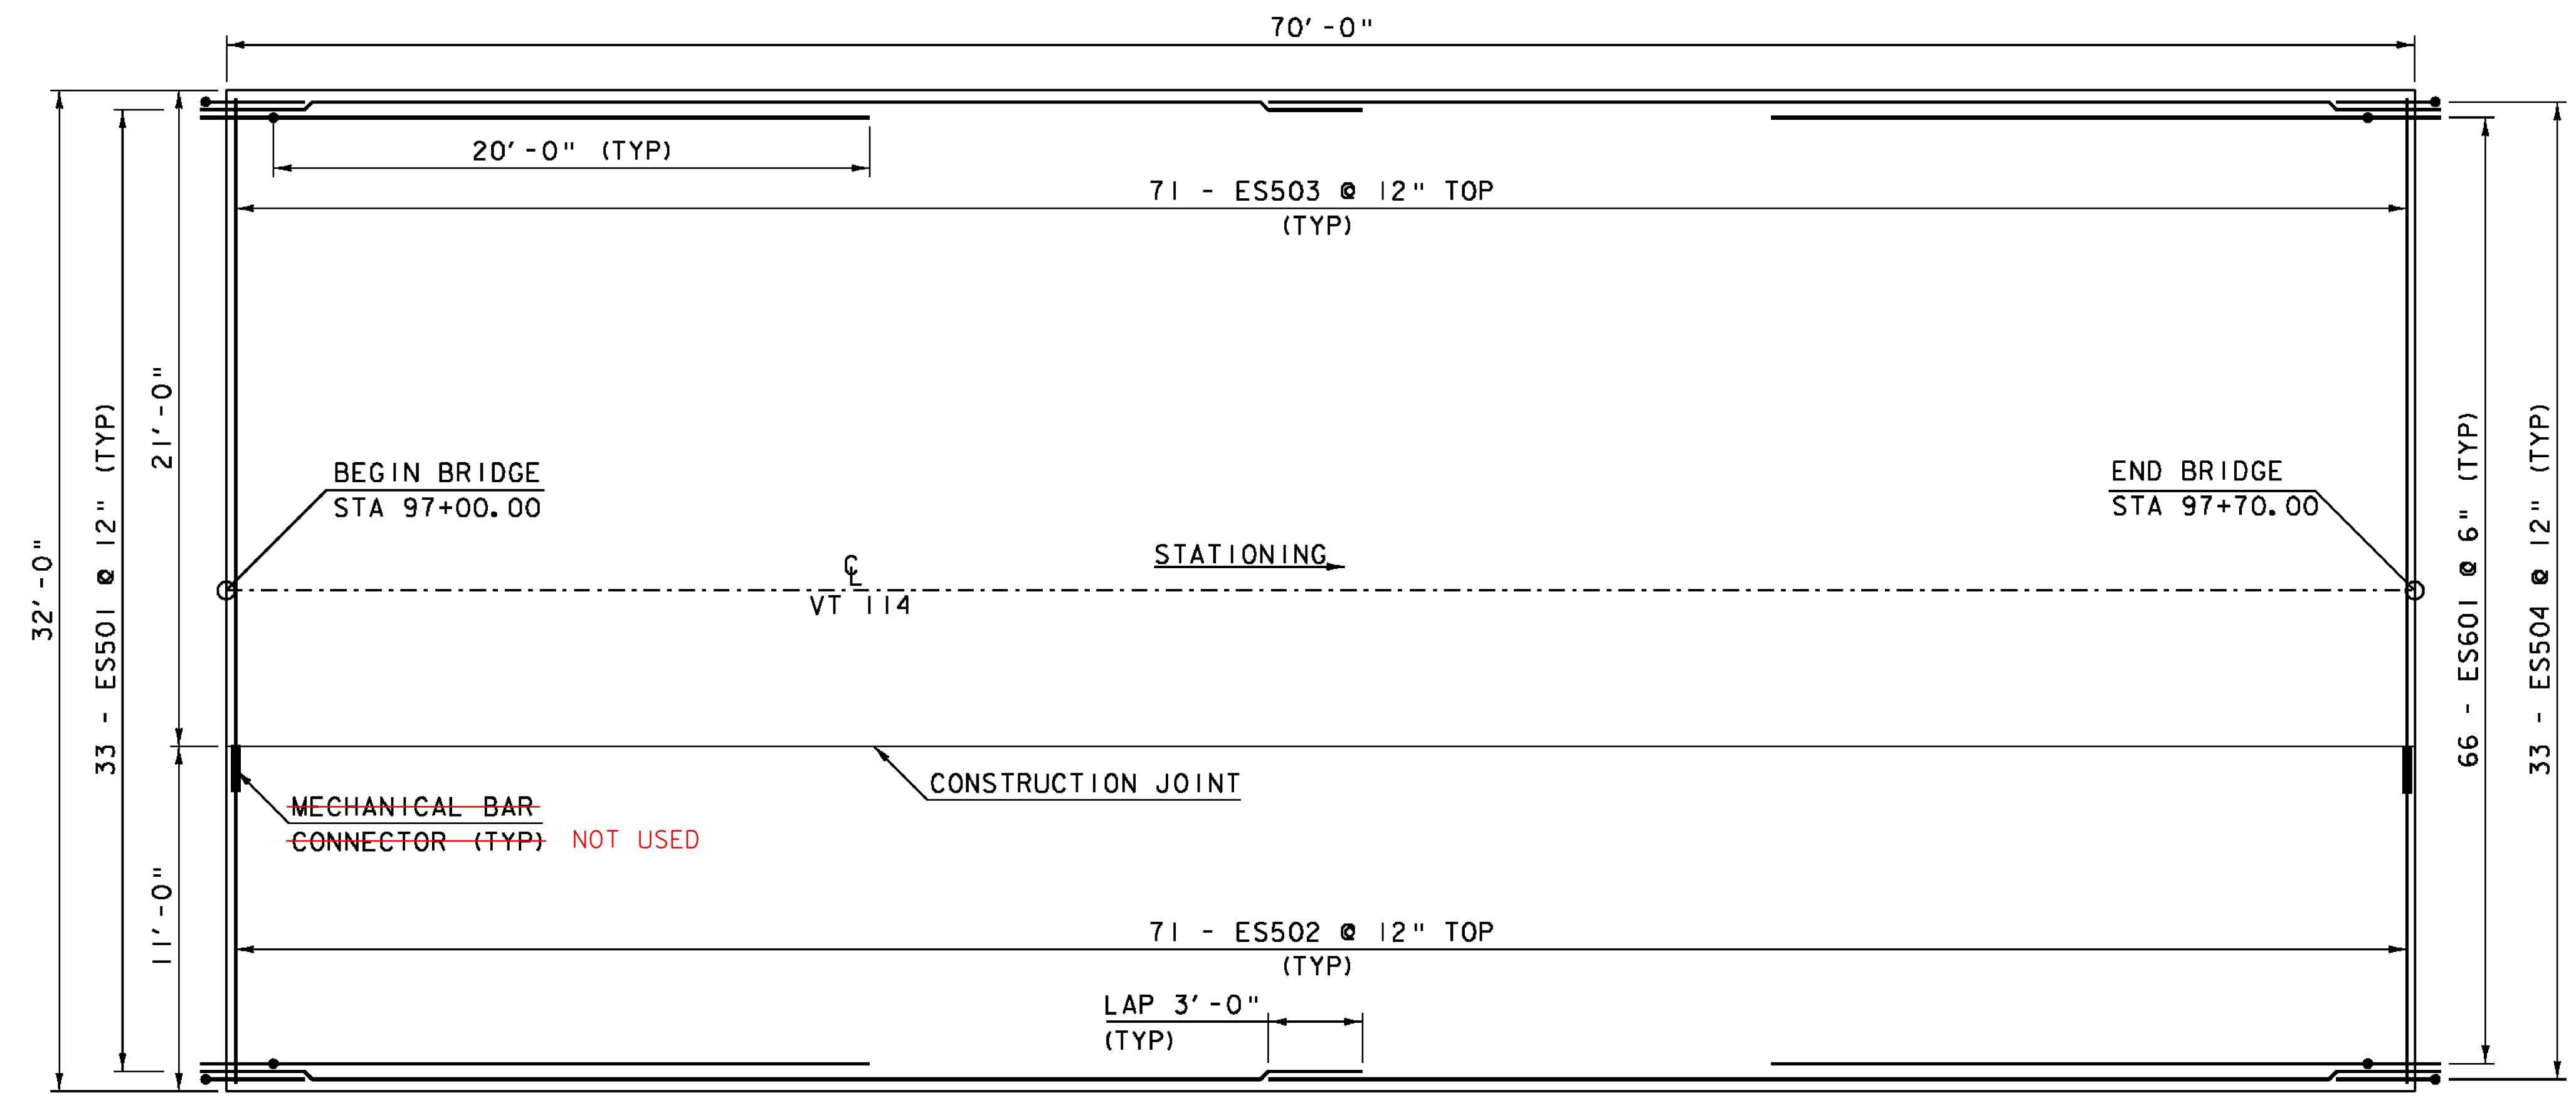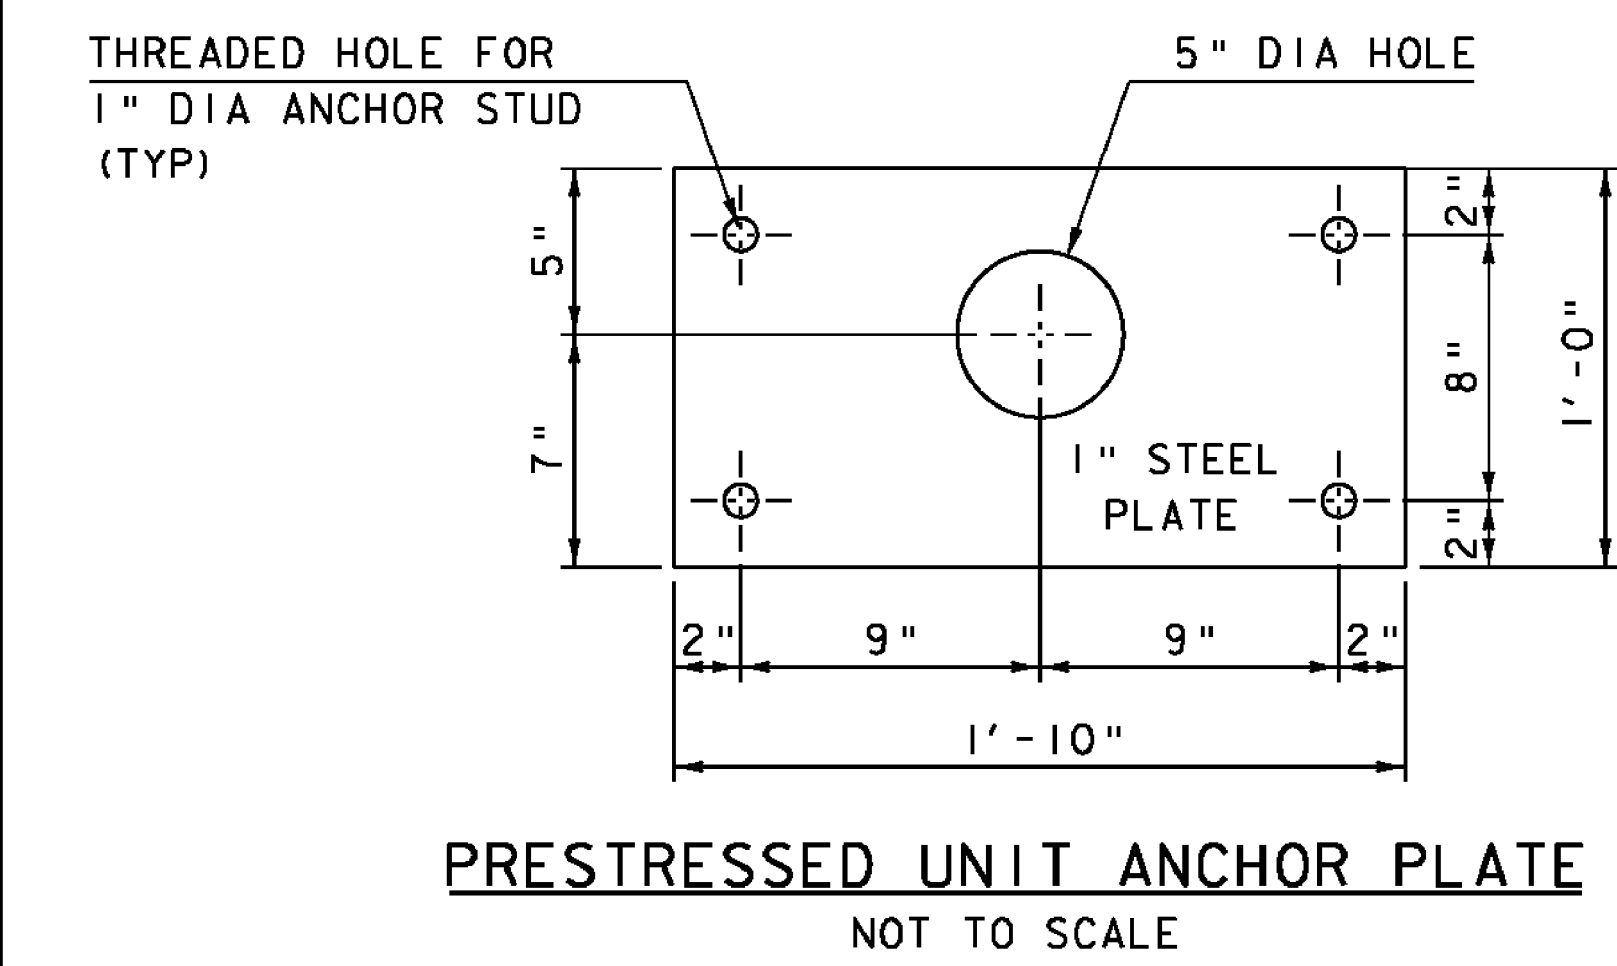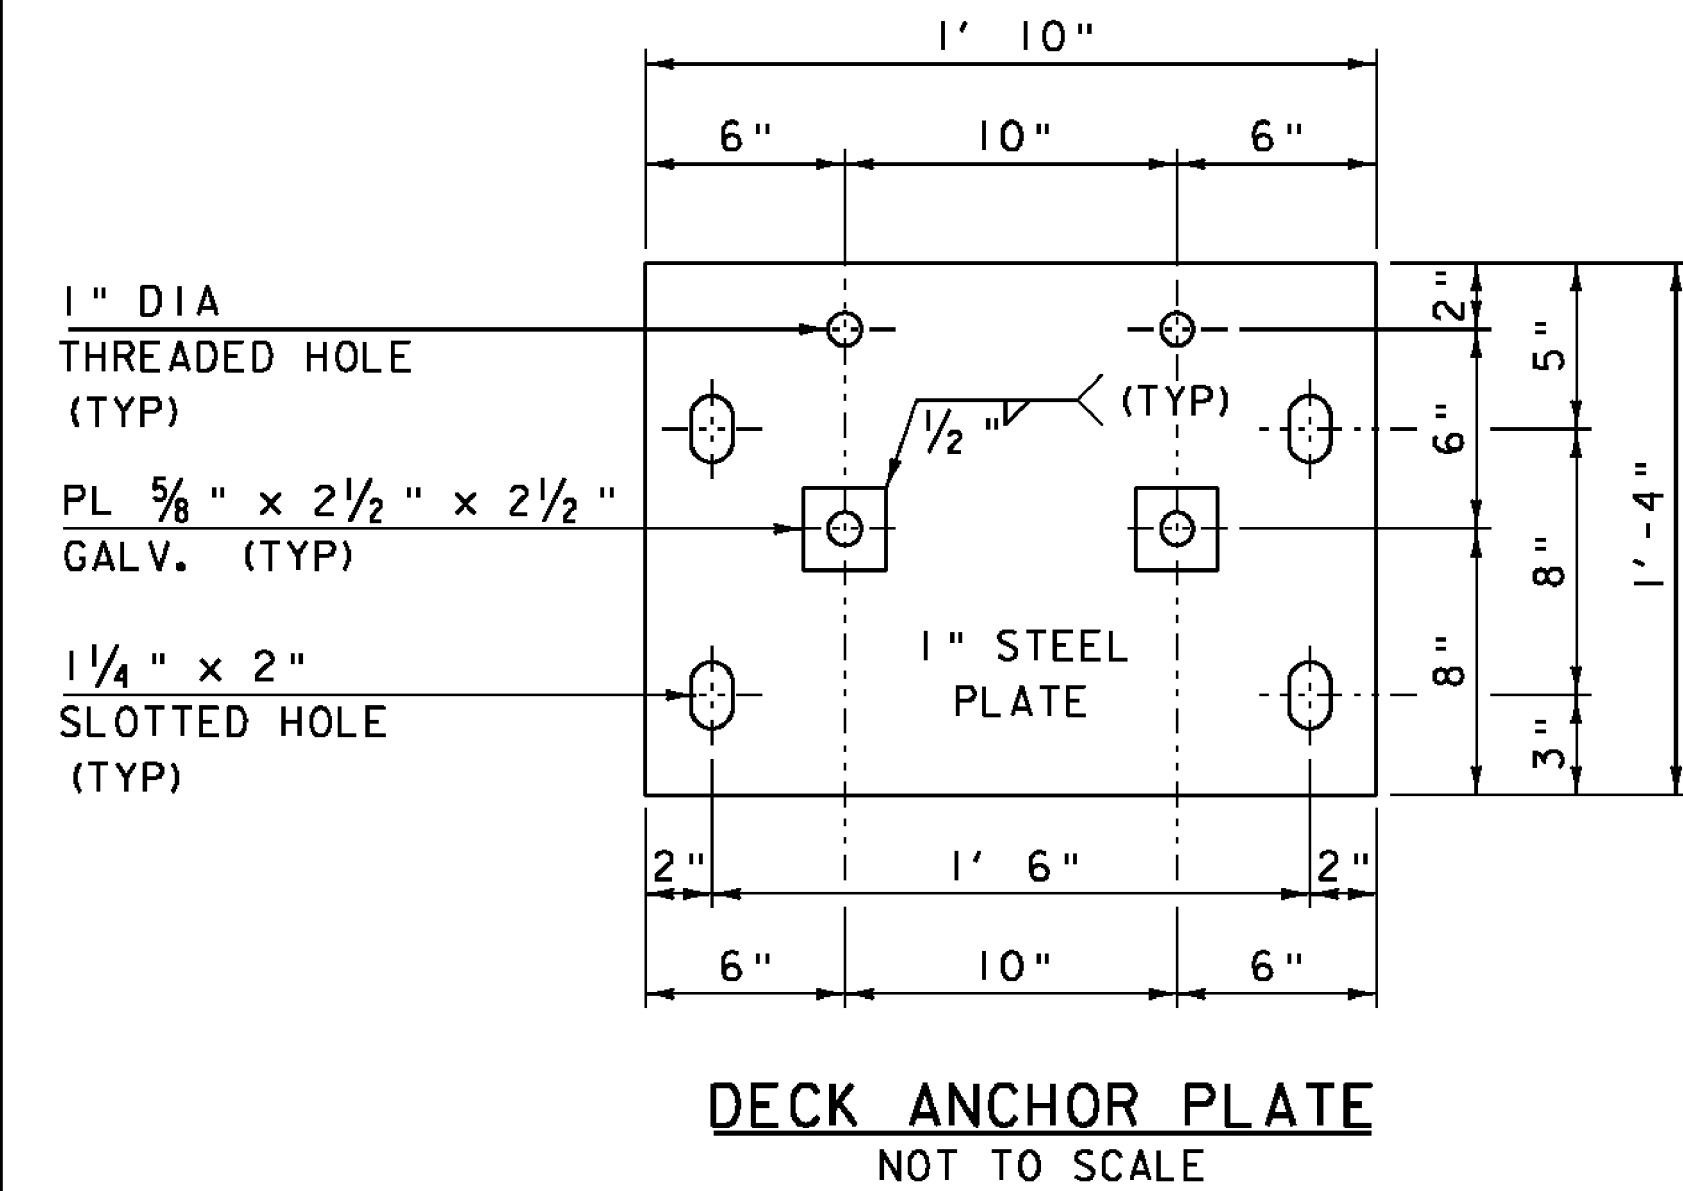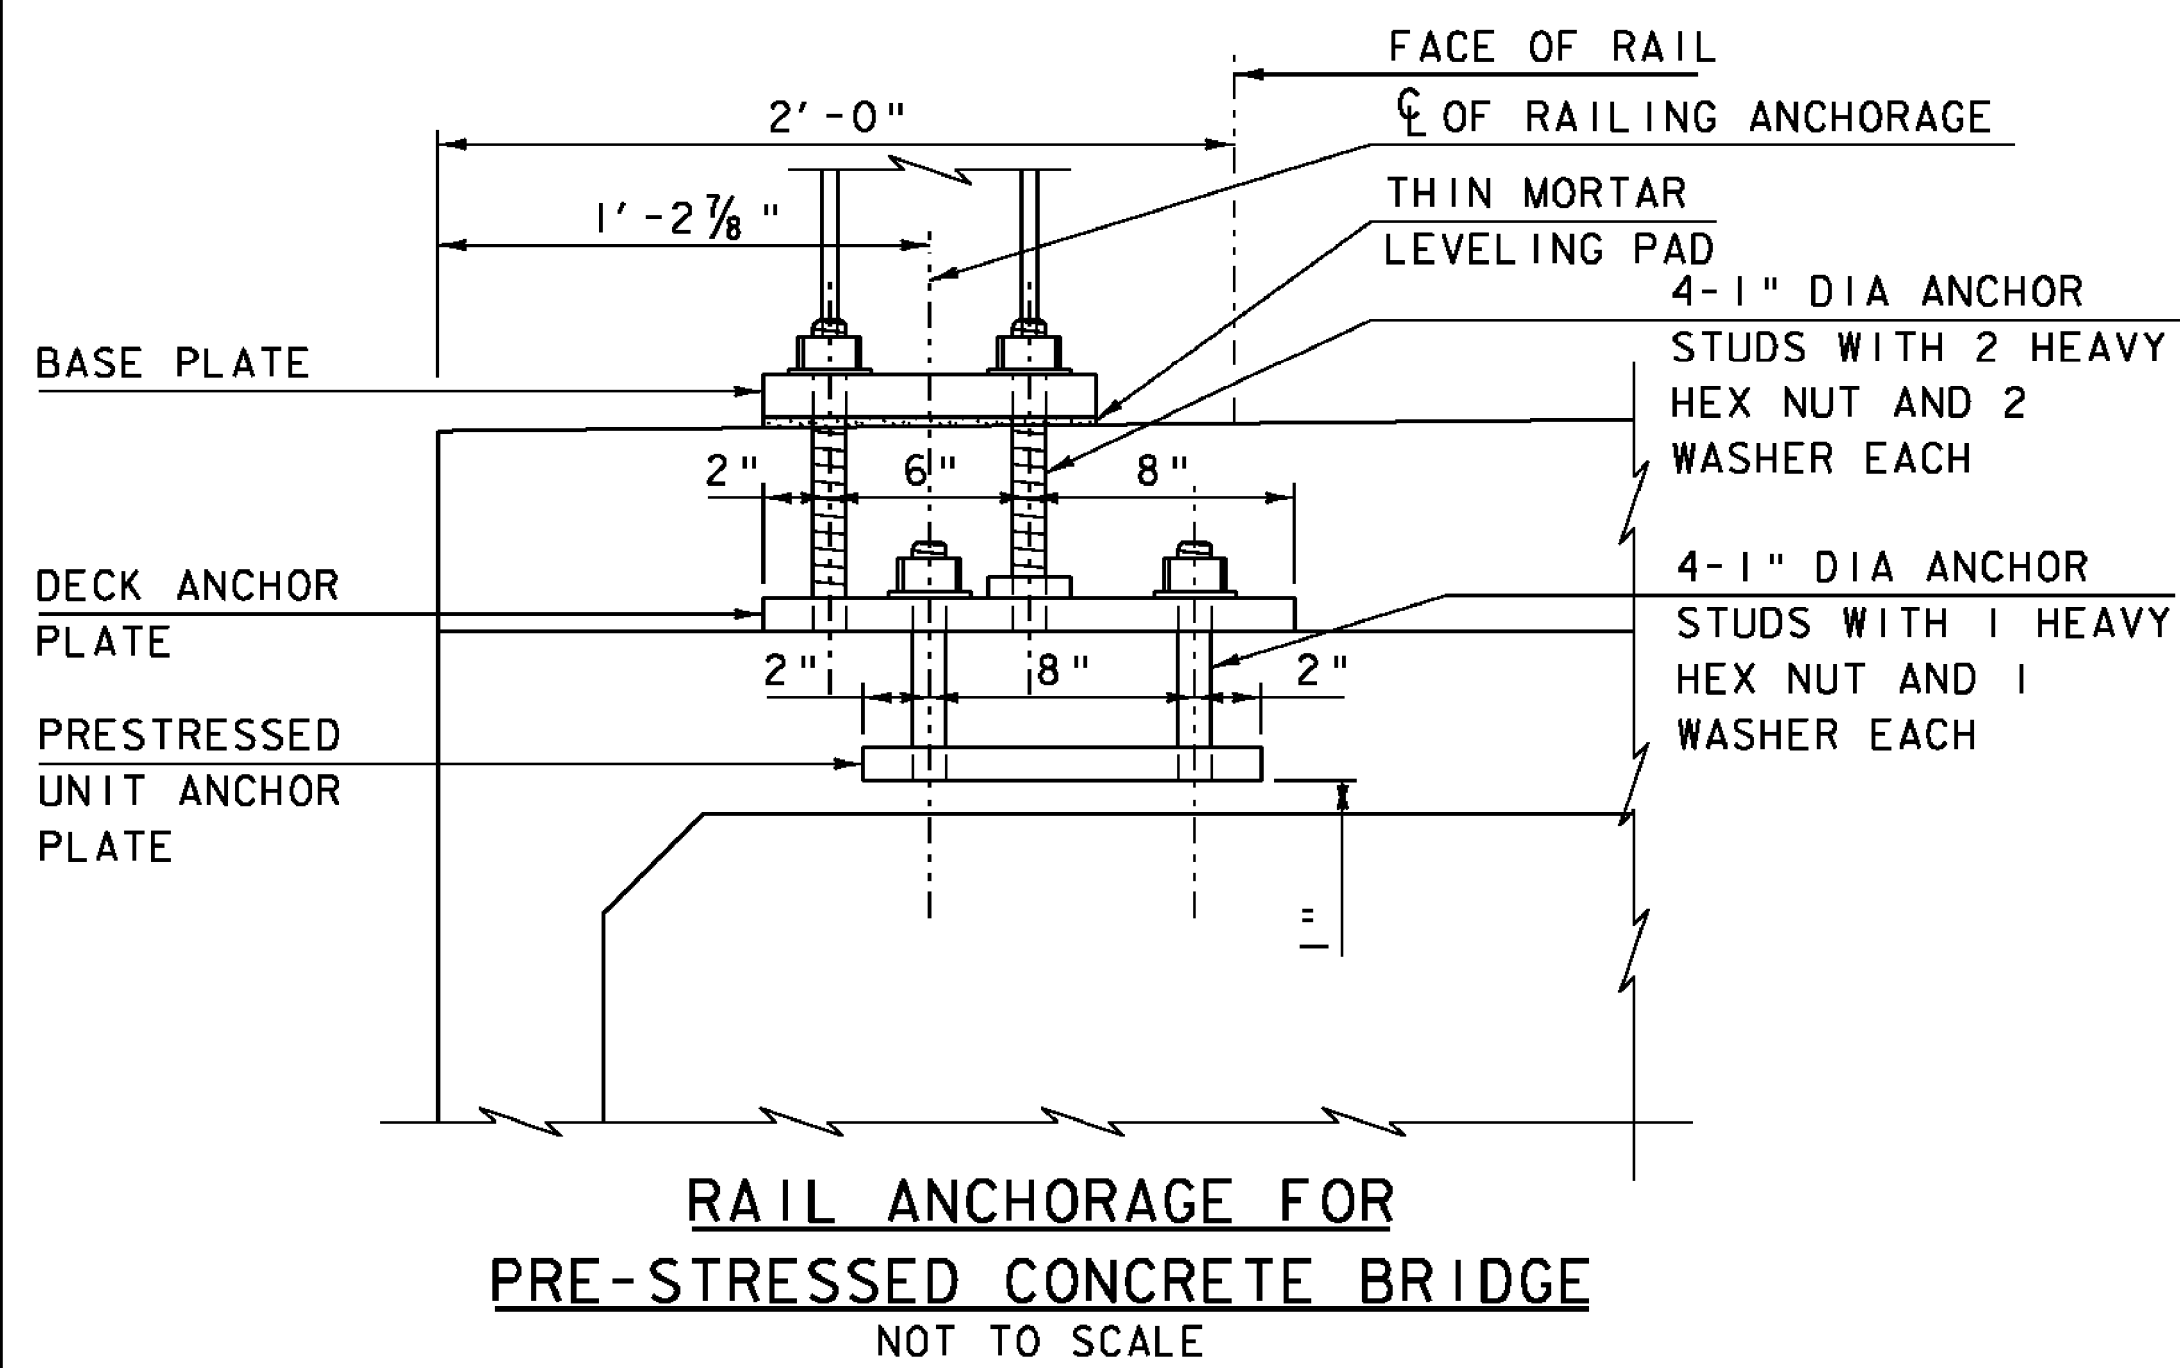


- NOTES:**
1. THE COST OF DECK ANCHOR PLATE AND THE RAILING ANCHOR STUDS SHALL BE INCLUDED IN THE BID PRICE BID FOR THE BRIDGE RAILING
 2. THE COST OF ANCHOR PLATE AND STUDS CAST INTO PRESTRESSED CONCRETE UNITS SHALL BE INCLUDED IN THE BID PRICE BID FOR THE PRESTRESSED UNIT.
 3. SEE STANDARD S-364A FOR BRIDGE RAIL DETAILS ABOVE THE TOP OF THE OVERLAY.

- NOTE:**
- NF = NEAR FACE
 - FF = FAR FACE
 - EF = EACH FACE
 - ▲ = CUT TO FIT IN FIELD
 - 3" CLEAR, UNLESS OTHERWISE SPECIFIED ON THE PLANS.
 - 3'-0" BAR LAP UNLESS OTHERWISE SPECIFIED ON THE PLANS.
 - E - EPOXY


PROJECT NAME: EAST HAVEN	PLOT DATE: 17-AUG-2011
PROJECT NUMBER: BRP 0269(II)	DRAWN BY: J. GRIFFIN
FILE NAME: s00cl62sup.dgn	CHECKED BY: J. LACROIX
PROJECT LEADER: K. HIGGINS	SHEET 21 OF 40
DESIGNED BY: J. GRIFFIN	
SUPERSTRUCTURE REINFORCING I	

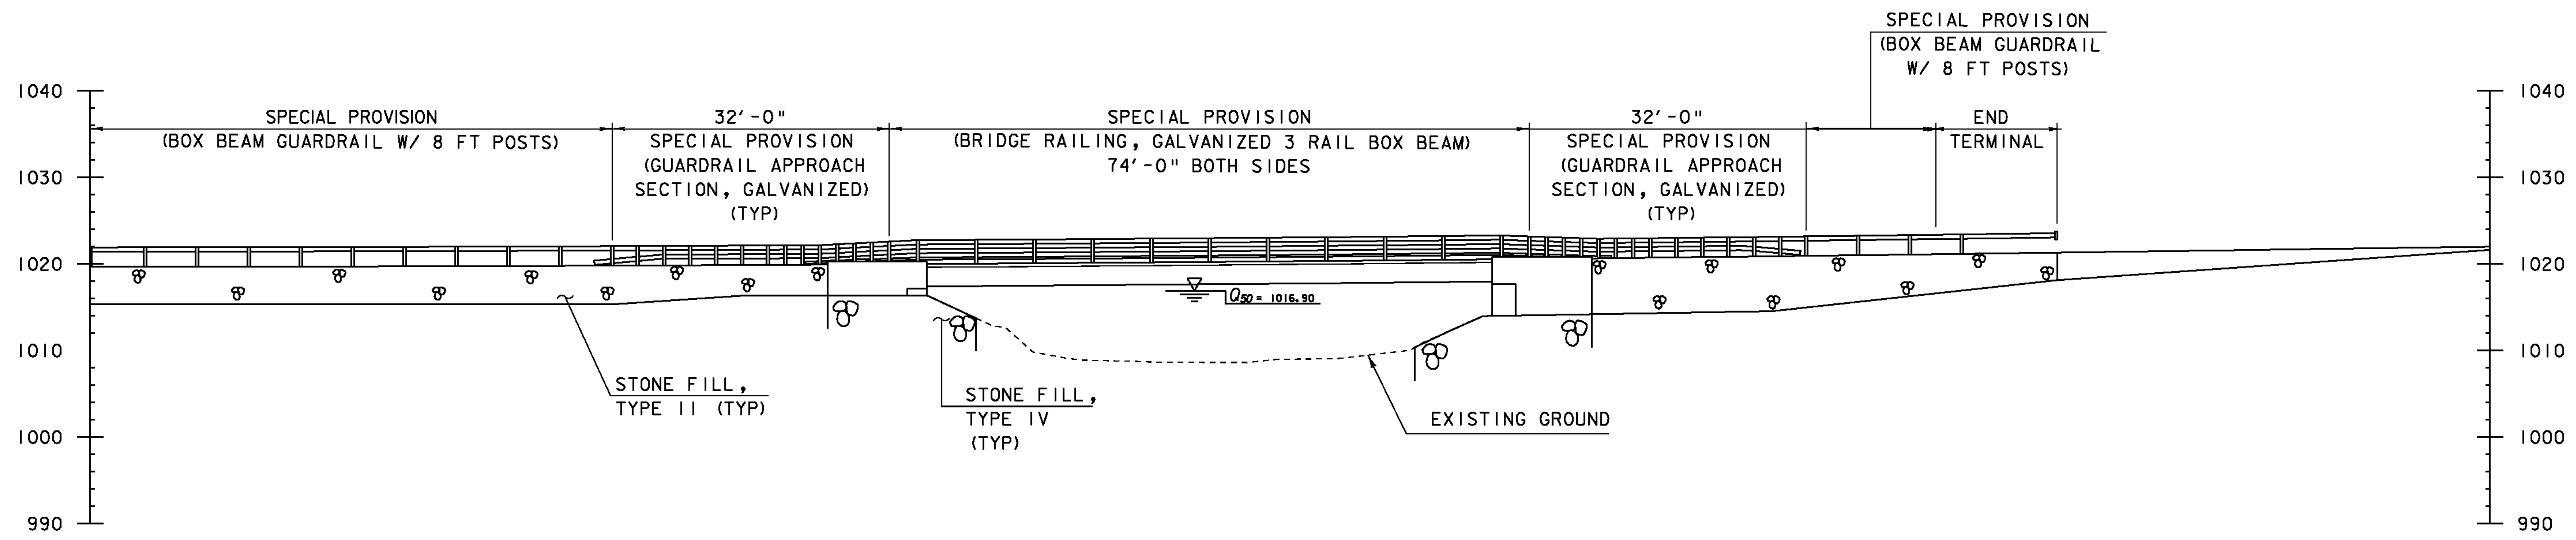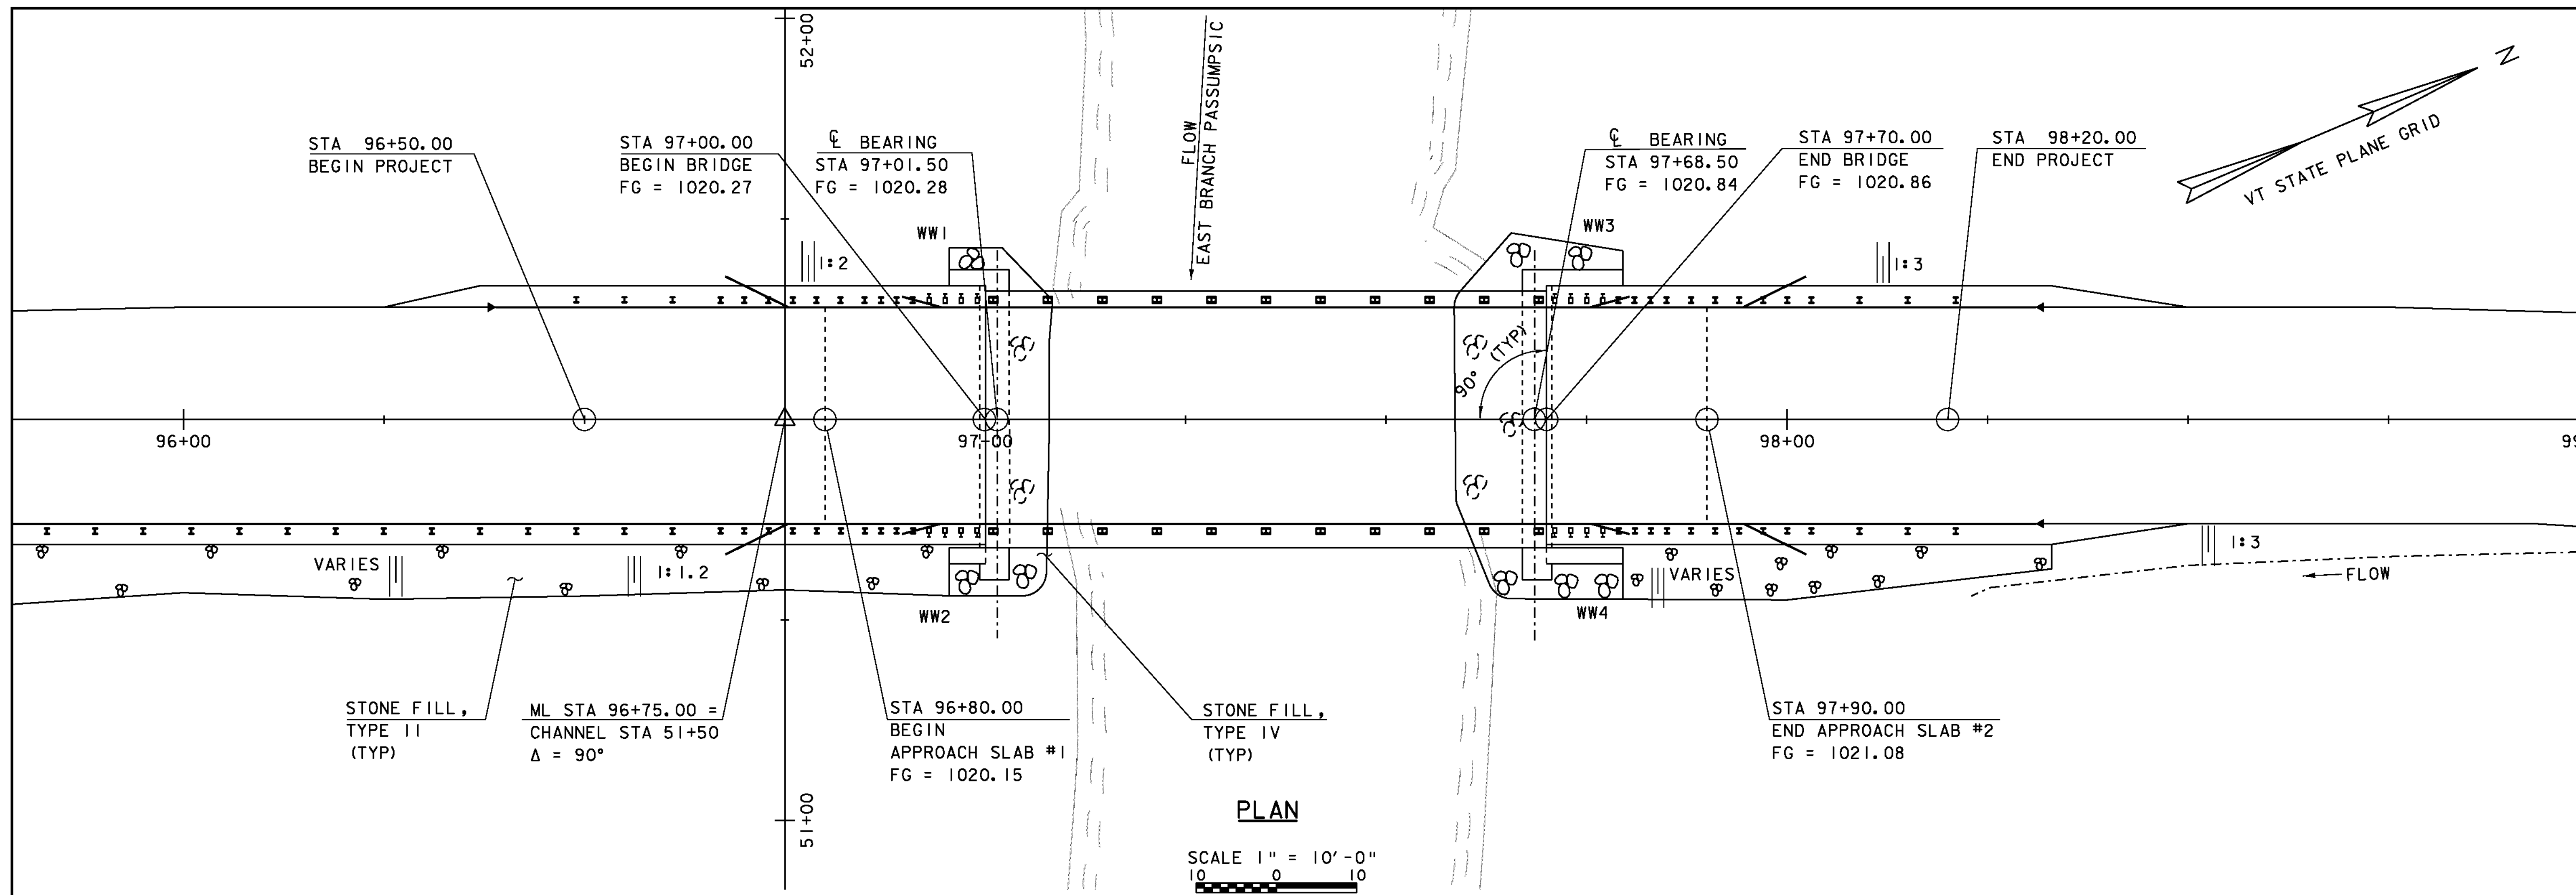


PROJECT NAME: EAST HAVEN	PLOT DATE: 08-AUG-2011
PROJECT NUMBER: BRF 0269(II)	DRAWN BY: R. PELLET
FILE NAME: s00cl62pe.dgn	CHECKED BY: J. LACROIX
PROJECT LEADER: K. HIGGINS	SHEET 19 OF 40
DESIGNED BY: J. LACROIX	
PLAN & ELEVATION	

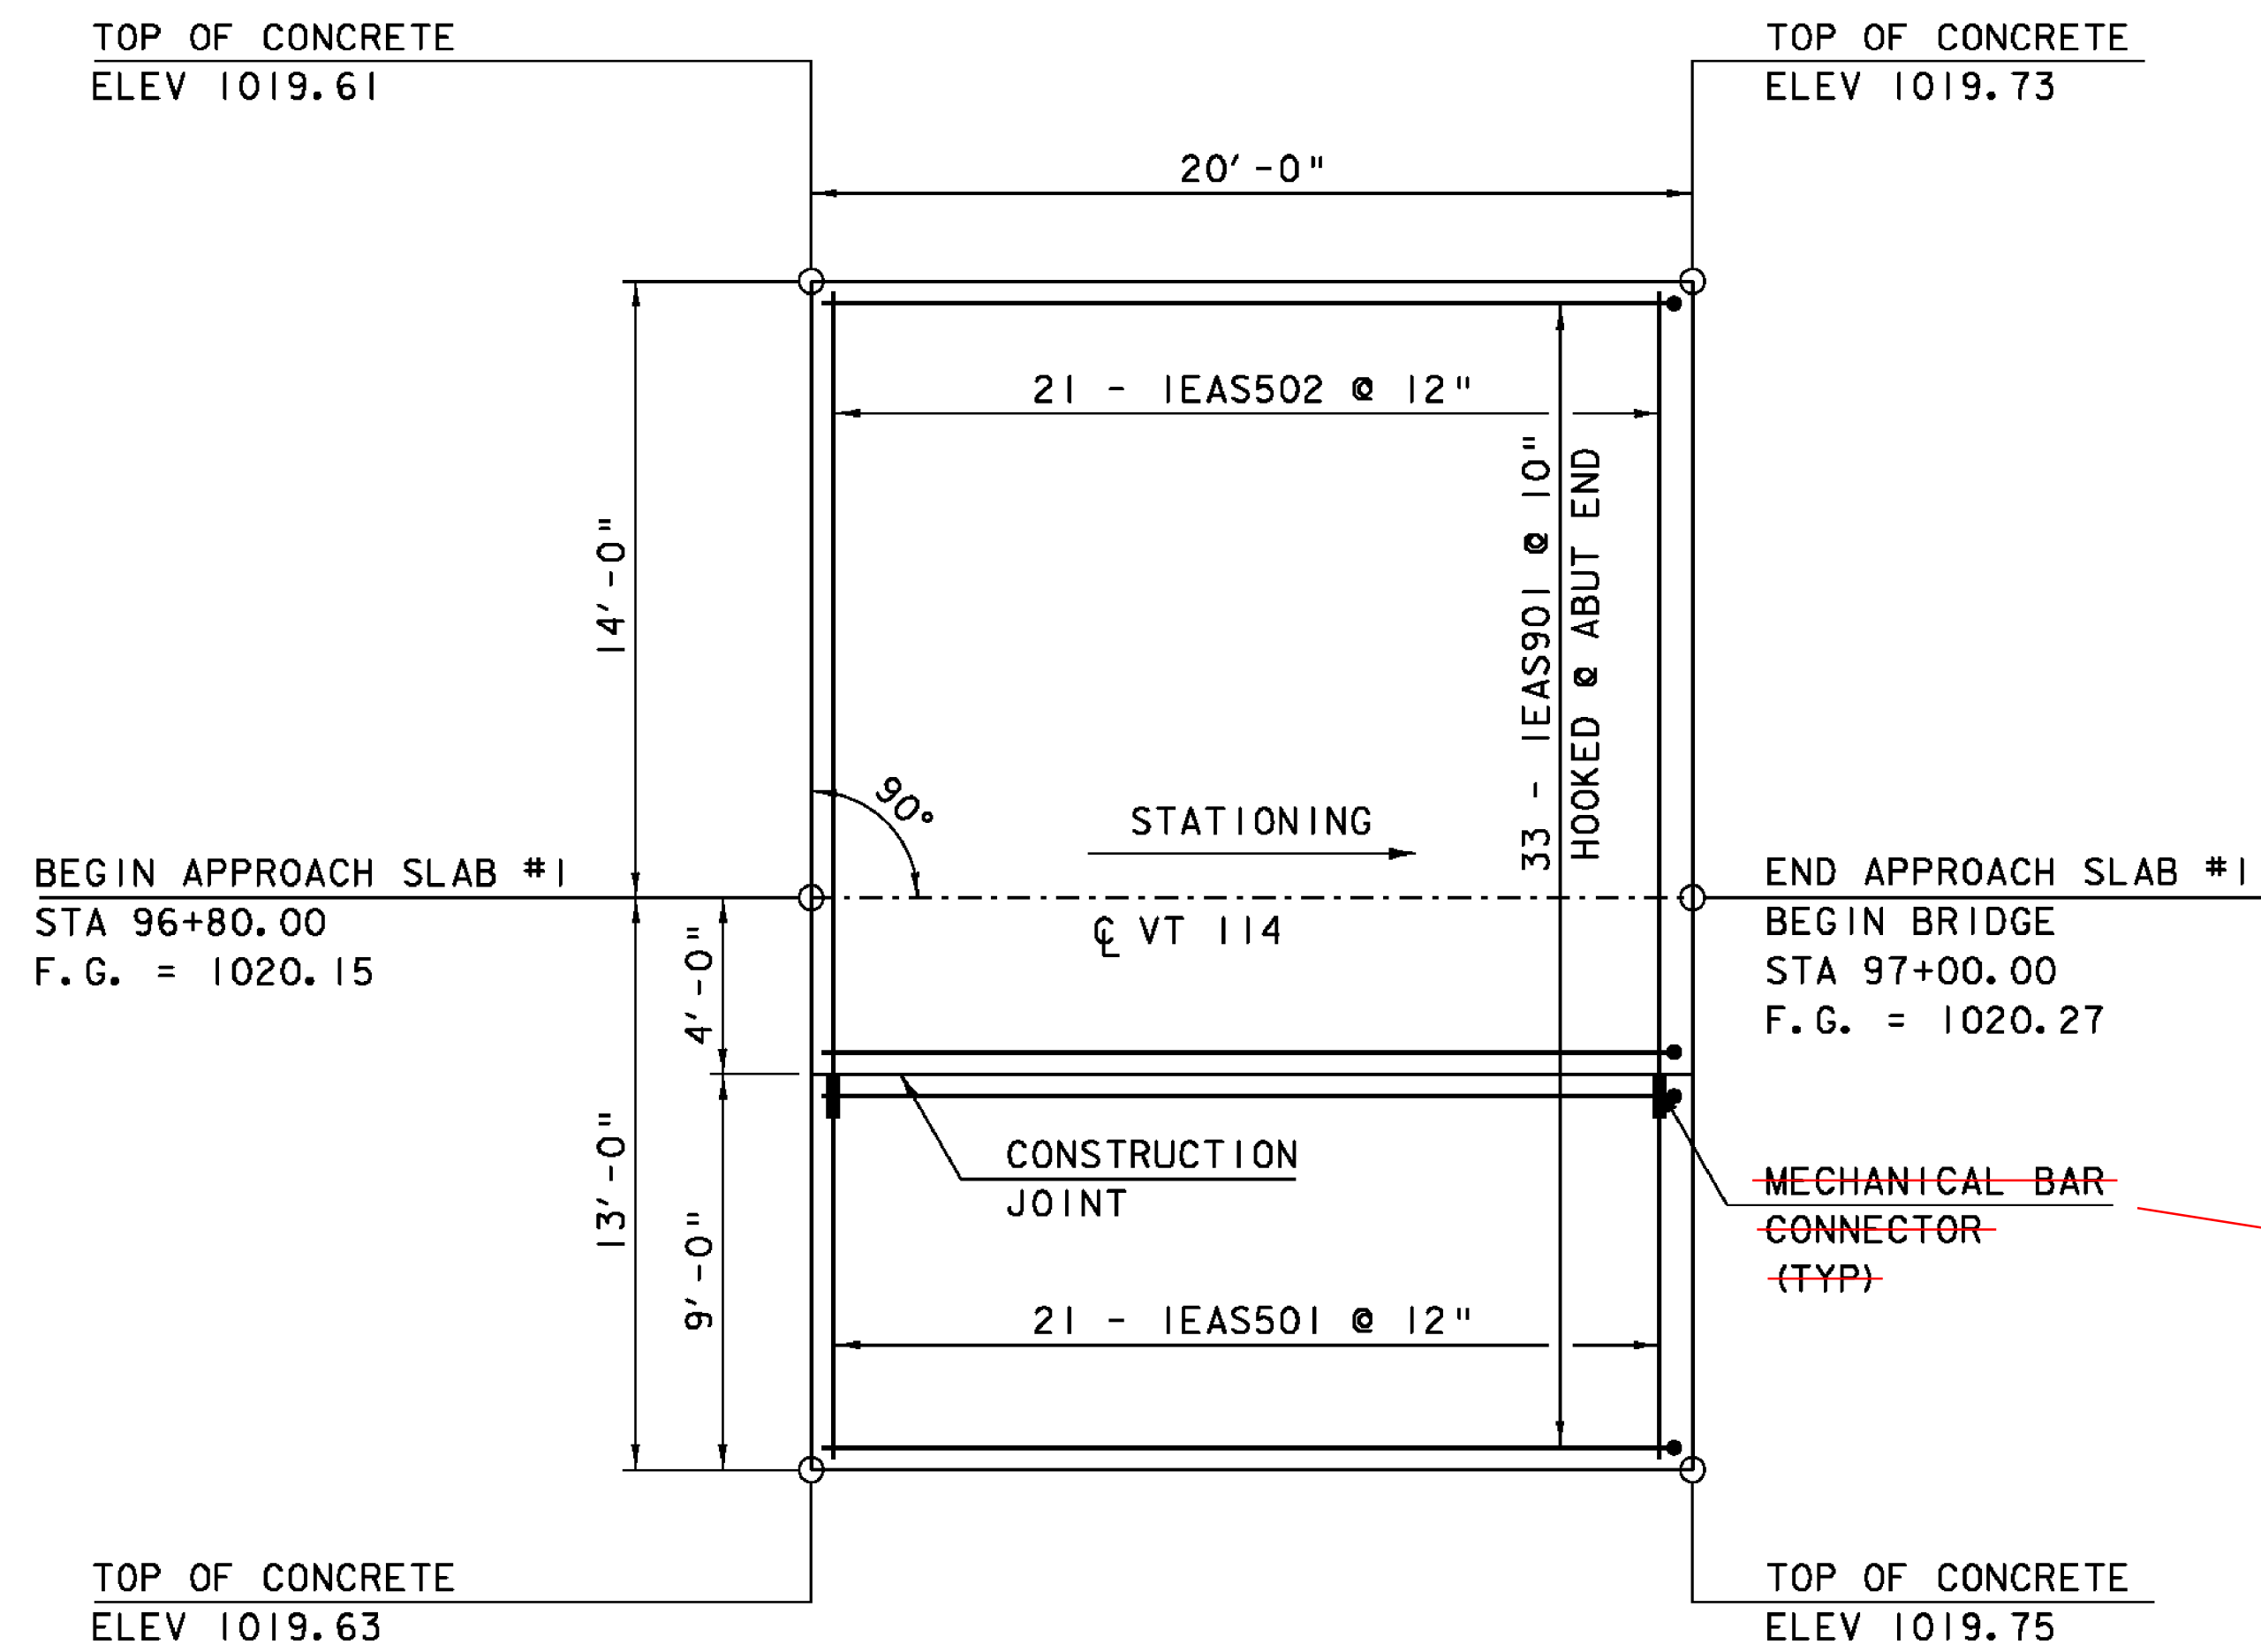

APPROACH SLAB #1 PLAN
SCALE 1/4" = 1'-0"

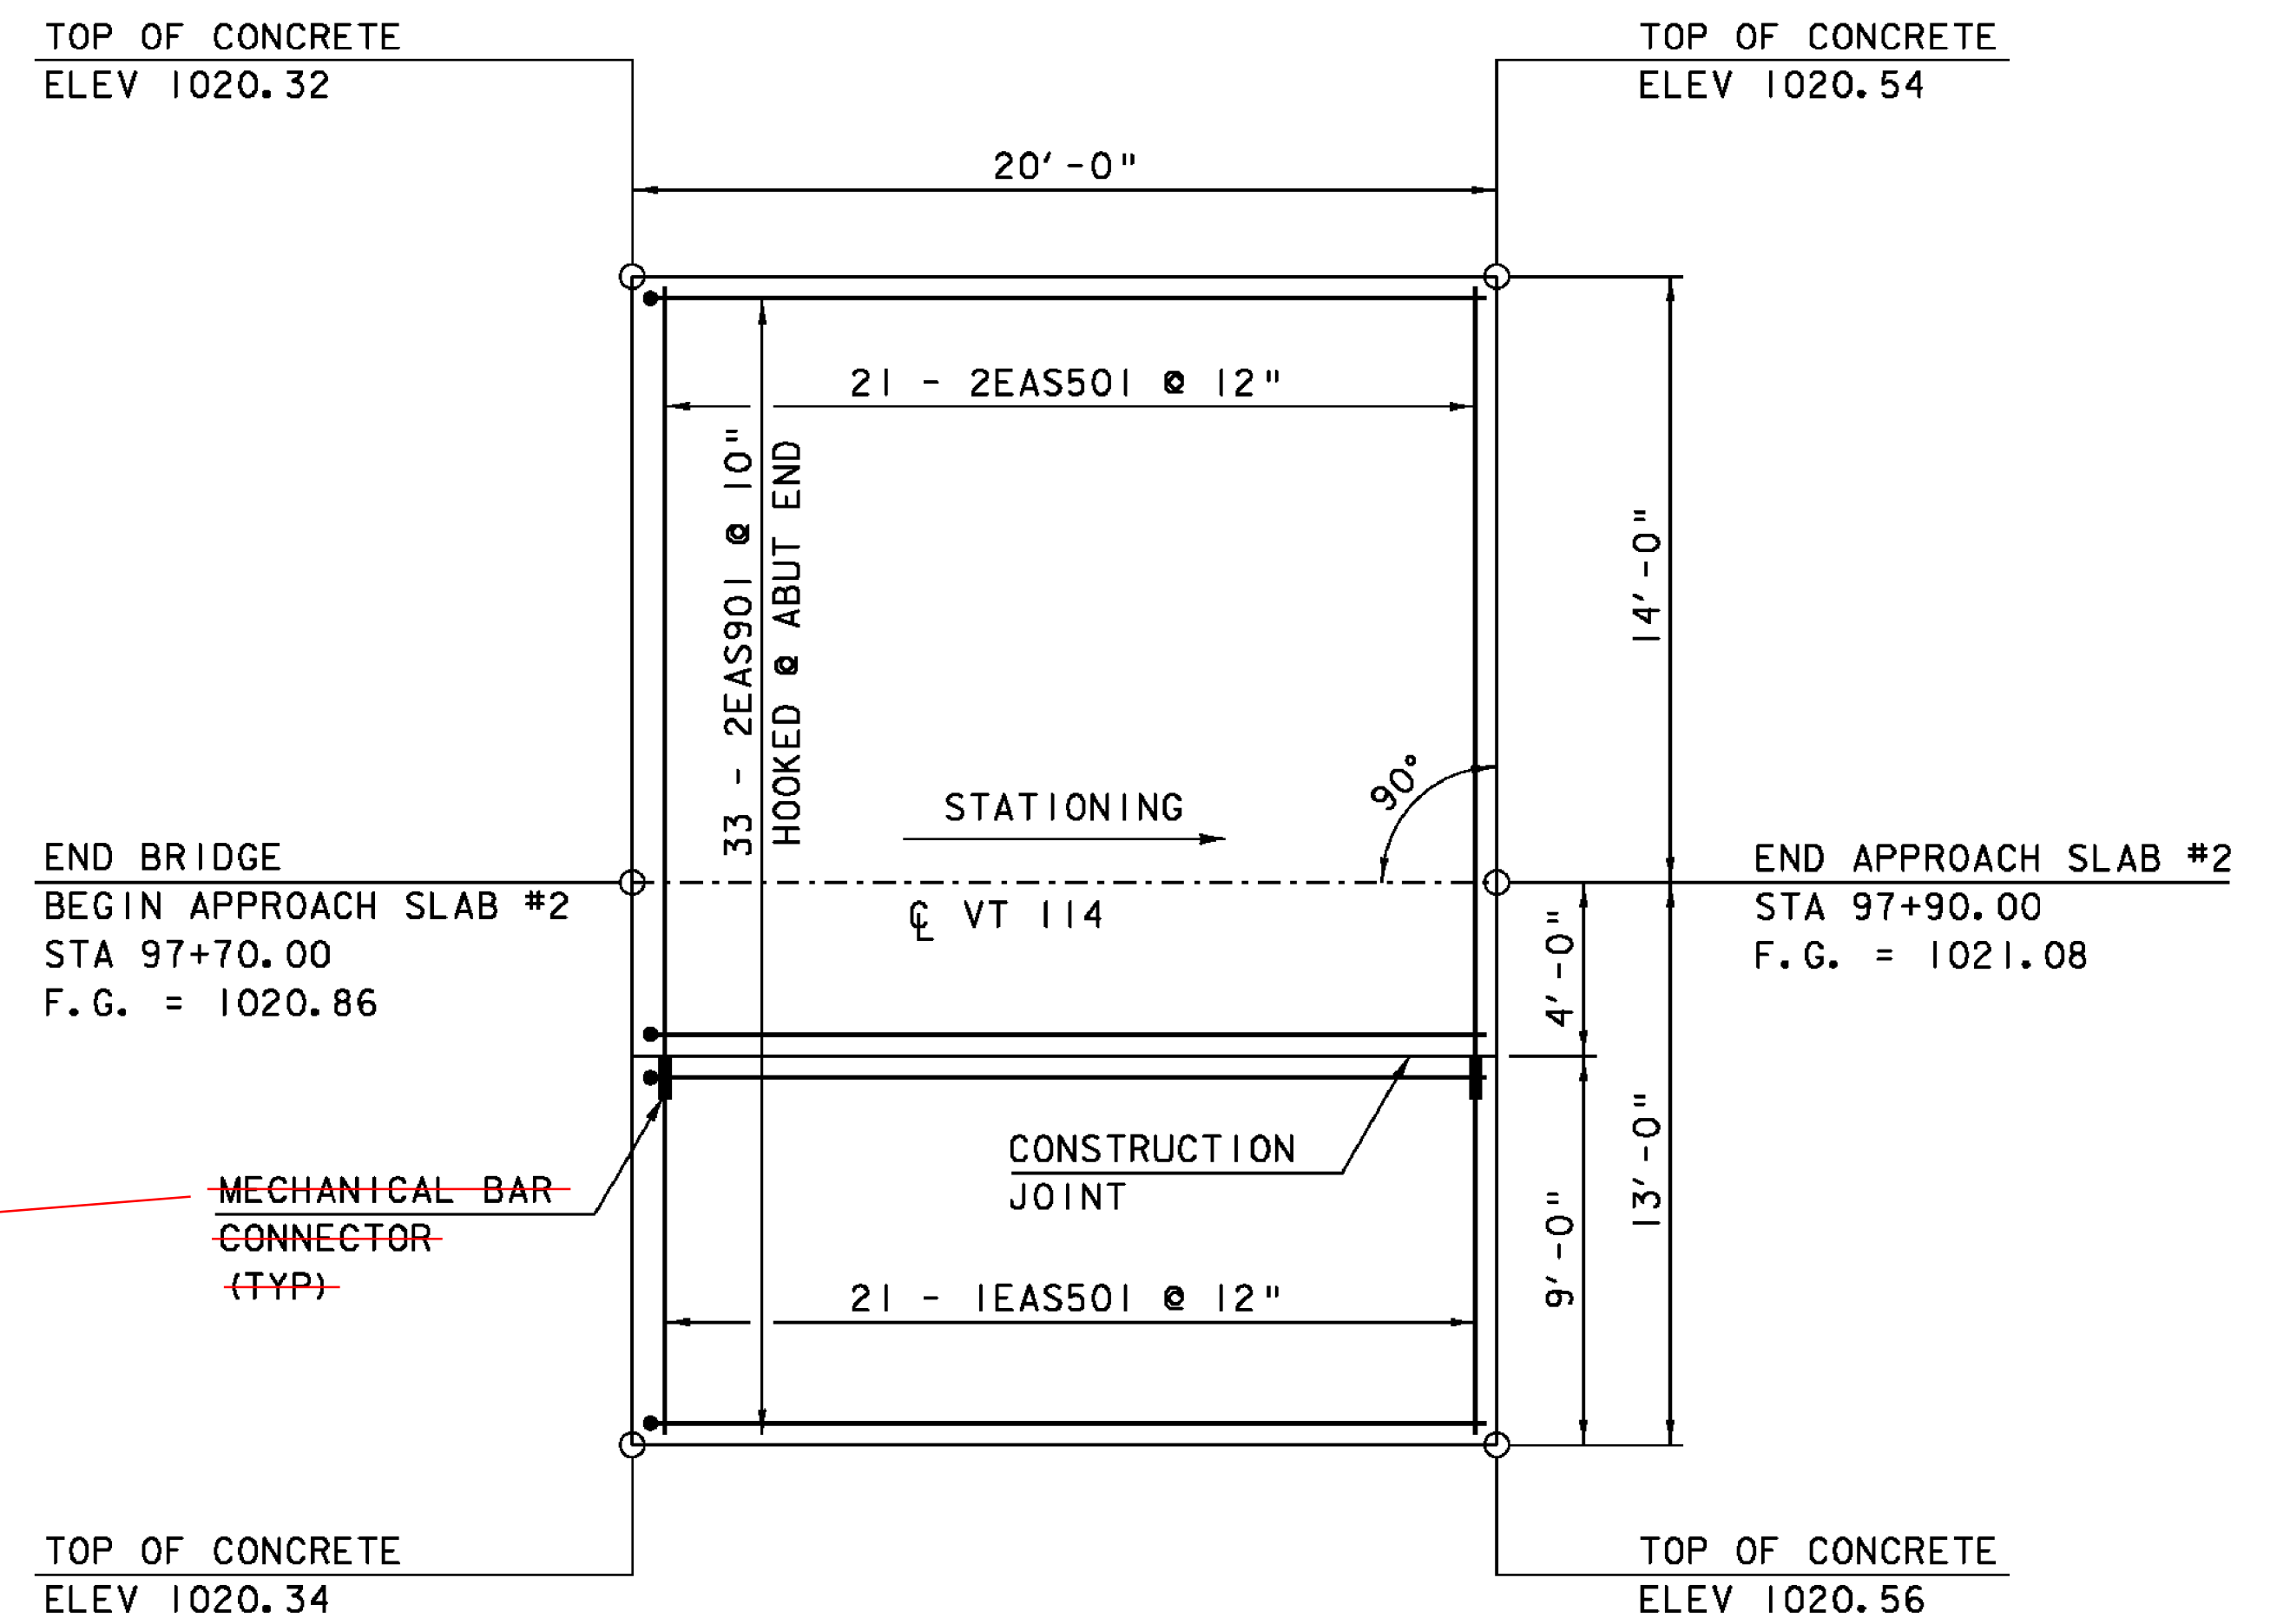


APPROACH SLAB #2 PLAN
SCALE 1/4" = 1'-0"

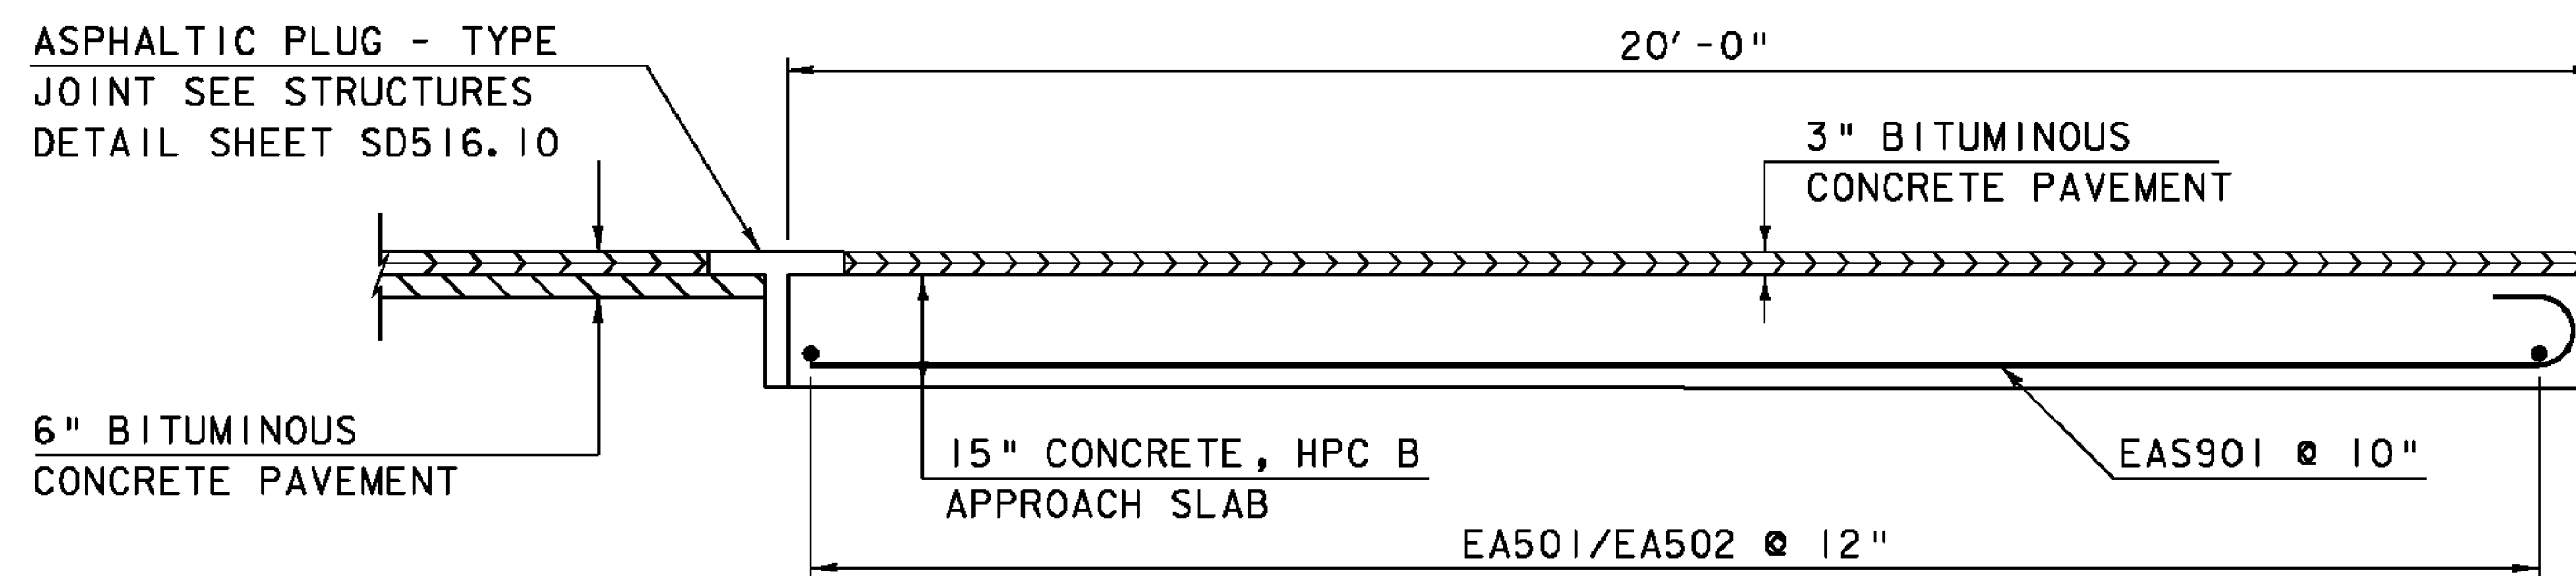

APPROACH SLAB ELEVATION (TYP)
SCALE 1/2" = 1'-0"


NOTE:
 E = EPOXY COATED REINFORCING
 NF = NEAR FACE
 FF = FAR FACE
 EF = EACH FACE
 ▲ = CUT TO FIT IN FIELD
 3" CLEAR, UNLESS OTHERWISE SPECIFIED ON THE PLANS.
 3'-0" BAR LAP UNLESS OTHERWISE SPECIFIED ON THE PLANS.

PROJECT NAME:	EAST HAVEN
PROJECT NUMBER:	BRF 0269(II)
FILE NAME:	s00cl62app.dgn
PROJECT LEADER:	K. HIGGINS
DESIGNED BY:	R. PELLETT
APPROACH SLABS	
PLOT DATE:	08-AUG-2011
DRAWN BY:	R. PELLETT
CHECKED BY:	J. GRIFFIN
SHEET	23 OF 40

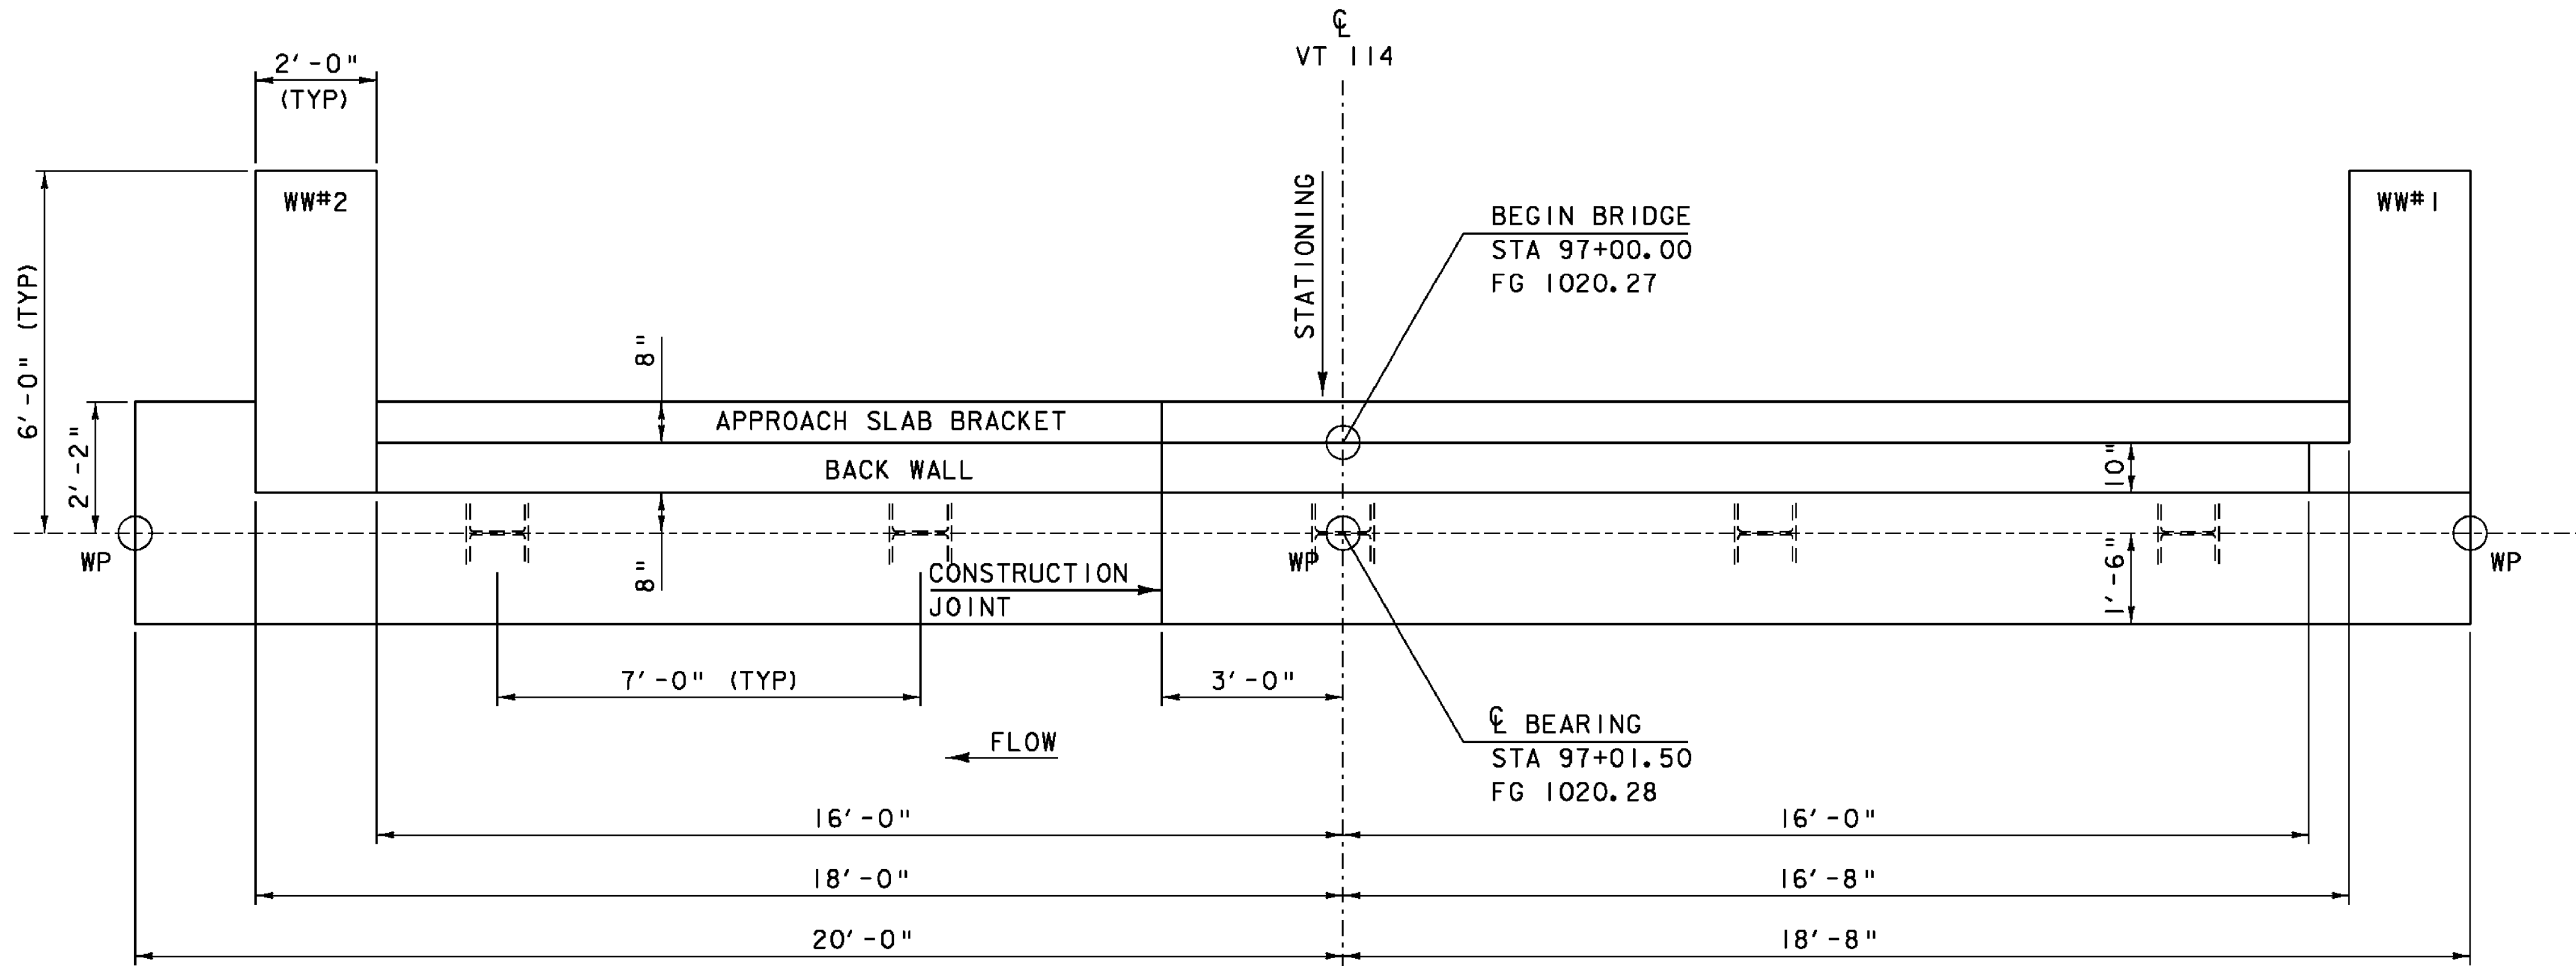

ABUTMENT #1 PLAN VIEW

SCALE 1/2" = 1'-0"
0 1 2

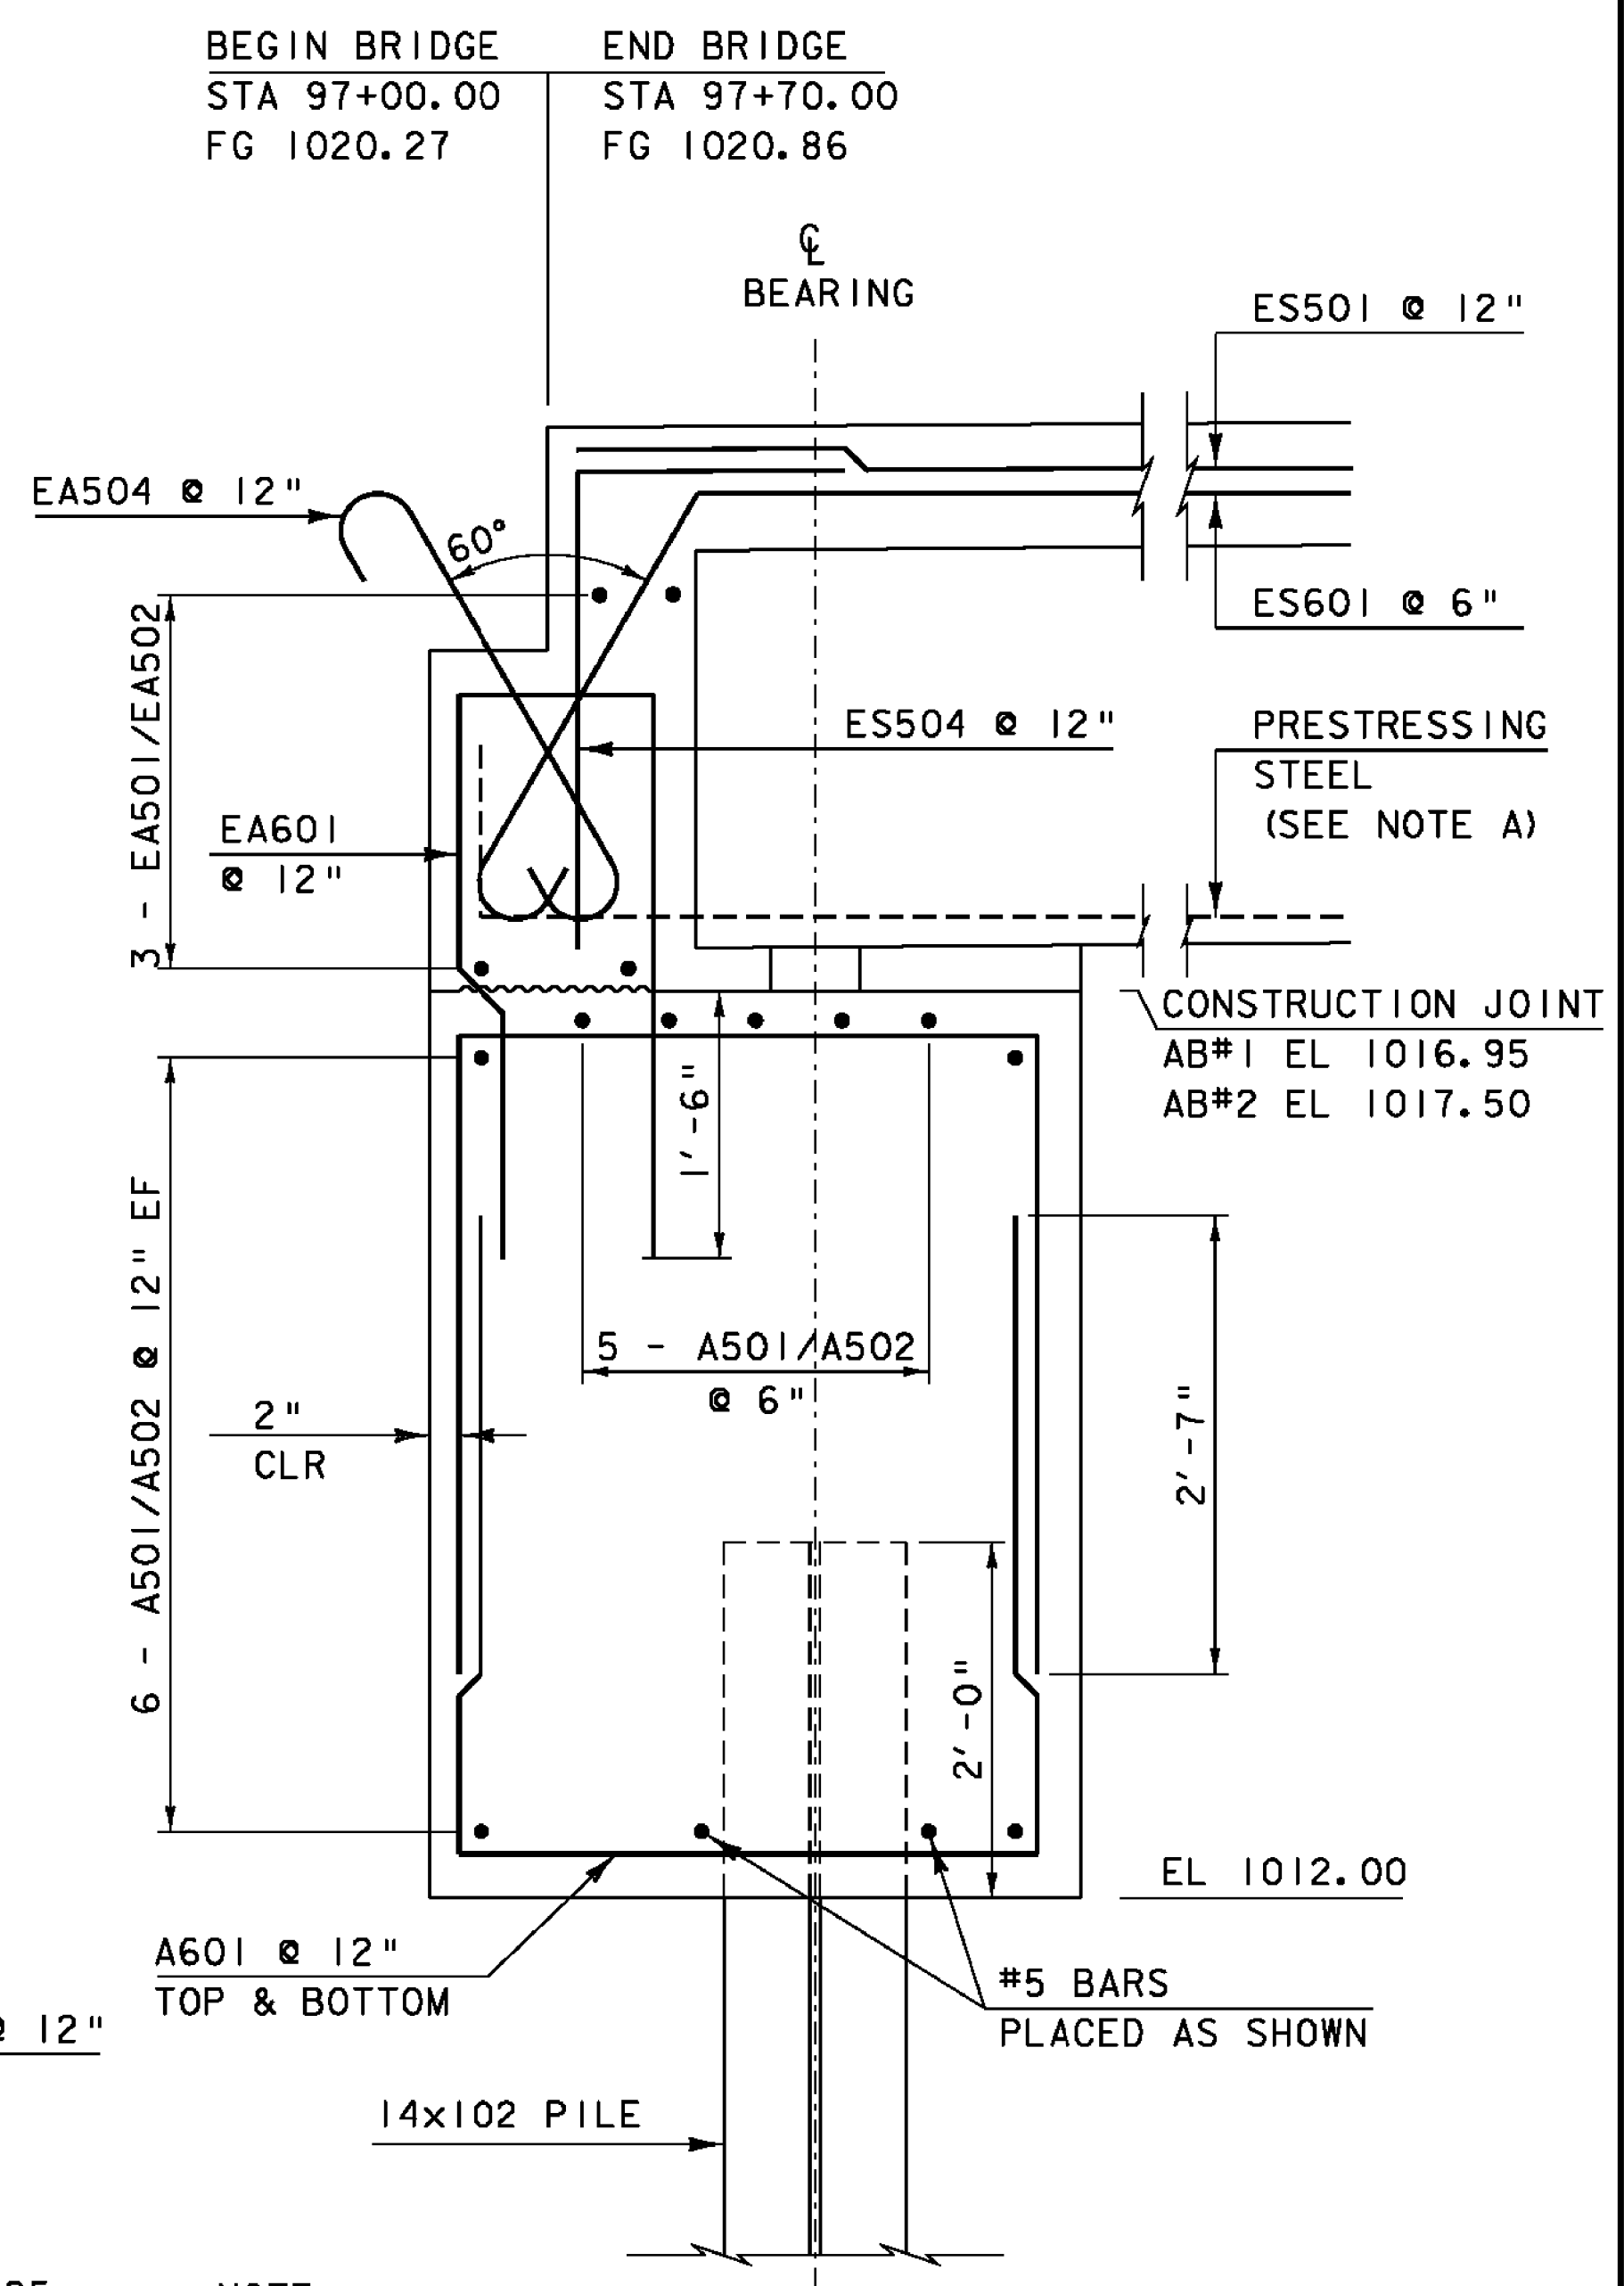


NOTE:
A. EXTEND EVERY OTHER BONDED PRESTRESSED STRANDS ON THE BOTTOM ROW 2'-8". IN LIEU OF EXTENDING THE STRANDS, THE CONTRACTOR MAY PROPOSE AN ALTERNATE DETAIL.

ABUTMENT TYPICAL

SCALE 1" = 1'-0"
0 1 2


NOTE:
NF = NEAR FACE
FF = FAR FACE
EF = EACH FACE
▲ = CUT TO FIT IN FIELD
3" CLEAR, UNLESS OTHERWISE SPECIFIED ON THE PLANS.
2'-2" BAR LAP UNLESS OTHERWISE SPECIFIED ON THE PLANS.

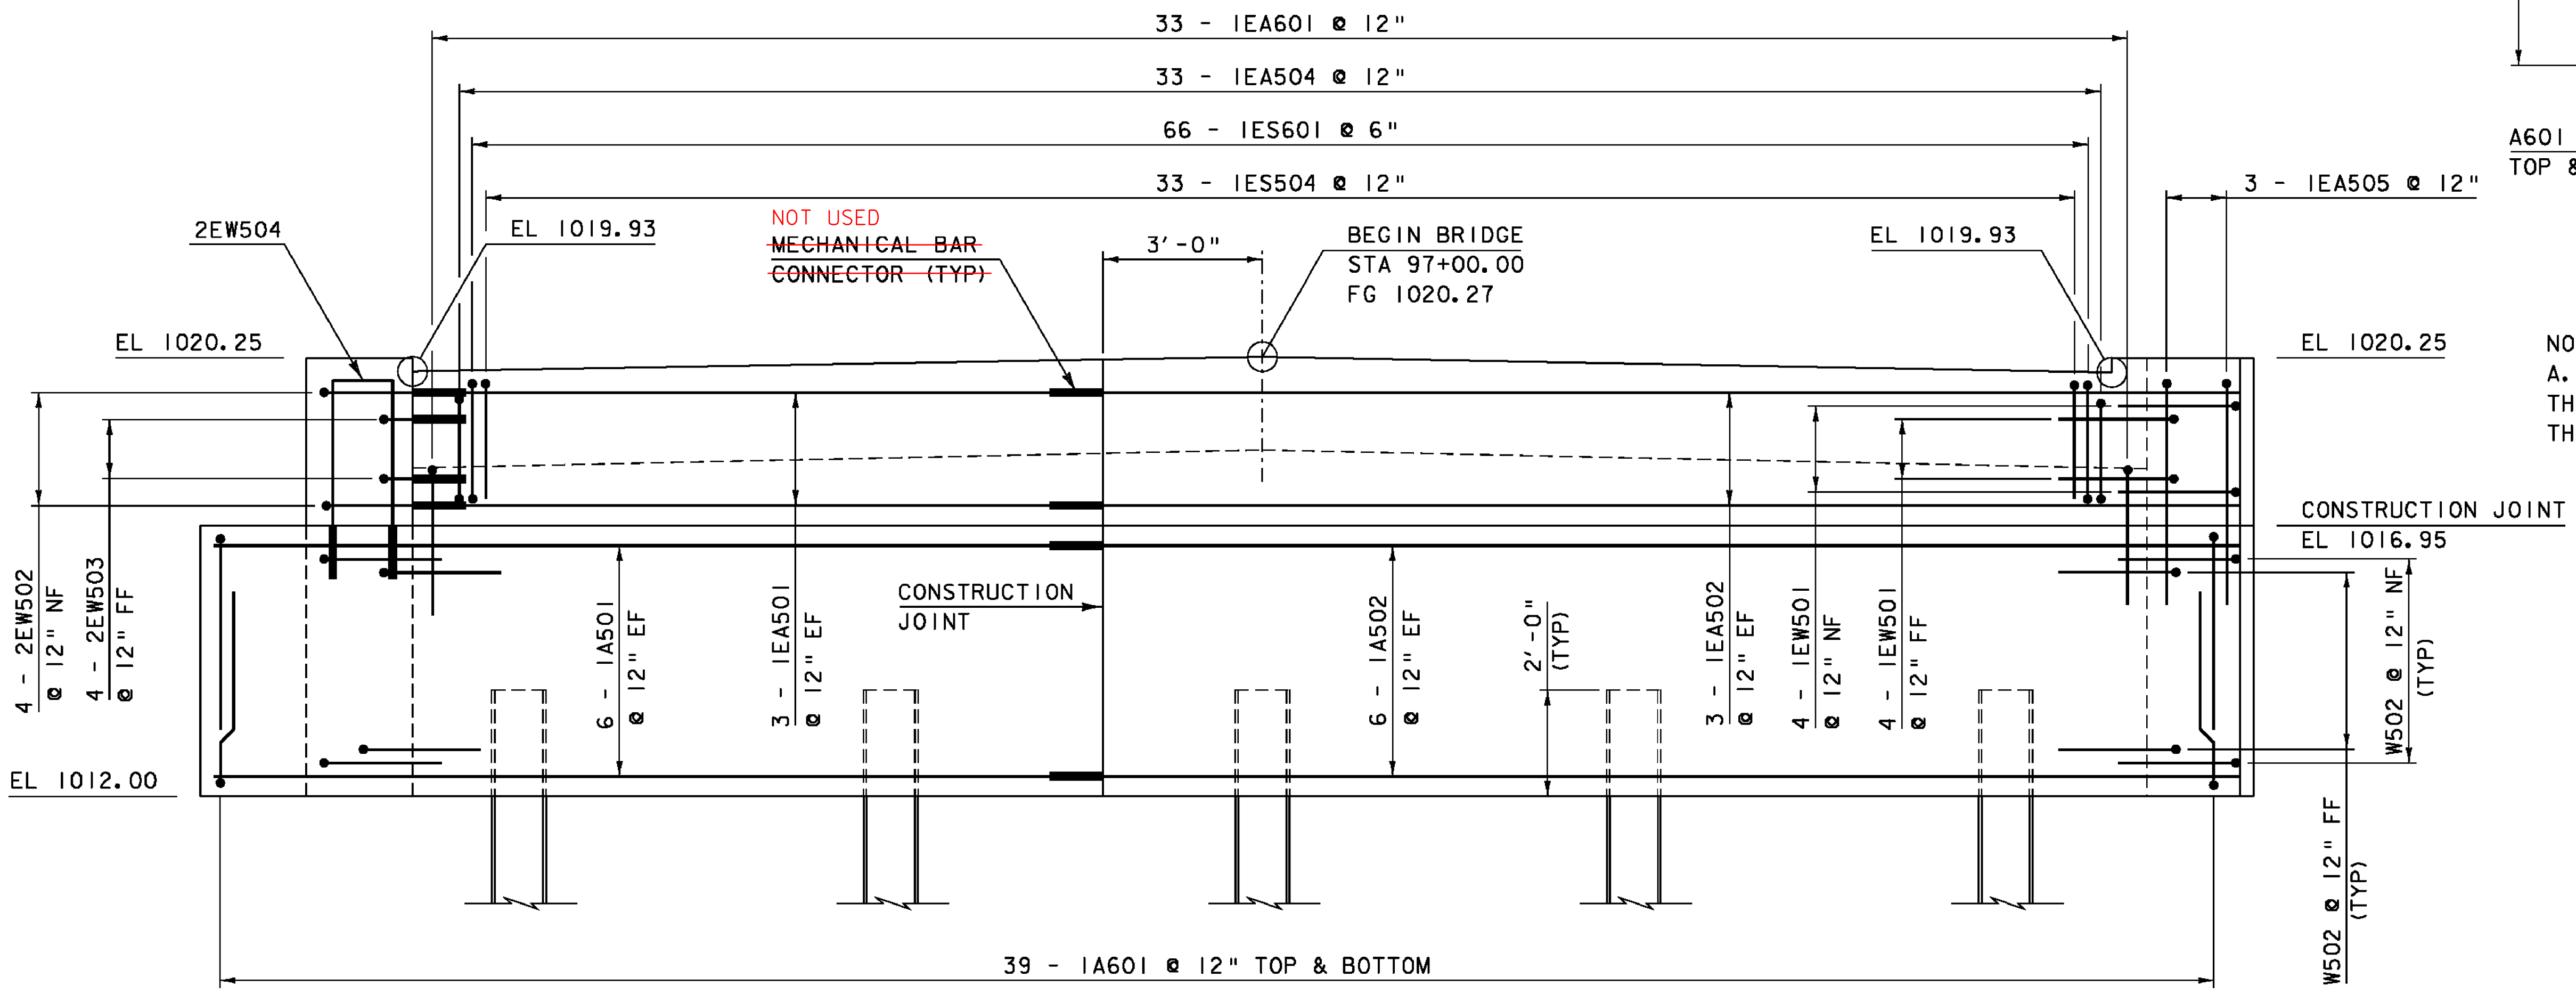


ABUTMENT #1 ELEVATION VIEW

SCALE 1/2" = 1'-0"
0 1 2


PROJECT NAME: EAST HAVEN	PLOT DATE: 08-AUG-2011
PROJECT NUMBER: BRF 0269(II)	DRAWN BY: J. SALVATORI
FILE NAME: s00c162sub.dgn	DESIGNED BY: J. GRIFFIN
PROJECT LEADER: K. HIGGINS	CHECKED BY: J. LACROIX
ABUTMENT #1 DETAILS	SHEET 24 OF 40

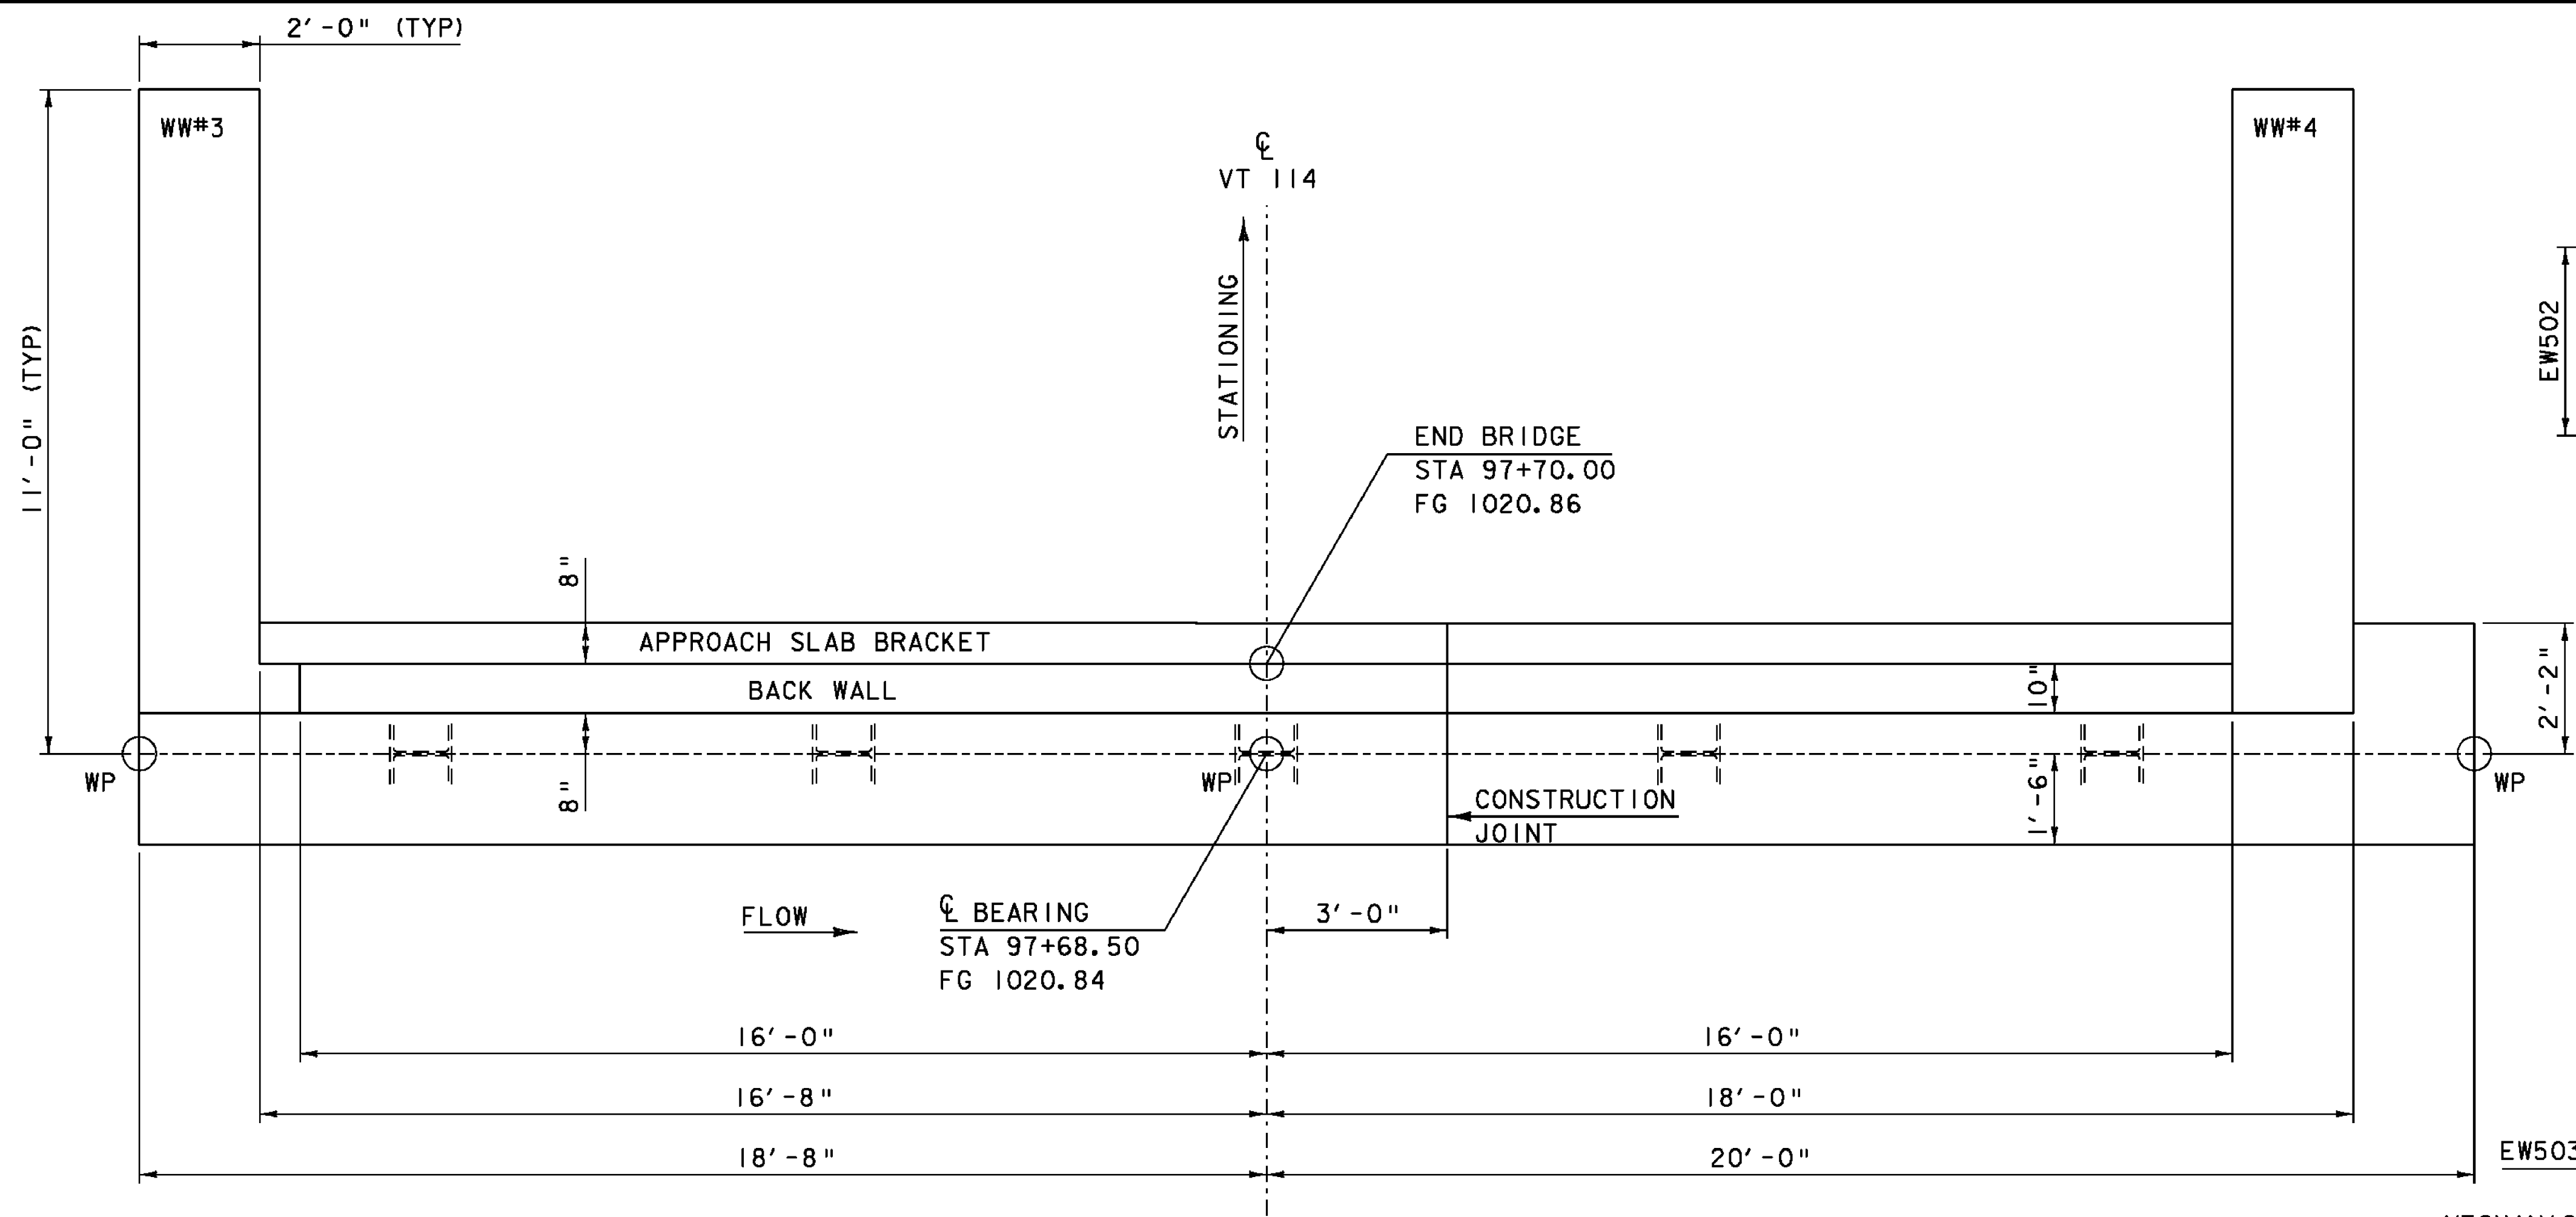


ABUTMENT #2 PLAN VIEW

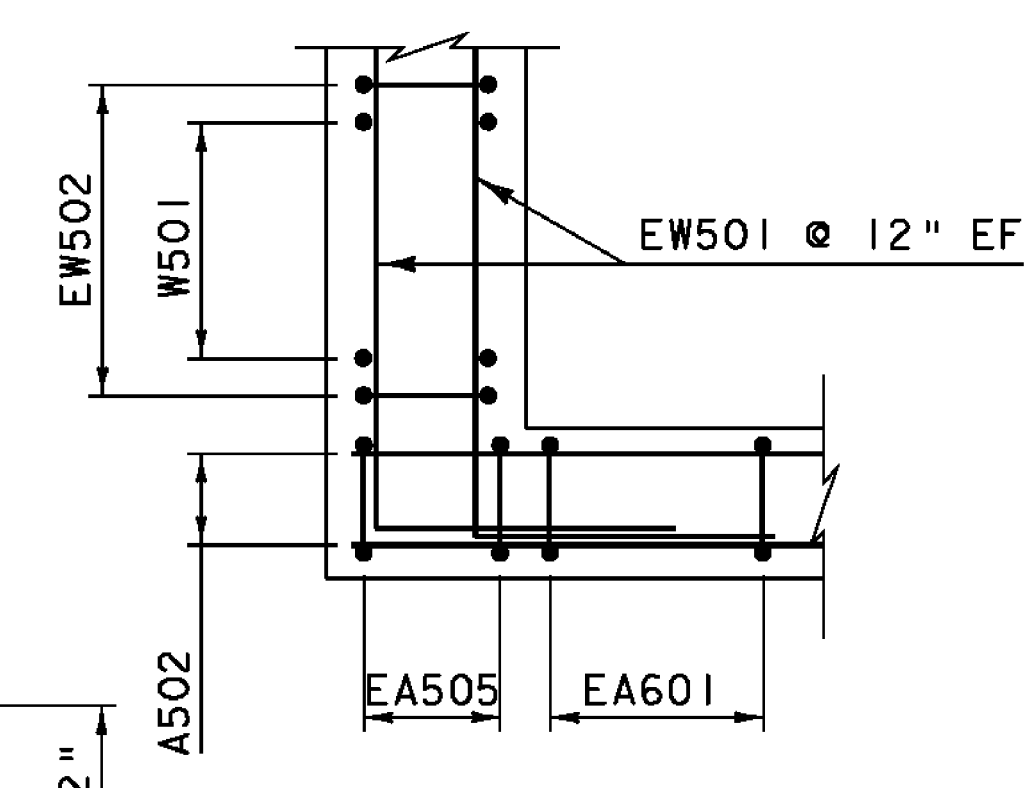


WINGWALL 1 & 3
CORNER DETAIL
ABOVE BRIDGE SEAT

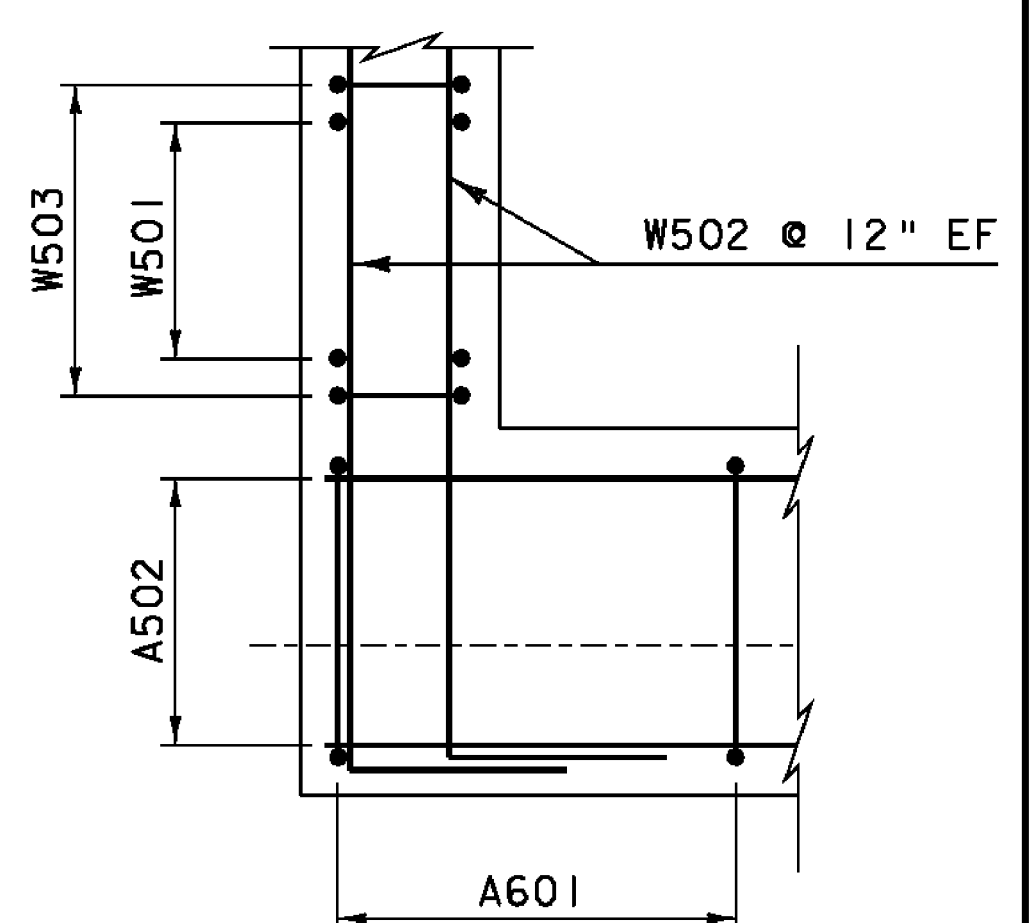


WINGWALL 1 & 3
CORNER DETAIL
BELOW BRIDGE SEAT

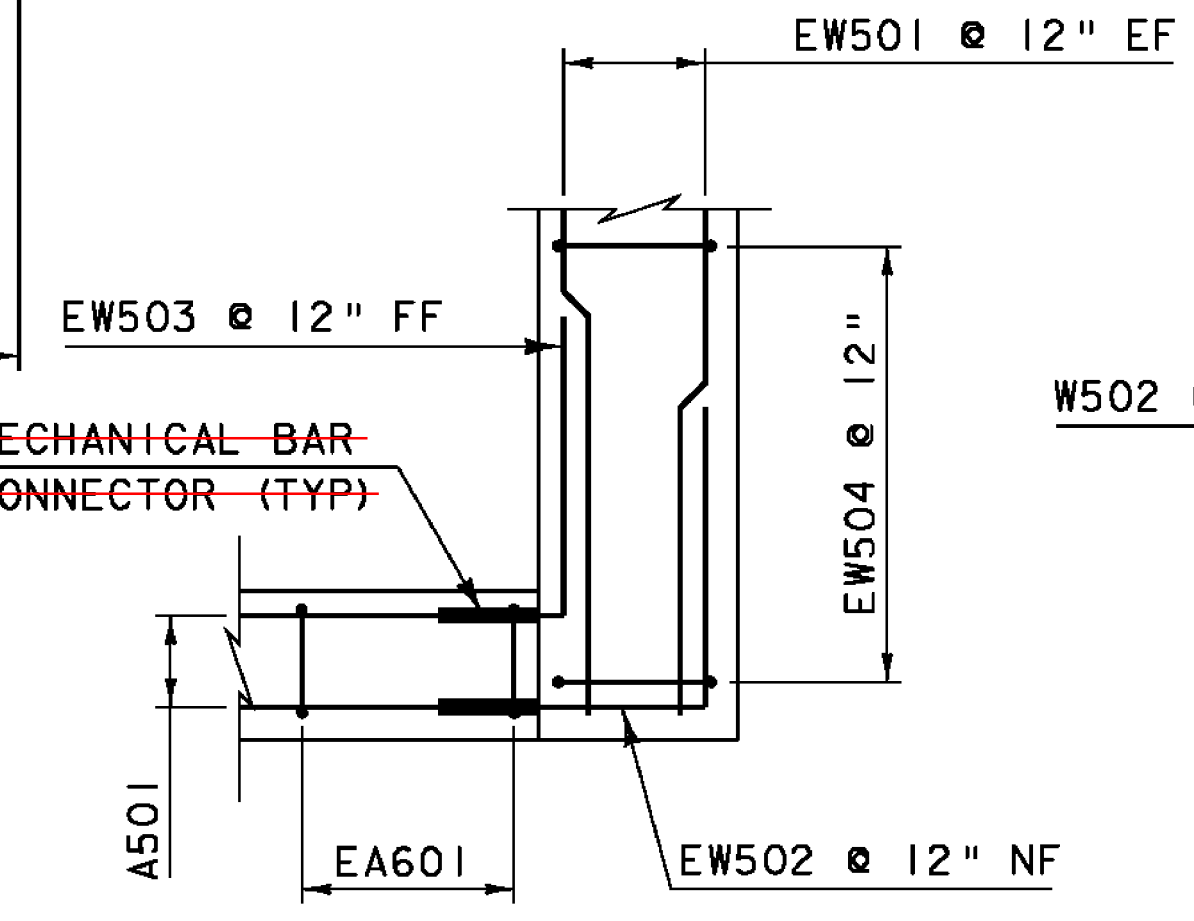


WINGWALL 2 & 4
CORNER DETAIL
ABOVE BRIDGE SEAT

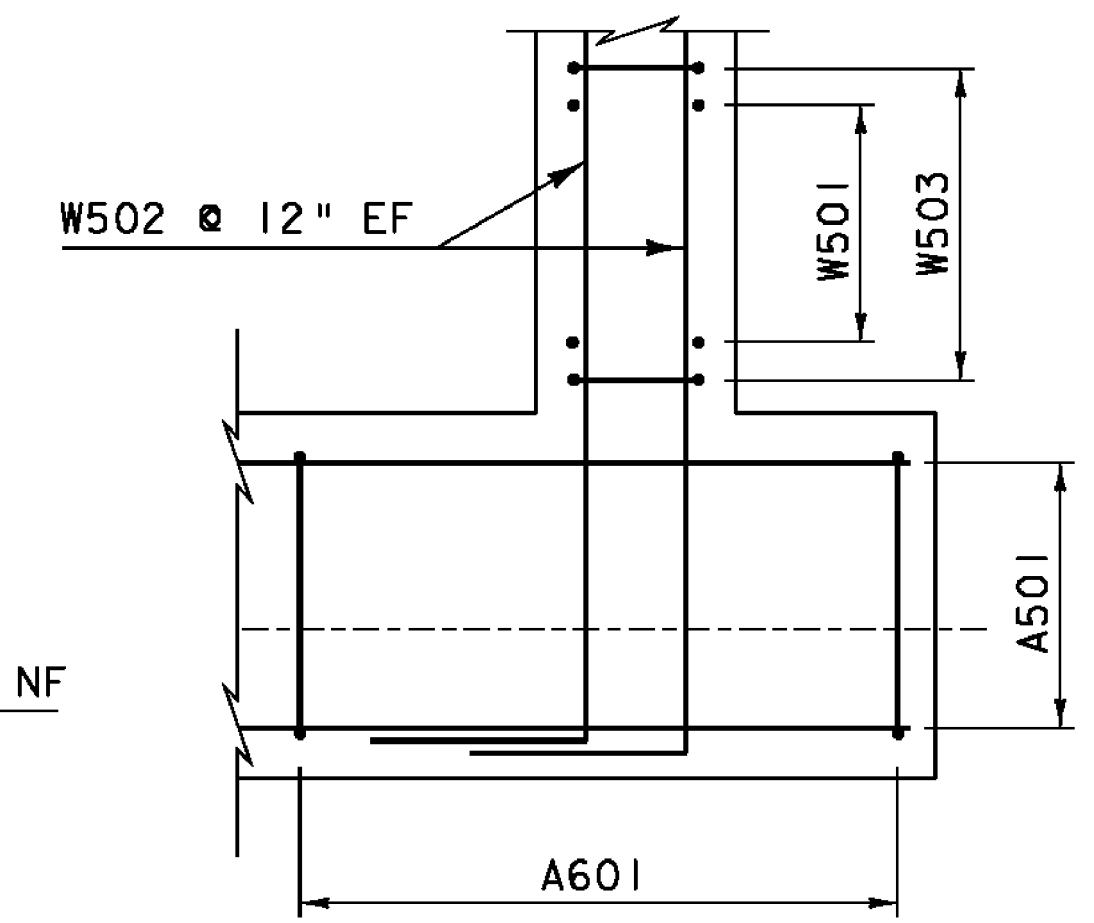

WINGWALL 2 & 4
CORNER DETAIL
BELOW BRIDGE SEAT

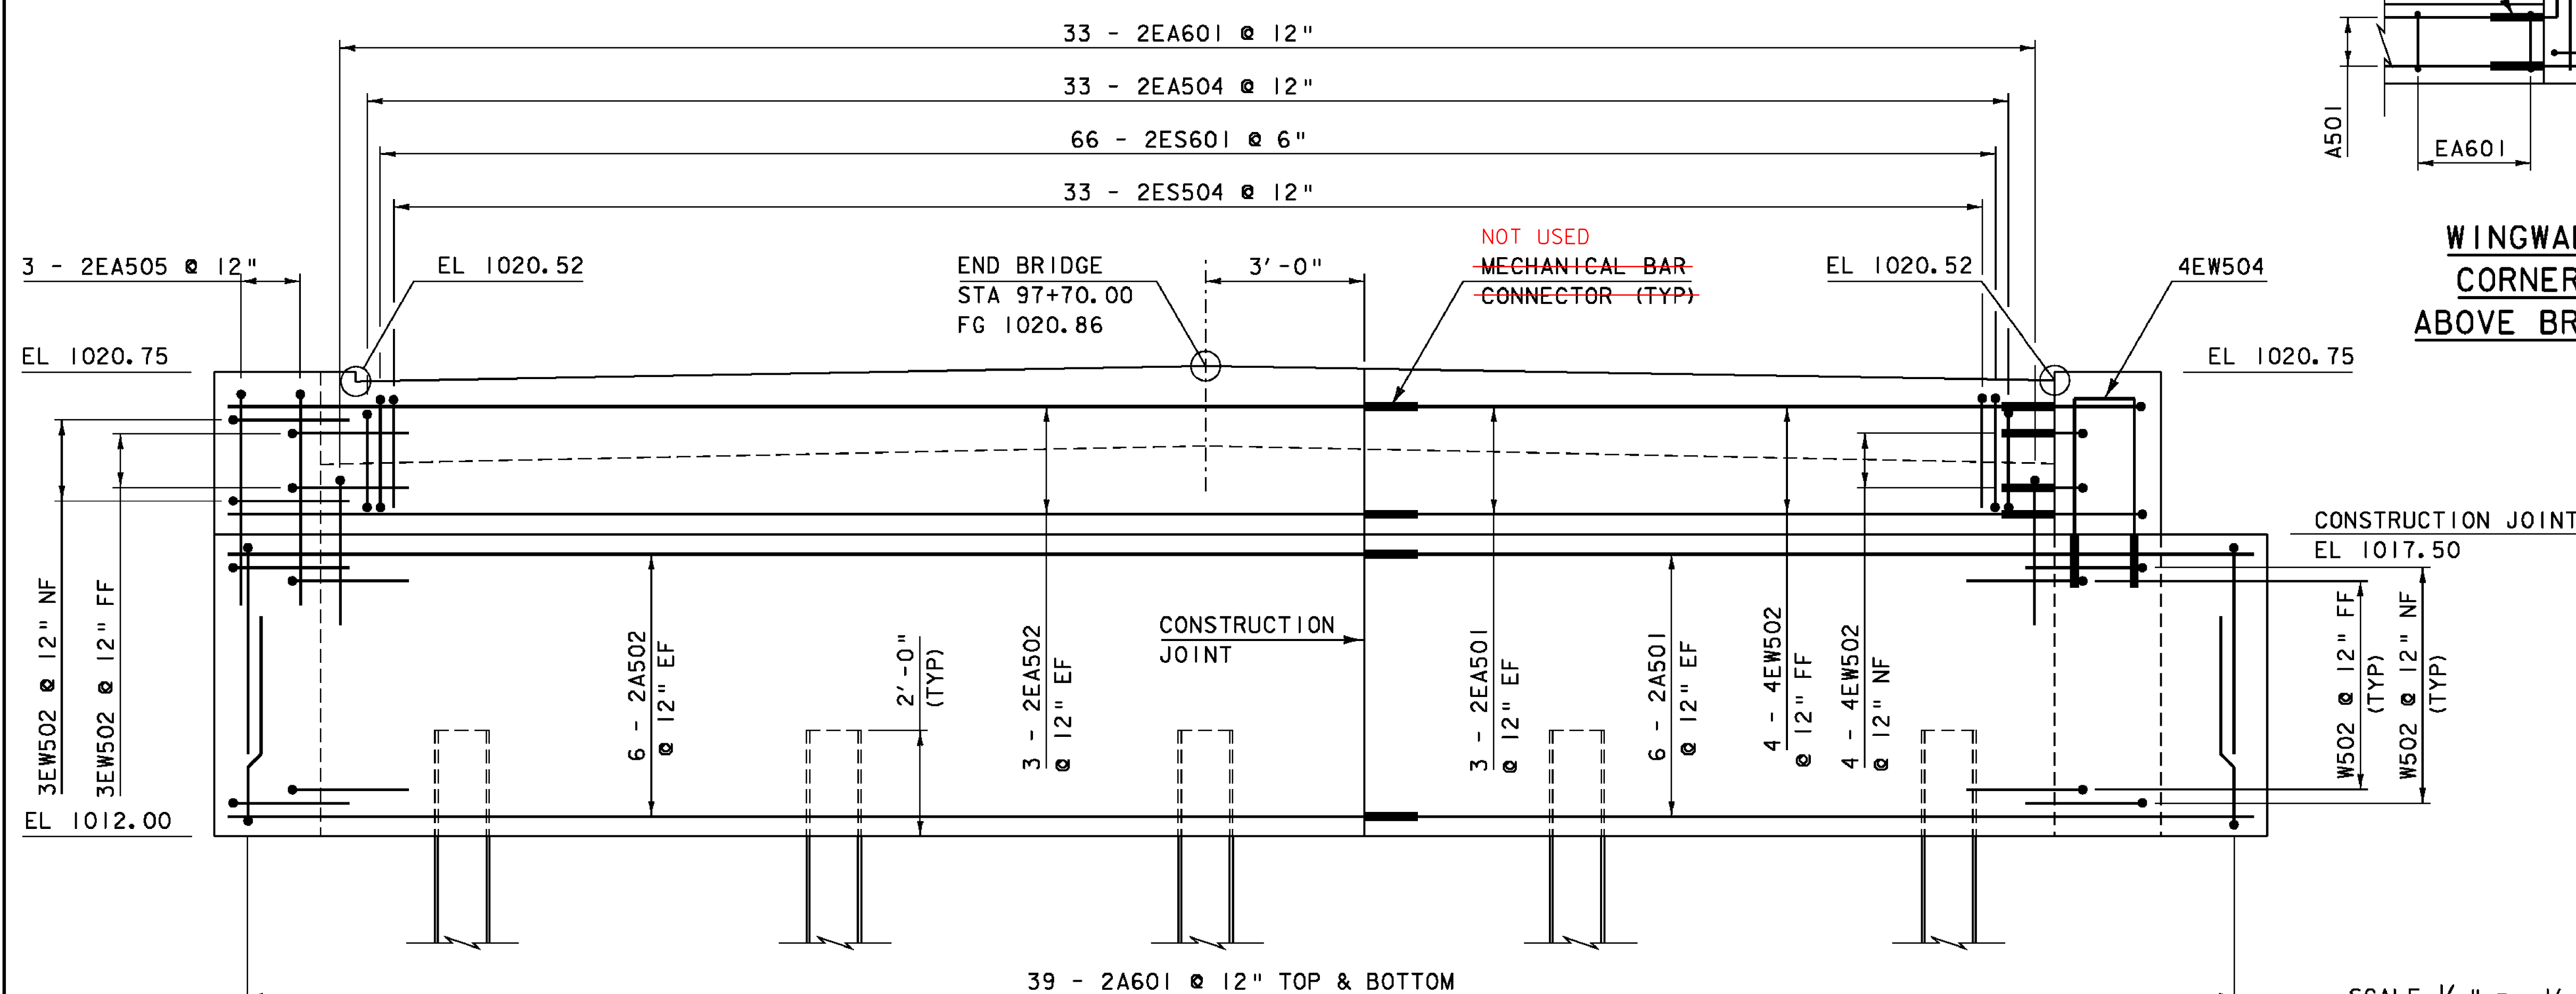


ABUTMENT #2 ELEVATION VIEW

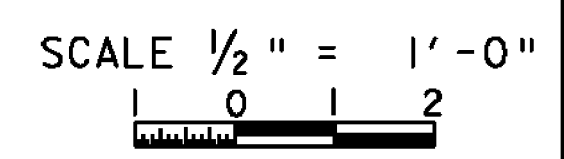

NOTE:
NF = NEAR FACE
FF = FAR FACE
EF = EACH FACE
▲ = CUT TO FIT IN FIELD
3" CLEAR, UNLESS OTHERWISE SPECIFIED ON THE PLANS.
2'-2" BAR LAP UNLESS OTHERWISE SPECIFIED ON THE PLANS.

PROJECT NAME:	EAST HAVEN	PLOT DATE:	08-AUG-2011
PROJECT NUMBER:	BRF 0269(II)	DRAWN BY:	J. SALVATORI
FILE NAME:	s00c162sub.dgn	DESIGNED BY:	J. GRIFFIN
PROJECT LEADER:	K. HIGGINS	ABUTMENT #2 DETAILS	CHECKED BY: J. LACROIX
		SHEET 25 OF 40	

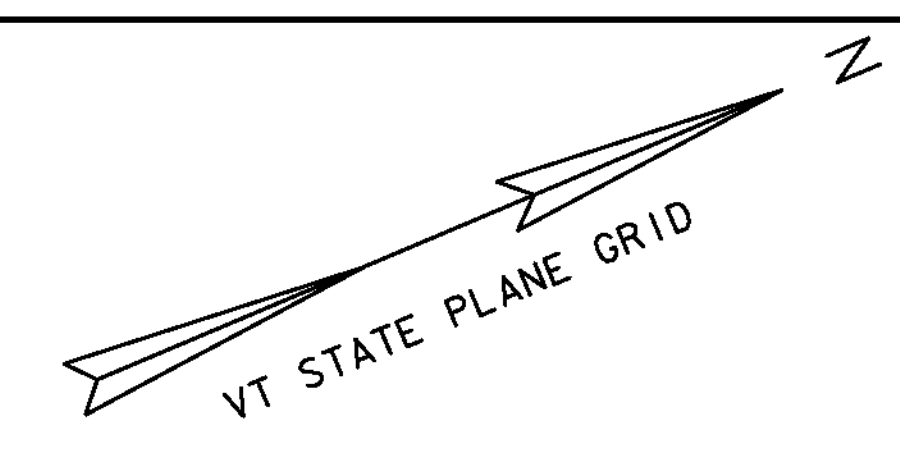


MILEMARKER, STATION, OR SIGN NUMBER	SIGN LEGEND	SIGN DIMENSIONS		NEW SIGN "A"	EXIST POST SALVAGE	NO. OF POSTS	NEW SIGN POSTS SQUARE STEEL (in)			REMARKS	SIGN DETAIL			
		WIDTH (in)	HEIGHT (in)				2.0	2.0	2.5		DETAIL ON SHEET NUMBER	STD. SHEET NUMBER		
							lb/ft							
96+77.75 RT.	BRIDGE 18 VT 114	6	8	0.33		1	10			X		VD-701	E-134	
97+84.98 LT.	BRIDGE 18 VT 114	6	8	0.33		1	10			X		VD-701	E-134	
							FT	FT	FT		EA			
							TOTALS			SF		FT		
										0.66		20		

FINAL POST LENGTHS ARE TO BE DETERMINED IN THE FIELD. POST SIZES ARE COMPUTED BASED ON INFORMATION FURNISHED ON THE STANDARD SHEETS AND THE VTRANS "SIGN POST DESIGN GUIDELINE."

SHS = STANDARD HIGHWAY SIGNS (MUTCD)

NOTE:
ADJUST NEW EDGE LINE TO MATCH EXISTING EDGE LINE AT BEGIN/END APPROACH

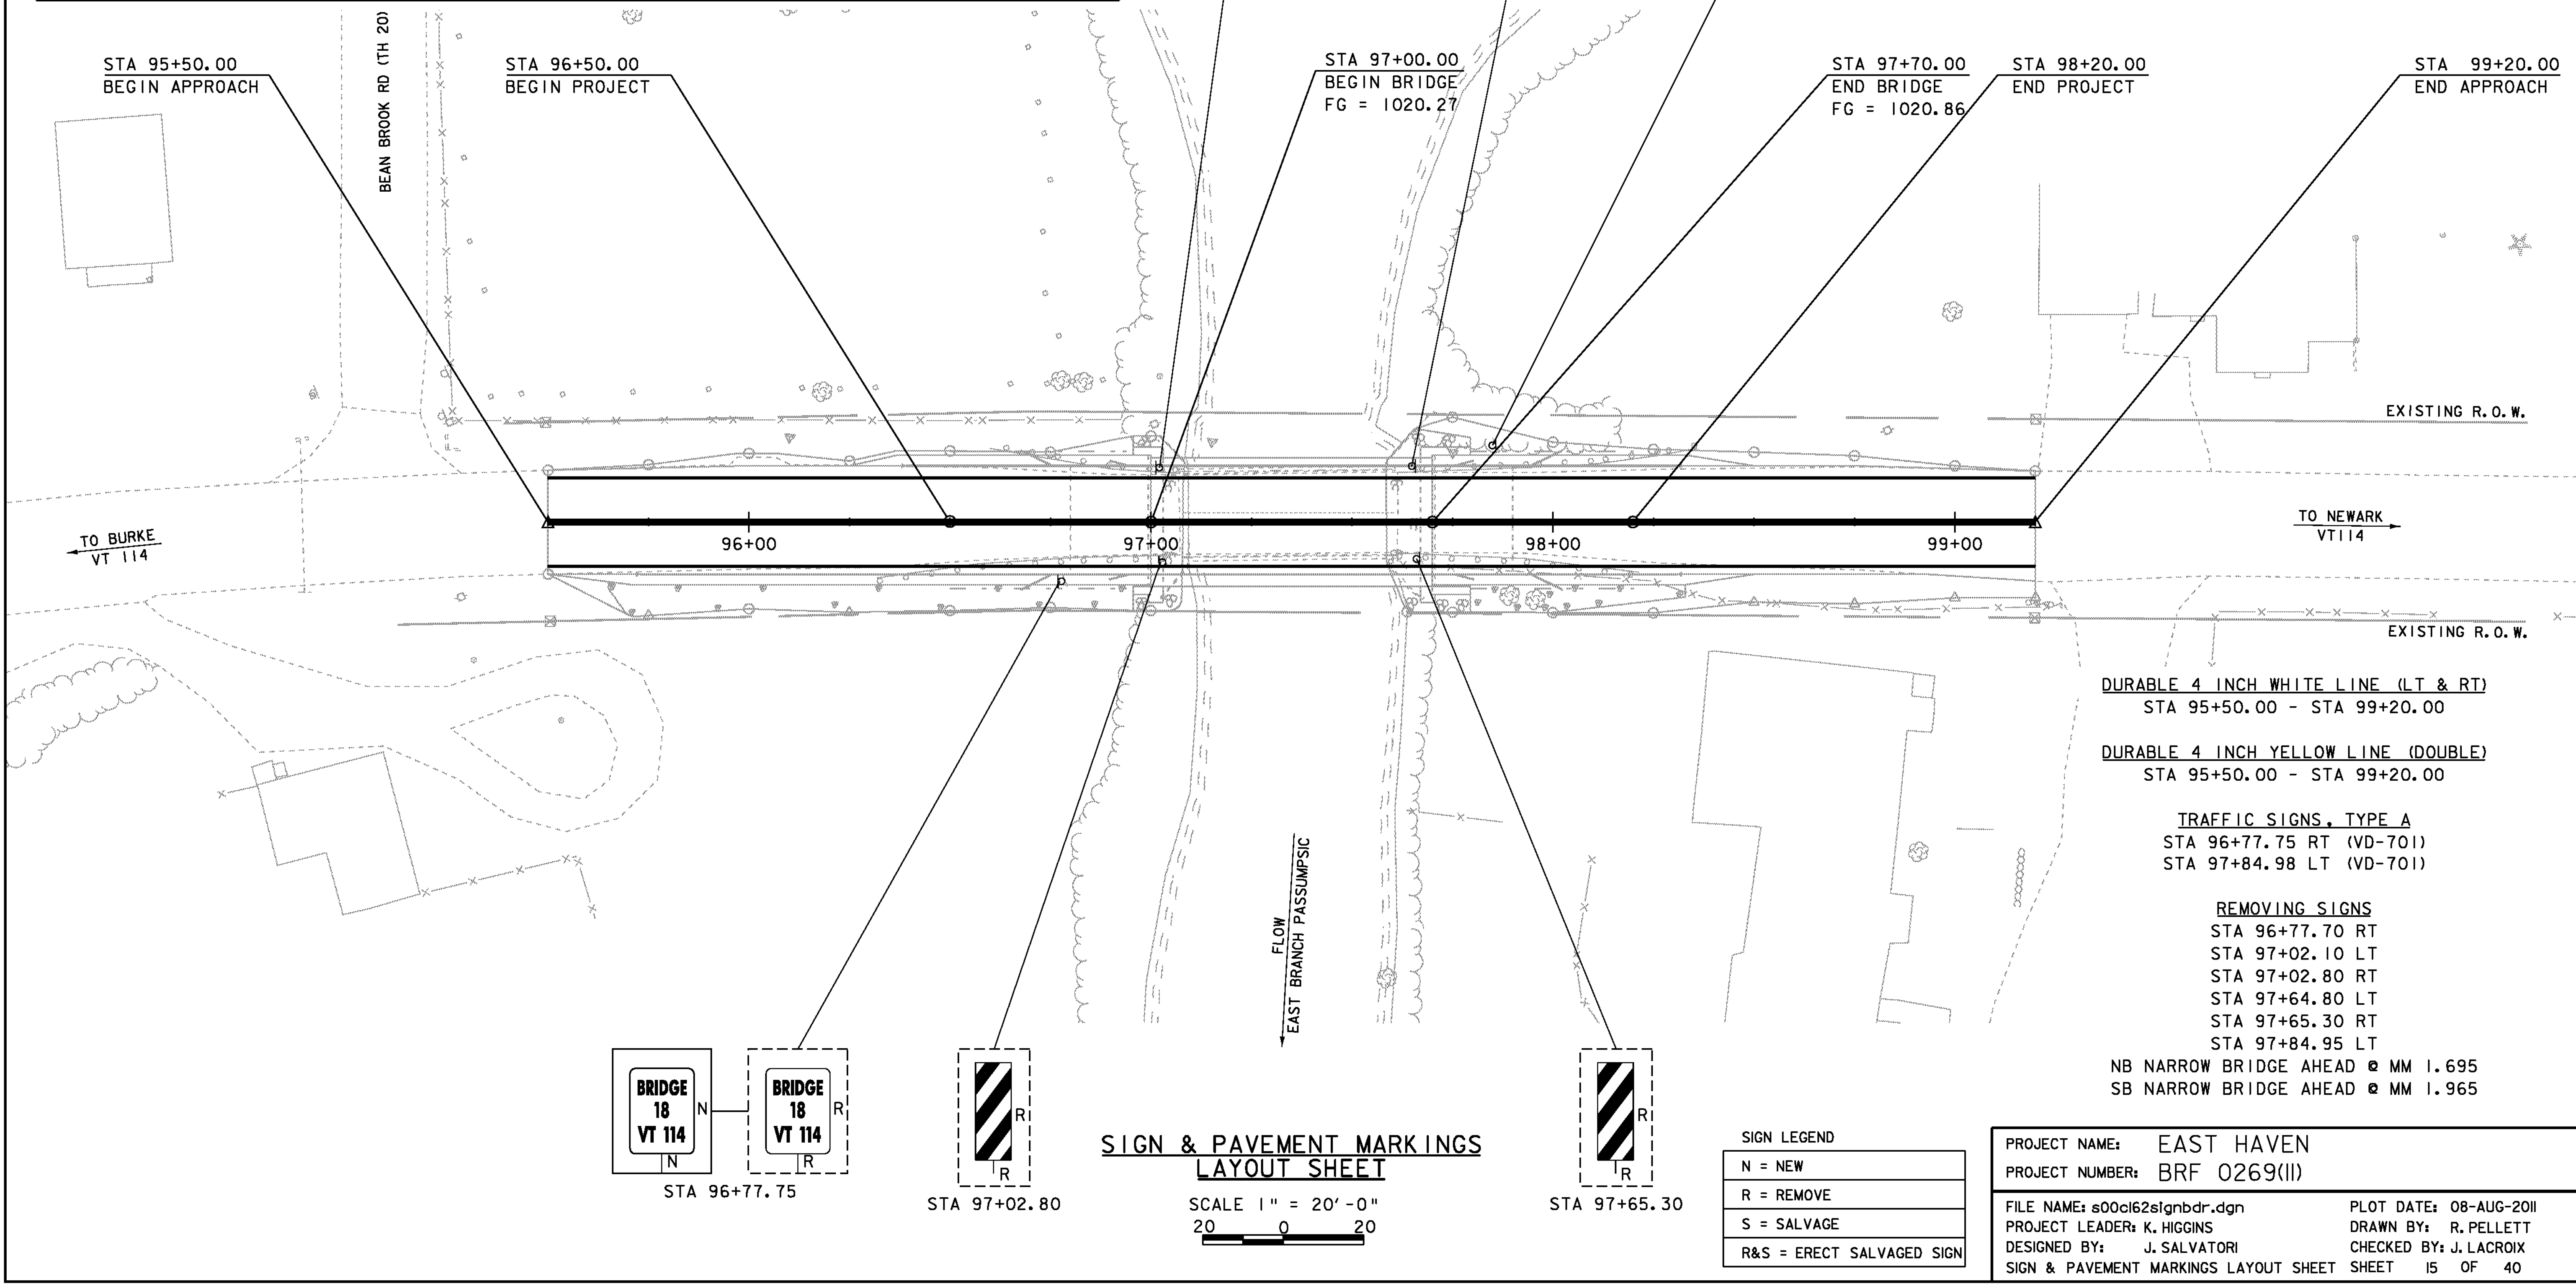

DURABLE 4 INCH WHITE LINE (LT & RT)
STA 95+50.00 - STA 99+20.00

DURABLE 4 INCH YELLOW LINE (DOUBLE)
STA 95+50.00 - STA 99+20.00

TRAFFIC SIGNS, TYPE A
STA 96+77.75 RT (VD-701)
STA 97+84.98 LT (VD-701)



REMOVING SIGNS
STA 96+77.75 RT
STA 97+02.10 LT
STA 97+02.80 RT
STA 97+64.80 LT
STA 97+65.30 RT
STA 97+84.95 LT
NB NARROW BRIDGE AHEAD @ MM 1.695
SB NARROW BRIDGE AHEAD @ MM 1.965

SIGN & PAVEMENT MARKINGS LAYOUT SHEET

SCALE 1" = 20'-0"
20 0 20

SIGN LEGEND	
N	= NEW
R	= REMOVE
S	= SALVAGE
R&S	= ERECT SALVAGED SIGN

PROJECT NAME:	EAST HAVEN	PLOT DATE:	08-AUG-2011
PROJECT NUMBER:	BRF 0269(II)	DRAWN BY:	R. PELLETT
FILE NAME:	s00cl62signbdr.dgn	CHECKED BY:	J. LACROIX
PROJECT LEADER:	K. HIGGINS	SIGN & PAVEMENT MARKINGS LAYOUT SHEET SHEET 15 OF 40	
DESIGNED BY:	J. SALVATORI		

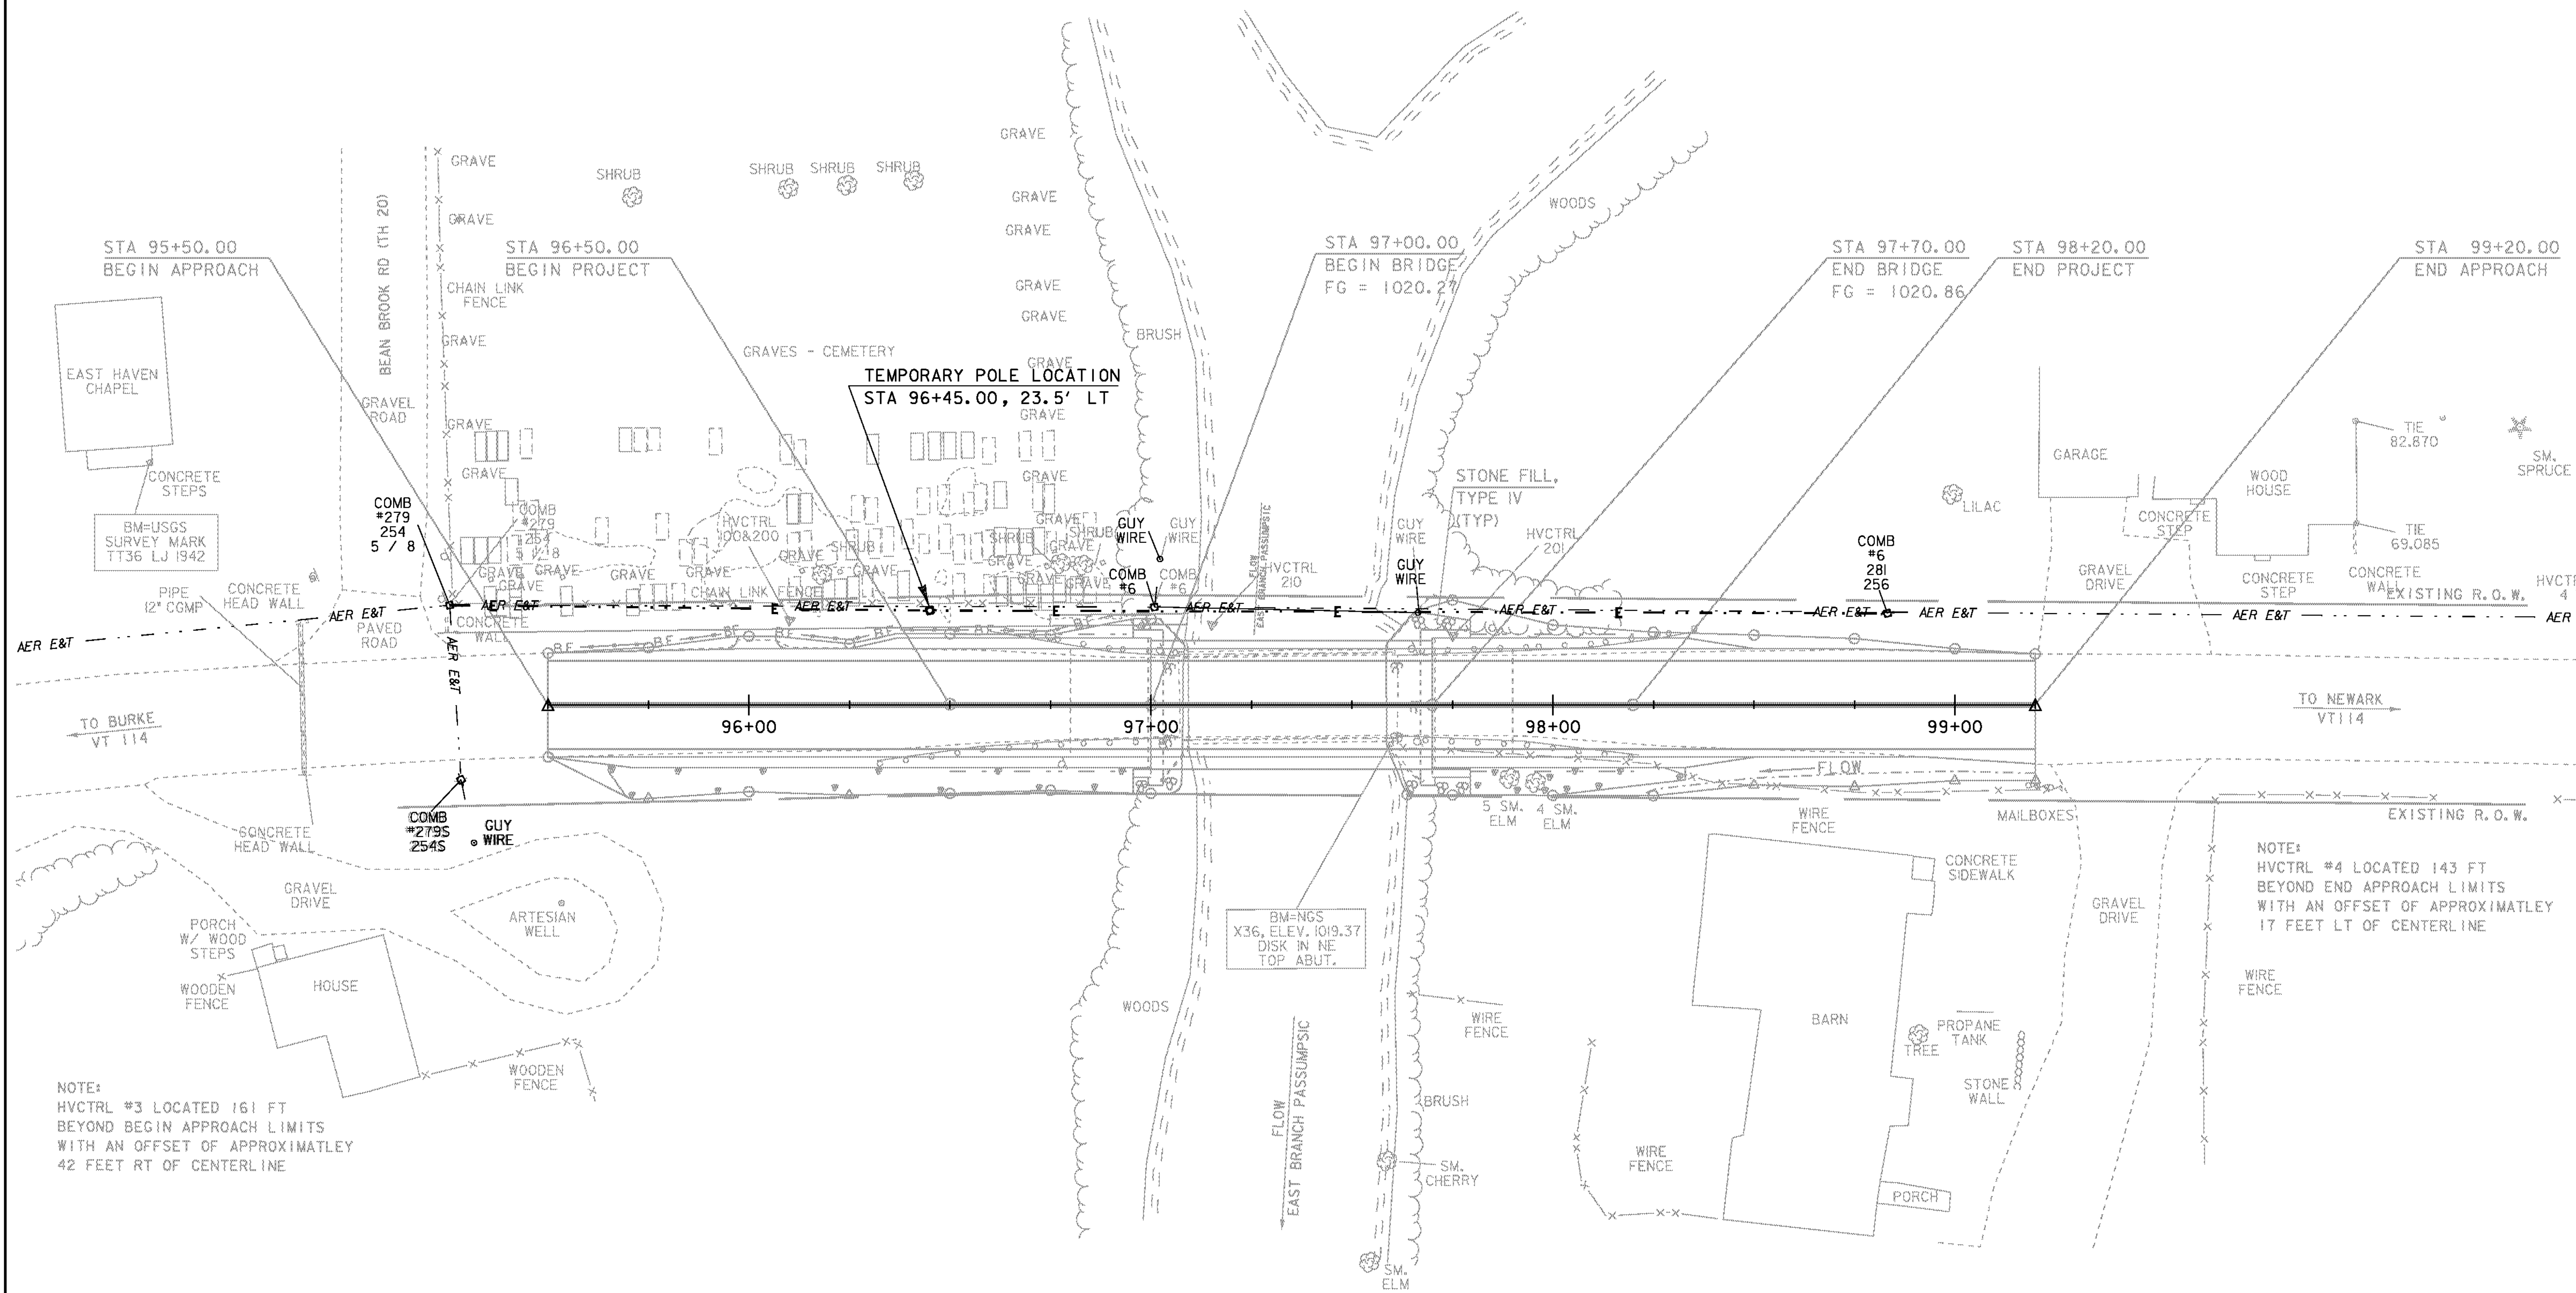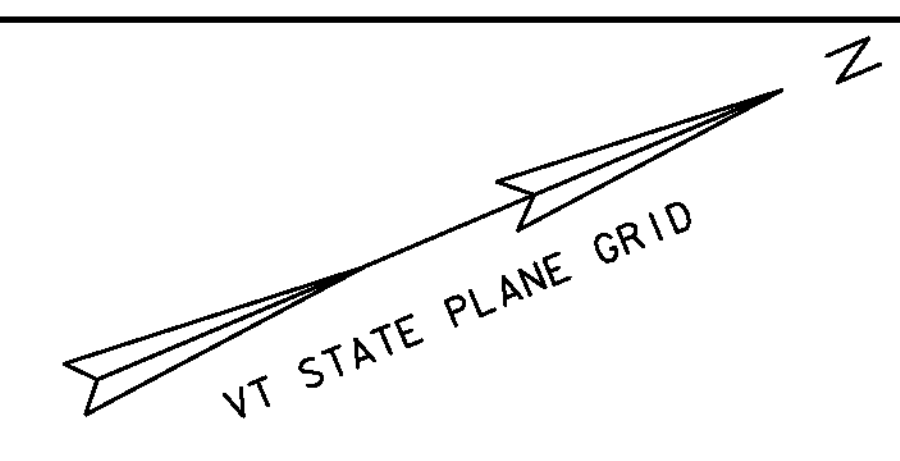



NOTE:
HVCTRL #3 LOCATED 161 FT
BEYOND BEGIN APPROACH LIMITS
WITH AN OFFSET OF APPROXIMATELY
42 FEET RT OF CENTERLINE

NOTE:
HVCTRL #4 LOCATED 143 FT
BEYOND END APPROACH LIMITS
WITH AN OFFSET OF APPROXIMATELY
17 FEET LT OF CENTERLINE

UTILITY LAYOUT SHEET

SCALE 1" = 20' - 0"
20 0 20

PROJECT NAME:	EAST HAVEN	PLOT DATE:	08-AUG-2011
PROJECT NUMBER:	BRF 0269(II)	DRAWN BY:	R. PELLET
FILE NAME:	s00c162ut11bdr.dgn	CHECKED BY:	J. LACROIX
PROJECT LEADER:	K. HIGGINS	UTILITY LAYOUT SHEET	SHEET 14 OF 40
DESIGNED BY:	J. LACROIX		

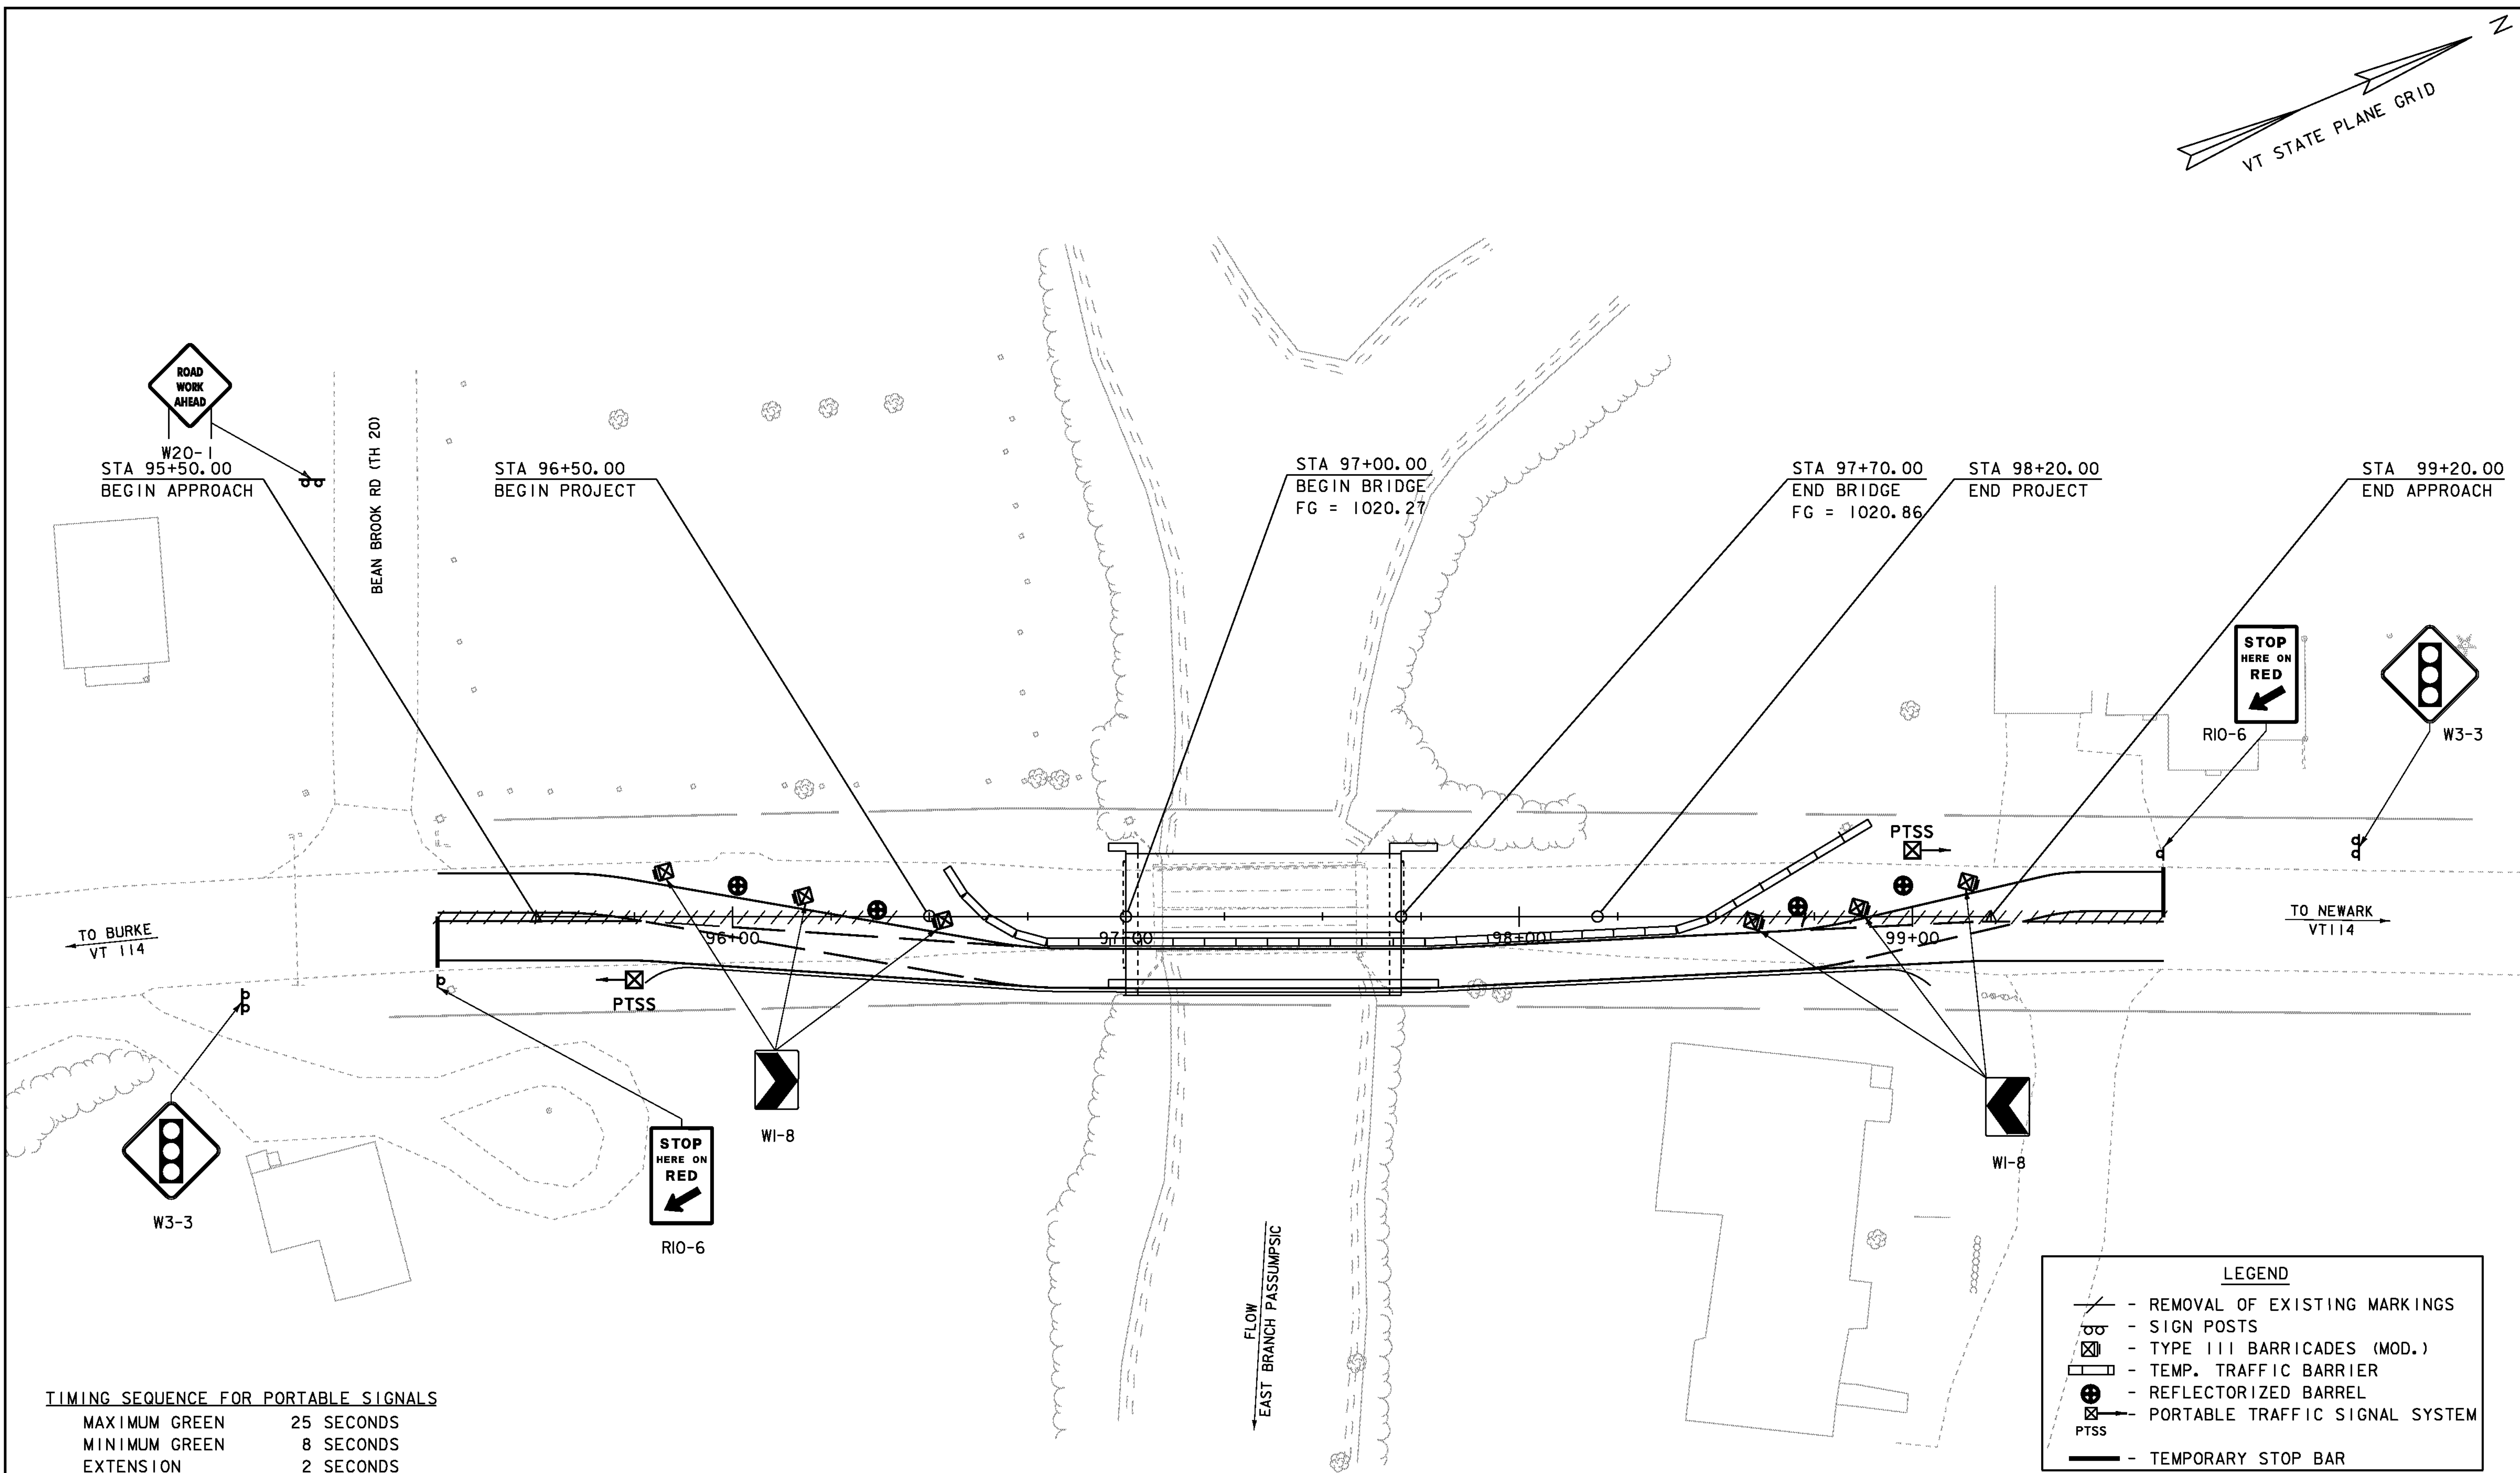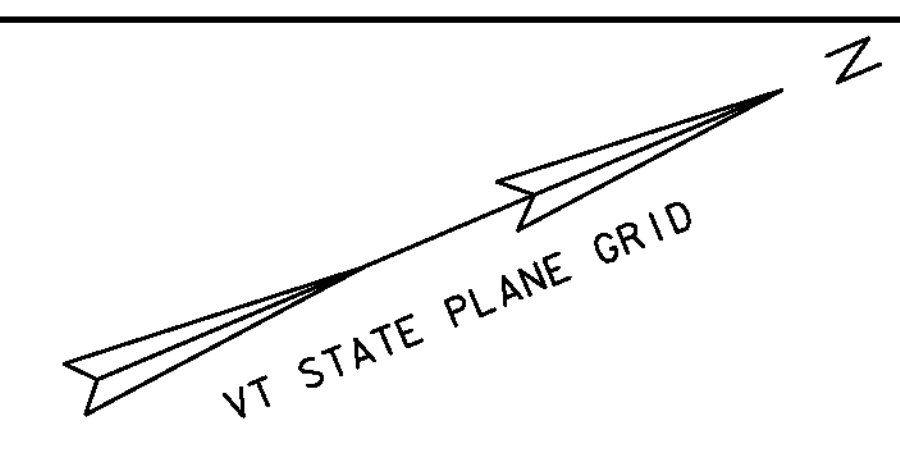


TIMING SEQUENCE FOR PORTABLE SIGNALS

MAXIMUM GREEN	25 SECONDS
MINIMUM GREEN	8 SECONDS
EXTENSION	2 SECONDS
ALL-RED CLEARANCE	16 SECONDS



LEGEND

- REMOVAL OF EXISTING MARKINGS
- SIGN POSTS
- TYPE III BARRICADES (MOD.)
- TEMP. TRAFFIC BARRIER
- REFLECTORIZED BARREL
- PORTABLE TRAFFIC SIGNAL SYSTEM (PTSS)
- TEMPORARY STOP BAR


TRAFFIC CONTROL - PHASE II

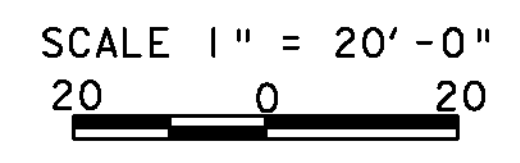

PROJECT NAME: EAST HAVEN	PLOT DATE: 08-AUG-2011
PROJECT NUMBER: BRF 0269(II)	DRAWN BY: R. PELLETT
FILE NAME: s00cl62ph1a2.dgn	CHECKED BY: J. SALVATORI
PROJECT LEADER: K. HIGGINS	SHEET 13 OF 40
DESIGNED BY: J. SALVATORI	
TRAFFIC CONTROL - PHASE II	

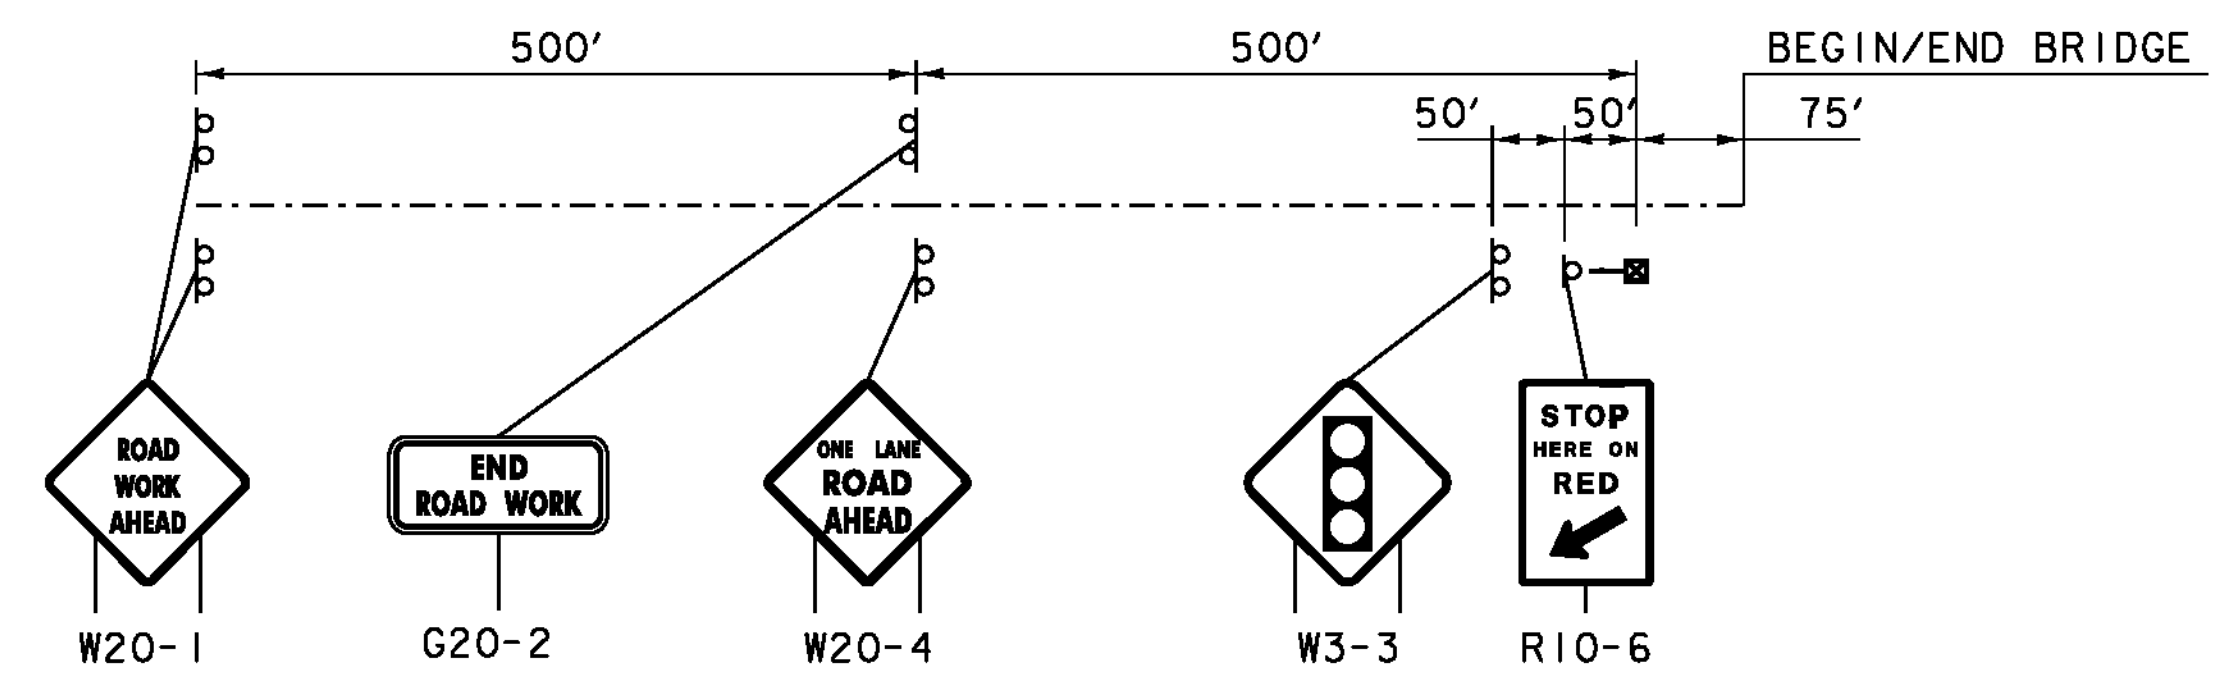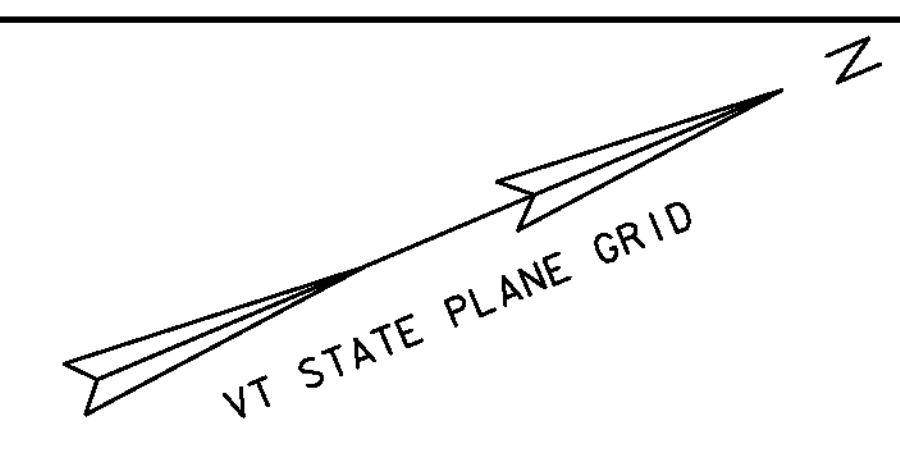

APPROACH SIGNS
NOT TO SCALE

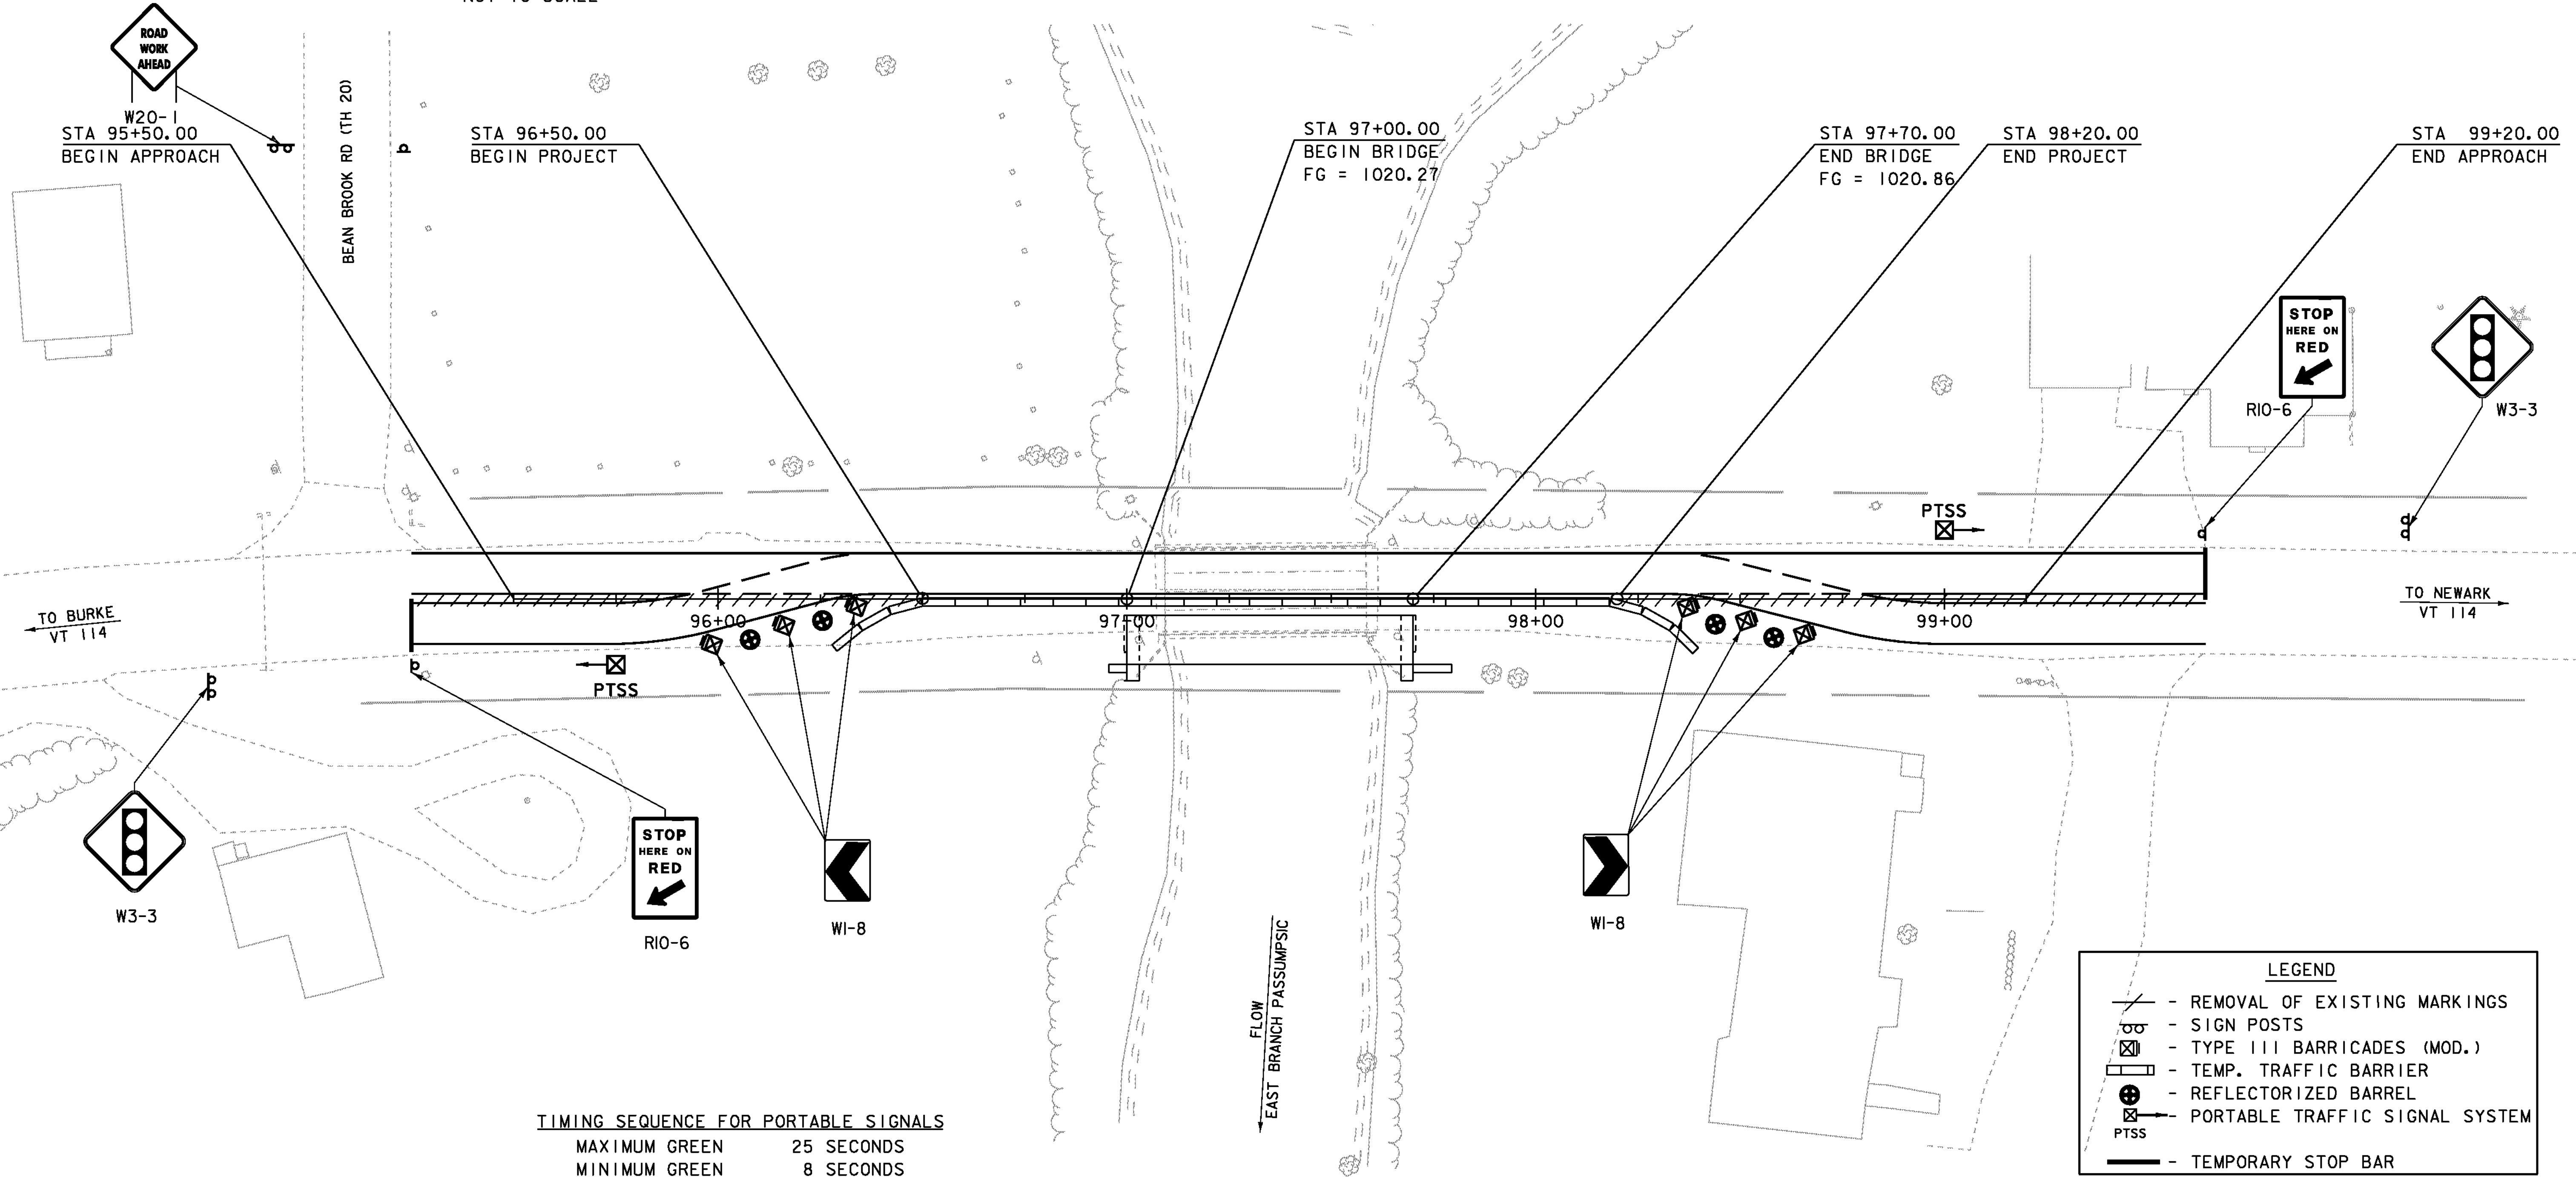


TIMING SEQUENCE FOR PORTABLE SIGNALS

MAXIMUM GREEN	25 SECONDS
MINIMUM GREEN	8 SECONDS
EXTENSION	2 SECONDS
ALL-RED CLEARANCE	16 SECONDS


LEGEND

- REMOVAL OF EXISTING MARKINGS
- SIGN POSTS
- TYPE III BARRICADES (MOD.)
- TEMP. TRAFFIC BARRIER
- REFLECTORIZED BARREL
- PORTABLE TRAFFIC SIGNAL SYSTEM
PTSS
- TEMPORARY STOP BAR


TRAFFIC CONTROL - PHASE I

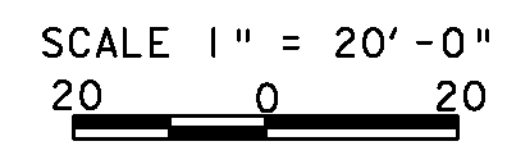


PROJECT NAME:	EAST HAVEN
PROJECT NUMBER:	BRF 0269(II)
FILE NAME:	s00cl62ph1a.dgn
PROJECT LEADER:	K. HIGGINS
DESIGNED BY:	J. SALVATORI
TRAFFIC CONTROL - PHASE I	
PLOT DATE:	08-AUG-2011
DRAWN BY:	R. PELLETT
CHECKED BY:	J. SALVATORI
SHEET	12 OF 40

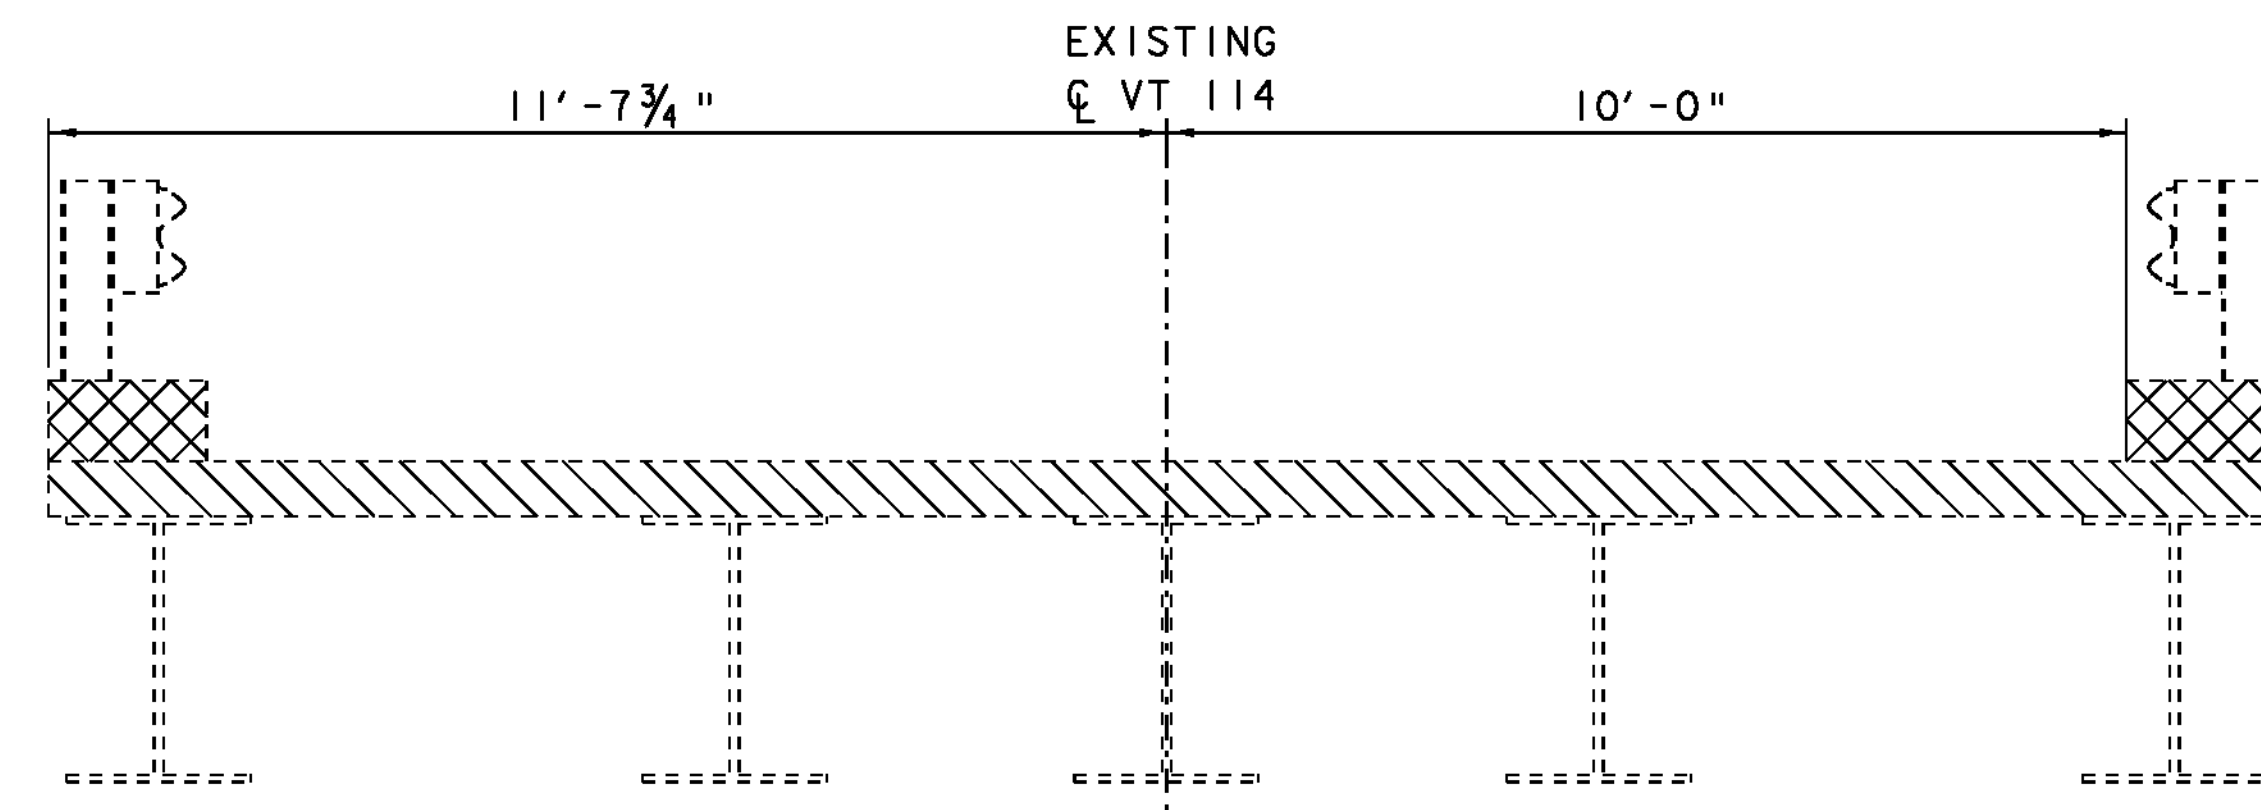


EXISTING TYPICAL SECTION

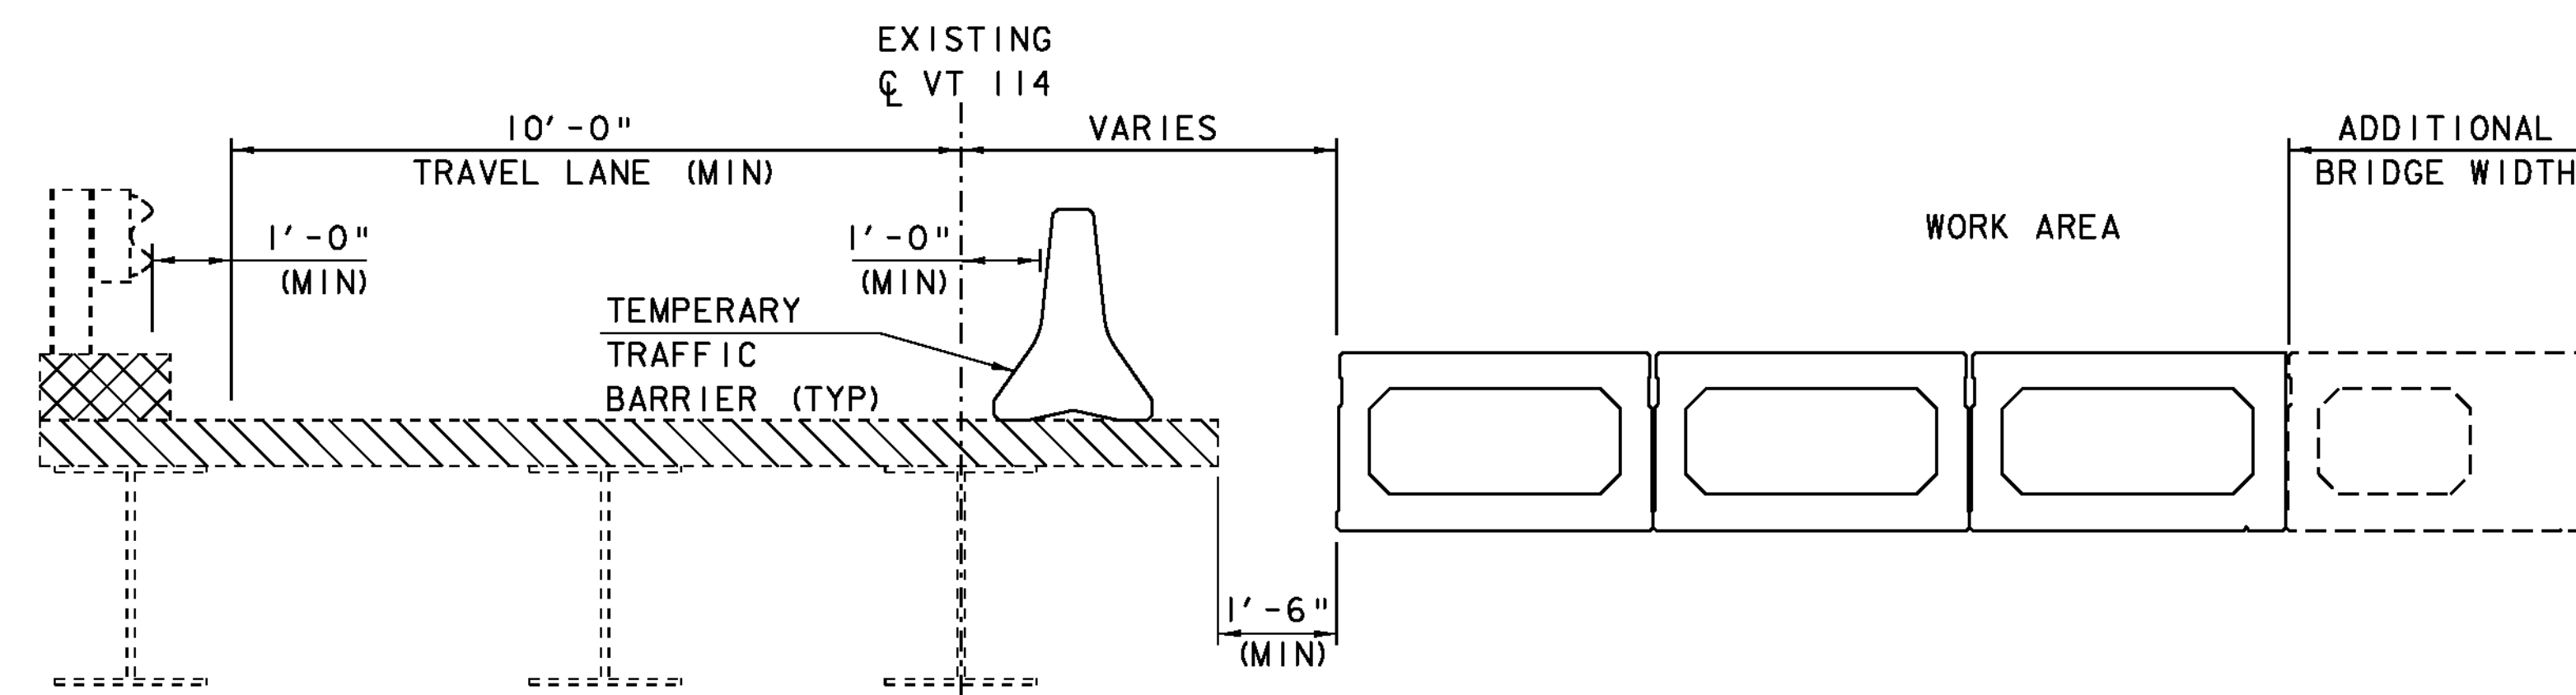

PHASE I

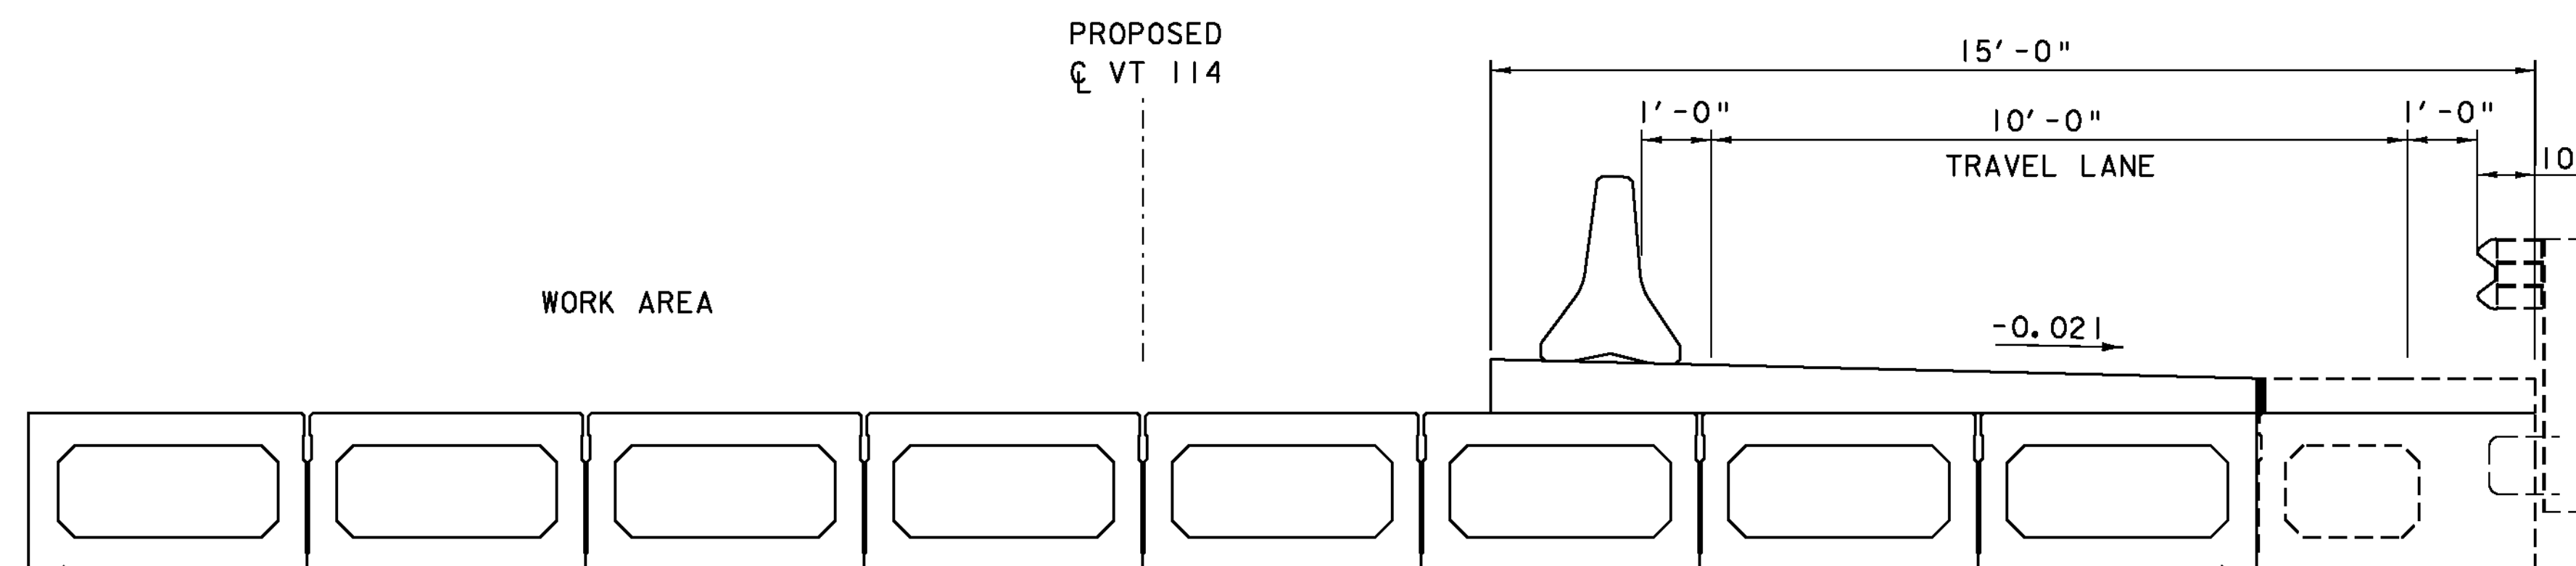

PHASE II

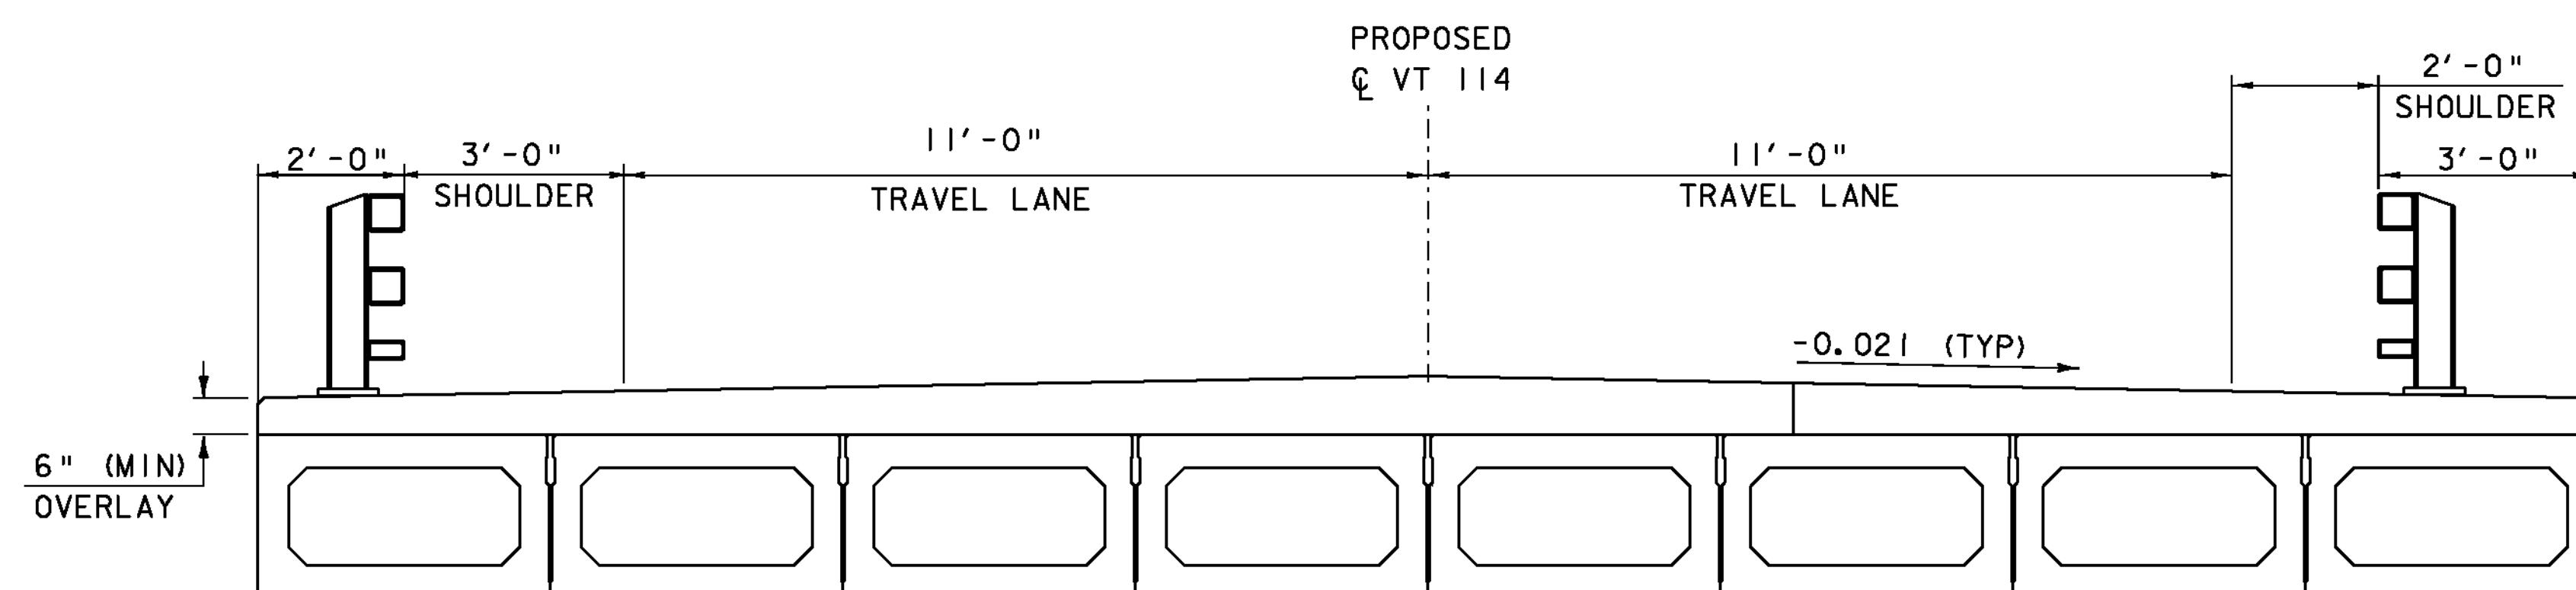

FINAL CONDITION

NOTE:

THE TRAFFIC CONTROL PHASING SHOWN IS OF A CONCEPTUAL NATURE ONLY. THE CONTRACTOR SHALL SUPPLY A DETAILED TRAFFIC CONTROL PLAN, WHICH NEED NOT UTILIZE PHASING OR THE PHASING SHOWN HERE. SEE THE TRAFFIC CONTROL NOTES AND THE SPECIFICATIONS FOR ITEM 900.645 SPECIAL PROVISION (TRAFFIC CONTROL, ALL-INCLUSIVE) FOR MORE DETAILS.

CONTRACTOR TO PROVIDE ADDITIONAL WIDTH FOR PHASED CONSTRUCTION. SEE SPECIAL PROVISIONS FOR ITEM 900.645 SPECIAL PROVISION (TEMPORARY BRIDGE WIDENING FOR PHASED CONSTRUCTION)


TEMPORARY BRIDGE RAILING, AASHTO TL-2 (MIN) (PAID FOR UNDER SPECIAL PROVISION (TEMPORARY BRIDGE WIDENING FOR PHASED CONSTRUCTION))

SCALE 1/2" = 1'-0"

PROJECT NAME: EAST HAVEN
 PROJECT NUMBER: BRF 0269(II)

FILE NAME: s00cl62phasing.dgn
 PROJECT LEADER: K. HIGGINS
 DESIGNED BY: J. LACROIX
 TRAFFIC PHASING TYPICALS


PLOT DATE: 08-AUG-2011
 DRAWN BY: R. PELLET
 CHECKED BY: J. LACROIX
 SHEET II OF 40

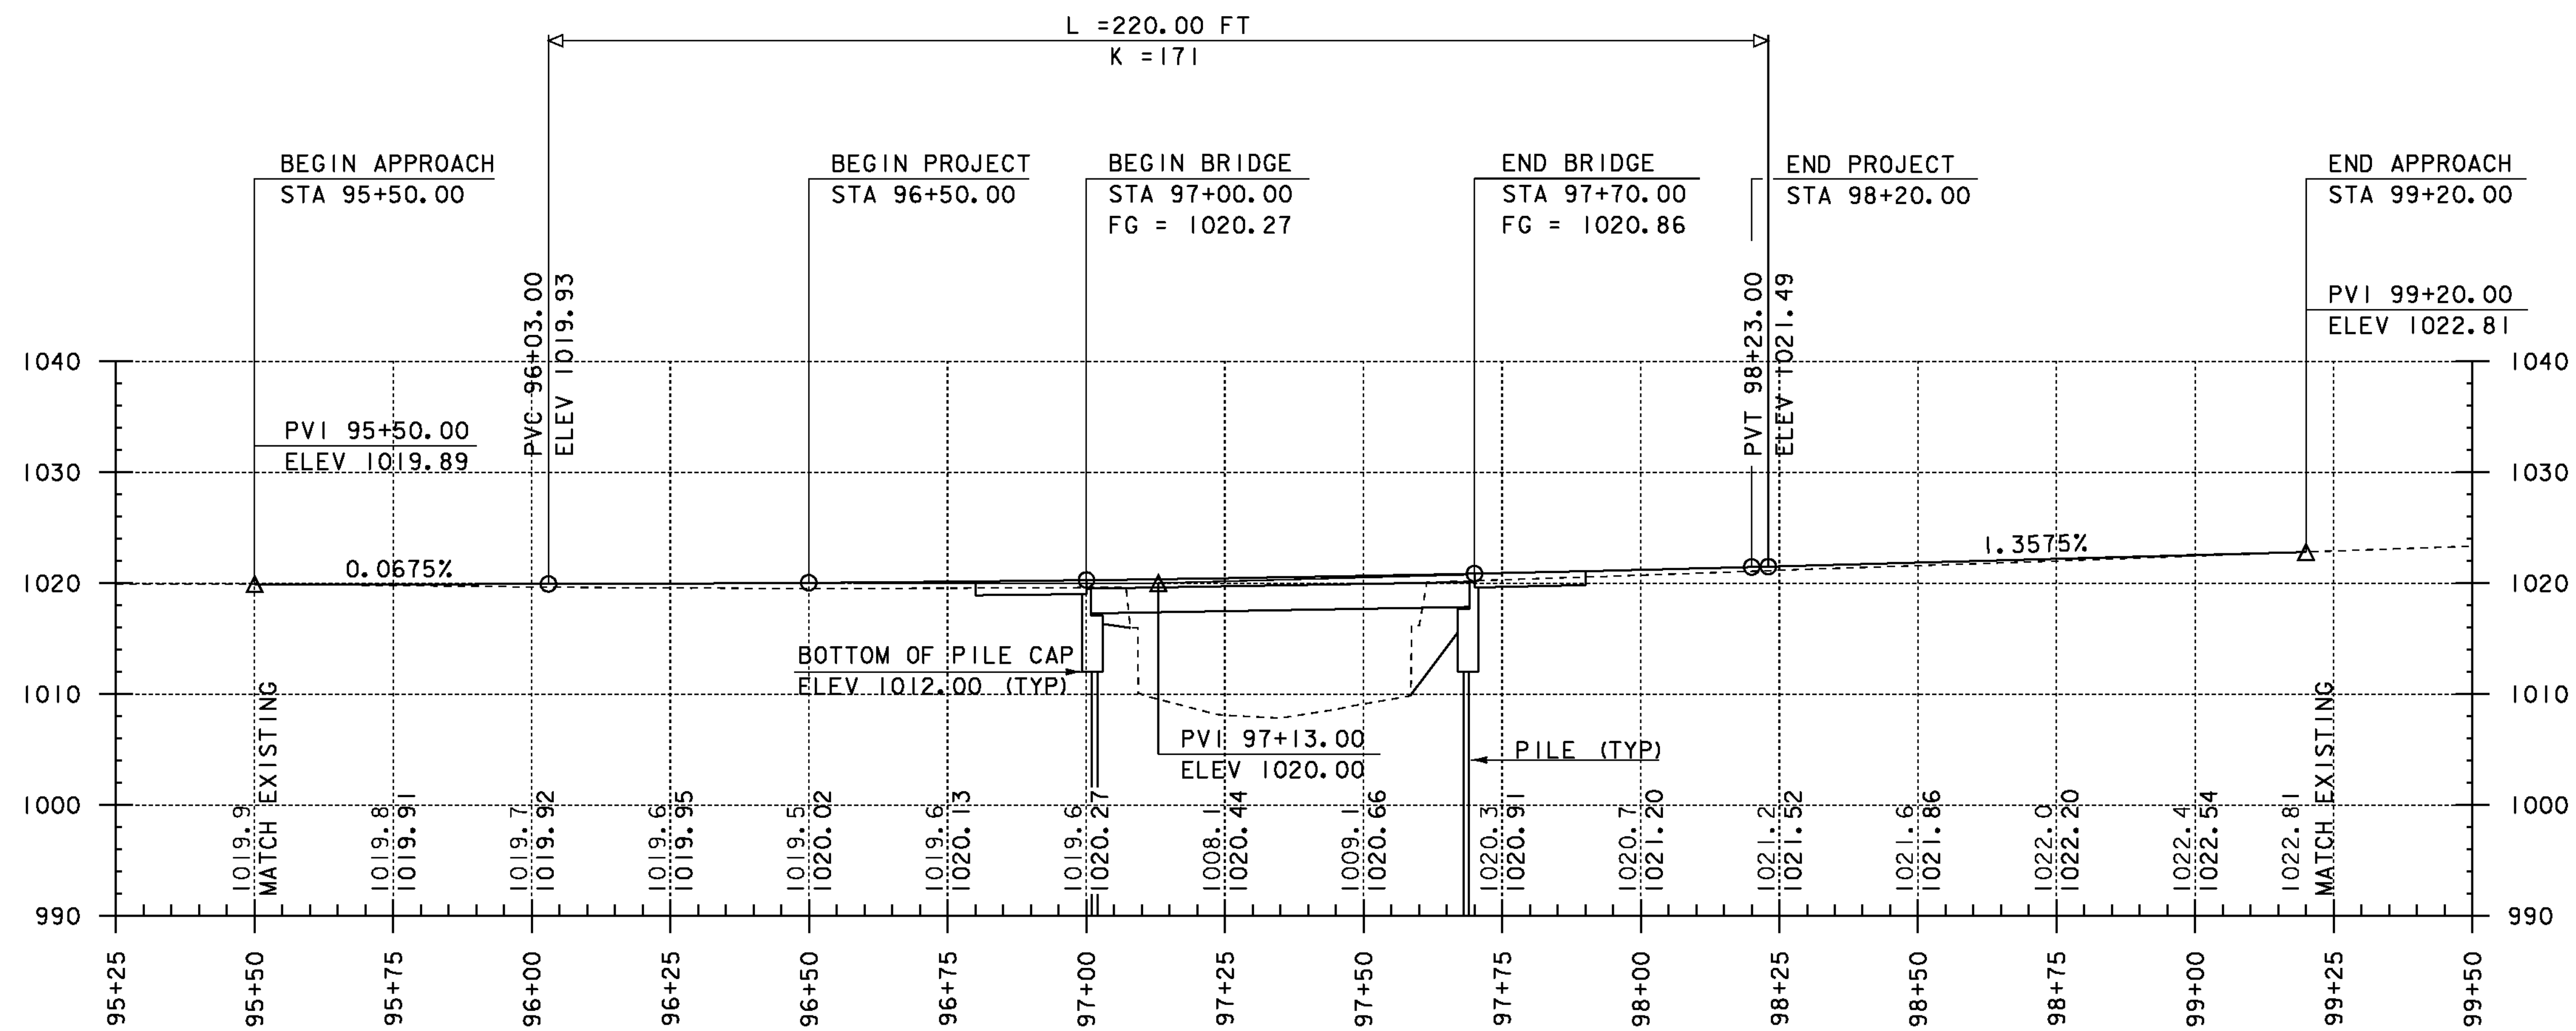

MAINLINE PROFILE


HORIZONTAL SCALE 1" = 20'-0"
 VERTICAL SCALE 1" = 10'-0"

THE GRADES SHOWN TO THE NEAREST TENTH ARE THE ORIGINAL GROUND ELEVATIONS ALONG THE PROPOSED ALIGNMENT.
 THE GRADES SHOWN TO THE NEAREST HUNDREDTH ARE THE FINISH GRADES ALONG THE PROPOSED ALIGNMENT.

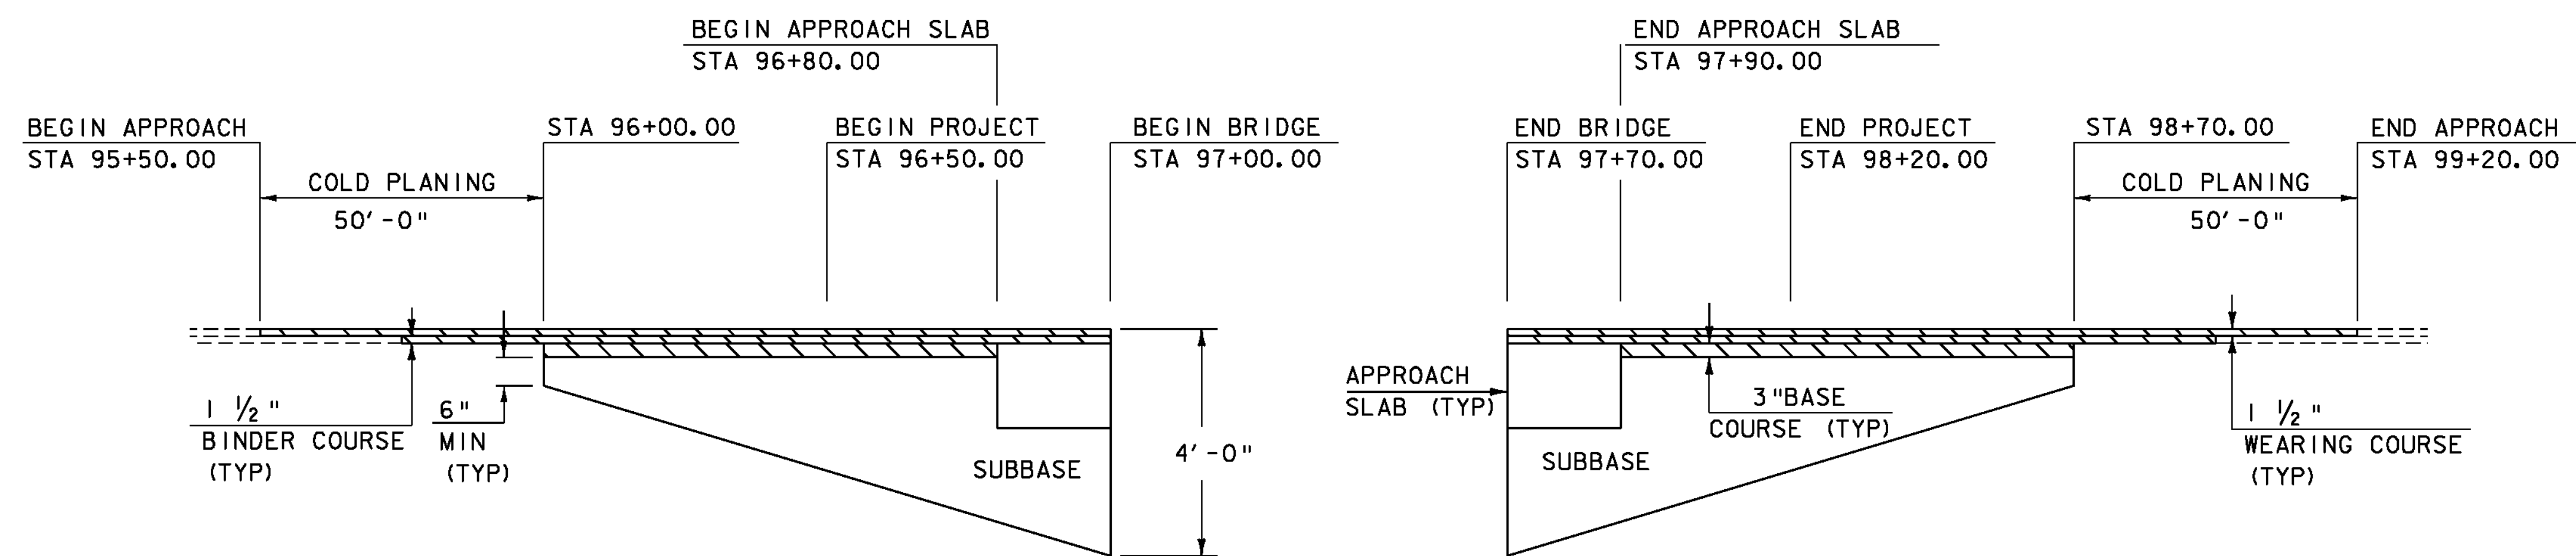

MATERIAL TRANSITION

HORIZONTAL SCALE 1" = 20'-0"
 VERTICAL SCALE 1/2" = 1'-0"

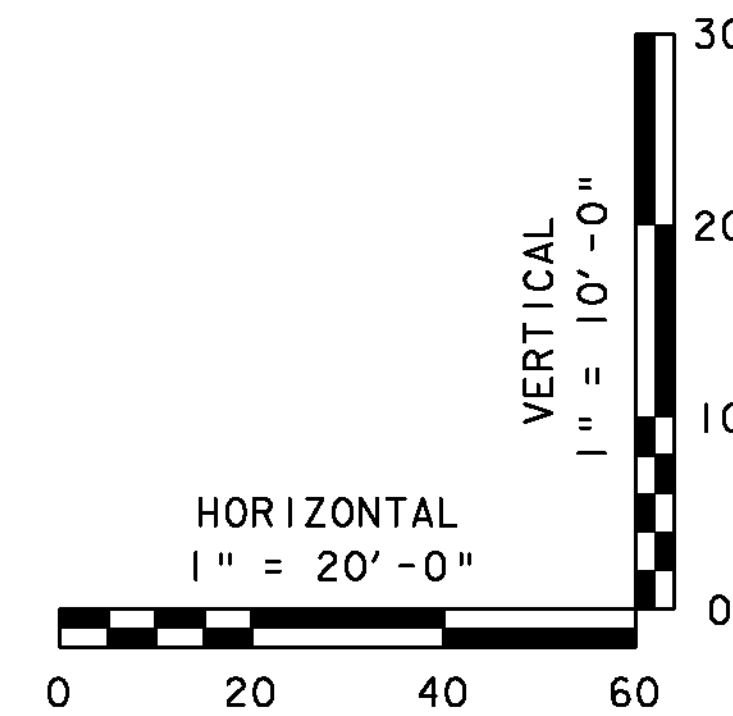

PROJECT NAME: EAST HAVEN	PLOT DATE: 08-AUG-2011
PROJECT NUMBER: BRF 0269(II)	DRAWN BY: R. PELLETT
FILE NAME: s00cl62pro.dgn	CHECKED BY: J. LACROIX
DESIGNED BY: J. LACROIX	SHEET 10 OF 40
MAINLINE PROFILE	

STONE FILL, TYPE II
 STA 95+65.00 - 96+95.50 RT
 STA 97+79.50 - 98+32.95 RT

REMOVAL OF EXISTING FENCE
 STA 97+61 - STA 98+50 RT
 (SEE GENERAL NOTES)



REMOVAL AND DISPOSAL OF GUARDRAIL
 STA 96+32 - STA 97+07 RT
 STA 96+60 - STA 97+07 LT
 STA 97+61 - STA 98+21 RT
 STA 97+61 - STA 98+36 LT

MANUFACTURED TERMINAL SECTION, TANGENT
 STA 95+72 - STA 95+86 RT
 STA 96+38 - STA 96+52 LT
 STA 98+18 - STA 98+32 LT
 STA 98+18 - STA 98+32 RT

**SPECIAL PROVISION (BRIDGE RAILING,
 GALVANIZED 3 RAIL BOX BEAM)**
 STA 96+99 - STA 97+71 LT & RT

**SPECIAL PROVISION (GUARDRAIL APPROACH
 SECTION, GALVANIZED 3 RAIL BOX BEAM)**
 STA 96+67 - STA 96+99 LT & RT
 STA 97+71 - STA 98+03 LT & RT

**SPECIAL PROVISION (BOX BEAM
 GUARDRAIL, W/ 8 FT POSTS)**
 STA 95+86 - STA 96+67 RT
 STA 96+52 - STA 96+67 LT
 STA 98+03 - STA 98+18 LT
 STA 98+03 - STA 98+18 RT

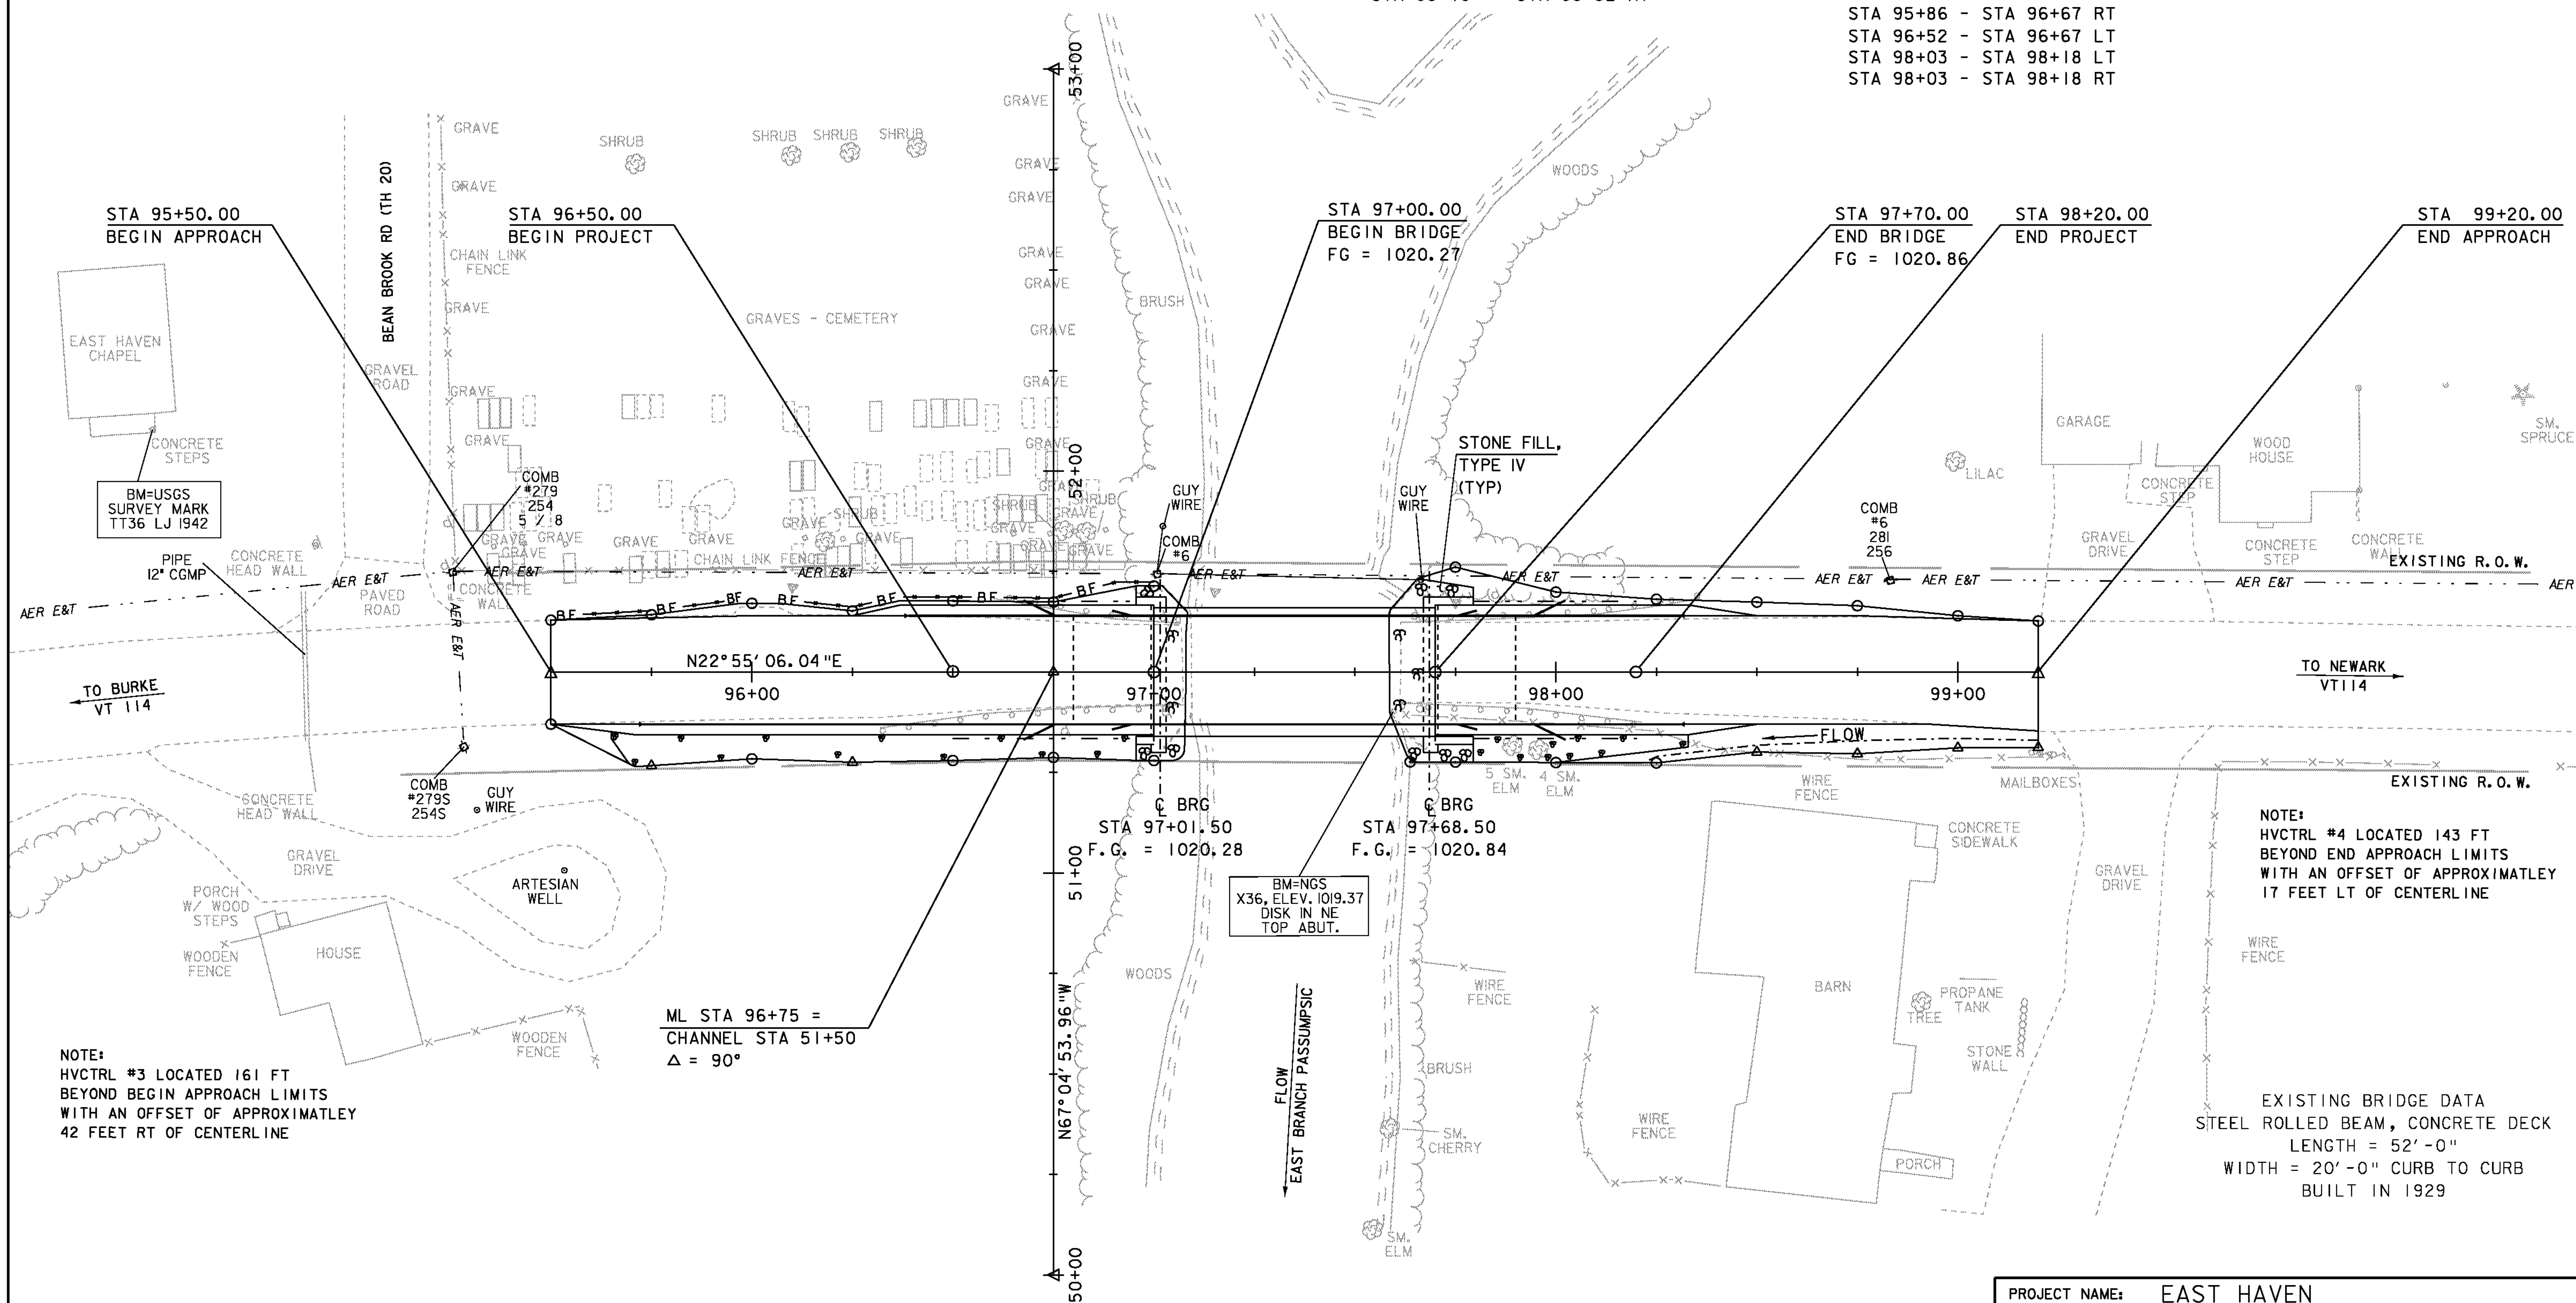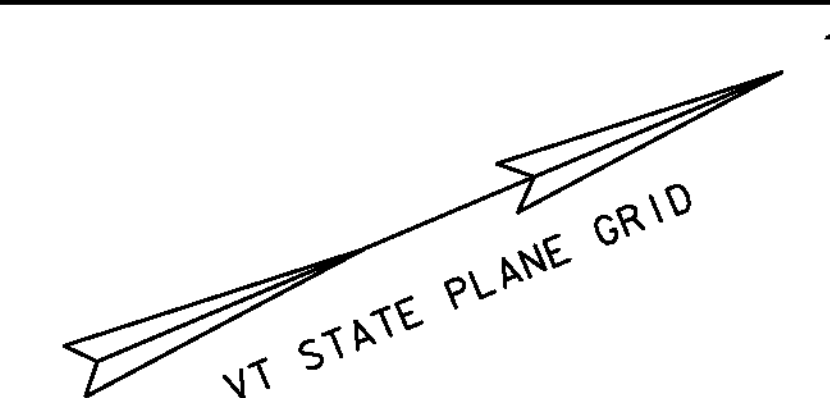

NOTE:
 HVCTRL #3 LOCATED 161 FT
 BEYOND BEGIN APPROACH LIMITS
 WITH AN OFFSET OF APPROXIMATELY
 42 FEET RT OF CENTERLINE

ML STA 96+75 =
 CHANNEL STA 51+50
 Δ = 90°

NOTE:
 HVCTRL #4 LOCATED 143 FT
 BEYOND END APPROACH LIMITS
 WITH AN OFFSET OF APPROXIMATELY
 17 FEET LT OF CENTERLINE

EXISTING BRIDGE DATA
 STEEL ROLLED BEAM, CONCRETE DECK
 LENGTH = 52'-0"
 WIDTH = 20'-0" CURB TO CURB
 BUILT IN 1929

LAYOUT SHEET

SCALE 1" = 20'-0"
 20 0 20

PROJECT NAME:	EAST HAVEN
PROJECT NUMBER:	BRF 0269(II)
FILE NAME:	s00cl62bdr.dgn
PROJECT LEADER:	K. HIGGINS
DESIGNED BY:	J. LACROIX
LAYOUT SHEET	
PLOT DATE:	08-AUG-2011
DRAWN BY:	R. PELLET
CHECKED BY:	J. LACROIX
SHEET	9 OF 40

GPS CONTROL POINTS

HCTRL # 1

STANDARD DISK STAMPED
RIVERS

N = 790777.775
E = 1799982.453

GENERAL LOCATION - EAST HAVEN, VT
TO REACH FROM THE INTERSECTION OF VT ROUTE 114 AND US ROUTE 5 IN LYNDONVILLE GO NORTH
NORTHEAST ALONG VT ROUTE 114 FOR 4.7 MI (7.6 KM) TO THE INTERSECTION OF BURKE MOUNTAIN ROAD
RIGHT. CONTINUE STRAIGHT ALONG VT ROUTE 114 FOR 6.5 MI (10.5 KM) TO THE MARK ON THE RIGHT.
THE MARK IS LOCATED 6.8 M (22.3 FT) EAST SOUTHEAST OF AND 0.5 M (1.6 FT) LOWER THAN THE
CENTERLINE OF VT ROUTE 114, 25.1 M (82.3 FT) SOUTH SOUTHEAST OF POLE 261/286, 52.4 M (171.9 FT)
NORTH NORTHEAST OF THE MOST NORTHERLY GRAVEL DRIVE TO HOUSE 2024, 0.6 M (2.0 FT) NORTHWEST OF A
FENCE LINE, AND 0.6 M (2.0 FT) WEST OF A FIBERGLASS WITNESS POST.

HVCTRL #2


STANDARD DISK STAMPED
RIVERS AZ MK

N = 789166.456
E = 1799368.163
ELEV. = 1018.170

GENERAL LOCATION - EAST HAVEN, VT OWNERSHIP - SCOTT RIVERS
TO REACH FROM THE INTERSECTION OF VT ROUTE 114 AND US ROUTE 5 IN LYNDONVILLE GO NORTH
NORTHEAST ALONG VT ROUTE 114 FOR 4.7 MI (7.6 KM) TO THE INTERSECTION OF BURKE MOUNTAIN ROAD
RIGHT. CONTINUE STRAIGHT ALONG VT ROUTE 114 FOR 6.1 MI (9.8 KM) TO THE MARK ON THE LEFT SET IN
THE TOP OF A 0.6 M (2.0 FT) X 0.6 M (2.0 FT) ROCK OUTCROP. THE MARK IS LOCATED 7.5 M (24.6 FT)
WEST NORTHWEST OF AND ABOUT LEVEL WITH THE CENTERLINE OF VT ROUTE 114, 36.4 M (119.4 FT)
NORTHEAST OF POLE 251/6/276, 5.8 M (19.0 FT) SOUTH SOUTHWEST OF POLE 6/277/252, AND 2.4 M (7.9
FT) SOUTH SOUTHWEST OF A FENCE AND FIBERGLASS WITNESS POST.

- TO ALLOW THE STATE PLANE COORDINATES TO FIT THE AGENCY DESIGN PLANE, SUBTRACT 700,000 FROM THE NORTING AND SUBTRACT 1,700,000 FROM THE EASTING.
- DESCRIPTION PROVIDED BY VERMONT AGENCY OF TRANSPORTATION GEODETIC SURVEY UNIT

TRAVERSE TIES

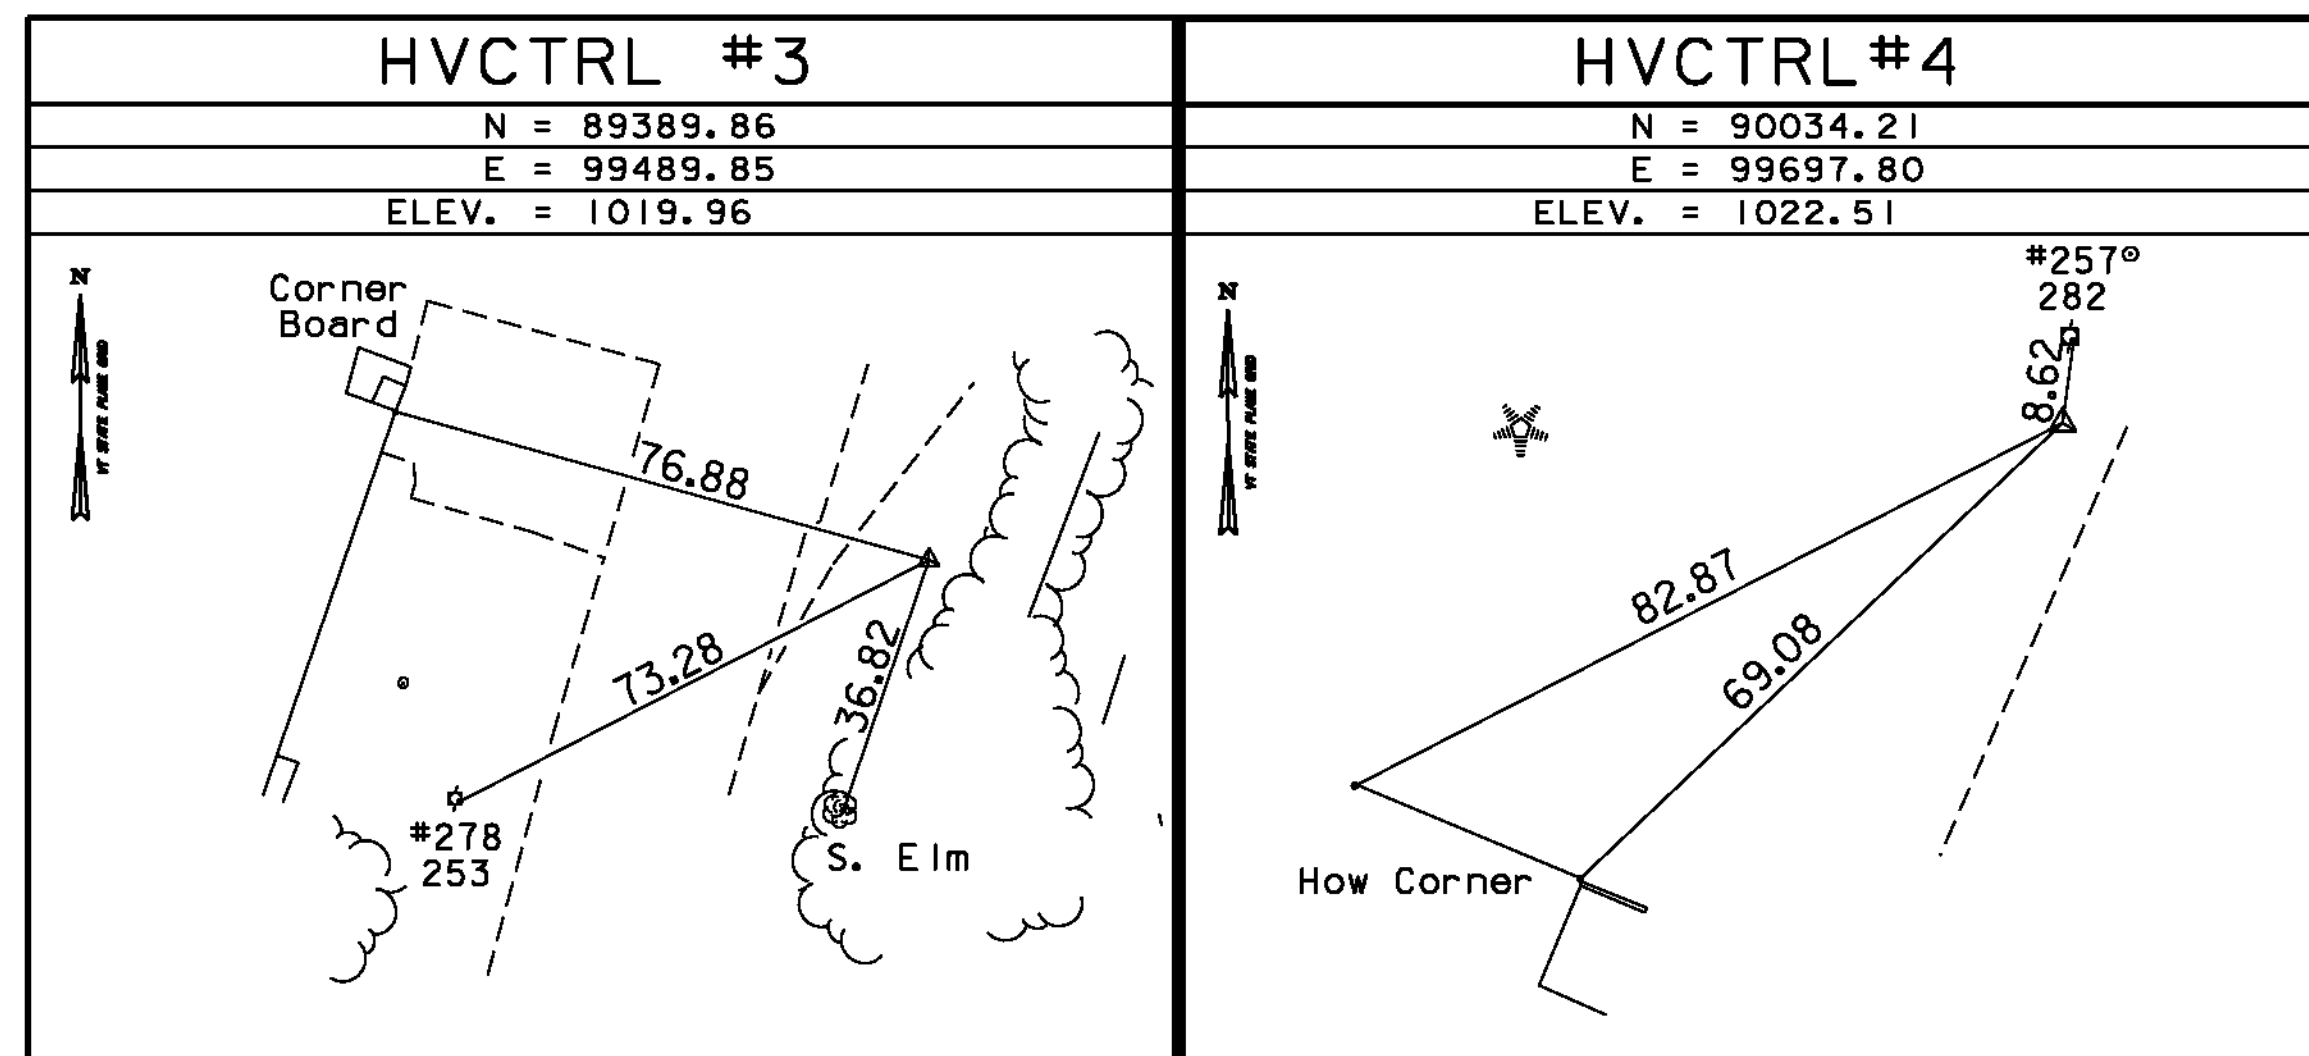

• MAIN TRAVERSE COMPLETED 11/14/00 by R. Gilman P.C. R. Bullock & J. Hulett

ALIGNMENT COORD


ALIGNMENT CURRENT AS OF 1/7/2011

MAIN LINE VT 114


POB 95+50.00 89554.76 99514.03
 POE 99+20.00 89895.56 99658.12
 TANGENT DIRECTION N 22°55'06" E
 TANGENTIAL LENGTH 370.00

DATUM	
VERTICAL	NAVD 88
HORIZONTAL	NAD 83/96
ADJUSTMENT	COMPASS


PROJECT NAME: EAST HAVEN	
PROJECT NUMBER: BRF 0269(II)	
FILE NAME: 00c162/survey/xcl62t1.dgn	PLOT DATE: 08-AUG-2011
PROJECT LEADER: K. HIGGINS	DRAWN BY: R. Bullock
DESIGNED BY: SURVEY	CHECKED BY: SURVEY
TIE SHEET	SHEET 8 OF 40

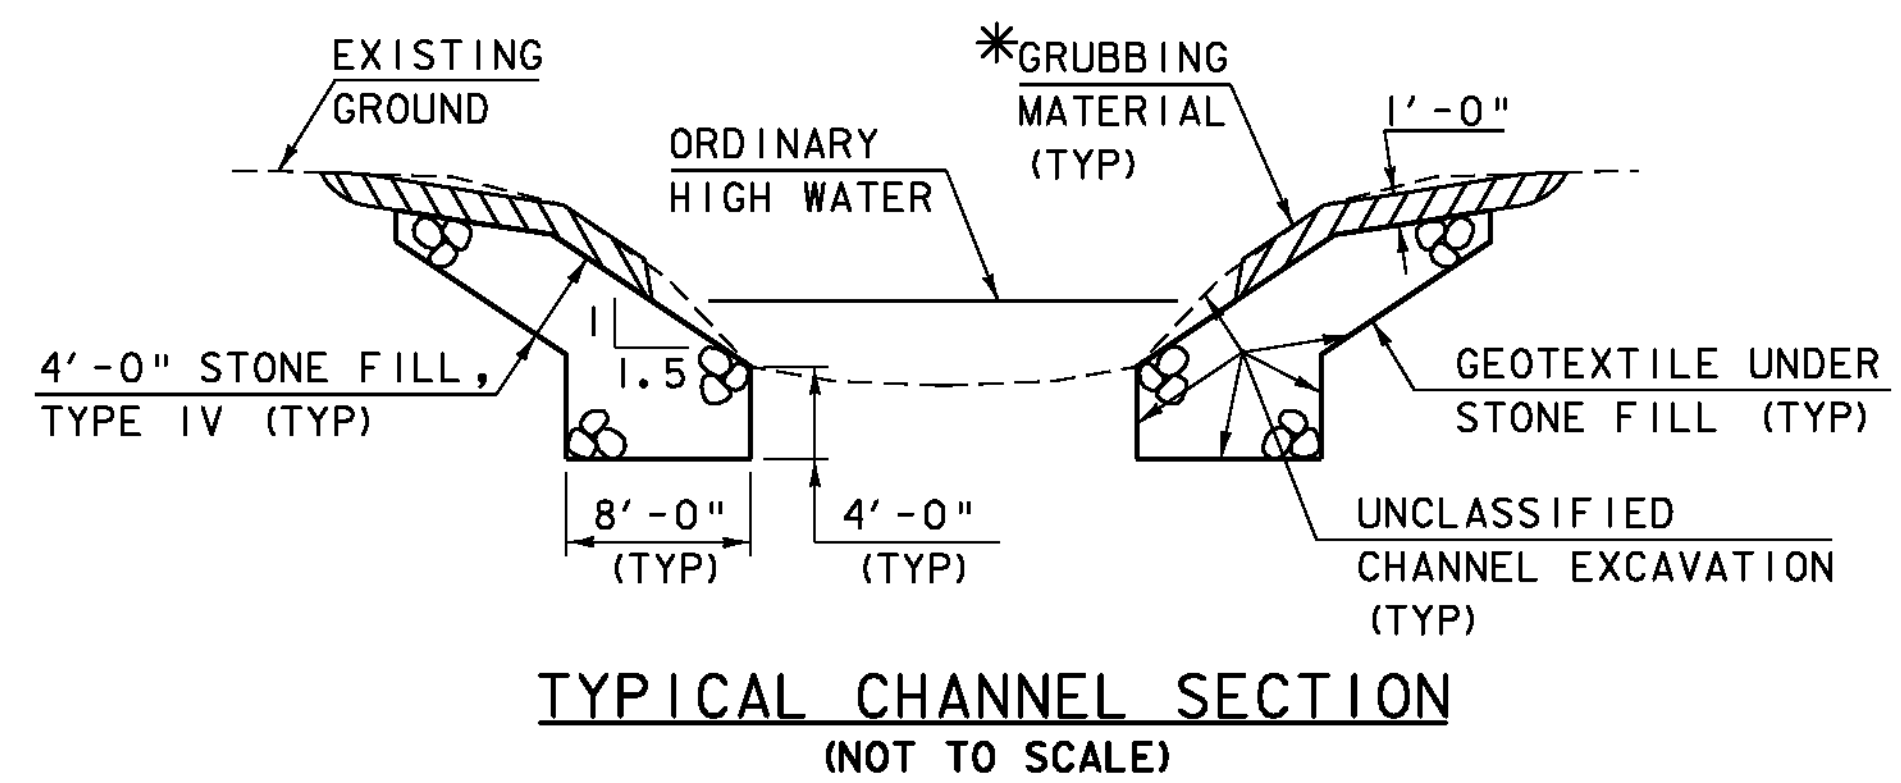

*GRUBBING MATERIAL SHALL NOT BE PLACED ON THE STONE FILL IN THE AREA UNDER THE BRIDGE. WHENEVER CHANNEL SLOPE INTERSECTS ROADWAY SUBBASE, GRUBBING MATERIAL SHALL BEGIN AT THE BOTTOM OF SUBBASE.

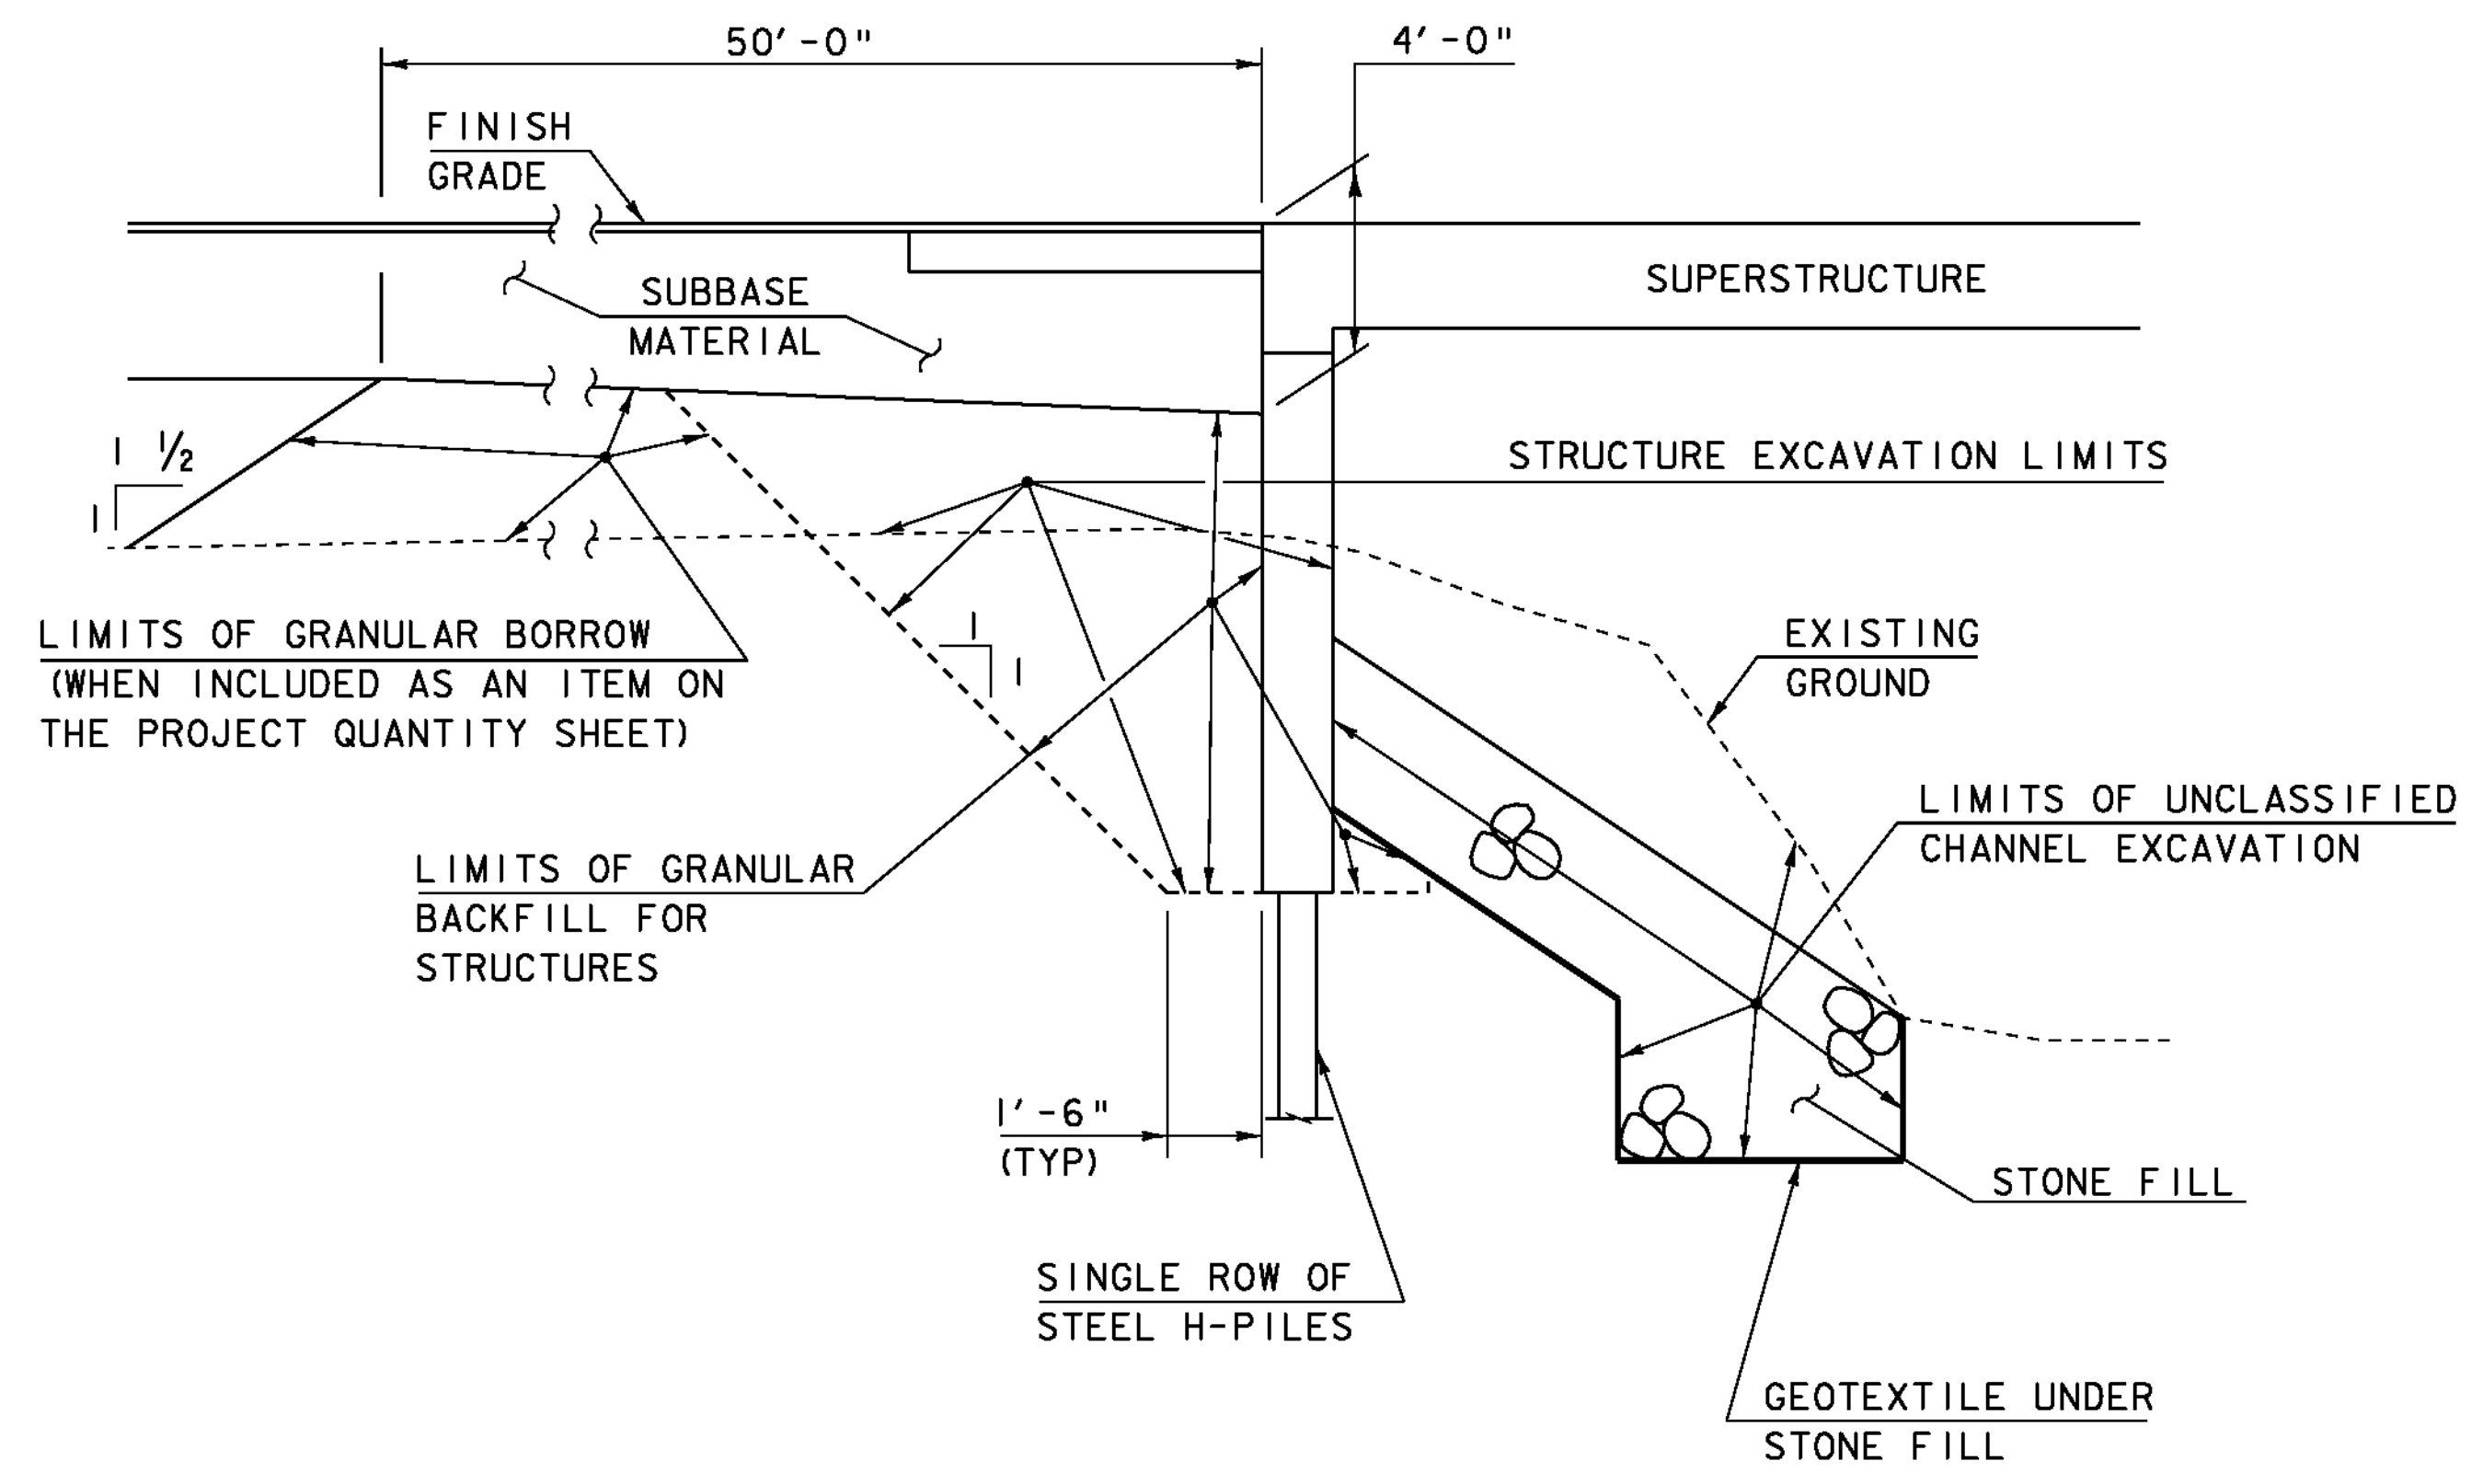

ACTUAL LIMITS OF STRUCTURE EXCAVATION SHALL BE DETERMINED BY THE CONTRACTOR. HOWEVER, ONLY THE EXCAVATION BETWEEN THE LIMITS SHOWN WILL BE PAID FOR UNDER THE ITEM 204.25 "STRUCTURE EXCAVATION". EXCAVATION BY THE CONTRACTOR OUTSIDE OF THESE LIMITS WILL BE AT THE EXPENSE OF THE CONTRACTOR.

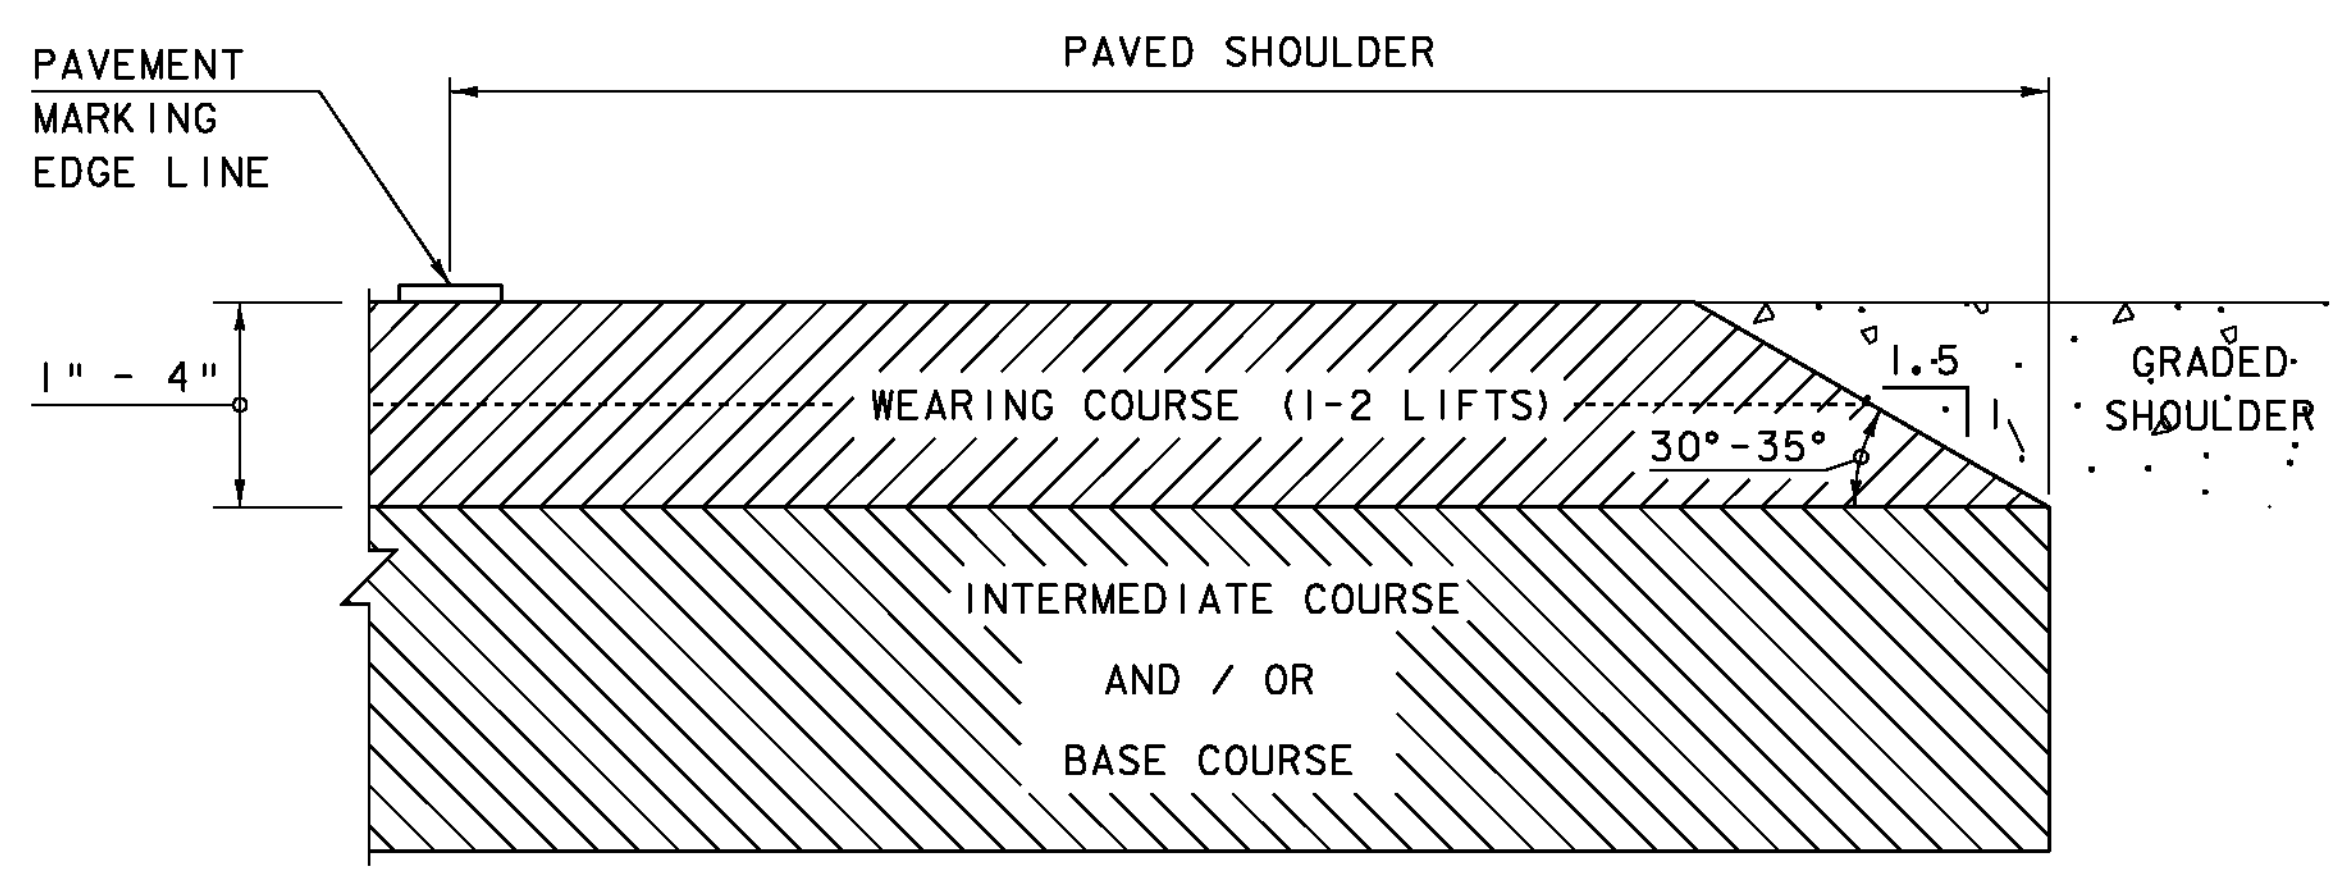

NOTE: LEVELING COURSE MAY INCLUDE THE "SAFETY EDGE" AT THE CONTRACTOR'S CHOICE.

PROJECT NAME:	EAST HAVEN
PROJECT NUMBER:	BRF 0269(II)
FILE NAME:	s00cl62+yp.dgn
PROJECT LEADER:	K. HIGGINS
DESIGNED BY:	J. LACROIX
TYPICAL SECTIONS #2	
PLOT DATE:	08-AUG-2011
DRAWN BY:	R. PELLETT
CHECKED BY:	J. LACROIX
SHEET	7 OF 40


MATERIAL TOLERANCES

(IF USED ON PROJECT)

SURFACE	
- PAVEMENT (TOTAL THICKNESS)	+/- 1/4"
- AGGREGATE SURFACE COURSE	+/- 1/2"
SUBBASE	+/- 1"
SAND BORROW	+/- 1"


NOTE:
SEE SECTION 490 OF THE GENERAL SPECIAL PROVISIONS AND SPECIAL PROVISIONS FOR PG BINDER REQUIREMENTS.

- * 1 1/2" SUPERPAVE BITUMINOUS CONCRETE PAVEMENT, TYPE IVS
- 1 1/2" SUPERPAVE BITUMINOUS CONCRETE PAVEMENT, TYPE IVS
- 3" SUPERPAVE BITUMINOUS CONCRETE PAVEMENT, TYPE IIS
- VARIES SUBBASE OF DENSE GRADED CRUSHED STONE

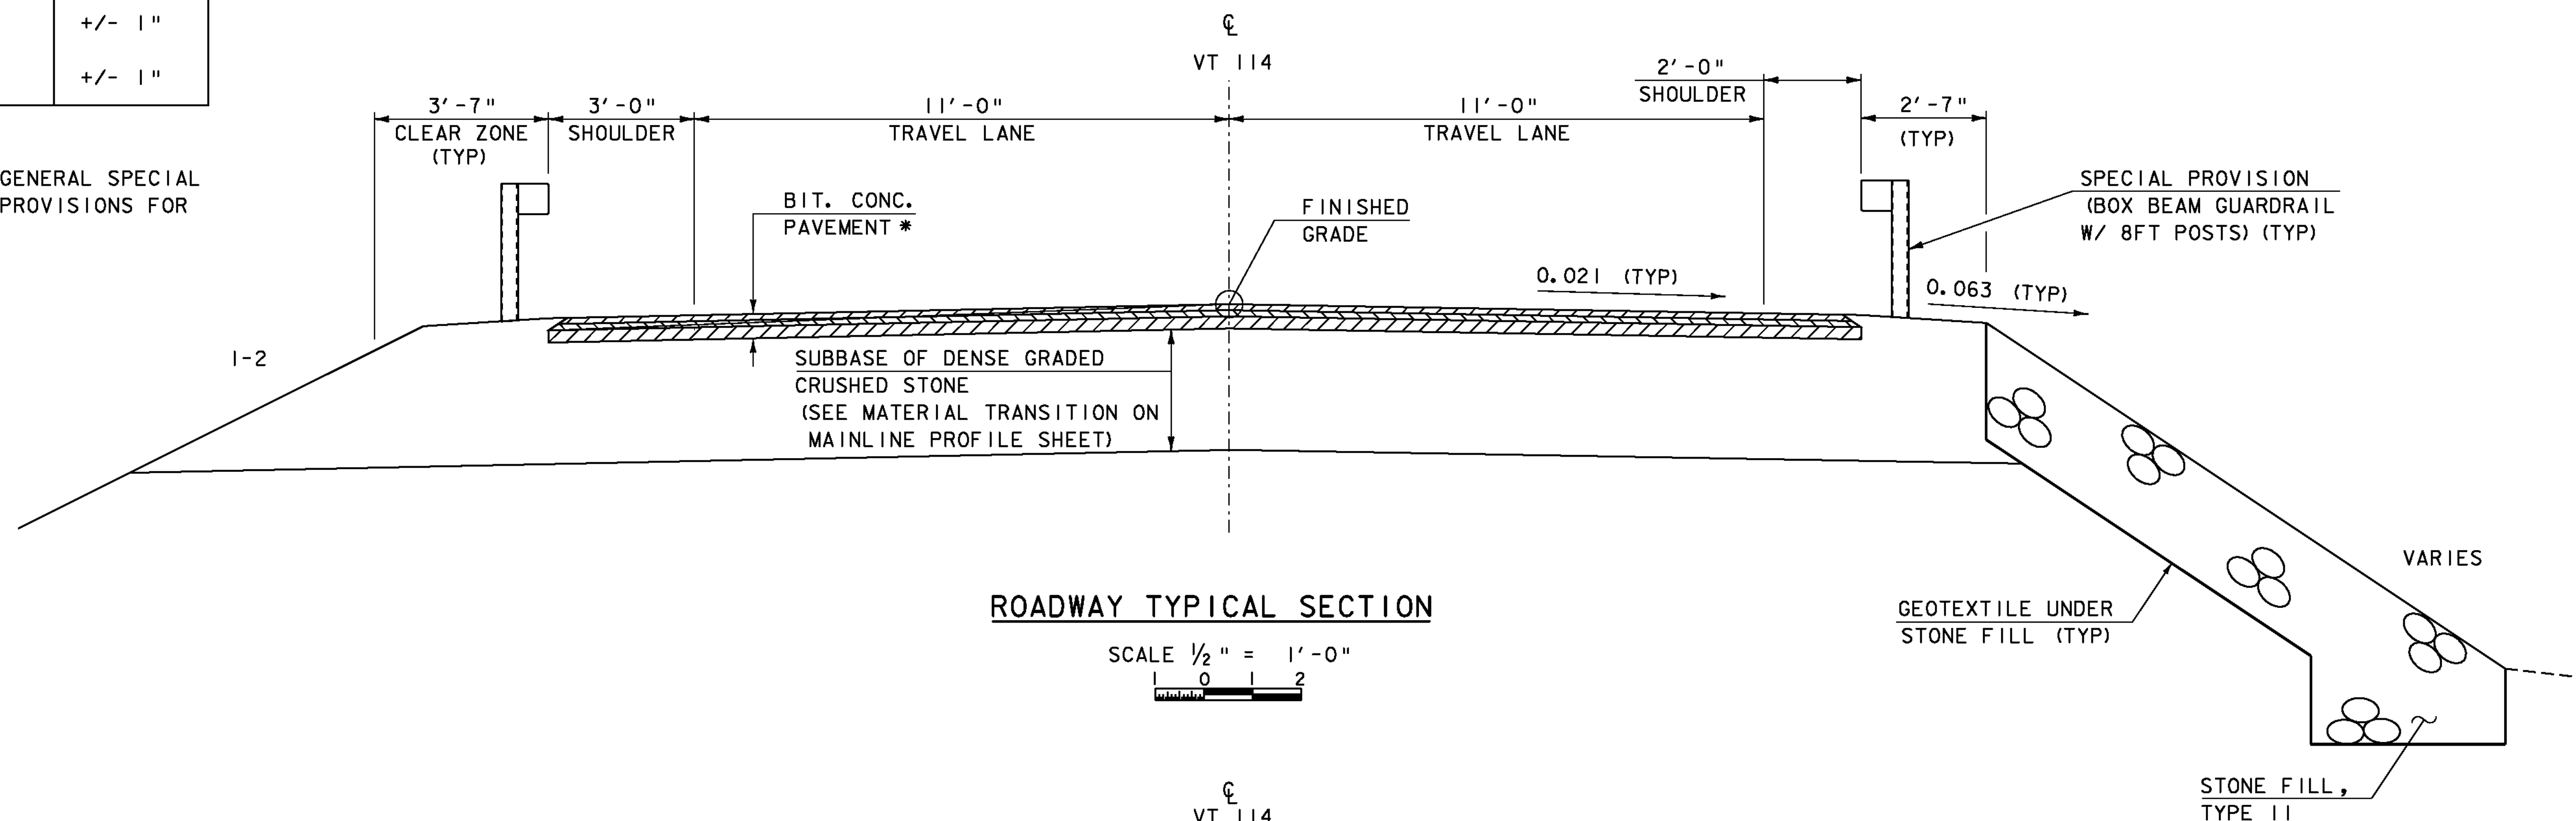

ROADWAY TYPICAL SECTION

SCALE 1/2" = 1'-0"
0 1 2

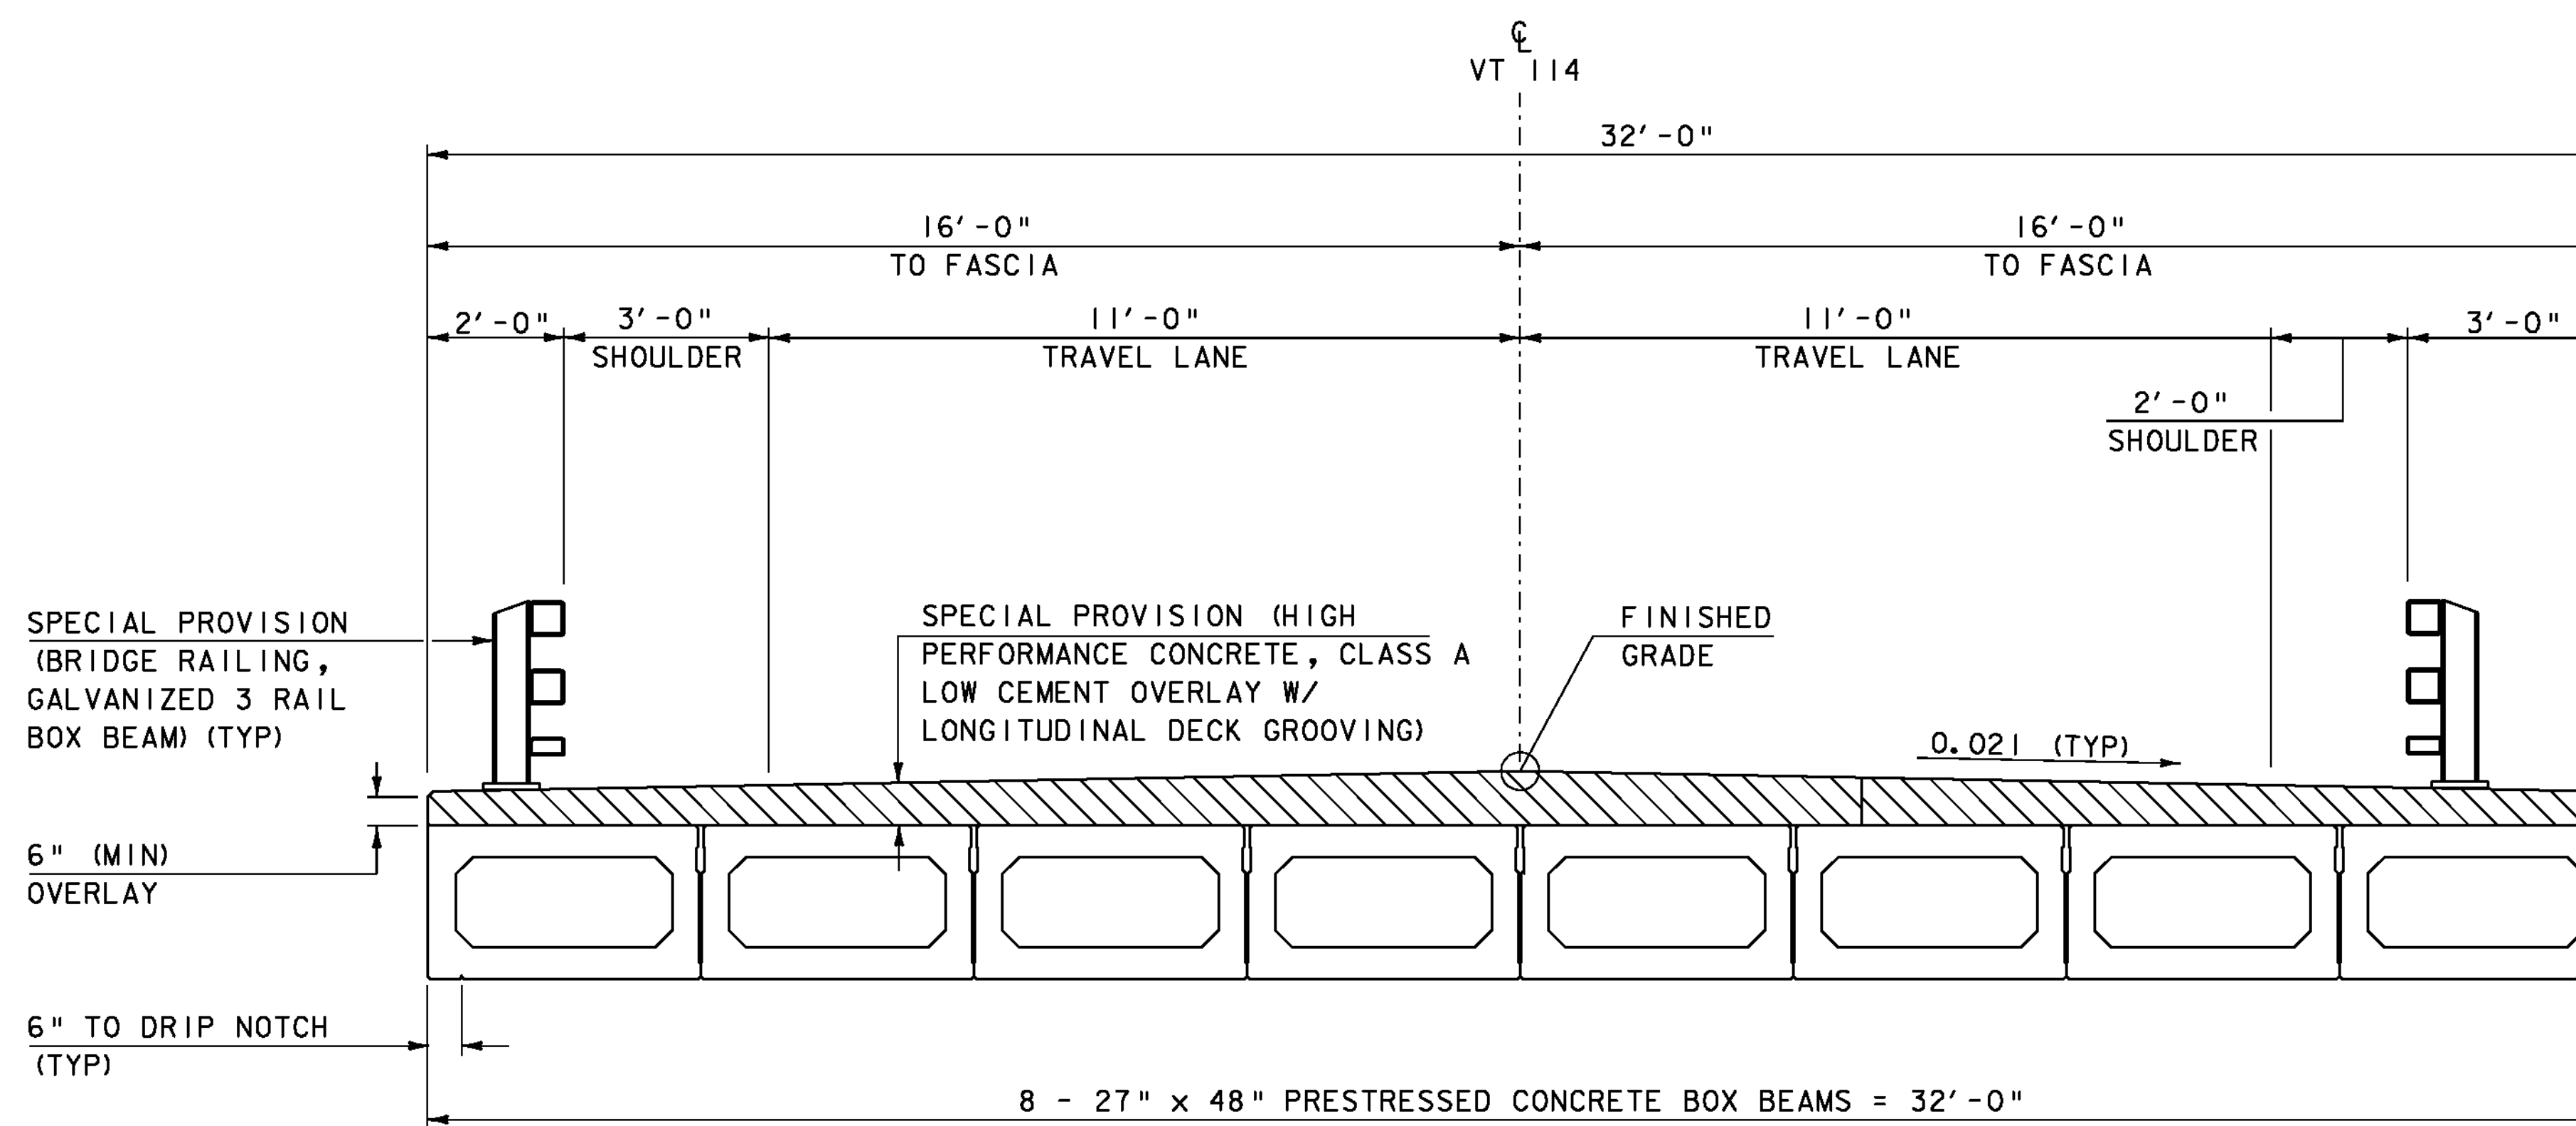

BRIDGE TYPICAL SECTION

SCALE 1/2" = 1'-0"
0 1 2

PROJECT NAME: EAST HAVEN
PROJECT NUMBER: BRF 0269(II)

FILE NAME: s00cl62+yp.dgn
PROJECT LEADER: K. HIGGINS
DESIGNED BY: J. LACROIX
TYPICAL SECTIONS #1

PLOT DATE: 08-AUG-2011
DRAWN BY: R. PELLETT
CHECKED BY: J. LACROIX
SHEET 6 OF 40

QUANTITY SHEET 2

SUMMARY OF ESTIMATED QUANTITIES										TOTALS		DESCRIPTIONS				DETAILED SUMMARY OF QUANTITIES		
					ROADWAY	EMPLOYEE TRAINEESHIP	EROSION CONTROL	BRIDGE	FULL C E	GRAND TOTAL	FINAL	UNIT	ITEMS	ITEM NUMBER	ROUND	QUANTITIES	UNIT	ITEMS
					740					740		LF	DURABLE 4 INCH WHITE LINE (FPQ)	646.400				
					740					740		LF	DURABLE 4 INCH YELLOW LNE (FPQ)	646.410				
							300			300		SY	GEOTEXTILE UNDER STONE FILL	649.31				
							200			200		SY	GEOTEXTILE FOR SILT FENCE, WOVEN WIRE REINFORCED	649.515				
							60			60		SY	GEOTEXTILE FOR FILTER CURTAIN	649.61				
							5			5		LB	SEED	651.15				
							5			5		LB	SEED, WINTER RYE	651.17				
							40			40		LB	FERTILIZER	651.18				
							0.25			0.25		TON	AGRICULTURAL LIMESTONE	651.20				
							0.25			0.25		TON	HAY MULCH	651.25				
							25			25		CY	TOPSOIL	651.35				
							50			50		SY	GRUBBING MATERIAL	651.40				
							1			1		LS	EPSC PLAN	652.10				
							50			50		HR	MONITORING EPSC PLAN	652.20				
							1			1		LU	MAINTENANCE OF EPSC PLAN (N.A.B.1)	652.30				
							25			25		SY	TEMPORARY EROSION MATTING	653.20				
							15			15		CY	TEMPORARY STONE CHECK DAM, TYPE I	653.25				
							120			120		CY	VEHICLE TRACKING PAD	653.35				
							140			140		LF	BARRIER FENCE	653.50				
							465			465		LF	PROJECT DEMARCATION FENCE	653.55				
					0.66					0.66		SF	TRAFFIC SIGNS, TYPE A	675.20				
					20					20		LF	SQUARE TUBE SIGN POST AND ANCHOR	675.341				
					8					8		EACH	REMOVING SIGNS	675.50				
								62		62		CY	SPECIAL PROVISION (HIGH PERFORMANCE CONCRETE, CLASS A LOW CEMENT)	900.608				
								4		4		EACH	SPECIAL PROVISION (GUARDRAIL APPROACH SECTION, GALVANIZED 3 RAIL BOX BEAM)	900.620				
					126					126		LF	SPECIAL PROVISION (BOX BEAM GUARDRAIL W/8 FEET POSTS) (FPQ)	900.640				
								144		144		LF	SPECIAL PROVISION (BRIDGE RAILING, GALVANIZED 3 RAIL BOX BEAM) (FPQ)	900.640				
								1		1		LS	SPECIAL PROVISION (TEMPORARY BRIDGE WIDENING FOR PHASE CONSTRUCTION)	900.645				
					1					1		LS	SPECIAL PROVISION (TRAFFIC CONTROL, ALL-INCLUSIVE)	900.645				
								210		210		SY	SPECIAL PROVISION (LONGITUDINAL DECK GROOVING) (FPQ)	900.675				

PROJECT NAME: EAST HAVEN
PROJECT NUMBER: BRF 0269(II)

FILE NAME: s00cl62qs.xls
PROJECT LEADER: K. HIGGINS
DESIGNED BY: J. LACROIX
QUANTITY SHEET - 2

PLOT DATE: 08-AUG-2011
DRAWN BY: R. PELLETT
CHECKED BY: J. LACROIX
SHEET 5 OF 40

QUANTITY SHEET 1

SUMMARY OF ESTIMATED QUANTITIES										TOTALS		DESCRIPTIONS				DETAILED SUMMARY OF QUANTITIES		
					ROADWAY	EMPLOYEE TRAINEESHIP	EROSION CONTROL	BRIDGE	FULL C E	GRAND TOTAL	FINAL	UNIT	ITEMS	ITEM NUMBER	ROUND	QUANTITIES	UNIT	ITEMS
					1					1		LS	CLEARING AND GRUBBING, INCLUDING INDIVIDUAL TREES AND STUMPS	201.10				
					585					585		CY	COMMON EXCAVATION	203.15				
					250					250		CY	UNCLASSIFIED CHANNEL EXCAVATION	203.27				
					1					1		CY	TRENCH EXCAVATION OF EARTH, EXPLORATORY (N.A.B.I.)	204.22				
								230		230		CY	STRUCTURE EXCAVATION	204.25				
								110		110		CY	GRANULAR BACKFILL FOR STRUCTURES	204.30				
					300					300		SY	COLD PLANING, BITUMINOUS PAVEMENT	210.10				
					465					465		CY	SUBBASE OF DENSE GRADED CRUSHED STONE	301.35				
					1					1		CWT	EMULSIFIED ASPHALT	404.65				
					1					1		LU	PRICE ADJUSTMENT, ASPHALT CEMENT (N.A.B.I.)	406.50				
					200					200		TON	SUPERPAVE BITUMINOUS CONCRETE PAVEMENT	490.30				
					1					1		LU	MAT DENSITY PAY ADJUSTMENT (N.A.B.I.)	490.32				
								118		118		CY	CONCRETE, HIGH PERFORMANCE CLASS B (FPQ)	501.34				
								1		1		LS	FURNISHING EQUIPMENT FOR DRIVING PILING	504.10				
								390		390		LF	STEEL PILING FOR INTEGRAL ABUTMENTS, HP 14 X 102	505.29				
								2		2		EACH	DYNAMIC PILE LOADING TEST	505.45				
								9800		9800		LB	REINFORCING STEEL (FPQ)	507.15				
								13100		13100		LB	EPOXY COATED REINFORCING STEEL (FPQ)	507.17				
								227		227		EACH	MECHANICAL BAR CONNECTOR (#5)	507.19				
								560		560		LF	PRESTRESSED CONCRETE BOX BEAMS (27" X 48") (FPQ)	510.21				
								490		490		LF	GROUTING SHEAR KEYS (FPQ)	510.24				
								30		30		GAL	WATER REPELLENT, SILANE	514.10				
								54		54		LF	BRIDGE EXPANSION JOINT, ASPHALTIC PLUG (FPQ)	516.10				
								1		1		LS	MAINTENANCE OF STRUCTURES AND APPROACHES	527.10				
					120					120		SY	REMOVAL OF BRIDGE PAVEMENT	529.10				
					1					1		EACH	REMOVAL OF STRUCTURE (1040 SF - EST.)	529.15				
								8		8		EACH	BEARING DEVICE ASSEMBLY, ELASTOMERIC PAD (11 1/2" X 11 1/2")	531.11				
								16		16		EACH	BEARING DEVICE ASSEMBLY, ELASTOMERIC PAD (5 3/4" X 11 1/2")	531.11				
					125					125		CY	STONE FILL, TYPE II	613.11				
					150					150		CY	STONE FILL, TYPE IV	613.13				
					89					89		LF	REMOVAL OF EXISTING FENCE	620.55				
					4					4		EACH	MANUFACTURED TERMINAL SECTION, TANGENT	621.61				
					257					257		LF	REMOVAL AND DISPOSAL OF GUARDRAIL	621.80				
					3000					3000		HR	FLAGGERS	630.15				
									1	1		LS	FIELD OFFICE, ENGINEERS	631.10				
									1	1		LS	TESTING EQUIPMENT, CONCRETE	631.16				
									1	1		LS	TESTING EQUIPMENT, BITUMINOUS	631.17				
								3000		3000		DL	FIELD OFFICE TELEPHONE (N.A.B.I.)	631.26				
						520				520		HR	EMPLOYEE TRAINEESHIP	634.10				
					1					1		LS	MOBILIZATION/DEMOBILIZATION	635.11				

PROJECT NAME: EAST HAVEN
PROJECT NUMBER: BRF 0269(II)
FILE NAME: s00cl62qs.xls
PROJECT LEADER: K. HIGGINS
DESIGNED BY: J. LACROIX
QUANTITY SHEET - 1
PLOT DATE: 08-AUG-2011
DRAWN BY: R. PELLETT
CHECKED BY: J. LACROIX
SHEET 4 OF 40

GENERAL

- 1. ALL MATERIALS AND CONSTRUCTION SHALL CONFORM TO THE STATE OF VERMONT, AGENCY OF TRANSPORTATION STANDARD SPECIFICATIONS FOR CONSTRUCTION, DATED 2006, AND ITS LATEST REVISIONS, THE AASHTO LRFD BRIDGE DESIGN SPECIFICATIONS FIFTH EDITION, AND ITS LATEST REVISIONS AND THE AASHTO LRFD BRIDGE CONSTRUCTION SPECIFICATIONS, THIRD EDITION, AND ITS LATEST REVISIONS.
- 2. ALL DIMENSIONS SHOWN IN THE PLANS ARE HORIZONTAL OR VERTICAL AND ARE GIVEN AT 68 DEGREES FAHRENHEIT, UNLESS NOTED OTHERWISE.
- 3. ITEM 529.15 "REMOVAL OF STRUCTURE" IS FOR THE REMOVAL OF THE EXISTING SUPERSTRUCTURE, INCLUDING THE BRIDGE RAIL, THE SOUTH ABUTMENT DOWN TO ELEVATION 1016' AS WELL AS ANY PORTION OF THE ABUTMENT THAT WILL AFFECT NEW CONSTRUCTION, AND THE ENTIRE NORTH ABUTMENT.
- 4. THERE ARE GRAVE SITES LOCATED IN THE VICINITY OF WINGWALL #1. THE CONTRACTOR SHALL CONTACT VTRANS ARCHAEOLOGIST JEANNINE RUSSELL AT 802-828-3981 A MINIMUM OF TWO WEEKS PRIOR TO PERFORMING EXCAVATION IN THIS AREA. A REPRESENTATIVE OF THE STATE WILL BE PRESENT DURING THE EXCAVATION IN THIS AREA. THIS WORK WILL BE INCLUDED IN THE BID PRICE OF THE APPROPRIATE EXCAVATION ITEM. IN NO CASE SHALL THE CONTRACTOR DISTURB EARTH OUTSIDE OF THE BARRIER FENCE AS SHOWN IN THE EROSION CONTROL PLANS. SEE SPECIAL PROVISIONS FOR MORE INFORMATION.
- 5. THERE IS A FENCE TO BE REMOVED BETWEEN STATIONS 97+61 RT AND 98+50 RT. THE CONTRACTOR SHALL STOCKPILE THIS FENCE AT A LOCATION ACCEPTABLE TO THE PROPERTY OWNER.

CONCRETE

- 6. ITEM 514.10 "WATER REPELLENT, SILANE", SHALL BE APPLIED TO ALL EXPOSED CONCRETE SURFACES, EXCEPT THE UNDERSIDE OF THE SUPERSTRUCTURE BETWEEN DRIP NOTCHES.
- 7. THE OVERLAY AND SUBSTRUCTURE CONCRETE ABOVE THE CONSTRUCTION JOINT SHALL BE SPECIAL PROVISION (HIGH PERFORMANCE CONCRETE, CLASS A LOW CEMENT)
- 8. THE SUBSTRUCTURE CONCRETE BELOW THE CONSTRUCTION JOINT SHALL BE CONCRETE, HIGH PERFORMANCE CLASS B.
- 9. THE DECK WILL HAVE A LONGITUDINAL GROOVED FINISH. THIS WORK WILL BE PAID FOR UNDER ITEM 900.675 SPECIAL PROVISION (LONGITUDINAL DECK GROOVING).
- 10. THE TOP SURFACE OF THE PILE CAP SHALL INITIALLY BE GIVEN A FLOAT FINISH TO GRADE. THE CONCRETE WITHIN THE REINFORCING CAGE SHALL THEN BE ROUGHENED BY RAKING PARALLEL TO THE FACE OF THE ABUTMENT TO AN AMPLITUDE OF 1/2 INCH. THE CONCRETE OUTSIDE THE REINFORCING CAGE AND UNDER THE BEARING PADS SHALL REMAIN SMOOTH.
- 11. TO FACILITATE COMPLETE CONSOLIDATION OF CONCRETE BETWEEN THE TOP OF THE BRIDGE SEAT AND THE BOTTOM OF THE BEAM, VENT HOLES MAY BE PROVIDED FOR THE INSERTION OF A VIBRATOR IN THE FRONT FORM UNDER EACH BEAM. IF CONCRETE DOES NOT CONSOLIDATE IN THIS AREA, THE CONTRACTOR SHALL REPAIR THIS AREA TO THE SATISFACTION OF THE ENGINEER.

PRESTRESSED BOX BEAMS

- 12. TRANSVERSE TENDONS PLATES AND CHUCKS SHALL BE GALVANIZED AFTER FABRICATION IN ACCORDANCE WITH AASHTO M 232M/M 232.
- 13. ITEM 510.24 "GROUTING SHEAR KEYS": FILL THE JOINTS BETWEEN THE BEAMS WITH MORTAR, TYPE IV, AS DESCRIBED IN SUBSECTION 510.13 AND AS FOLLOWS:
 - A. CLEAN JOINTS WITH AN OIL FREE AIR-BLAST IMMEDIATELY BEFORE GROUT PLACEMENT. VERIFY THAT THE BACKER ROD IS STILL IN PLACE.
 - B. FOLLOW MANUFACTURER'S RECOMMENDATIONS FOR ADDITIONAL JOINT PREPARATION AND GROUT PLACEMENT.
 - C. CAREFULLY ROD JOINTS TO ELIMINATE ANY POSSIBILITY OF VOIDS.
- 14. DESIGN VALUES
 - A. CONCRETE: $f_c = 7$ ksi AND STRENGTH @ RELEASE = 5.5 ksi
 - B. LIVE LOAD: AASHTO HL-93
 - C. PRESTRESSING STRANDS: 0.6" DIAMETER, 270 ksi, LOW-RELAXATION 7-WIRE STRANDS PULLED TO 75% OF THEIR YIELD STRENGTH
 - D. POST-TENSIONING STRANDS: 0.6" DIAMETER, 270 ksi, LOW-RELAXATION 7-WIRE STRANDS.
 - E. THE ASSUMED MODULUS OF ELASTICITY FOR THE STRAND IS 28,500 KSI.
 - F. TRANSVERSE TENDONS SHALL BE COVERED BY SEAMLESS POLYPROPYLENE SHEATH (WITH CORROSION INHIBITOR GREASE BETWEEN SHEATH AND STRAND) FOR THE LENGTH OF THE STRAND. TIES SHALL BE TENSIONED TO 47 KIPS FOR EACH 0.6" DIAMETER STRAND.

G. SERVICE LOADS

MEMBER MOMENT	732.1 K-FT
SUPERIMPOSED DEAD LOAD MOMENT	106.3 K-FT
LIVE LOAD & IMPACT MOMENT	499.2 K-FT
DEAD LOAD REACTION	67.4 K
LIVE LOAD & IMPACT REACTION	57.9 K
TOTAL REACTION	125.3 K
FINAL CAMBER	0.3 IN

- 15. THE FABRICATOR MAY, WITH THE APPROVAL OF THE ENGINEER, ALTER THE DESIGN AS DETAILED TO MEET THE CONTRACTOR'S CONSTRUCTION NEEDS, OR THE PLANT'S PRESTRESSING OPERATION AND MATERIAL REQUIREMENTS. ALTERNATE STRAND, TRANSVERSE TIE AND CROSS-SLOPE CONFIGURATIONS MAY BE SUBMITTED TO THE ENGINEER FOR APPROVAL. ANY DESIGN CHANGES SHALL MEET ALL OF THE APPLICABLE DESIGN CRITERIA, LOADINGS AND CODES (THE LATEST EDITION OF THE AASHTO LRFD BRIDGE DESIGN SPECIFICATIONS AND THE LATEST EDITION OF THE STRUCTURES DESIGN MANUAL), AND SHALL BE STAMPED AND SIGNED BY A PROFESSIONAL ENGINEER LICENSED IN THE STATE OF VERMONT.
- 16. THE PRECASTER SHALL SANDBLAST SHEAR KEY FACES PRIOR TO DELIVERY.
- 17. ALL TIES AND STIRRUPS IN THE BOX BEAMS SHALL BE EPOXY COATED.

PILES

- 18. THE PILES SHALL BE HP 14 X 102.
- 19. THE PILES SHALL BE EMBEDDED IN THE GROUND A MINIMUM OF 25 FEET AND SHALL BE DRIVEN TO A NOMINAL RESISTANCE OF 350 KIP. TO PREVENT DAMAGE TO THE PILES, PILE SHOES SHALL BE REQUIRED AND SHALL CONFORM TO SECTION 505.
- 20. FOR ESTIMATING PURPOSES, THE PILE TIP ELEVATIONS WERE ASSUMED AS SHOWN ON THE BORING LOGS. THE ACTUAL IN PLACE LENGTHS MAY VARY.
- 21. A MINIMUM OF ONE DYNAMIC PILE TEST SHALL BE CONDUCTED FOR EACH SUBSTRUCTURE UNIT. MORE TESTS MAY BE REQUIRED BY THE ENGINEER. THE FIRST TEST PILE SHALL BE THE FIRST DRIVEN FOR THE SUBSTRUCTURE UNIT. THE PILE SHALL BE DRIVEN AT THE PLAN LOCATION AND THE PILE SHALL BE MEASURED FOR PAYMENT UNDER CONTRACT ITEM 505.29.

TRAFFIC CONTROL

- 22. THE TRAFFIC CONTROL PHASING SHOWN IN THE PLANS IS OF A CONCEPTUAL NATURE ONLY. THE CONTRACTOR SHALL SUPPLY A DETAILED TRAFFIC CONTROL PLAN, WHICH NEED NOT UTILIZE THE PHASING SHOWN IN THESE PLANS.
- 23. AS PART OF 900.645 SPECIAL PROVISION (TRAFFIC CONTROL, ALL-INCLUSIVE), THE CONTRACTOR SHALL SUBMIT A SITE SPECIFIC TRAFFIC CONTROL PLAN TO THE ENGINEER FOR APPROVAL PER SUBSECTION 105.03. SEE SPECIAL PROVISIONS.
- 24. ALL SIGNING SHALL BE IN ACCORDANCE WITH THE LATEST EDITION OF THE MUTCD. FOR ADDITIONAL SIGNING INSTRUCTIONS SEE STANDARDS E-100, E-100A, E-101, E-102, E-102A, AND E-121.
- 25. ALL ITEMS REQUIRED TO IMPLEMENT THE CONTRACTOR'S TRAFFIC CONTROL PLAN WILL NOT BE PAID FOR DIRECTLY BUT WILL BE CONSIDERED INCLUDED IN THE BID PRICE FOR ITEM 900.645 SPECIAL PROVISION (TRAFFIC CONTROL, ALL-INCLUSIVE). THIS INCLUDES BUT IS NOT LIMITED TO THE FOLLOWING ITEMS:
 - TEMPORARY TRAFFIC SIGNAL SYSTEM
 - TEMPORARY TRAFFIC BARRIER
 - TEMPORARY PAVEMENT MARKINGS (INCLUDING REMOVAL OF EXISTING MARKINGS)
 - CONSTRUCTION SIGNING
- 26. PAYMENT FOR MAINTENANCE OF THE EXISTING BRIDGE STRUCTURE FOR PHASE I TRAFFIC WILL BE MADE UNDER CONTRACT ITEM 527.10. PAYMENT FOR TEMPORARY BRIDGE WIDENING AND MAINTENANCE OF THE NEW BRIDGE STRUCTURE FOR PHASE II TRAFFIC WILL BE INCLUDED IN THE UNIT PRICE BID FOR CONTRACT ITEM 900.645 SPECIAL PROVISION (TEMPORARY BRIDGE WIDENING FOR PHASE CONSTRUCTION).
- 27. THERE ARE NUMEROUS DETAILS ON THESE PLANS THAT ARE BASED ON A PHASED CONSTRUCTION DESIGN THAT MAY OR MAY NOT BE USED BY THE CONTRACTOR. THE LOCATION OF CONSTRUCTION JOINTS, THE CONFIGURATION OF THE ABUTMENTS, AND THE DIMENSIONS OF REINFORCING STEEL WILL ALL HAVE TO BE CONSIDERED ONCE THE CONTRACTOR'S TRAFFIC CONTROL PLAN HAS BEEN ACCEPTED.

- 28. SPECIAL PROVISION (TEMPORARY BRIDGE WIDENING FOR PHASED CONSTRUCTION) IS FOR THE CONSTRUCTION OF A TEMPORARY ROADWAY AND BRIDGE COMPONENT SO THAT A 12 FOOT TRAVEL LANE, INCLUDING SHOULDERS CAN BE MAINTAINED THROUGH THE PROJECT (SEE TRAFFIC PHASING TYPICALS SHEET). THE CONTRACTOR SHALL KEEP ALL FILL SLOPES FROM THE TEMPORARY BRIDGE INSIDE THE RIGHT OF WAY LIMITS UNLESS THE CONTRACTOR CAN MAKE OTHER ARRANGEMENTS WITH PROPERTY OWNERS. IF TEMPORARY SHEET PILING IS REQUIRED TO KEEP FILLS INSIDE THE RIGHT OF WAY, COST SHALL BE INCLUDED IN THE LUMP SUM BID PRICE FOR SPECIAL PROVISION (TEMPORARY BRIDGE WIDENING FOR PHASED CONSTRUCTION).

PROJECT NAME:	EAST HAVEN
PROJECT NUMBER:	BRF 0269(II)
FILE NAME:	s00cl62gennotes.dgn
PROJECT LEADER:	K. HIGGINS
DESIGNED BY:	J. LACROIX
GENERAL NOTES	
PLOT DATE:	08-AUG-2011
DRAWN BY:	R. PELLETT
CHECKED BY:	J. LACROIX
SHEET	3 OF 40

PRELIMINARY INFORMATION SHEET (BRIDGE)

LRFD

INDEX OF SHEETS

FINAL HYDRAULIC REPORT

PLAN SHEETS

1	TITLE SHEET
2	PRELIMINARY INFORMATION SHEET (BRIDGE)
3	GENERAL NOTES
4 - 5	QUANTITY SHEET 1 - 2
6 - 7	TYPICAL SECTIONS #1 - #2
8	TIE SHEET
9	LAYOUT SHEET
10	MAINLINE PROFILE
11	TRAFFIC PHASING TYPICALS
12	TRAFFIC CONTROL - PHASE I
13	TRAFFIC CONTROL - PHASE II
14	UTILITY LAYOUT SHEET
15	SIGN & PAVEMENT MARKINGS LAYOUT SHEET
16	RAIL LAYOUT
17	BORING LAYOUT
18	BORING LOGS
19	PLAN & ELEVATION
20	FRAMING PLAN
21 - 22	SUPERSTRUCTURE REINFORCING 1 - 2
23	APPROACH SLABS
24 - 25	ABUTMENT #1 & #2 DETAILS
26	WINGWALL DETAILS
27	REINFORCING STEEL SCHEDULE
28	R.O.W. PLAN
29	EPSC NARRATIVE
30	EPSC EXISTING SITE PLAN
31	EPSC CONSTRUCTION SITE PLAN
32	EPSC FINAL SITE PLAN
33 - 34	EPSC DETAILS #1 - #2
35 - 38	MAINLINE SECTIONS #1 - #4
39 - 40	CHANNEL SECTIONS #1 - #2

STANDARDS LIST

E-100	CONSTRUCTION APPROACH SIGNS	01-02-2004
E-100A	SIDE ROAD CONSTRUCTION - APPROACH SIGNS	01-02-2004
E-101	CONSTRUCTION SIGN DETAILS	05-30-2003
E-102	CONSTRUCTION SIGN DETAILS	08-30-2003
E-102A	CONSTRUCTION SIGN DETAILS	05-01-2004
E-121	STANDARD SIGN PLACEMENT - CONVENTIONAL ROAD	08-08-1995
E-134	BRIDGE NUMBER PLAQUE	08-08-1995
E-164	SQUARE STEEL SIGN POST	06-08-2009
E-192	PAVEMENT MARKING DETAILS	10-12-2000
G-1B	BOX BEAM GUARD RAIL	06-01-1994
G-19	GENERIC GRADING PLANS FOR GUARDRAIL END TERMINALS	11-15-2002
S-364A	BRIDGE RAILING, GALVANIZED 3 RAIL BOX BEAM	08-09-2010
S-364B	GUARDRAIL APPROACH SECTION, GALVANIZED 3 RAIL BOX BEAM	08-09-2010
S-364C	GUARDRAIL APPROACH SECTION, GALVANIZED 3 RAIL BOX BEAM	08-09-2010
S-364D	GUARDRAIL APPROACH SECTION, GALVANIZED 3 RAIL BOX BEAM	08-09-2010

STRUCTURAL DETAIL SHEETS

SD-501.00	CONCRETE DETAILS AND NOTES
SD-502.00	CONCRETE DETAILS AND NOTES
SD-516.10	BRIDGE JOINT, ASPHALTIC PLUG
SD-601.00	STRUCTURAL STEEL DETAILS & NOTES

HYDROLOGIC DATA

Date: July 2010

DRAINAGE AREA : 45.4 sq. mi.
 CHARACTER OF TERRAIN : Hilly to mountainous, mostly forested with some open areas.
 STREAM CHARACTERISTICS : Incised, sinuous, with a confluence 100' upstream
 NATURE OF STREAMBED : Gravel, cobbles, sand, silt and boulders

PEAK FLOW DATA

Q 2.33 =	1200 cfs	Q 50 =	3700 cfs
Q 10 =	2450 cfs	Q 100 =	4200 cfs
Q 25 =	3125 cfs	Q 500 =	5900 cfs

DATE OF FLOOD OF RECORD : Unknown
 ESTIMATED DISCHARGE : Unknown
 WATER SURFACE ELEV. : Unknown
 NATURAL STREAM VELOCITY : @ Q50 = 11.6 fps
 ICE CONDITIONS : Moderate
 DEBRIS : Moderate
 DOES THE STREAM REACH MAXIMUM HIGHWATER ELEV. RAPIDLY? No
 IS ORDINARY RISE RAPID? Yes
 IS STAGE AFFECTED BY UPSTREAM OR DOWNSTREAM CONDITIONS? No
 IF YES, DESCRIBE :

WATERSHED STORAGE : 1% HEADWATERS:
 UNIFORM: X
 IMMEDIATELY ABOVE SITE:

EXISTING STRUCTURE INFORMATION

STRUCTURE TYPE : Single span steel beam bridge with concrete deck
 YEAR BUILT : 1929
 CLEAR SPAN(NORMAL TO STREAM): 49'
 VERTICAL CLEARANCE ABOVE STREAMBED: 8'
 WATERWAY OF FULL OPENING: 314 sq. ft.
 DISPOSITION OF STRUCTURE: Remove superstructure and north abutment
 TYPE OF MATERIAL UNDER SUBSTRUCTURE: See boring information

WATER SURFACE ELEVATIONS AT:

Q2.33 =	1013.5'	VELOCITY =	7.2 fps
Q10 =	1015.6'	"	11.1 fps
Q25 =	1019.3'	"	10.4 fps
Q50 =	1020.0'	"	11.6 fps
Q100 =	1020.5'	"	12.8 fps

LONG TERM STREAMBED CHANGES: Minor scour in the center of the channel through the bridge area.

IS THE ROADWAY OVERTOPPED BELOW Q100: Yes
 FREQUENCY: Between Q25 and Q50
 RELIEF ELEVATION: 1019.6'
 DISCHARGE OVER ROAD @Q100: 730 cfs

UPSTREAM STRUCTURE

TOWN: Newark DISTANCE: 4200'
 HIGHWAY #: VT 114 STRUCTURE #: 19
 CLEAR SPAN: 52' CLEAR HEIGHT: 11'
 YEAR BUILT: 1929 FULL WATERWAY: 572 sq. ft.
 STRUCTURE TYPE: Single span steel beam bridge with concrete deck

DOWNSTREAM STRUCTURE

TOWN: East Haven DISTANCE: 3100'
 HIGHWAY #: T.H. 4 STRUCTURE #: 10
 CLEAR SPAN: 35' CLEAR HEIGHT: 10'
 YEAR BUILT: 1960 FULL WATERWAY: 350 sq. ft.
 STRUCTURE TYPE: Single span steel beam bridge with timber deck & stone abutments

LRFR LOAD RATING FACTORS

LOADING LEVELS	TRUCK						
	H-20	HL-93	3S2	6 AXLE	3A. STR.	4A. STR.	5A. SEMI
TONNAGE	20	36	36	66	30	34.5	38
INVENTORY	2.84	1.46					
POSTING							
OPERATING	3.68	1.89	3.03	2.02	2.61	1.88	
COMMENTS:							

PILE DRIVING AND TESTING REQUIREMENTS

- NOMINAL PILE DRIVING CAPACITY P_{DIP} : 350.00 KIP
- PILE TEST RESISTANCE FACTOR ϕ : 0.65
- MAXIMUM PILE TIP ELEVATION: 987.00 FT
- 0

PROPOSED STRUCTURE

STRUCTURE TYPE: Single span prestressed concrete box beam bridge

CLEAR SPAN(NORMAL TO STREAM): 65'
 VERTICAL CLEARANCE ABOVE STREAMBED: 10'
 WATERWAY OF FULL OPENING: 455 sq. ft.

WATER SURFACE ELEVATIONS AT:

Q2.33 =	1013.4'	VELOCITY =	6.7 fps
Q10 =	1015.2'	"	9.7 fps
Q25 =	1016.1'	"	11.3 fps
Q50 =	1016.9'	"	12.7 fps
Q100 =	1017.7'	"	13.6 fps

IS THE ROADWAY OVERTOPPED BELOW Q100: No
 FREQUENCY: Above Q100
 RELIEF ELEVATION: 1019.9'
 DISCHARGE OVER ROAD @Q100: 0 cfs

AVERAGE LOW ELEVATION OF SUPERSTRUCTURE: 1018.2'
 VERTICAL CLEARANCE: @ Q50 = 1.3'

SCOUR: 3' of contraction scour at Q100.
 Maximum scour up to Q500 = 4' of contraction scour, at incipient overtopping flow.
 REQUIRED CHANNEL PROTECTION: Stone Fill, Type IV

PERMIT INFORMATION

AVERAGE DAILY FLOW: 90 cfs DEPTH OR ELEVATION:
 ORDINARY LOW WATER: 40 cfs Elevation 1010'
 ORDINARY HIGH WATER: 515 cfs Elevation 1012'

TEMPORARY BRIDGE REQUIREMENTS

STRUCTURE TYPE: No temporary bridge required.
 CLEAR SPAN (NORMAL TO STREAM):
 VERTICAL CLEARANCE ABOVE STREAMBED:
 WATERWAY AREA OF FULL OPENING:

ADDITIONAL INFORMATION

TRAFFIC MAINTENANCE NOTES

- MAINTAIN ONE-WAY TRAFFIC ON THE EXISTING STRUCTURE.
- INSTALL AND MAINTAIN TRAFFIC SIGNALS.
- SIDEWALKS ARE NOT NECESSARY

DESIGN VALUES

1. DESIGN LIVE LOAD	HL-93
2. FUTURE PAVEMENT	d_p : 3.0 INCH
3. DESIGN SPAN	L : 67.00 FT
4. MIN. MID-SPAN POS. CAMBER @ RELEASE (PRESTRESSED UNITS)	Δ : ---
5. PRESTRESSING STRAND (0.60 INCH DIAMETER - LOW RELAX)	f_y : 270 KSI
6. PRESTRESSED CONCRETE STRENGTH	f'_c : 7.0 KSI
7. PRESTRESSED CONCRETE RELEASE STRENGTH	f'_{cr} : 5.5 KSI
8. CONCRETE, HIGH PERFORMANCE CLASS AA	f'_c : 4.0 KSI
9. CONCRETE, HIGH PERFORMANCE CLASS A	f'_c : 4.0 KSI
10. CONCRETE, HIGH PERFORMANCE CLASS B	f'_c : 3.5 KSI
11. CONCRETE, CLASS C	f'_c : 3.0 KSI
12. REINFORCING STEEL	f_y : 60 KSI
13. STRUCTURAL STEEL AASHTO M270	f_y : ---
14. SOIL UNIT WEIGHT	γ : 0.140 KCF
15. NOMINAL BEARING RESISTANCE OF SOIL	q_n : 4.0 KSF
16. SOIL BEARING RESISTANCE FACTOR (REFER TO AASHTO LRFD)	ϕ : ---
17. NOMINAL BEARING RESISTANCE OF ROCK	q_n : 10.0 KSF
18. ROCK BEARING RESISTANCE FACTOR (REFER TO AASHTO LRFD)	ϕ : ---
19. NOMINAL AXIAL PILE RESISTANCE	q_p : 350 kips
20. PILE YIELD STRENGTH ASTM A572	f_y : 50
21. PILE SIZE	14X102
22. EST. PILE LENGTH	L_p : 39 FT
23. PILE RESISTANCE FACTOR	ϕ : ---
24. LATERAL PILE DEFLECTION	Δ : ---
25. BASIC WIND SPEED	V_{3s} : ---
26. MINIMUM GROUND SNOW LOAD	p_g : ---
27. SEISMIC DATA	PGA : --- S_1 : --- S_2 : ---

PROJECT NAME: EAST HAVEN

PROJECT NUMBER: BRF 0269(11)


FILE NAME: s00c162 PI Sheet Builder.xls PLOT DATE: 8/9/2011
 PROJECT LEADER: K. HIGGINS DRAWN BY: R. PELLETT
 DESIGNED BY: J. LACROIX CHECKED BY: J. LACROIX
 PRELIMINARY INFORMATION SHEET (BRIDGE) SHEET 2 OF 40

TRAFFIC DATA




YEAR	ADT	DHV	% D	% T	ADTT	20 year ESAL for flexible pavement from 2005 to 2025 : 1681000
2005	1100	170	54	9	140	40 year ESAL for flexible pavement from 2005 to 2045 : 4381000
2025	1500	220	54	7	150	Design Speed : 50 mph

SEE SHEET 2 FOR
INDEX OF SHEETS AND
LIST OF STANDARDS

STATE OF VERMONT AGENCY OF TRANSPORTATION

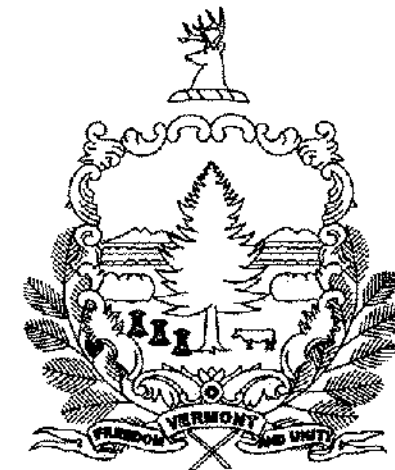


PROPOSED IMPROVEMENT BRIDGE PROJECT TOWN OF EAST HAVEN COUNTY OF ESSEX STATE ROUTE 114 - MAJOR COLLECTOR BRIDGE NO. 18

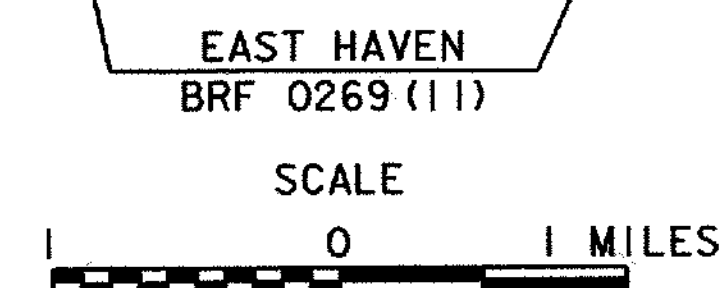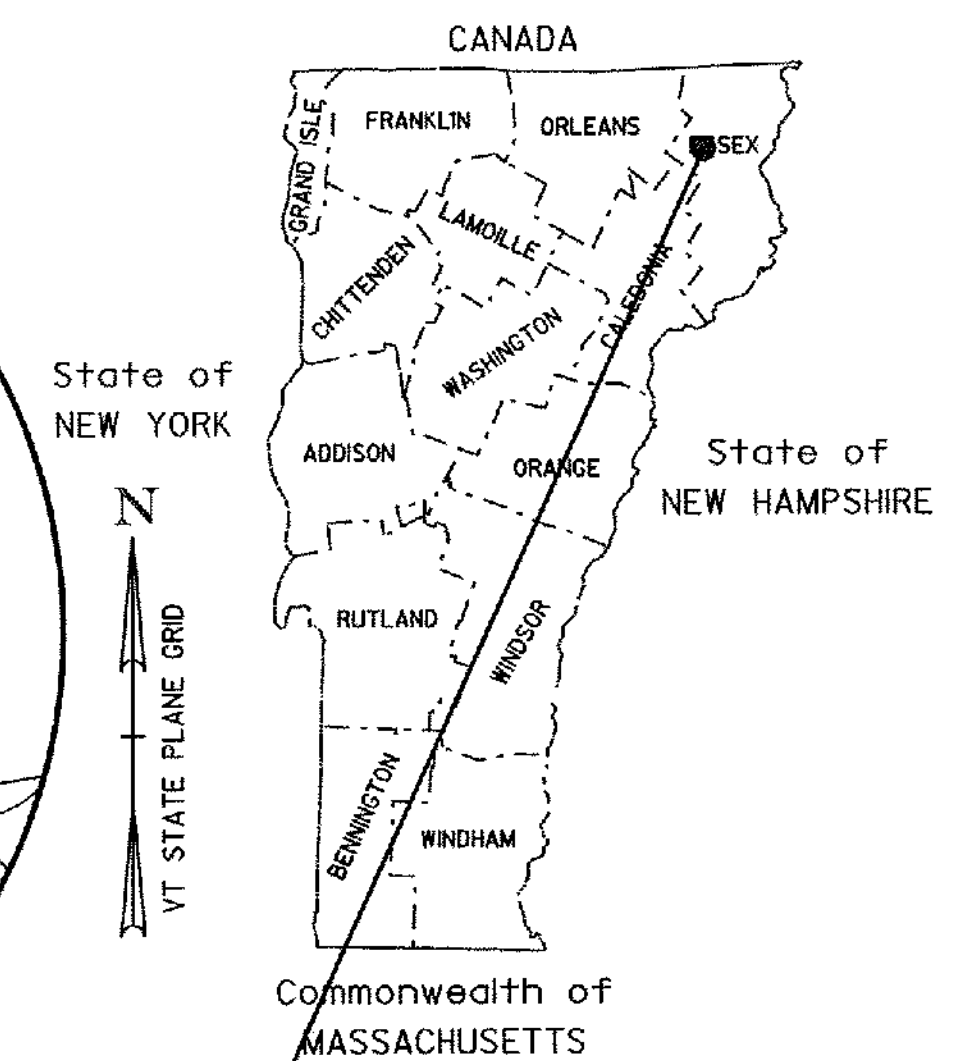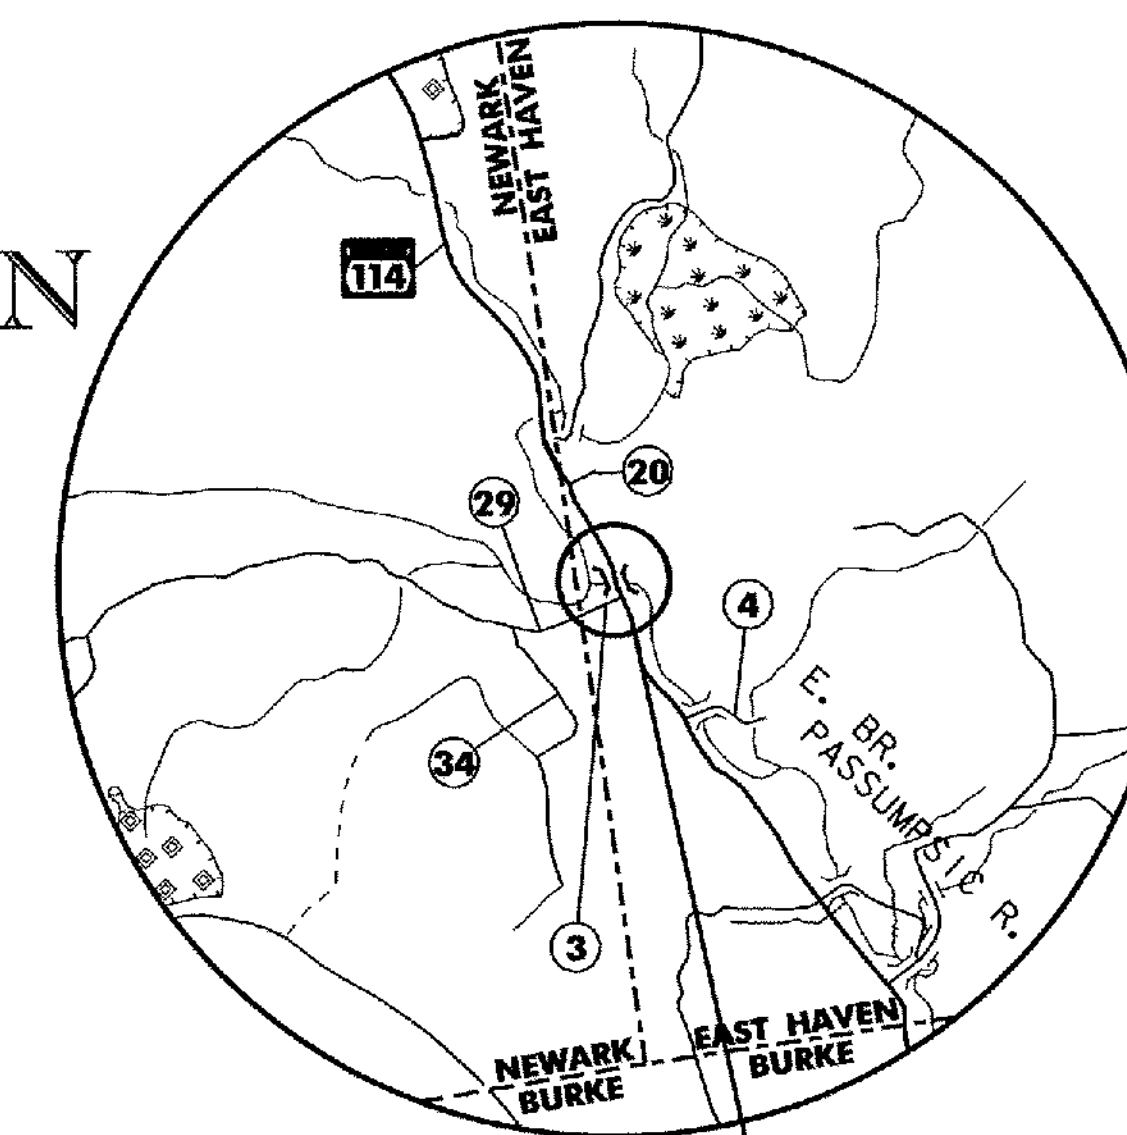

PROJECT LOCATION: BEGINNING AT MILE POST 1.827 ON VT 114 IN EAST HAVEN, CROSSING THE PASSUMPSIC RIVER AND ENDING AT MILE POST 1.860.

PROJECT DESCRIPTION: THIS PROJECT SHALL CONSIST OF THE REPLACEMENT OF THE EXISTING STRUCTURE WITH RELATED APPROACH WORK.

LENGTH OF BRIDGE: 70.00 FEET
LENGTH OF ROADWAY: 100.00 FEET
LENGTH OF PROJECT: 170.00 FEET

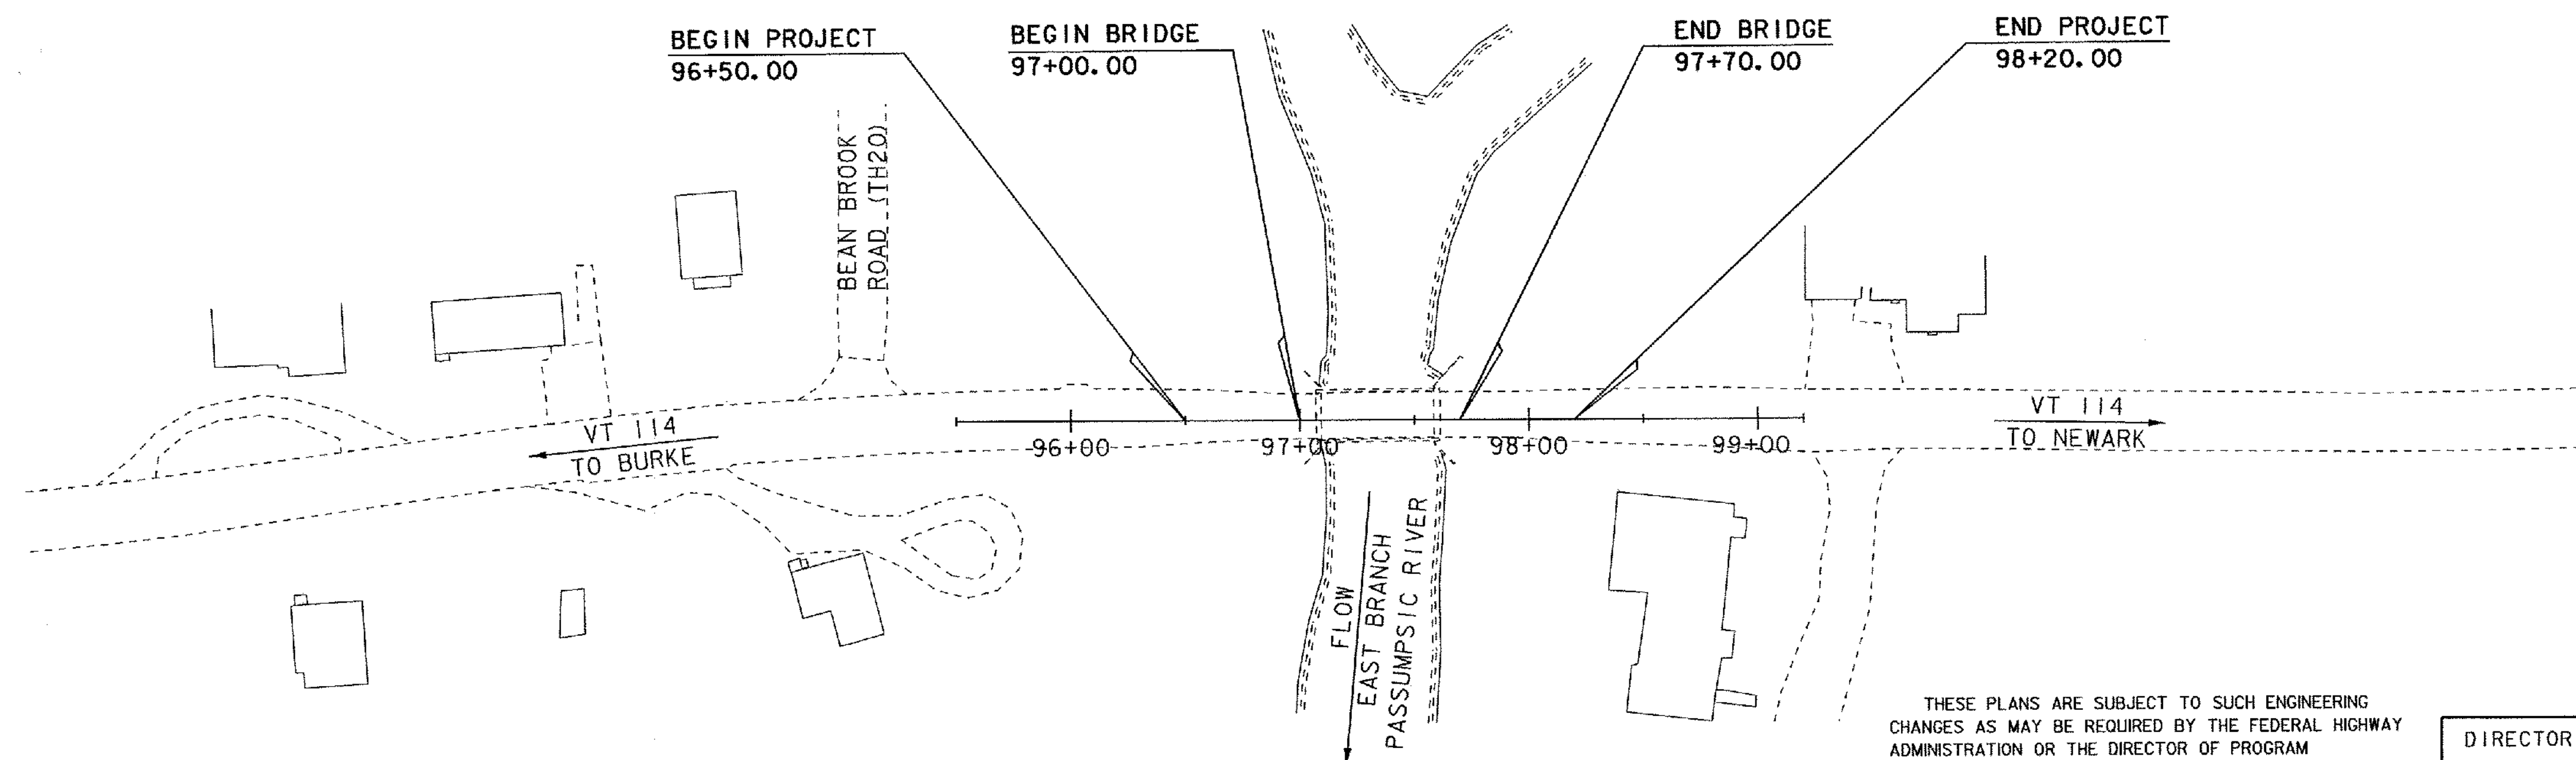

QUALITY ASSURANCE PROGRAM: LEVEL 2

CONVENTIONAL SYMBOLS

COUNTY LINE	
TOWN LINE	
LIMITS OF ACCESS	
POINT OF ACCESS	
FENCE LINE	
STONE WALL	
TRAVELED WAY	
GUARD RAIL	
RAILROAD	
SURVEY LINE	
CULVERT	
POWER POLE	
TELEPHONE POLE	
TREES	
CONTROL OF ACCESS	
PROPERTY LINE	
R.O.W. TAKING LINE	
SLOPE RIGHTS	
TOP OF CUT	
TOE OF SLOPE	

SURVEYED BY : R. GILMAN
SURVEYED DATE : 11/00




DATUM
VERTICAL NAVD 88
HORIZONTAL NAD 83 (96)

THESE PLANS ARE SUBJECT TO SUCH ENGINEERING CHANGES AS MAY BE REQUIRED BY THE FEDERAL HIGHWAY ADMINISTRATION OR THE DIRECTOR OF PROGRAM DEVELOPMENT.

CONSTRUCTION IS TO BE CARRIED ON IN ACCORDANCE WITH THESE PLANS AND THE STANDARD SPECIFICATIONS FOR CONSTRUCTION DATED 2006, AS APPROVED BY THE FEDERAL HIGHWAY ADMINISTRATION ON JUNE 15, 2006 FOR USE ON THIS PROJECT, INCLUDING ALL SUBSEQUENT REVISIONS AND SUCH REVISED SPECIFICATIONS AND SPECIAL PROVISIONS AS ARE INCORPORATED IN THESE PLANS.

SCALE 1" = 50'-0"
50 0 50

DIRECTOR OF PROGRAM DEVELOPMENT
APPROVED: *[Signature]* DATE 8/8/11
PROJECT MANAGER: KRISTIN HIGGINS
PROJECT NAME: EAST HAVEN
PROJECT NUMBER: BRF 0269 (11)
SHEET 1 OF 40 SHEETS

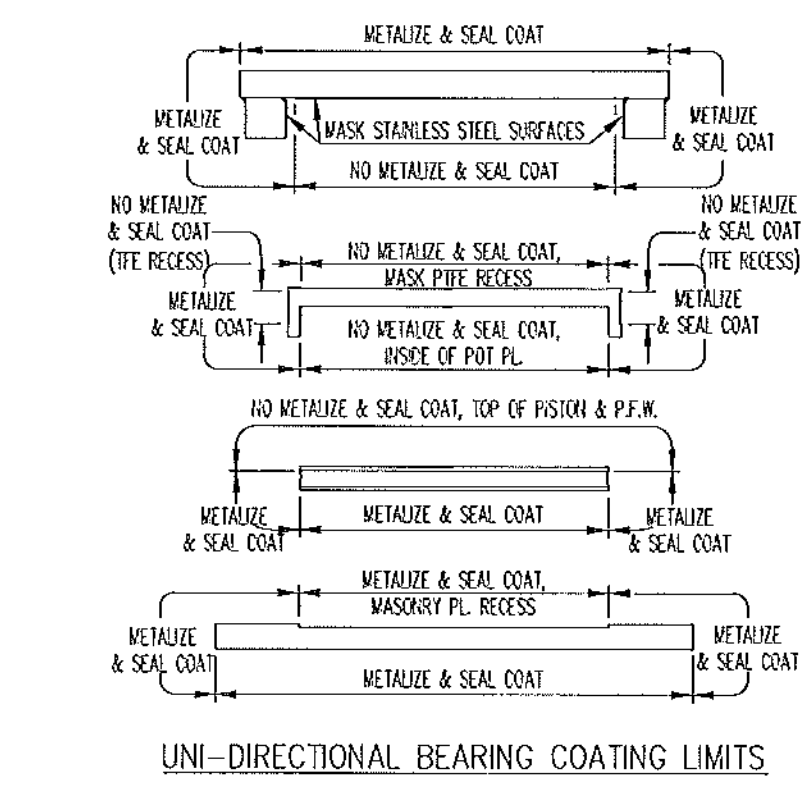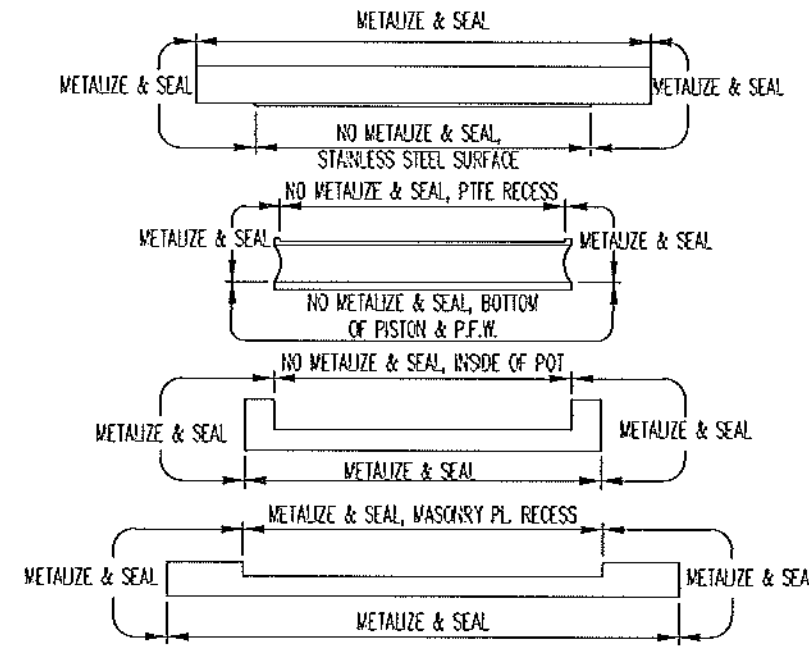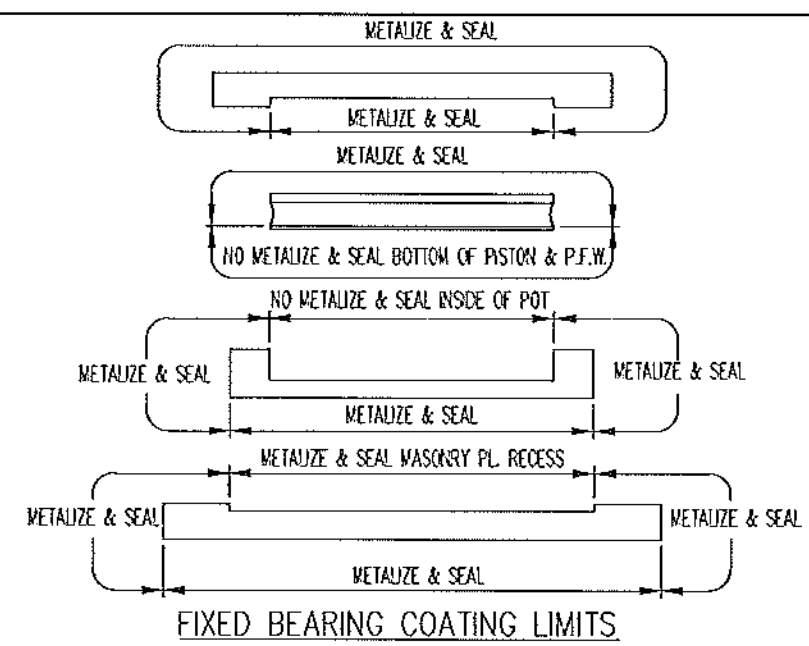

GENERAL NOTES
 1. MATERIALS AND WORKMANSHIP SHALL BE IN ACCORDANCE WITH THE ASHMO LOAD BEARING DESIGN & CONSTRUCTION SPECIFICATIONS SIX EDITION & ITS LATEST REVISIONS, THE VERMONT AGENCY OF TRANSPORTATION'S STANDARD SPECIFICATIONS FOR CONSTRUCTION DATED 2005 AS AMENDED BY THE SPECIAL PROVISIONS, AND THE CONTRACT PLANS.

2. PIPE SHALL BE VIRGIN, UNFILLED POLYETHYLENE TEREPHTHALE. GAGE BAR PIPE SHALL USE CLASS FILLER & FITMENTS.
 3. PIPE IS TO BE PURCHASED ETCHED ON ONE SIDE FOR BONDING WITH MARCHED RECESS. STEEL MATING SURFACES OF PIPE AND STEEL SHALL BE OBT BLENDED AND DEGREASED PRIOR TO APPLICATION OF ADHESIVE. ADHESIVE SHALL BE APPLIED USING DIRECTIONS SUPPLIED BY THE ADHESIVE MANUFACTURER. THE PIPE RESIN SHALL CONFORM TO THE REQUIREMENTS OF ASTM D3854.

4. STAINLESS STEEL SHALL CONFORM TO ASTM A240 - TYPE 304 AND SHALL BE 11 GA. (0.120"). STAINLESS STEEL SLIDING SURFACES IN CONTACT WITH PIPE SHALL HAVE A NO. 8 MIRROR FINISH AND ALL OTHERS SHALL HAVE A 20 FINISH.

5. WELDING SHALL CONFORM TO AWS-D15 BRIDGE WELDING CODE, AS WELL AS ANY STATE STANDARD.

6. THE TOP AND BOTTOM OF THE ANCHORE DISC SHALL BE LUBRICATED WITH BOV CORNING #4 SUICIDE COMPOUND.

7. ALL SHARP CORNERS OF STEEL MATERIALS SHALL BE REMOVED BY GRINDING OR SANDING.

8. THE BRASS SEALING RING ENDS SHALL BE CUT AT AN ANGLE OF 45° WITH A MAXIMUM GAP OF 0.05". THE RINGS SHALL BE SANDERED 120° USING A QUANTITY OF THREE (3) RINGS.

9. EACH BEARING SHALL BE MARKED WITH THE MANUFACTURER'S NAME, THE BEARING TYPE OR MODEL NUMBER, THE BEARING NUMBER AND LOT NUMBER, UPSTATION, AND THE INSTALLED LOCATION. THE MARKING SHALL BE PERMANENT AND IN A LOCATION THAT WILL BE VISIBLE AFTER ERECTION OF STRUCTURE.

10. EACH BEARING SHALL HAVE MARKS PLACED ON THE SIDE OF THE MASONRY & SOLE PLATES TO INDICATE THE LOCATION OF THE CENTERLINE. IN ADDITION, EACH UNI-DIRECTIONAL BEARING SHALL HAVE THE SOLE PL. & MASONRY PL. MARKED TO INDICATE THE LOCATION OF THE TRANSVERSE CL OF THE STAINLESS STEEL. THE MARK ON THE MASONRY PL. SHALL EXTEND THE ENTIRE LENGTH ON THE TOP SURFACE PRIOR TO ASSEMBLY. THIS MARK CAN BE USED IN THE FIELD TO DETERMINE THE INITIAL OFFSET LOCATION OF THE SOLE PLATE (IF APPLICABLE). THE MARKS SHALL BE MADE IN INDLEGIBLE INK AND SHALL BE VISIBLE AFTER BEARING INSTALLATION.

11. BEARINGS ARE TO BE SHIPPED AS COMPLETE UNITS, STEEL BANNED, AND SHALL BE WRAPPED TO PROTECT FROM MOISTURE AND DIRT DURING TRAVEL AND STORAGE. BEARINGS SHALL BE STORED IN A CLEAR, DRY, LEVEL UPRIGHT POSITION WHILE AT JOBSITE. BEARINGS SHALL BE LIFTED FROM THEIR UNDERSIDES ONLY.

12. AT NO TIME MAY THE BEARINGS BE DISASSEMBLED WITHOUT AUTHORIZATION FROM D.S. BROWN OR WITHOUT THE PRESENCE OF A D.S. BROWN REPRESENTATIVE.

13. POT/PISTON INTERFERENCE SHALL BE CHECKED WITH SKEAFLEX 1A (OR APPROVED EQUAL PRIOR TO SHIPMENT.

14. D.S. BROWN MAY SUBSTITUTE AND/OR SOW FOR A709 OR S50 DUE TO AVAILABILITY AT NO ADDITIONAL COST TO THE OWNER OR CONTRACTOR.

15. IN ACCORDANCE WITH AISC STEEL EROSION COMPONENT CERTIFICATION REQUIREMENTS, CALCULATIONS AND DRAWINGS HAVE BEEN REVIEWED BY PHILIP CASE, P.E.

16. VERSIFLEX HAWK "POT" STYLE BEARING MANUFACTURING FACILITY AND REPRESENTATIVE FOR COORDINATING PRODUCTION:
 THE D.S. BROWN COMPANY
 300 EAST CHERRY STREET
 NORTH BURLINGTON, VERMONT 05402
 CSR - BRYAN KRIDER

PROTECTIVE COATING NOTES
 1. ALL MILL SCALE SHALL BE REMOVED FROM BEARINGS BY BLASTING (SPC-SP3) PRIOR TO APPLYING PROTECTIVE COATING.

2. METALIZATION SHALL BE IN ACCORDANCE WITH AAS/ANSI C218-03. EXTERNAL STEEL SURFACES SHALL BE METALIZED TO A MAXIMUM THICKNESS OF 5 MILS. PROVIDE WIRE MATERIAL FOR THE METALIZED PRIMER CONSISTING OF PURE ZINC (99.9% Purity).

3. WITHIN 8 HOURS AFTER METALIZATION, THE EXTERNAL STEEL SURFACES SHALL RECEIVE A SEAL COAT IN ACCORDANCE WITH THE MANUFACTURER'S RECOMMENDATIONS.
 SEAL COAT = CARBOLOXIE PROSTRON, D.F.T. = 2 MILS MIN.

4. SEE COATING LIMIT DETAILS FOR COATING LOCATIONS.

5. PRIOR TO METALIZING ALL CORNERS AND EDGES OF THE STEEL PLATES, SHAPES, ETC., SHALL BE GRIND TO 0.063" RADIUS.

CONTRACTOR NOTES
 1. THE LOCATIONS OF THE ANCHOR BOLTS SHALL BE CROSS-REFERENCED WITH SHOP DRAWINGS TO VERIFY THE LOCATIONS.

2. CONTRACTOR SHALL TAKE ALL NECESSARY PRECAUTIONS TO PROTECT THE STAINLESS STEEL AND PIPE SLIDING SURFACES FROM DAMAGE AT ALL TIMES.

3. DUE TO DESIGN DIFFERENCES, THE OVERALL HEIGHTS OF THE BEARING BEING SUPPLIED MAY DIFFER FROM THE HEIGHTS SHOWN IN THE CONTRACT PLANS. THE ACTUAL BEARING HEIGHTS ARE GIVEN IN THE DATA TABLE ON THE INDIVIDUAL BEARING DETAIL SHEET. CONTRACTOR TO RECALCULATE AND VERIFY PRELIMINARY ELEVATIONS ACCORDINGLY.

4. THE BEARINGS WILL BE SHIPPED CENTERED, AND IT SHALL BE THE RESPONSIBILITY OF THE CONTRACTOR TO OFFSET THE SOLE PLATE IN THE FIELD DURING INSTALLATION IF APPLICABLE. OFFSET VALUES WERE NOT PROVIDED IN THE CONTRACT PLANS, SO IF REQUIRED, OFFSETS SHALL BE PROVIDED BY THE BROOK DESIGNER.

5. THE CONTRACTOR SHALL ENSURE THAT THE MAXIMUM TEMPERATURE REACHED BY SURFACES IN CONTACT WITH THE PIPE IS LIMITED TO 300°F (149°C), AND LIMITED TO 200°F (93°C) FOR SURFACES IN CONTACT WITH THE ELASTOMER. TEMPERATURES SHALL BE DETERMINED BY TEMPERATURE INDICATING MAX PROBES OR OTHER SUITABLE MEANS. DURING FIELD WELDING, NO WELDING CURRENT SHALL BE PERMITTED TO PASS BETWEEN THE POT AND PISTON COMPONENTS.

SAMPLING AND TESTING NOTES
 ELASTOMER DISCS SHALL BE SUBJECTED TO RANDOM IN-HOUSE TESTING OF THE APPLICABLE PHYSICAL PROPERTIES FOR ASHMO LOAD CONSTRUCTION SPECIFICATIONS, SECTION 18.

BEARINGS SHALL BE SUBJECTED TO THE TESTS DESCRIBED BELOW AND IN ACCORDANCE WITH THE APPLICABLE ASHMO LOAD CONSTRUCTION SPECIFICATIONS.

1. SAMPLE TEST - ONE (1) BEARING PER "LOT" SHALL BE TESTED AND SHALL BE CHOSEN AT RANDOM. A "LOT" SHALL CONSIST OF ONE OF THE FOLLOWING:
 (1) NO MORE THAN 10 EXPANSION BEARINGS OF ONE "LOAD CATEGORY"
 (2) ONE LOAD CATEGORY MAY CONSIST OF BEARINGS OF A DIFFERING VERTICAL LOAD CAPACITY BUT THE BEARINGS MAY NOT EXCEED A RANGE OF CAPACITY DIFFERING BY MORE THAN 50%.

2. PROCEDURE FOR TESTING EXPANSION BEARINGS-
 a.) LOAD THE BEARING WITH ITS DESIGN LOAD FOR AT LEAST 12 HOURS. MEASURE THE FORCE REQUIRED FOR THE FIRST MOVEMENT AND CALCULATE THE COEFFICIENT OF FRICTION. MEASURE THE FORCE REQUIRED FOR MOVEMENT UNDER INCREASING LOADS AND CALCULATE THE COEFFICIENT OF FRICTION.
 b.) LOAD THE BEARING AT 70% OF THE DESIGN LOAD BUT NOT LESS THAN 2000LBS. MEASURE THE STATIC AND DYNAMIC COEFFICIENTS OF FRICTION.
 c.) LOAD THE BEARING AT 150% OF THE DESIGN LOAD FOR 30 MINUTES, AT A 2% ROTATION, AND SUBJECT THE BEARING TO 100 CIRCLES OF MOVEMENT. MEASURE THE STATIC AND DYNAMIC COEFFICIENTS OF FRICTION.
 d.) COEFFICIENTS OF FRICTION SHALL BE LESS THAN 0.08.

3. PROCEDURE FOR TESTING FIXED BEARINGS-
 a.) LOAD BEARING AT 150% OF ITS DESIGN LOAD FOR 30 MINUTES, AT A 2% ROTATION.

4. AFTER PERFORMING EACH TEST DESCRIBED IN (2) & (3) ABOVE, DISASSEMBLE THE BEARING AND INSPECT FOR:
 a.) ANY SIGN OF SEALING FAILURE.
 b.) ANY SIGN OF MATERIAL FAILURE.
 c.) ANY OTHER DEFECTS.

DESCRIPTION	TOLERANCE TABLE (USD 181.4.2-1)		FLATNESS TOLERANCE	SURFACE FINISH (μ-in)
	THICKNESS TOLERANCE	DIMENSION TOLERANCE		
POT BEARING				
OVERALL DIMENSIONS	+1/4", -0"	+1/8", -0"	-	-
POT DEPTH (INSIDE)	-	+0.025", -0"	-	-
POT WALL THICKNESS & AVE. I.D.	+1/8", -0"	+0.005", -0.005"	+0.001", -0.001"	32
POT BASE: TOP & BOTTOM SURFACES	+0.025", -0"	-	CLASS C	63
PISTON: RM	+1/16", -0"	+0.005", -0.005"	+0.001", -0.001"	32
PISTON: TOP AND BOTTOM SURFACES	+0.025", -0"	-	CLASS C	63
ELASTOMERIC DISK (UNSTRESSED)	+1/8", -0"	+1/16", -0"	-	-
FLAT PIPE SLIDING SURFACES				
PIPE	+1/16", -0"	+0.002", -0"	CLASS A	-
STAINLESS STEEL	+1/16", -0"	+1/8", -0"	CLASS A	# 8 M-SHGR
GUIDES				
CONTACT SURFACE	-	+1/8", -0"	CLASS A	32
DISTANCE BETWEEN GUIDES	-	+0.007", -0"	-	-
PARALLELISM OF GUIDES	-	±/- 0.005 RAD	-	-
LOAD PLATES				
OVERALL DIMENSIONS	+1/16", -1/16"	+1/4", -1/4"	CLASS A	125
BEVEL SLOPE	±/- 0.002 RAD	-	-	-

* ONLY FOR SURFACES IN CONTACT WITH THE BEARING. TOP SURFACE OF SOLE PLATE AND BOTTOM SURFACE OF MASONRY PLATE SHALL BE CLASS B.

FLATNESS TOLERANCE	
CLASS	X NOM. DIM.
A	0.001
B	0.002
C	0.005

TOLERANCES
 EXCEPT AS NOTED BELOW, THE DIMENSIONAL TOLERANCES AND SURFACE FINISHES OF THE BEARING SHALL SATISFY THE REQUIREMENTS OF ASHMO LOAD TABLE 181.4.2-1.


1. DIMENSIONS (LENGTH, WIDTH, THICKNESS, HOLE LOCATIONS AND POSITION OF RELEED COMPONENTS), THE TOLERANCE SHALL BE ± 0.005".

2. FLATNESS
 a.) SOLE PLATE - BEARING SURFACES SHALL BE FLAT WITH MAXIMUM PERMISSIBLE VARIATION OF 0.01" FROM A PLANE DETERMINED BY ANY THREE CORNERS OF THE PLATE.

b.) MASONRY PLATE - BEARING SURFACES SHALL BE FLAT WITH MAXIMUM PERMISSIBLE VARIATION OF 0.01" FROM A PLANE DETERMINED BY ANY THREE CORNERS OF THE PLATE.


c.) SLIDING SURFACES - FOR STAINLESS STEEL MATING WITH PIPE BONDED TO STEEL, THE TOLERANCE SHALL BE THE "NOMINAL DIMENSION" IN INCHES TIMES 0.0005. THE "NOMINAL DIMENSION" SHALL BE THE DISTANCE BETWEEN ANY DIAGONAL CORNERS OR OPPOSITE EDGES OF THE BEARING SURFACE. THE TOLERANCE IS APPLICABLE TO BOTH SURFACES.

Vermont Agency of Transportation
RECEIVED
 CK'D BY GML OK'D BY JEL
 8:53 am, Mar 29, 2012
 RESUBMIT APPROVED X
 BY KMH DATE 3/29/2012

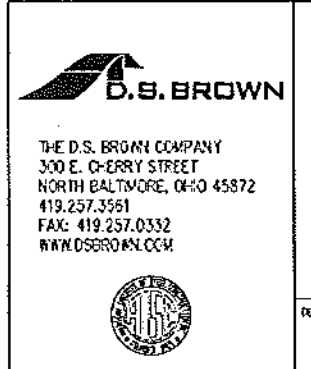


REVISION	DATE	BY	DESCRIPTION	ITEM	QUANTITY
1	3/28/12	R.T.G.	COVERING SPECIFICATIONS NOTE		
2	3/29/12	K.T.G.	LOCATION - TOWN HIGHWAY 6 BRIDGE NO. 57		
3	3/29/12	K.T.G.	BRIDGE - 57		
4	3/29/12	K.T.G.	PROJECT NO. - BRO 1442(28)		
5	3/29/12	K.T.G.	PROJECT NAME - SPRINGFIELD		
6	3/29/12	K.T.G.	DESIGNER - VIDOT		
7	3/29/12	K.T.G.	CUSTOMER - T BUCK CONSTRUCTION, INC.		
8	3/29/12	K.T.G.	GENERAL NOTES & COATING LIMITS		
9	3/29/12	K.T.G.	WINDSOR, CO., VT		

ASSEMBLY
03

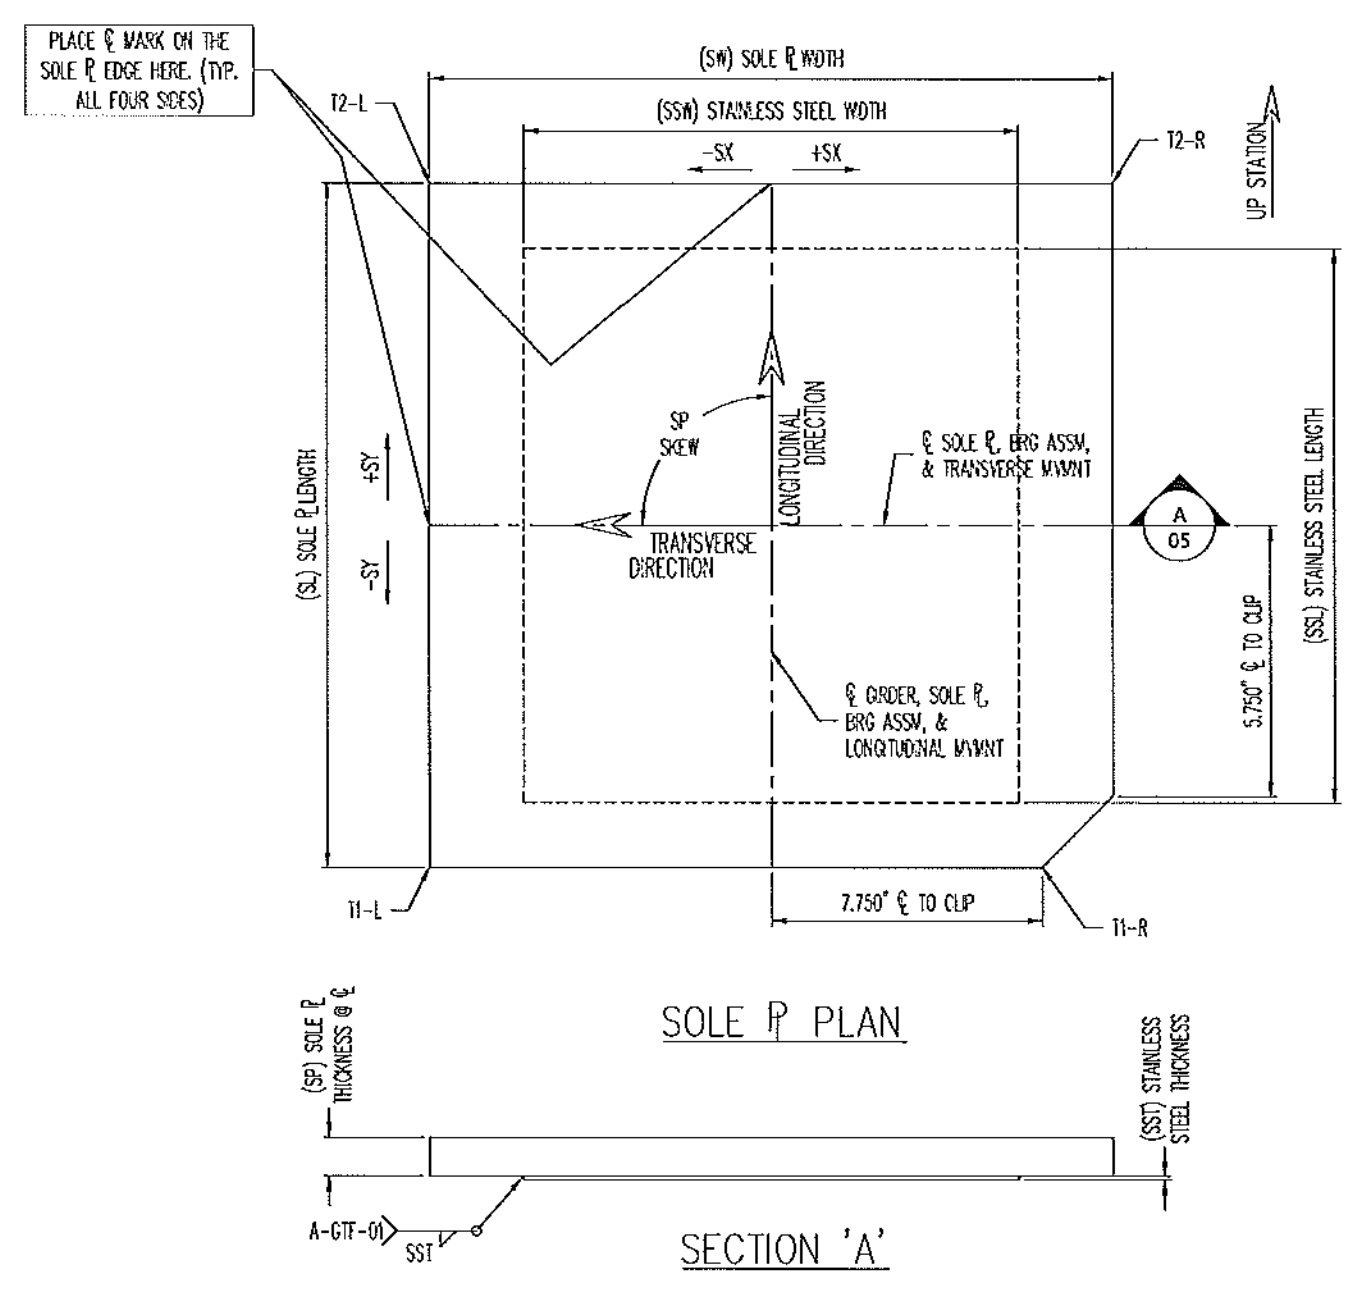

SOLE PLATE & STAINLESS STEEL SCHEDULE (PW)																	
ASSEM	QTY	BEVEL	BEVEL	BEVEL	SP	SW	S	SOLE PLATE	SP SS	SS	SP	SP SS					
PK	PK	11-L	11-R	12-L	12-R			MATERIAL	PK	SS1	SS2	MATERIAL					
SA	301	2	1.625	1.625	1.000	1.315	20.000	16.000	A102 OR S304 50#	301	0.120	10.250	11.250	+60.0"	+10.000	+10.000	A240 151L #8 & 28

Vermont Agency of Transportation
RECEIVED
CK'D BY GML OK'D BY JEL
8:53 am, Mar 29, 2012
RESUBMIT APPROVED X
BY KMH DATE 3/29/2012

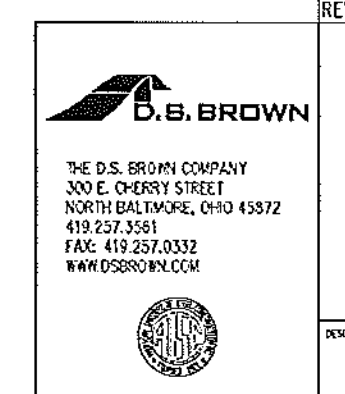

SEE SH. 03 FOR ASSEMBLY INFORMATION & DETAILS.
SEE SH. 04 FOR SUB-ASSEMBLY DETAILS.
ALL DIMENSIONS IN INCHES UNLESS OTHERWISE NOTED.

REV.	DESCRIPTION	DATE	DET.	CHKD.
1	LOCATION --- TOWN HIGHWAY 8 BRIDGE NO. 57			
	BRIDGE --- 57			
	PROJECT NO. --- BR0 1442(26)			
	PROJECT NAME --- SPRINGFIELD			
	DESIGNER --- VIDOT			
	CUSTOMER --- T BUCK CONSTRUCTION, INC.			

NO.	DATE	BY	CHKD.	DATE	BY	CHKD.
35029	11/12	1		1/26/12		

MK	QTY	DESCRIPTION
EA	1	PMG-165
EA1	1	SOLE PLATE
EA11	1	STAINLESS STEEL
EA12	1	PIPE DISC
EA13	1	POT PLATE
EA14	1	ELASTOMERIC DISC
EA15	3	BRASS RING
EA16	2	GUIDE BAR
EA17	2	G.B. STAINLESS STEEL
EA18	2	G.B. LOW-FRICTION MATL.
EA19	1	WASHER PLATE
EA2	1	UNDERLAYMENT (PS)
EA3	2	SKEDGE ROD (RS)
EA4	2	HEAVY HEX NUT (RS)
EA5	2	WASHER PLATE (RS)


MK	QTY	DESCRIPTION
EB	1	PMG-165
EB1	1	SOLE PLATE
EB11	1	STAINLESS STEEL
EB12	1	PIPE DISC
EB13	1	POT PLATE
EB14	1	ELASTOMERIC DISC
EB15	3	BRASS RING
EB16	2	GUIDE BAR
EB17	2	G.B. STAINLESS STEEL
EB18	2	G.B. LOW-FRICTION MATL.
EB19	1	WASHER PLATE
EB2	1	UNDERLAYMENT (PS)
EB3	2	SKEDGE ROD (RS)
EB4	2	HEAVY HEX NUT (RS)
EB5	2	WASHER PLATE (RS)

MK	QTY	DESCRIPTION
EC	1	PMG-160
EC1	1	SOLE PLATE
EC11	1	STAINLESS STEEL
EC12	1	PIPE DISC
EC13	1	POT PLATE
EC14	1	ELASTOMERIC DISC
EC15	3	BRASS RING
EC16	2	GUIDE BAR
EC17	2	G.B. STAINLESS STEEL
EC18	2	G.B. LOW-FRICTION MATL.
EC19	1	WASHER PLATE
EC2	1	UNDERLAYMENT (PS)
EC3	2	SKEDGE ROD (RS)
EC4	2	HEAVY HEX NUT (RS)
EC5	2	WASHER PLATE (RS)

MK	QTY	DESCRIPTION
ED	1	PMG-300
ED1	1	SOLE PLATE
ED11	1	STAINLESS STEEL
ED12	1	PIPE DISC
ED13	1	POT PLATE
ED14	1	ELASTOMERIC DISC
ED15	3	BRASS RING
ED16	2	GUIDE BAR
ED17	2	G.B. STAINLESS STEEL
ED18	2	G.B. LOW-FRICTION MATL.
ED19	1	WASHER PLATE
ED2	1	UNDERLAYMENT (PS)
ED3	2	SKEDGE ROD (RS)
ED4	2	HEAVY HEX NUT (RS)
ED5	2	WASHER PLATE (RS)

MK	QTY	DESCRIPTION
EA	1	PMG-165
EA1	1	SOLE PLATE
EA11	1	STAINLESS STEEL
EA12	1	PIPE DISC
EA13	1	POT PLATE
EA14	1	ELASTOMERIC DISC
EA15	3	BRASS RING
EA16	2	GUIDE BAR
EA17	2	G.B. STAINLESS STEEL
EA18	2	G.B. LOW-FRICTION MATL.
EA19	1	WASHER PLATE
EA2	1	UNDERLAYMENT (PS)
EA3	2	SKEDGE ROD (RS)
EA4	2	HEAVY HEX NUT (RS)
EA5	2	WASHER PLATE (RS)

MK	QTY	DESCRIPTION
EB	1	PMG-165
EB1	1	SOLE PLATE
EB11	1	STAINLESS STEEL
EB12	1	PIPE DISC
EB13	1	POT PLATE
EB14	1	ELASTOMERIC DISC
EB15	3	BRASS RING
EB16	2	GUIDE BAR
EB17	2	G.B. STAINLESS STEEL
EB18	2	G.B. LOW-FRICTION MATL.
EB19	1	WASHER PLATE
EB2	1	UNDERLAYMENT (PS)
EB3	2	SKEDGE ROD (RS)
EB4	2	HEAVY HEX NUT (RS)
EB5	2	WASHER PLATE (RS)

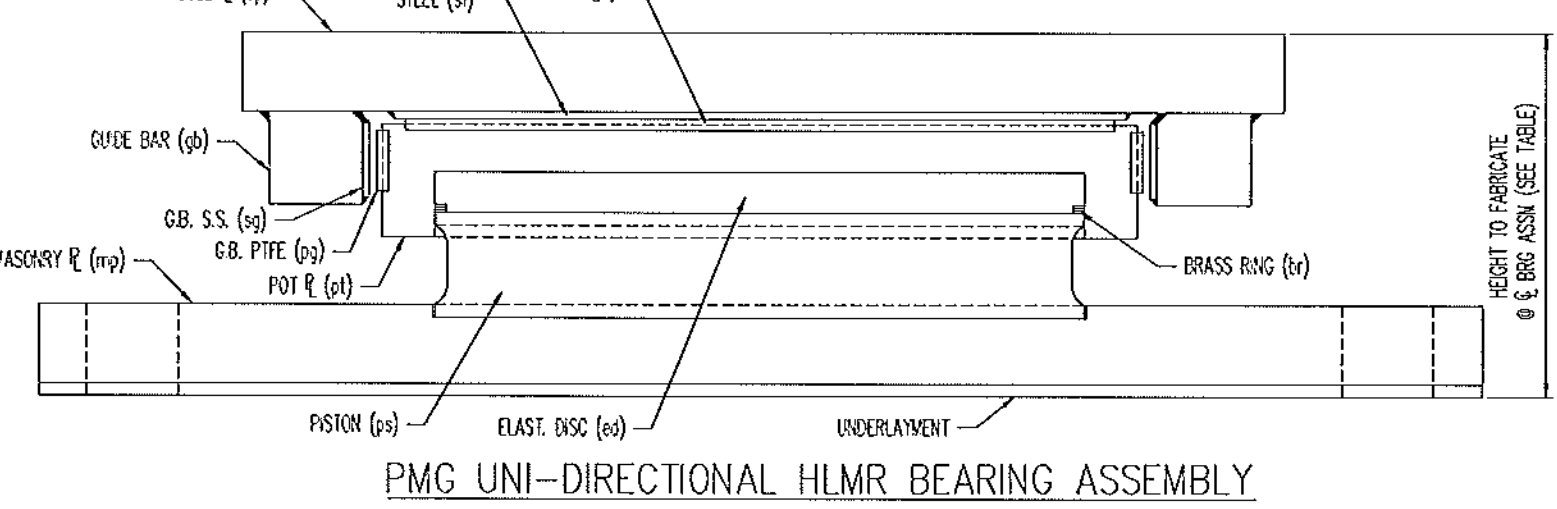

ASSEM FOR	PIECE	ELASTOMERIC DISC SCHEDULE (FWG)
EA	EA1	0.815 X 7.750W
EB	EB1	0.815 X 7.750W
EC	EC1	0.750 X 7.500W
ED	ED1	1.125 X 10.500W


ASSEM FOR	PIECE	PIPE DISC SCHEDULE (FWG)
EA	EA12	0.188 X 7.750W
EB	EB12	0.188 X 7.750W
EC	EC12	0.188 X 7.250W
ED	ED12	0.188 X 10.500W

ASSEM FOR	PIECE	GUIDE BAR LOW-FRICTION MATL. SCHEDULE (FWG)
EA	EA16	0.034 X 0.375 X 7.750W
EB	EB16	0.034 X 0.375 X 7.750W
EC	EC16	0.034 X 0.375 X 7.500W
ED	ED16	0.034 X 0.375 X 10.500W

HLBR BEARING ASSEMBLY LOCATION & LOAD DESIGN INFORMATION (FWG)															
MK	QTY	STRUCTURE	BEARING TYPE	LOCATION	MAX VERT. SERVICE	MAX VERT. STRENGTH	MAX HORIZ. SERVICE	MAX HORIZ. STRENGTH	LONG. TRANS. MOMENT	ROTATION (RAD)	HEIGHT TO FABRICATE	HEIGHT IN PLANS	DIFFERENCE IN PLANS	UNDERLAYMENT IN HEIGHT (Y/M)	
EA	1	Bridge No. 57	PMG-165	ABUTMENT 1: C2	165.0 kips	244.0 kips	42.0 kips	61.0 kips	2000	0	0.03	6.174	9.000	-2.826	YES
EB	1	Bridge No. 57	PMG-165	ABUTMENT 2: C1	140.0 kips	205.0 kips	35.0 kips	52.0 kips	1000	0	0.03	5.939	9.000	-3.061	YES
EC	1	Bridge No. 57	PMG-160	ABUTMENT 2: C4	300.0 kips	460.0 kips	75.0 kips	115.0 kips	1000	0	0.03	8.165	9.000	-0.835	YES

ELASTOMERIC DISC SCHEDULE (FWG)				BRASS RING SCHEDULE (FWG)			
ASSEM FOR	PIECE	QTY	ELASTOMERIC DISC DIMENSIONS	ASSEM FOR	PIECE	QTY	BRASS RING DIMENSIONS
EA	EA14	1	0.815 X 7.750W	EA	EA15	3	0.034 X 0.375 X 7.750W
EB	EB14	1	0.815 X 7.750W	EB	EB15	3	0.034 X 0.375 X 7.750W
EC	EC14	1	0.750 X 7.500W	EC	EC15	3	0.034 X 0.375 X 7.500W
ED	ED14	1	1.125 X 10.500W	ED	ED15	3	0.034 X 0.375 X 10.500W

PIPE DISC SCHEDULE (FWG)				GUIDE BAR LOW-FRICTION MATL. SCHEDULE (FWG)			
ASSEM FOR	PIECE	QTY	PIPE DISC DIMENSIONS	ASSEM FOR	PIECE	QTY	LOW-FRICTION MATL. DIMENSIONS
EA	EA12	1	0.188 X 7.750W	EA	EA16	2	0.034 X 0.375 X 7.750W
EB	EB12	1	0.188 X 7.750W	EB	EB16	2	0.034 X 0.375 X 7.750W
EC	EC12	1	0.188 X 7.250W	EC	EC16	2	0.034 X 0.375 X 7.500W
ED	ED12	1	0.188 X 10.500W	ED	ED16	2	0.034 X 0.375 X 10.500W

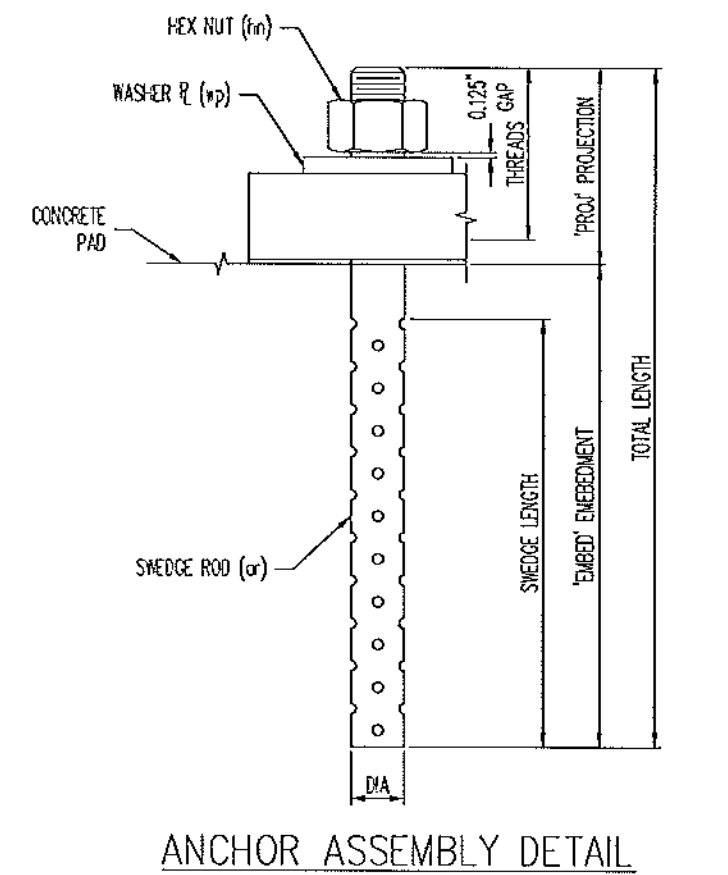


ANCHOR ROD SCHEDULE (FWG)									
ASSEM FOR	PIECE	QTY	DIA.	LENGTH	PROJ. EXPOSED	REMARKS	LOCATION	MATERIAL	COATING
EA	EA3	2	1.500	20.000	5.000	4" threads, 14" smooth	ABUTMENT 1: C2	F155A CR 36	A153-HDC
EB	EB3	2	1.500	20.000	5.000	4" threads, 14" smooth	ABUTMENT 1: C1	F155A CR 36	A153-HDC
EC	EC3	2	1.500	20.000	5.000	4" threads, 14" smooth	ABUTMENT 2: C1	F155A CR 36	A153-HDC
ED	ED3	2	2.000	21.000	6.000	4" threads, 14" smooth	ABUTMENT 2: C4	F155A CR 36	A153-HDC

NUT SCHEDULE (FWG)				
ASSEM FOR	PIECE	QTY	DIA.	MATERIAL
EA	EA4	2	1.500	A193-01 or A194-2H
EB	EB4	2	1.500	A193-01 or A194-2H
EC	EC4	2	1.500	A193-01 or A194-2H
ED	ED4	2	2.000	A193-01 or A194-2H

WASHER SCHEDULE (FWG)					
ASSEM FOR	PIECE	QTY	THICKNESS	WIDTH	LENGTH
EA	EA5	2	0.375	3.000	3.000
EB	EB5	2	0.375	3.000	3.000
EC	EC5	2	0.375	3.000	3.000
ED	ED5	2	0.375	4.000	4.000

Vermont Agency of Transportation
RECEIVED
 CK'D BY GML OK'D BY JEL
 8:53 am, Mar 29, 2012
 SUBMIT APPROVED X
 BY KMH DATE 3/29/2012



SEE SHIT. 01 & 02 FOR SUB-ASSEMBLY DETAILS
 SEE SHIT. 01 FOR GENERAL NOTES & COATING LIMITS
 ALL DIMENSIONS IN INCHES UNLESS OTHERWISE NOTED

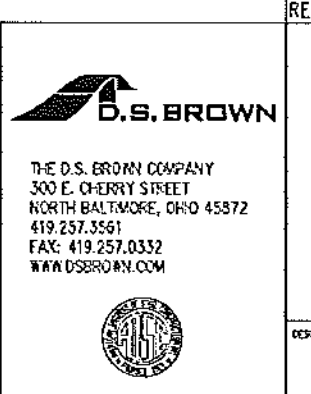

REV.	DESCRIPTION	DATE	BY	CHKD.
1	LOCATION --- TOWN HIGHWAY 6 BRIDGE NO. 57			
2	BRIDGE --- 57			
3	PROJECT NO. --- BRD 1442(26)			
4	PROJECT NAME --- SPRINGFIELD			
5	DESIGNER --- VTDOT			
6	CUSTOMER --- T BUCK CONSTRUCTION, INC.			

ITEM	QUANTITY
35029-1112-2	2 OF 2
35029-1112-4	1 OF 1
35029-1112-5	1 OF 1

DATE	BY	CHKD.
3/26/12		
3/29/12		

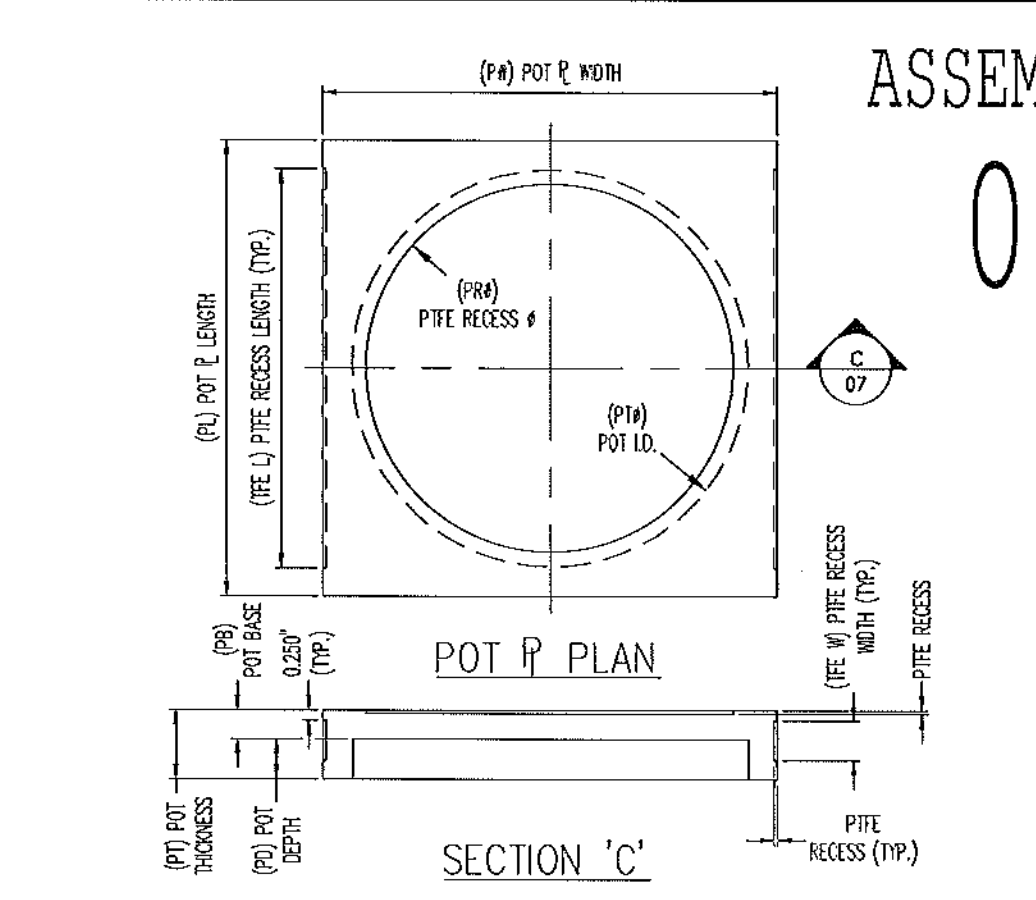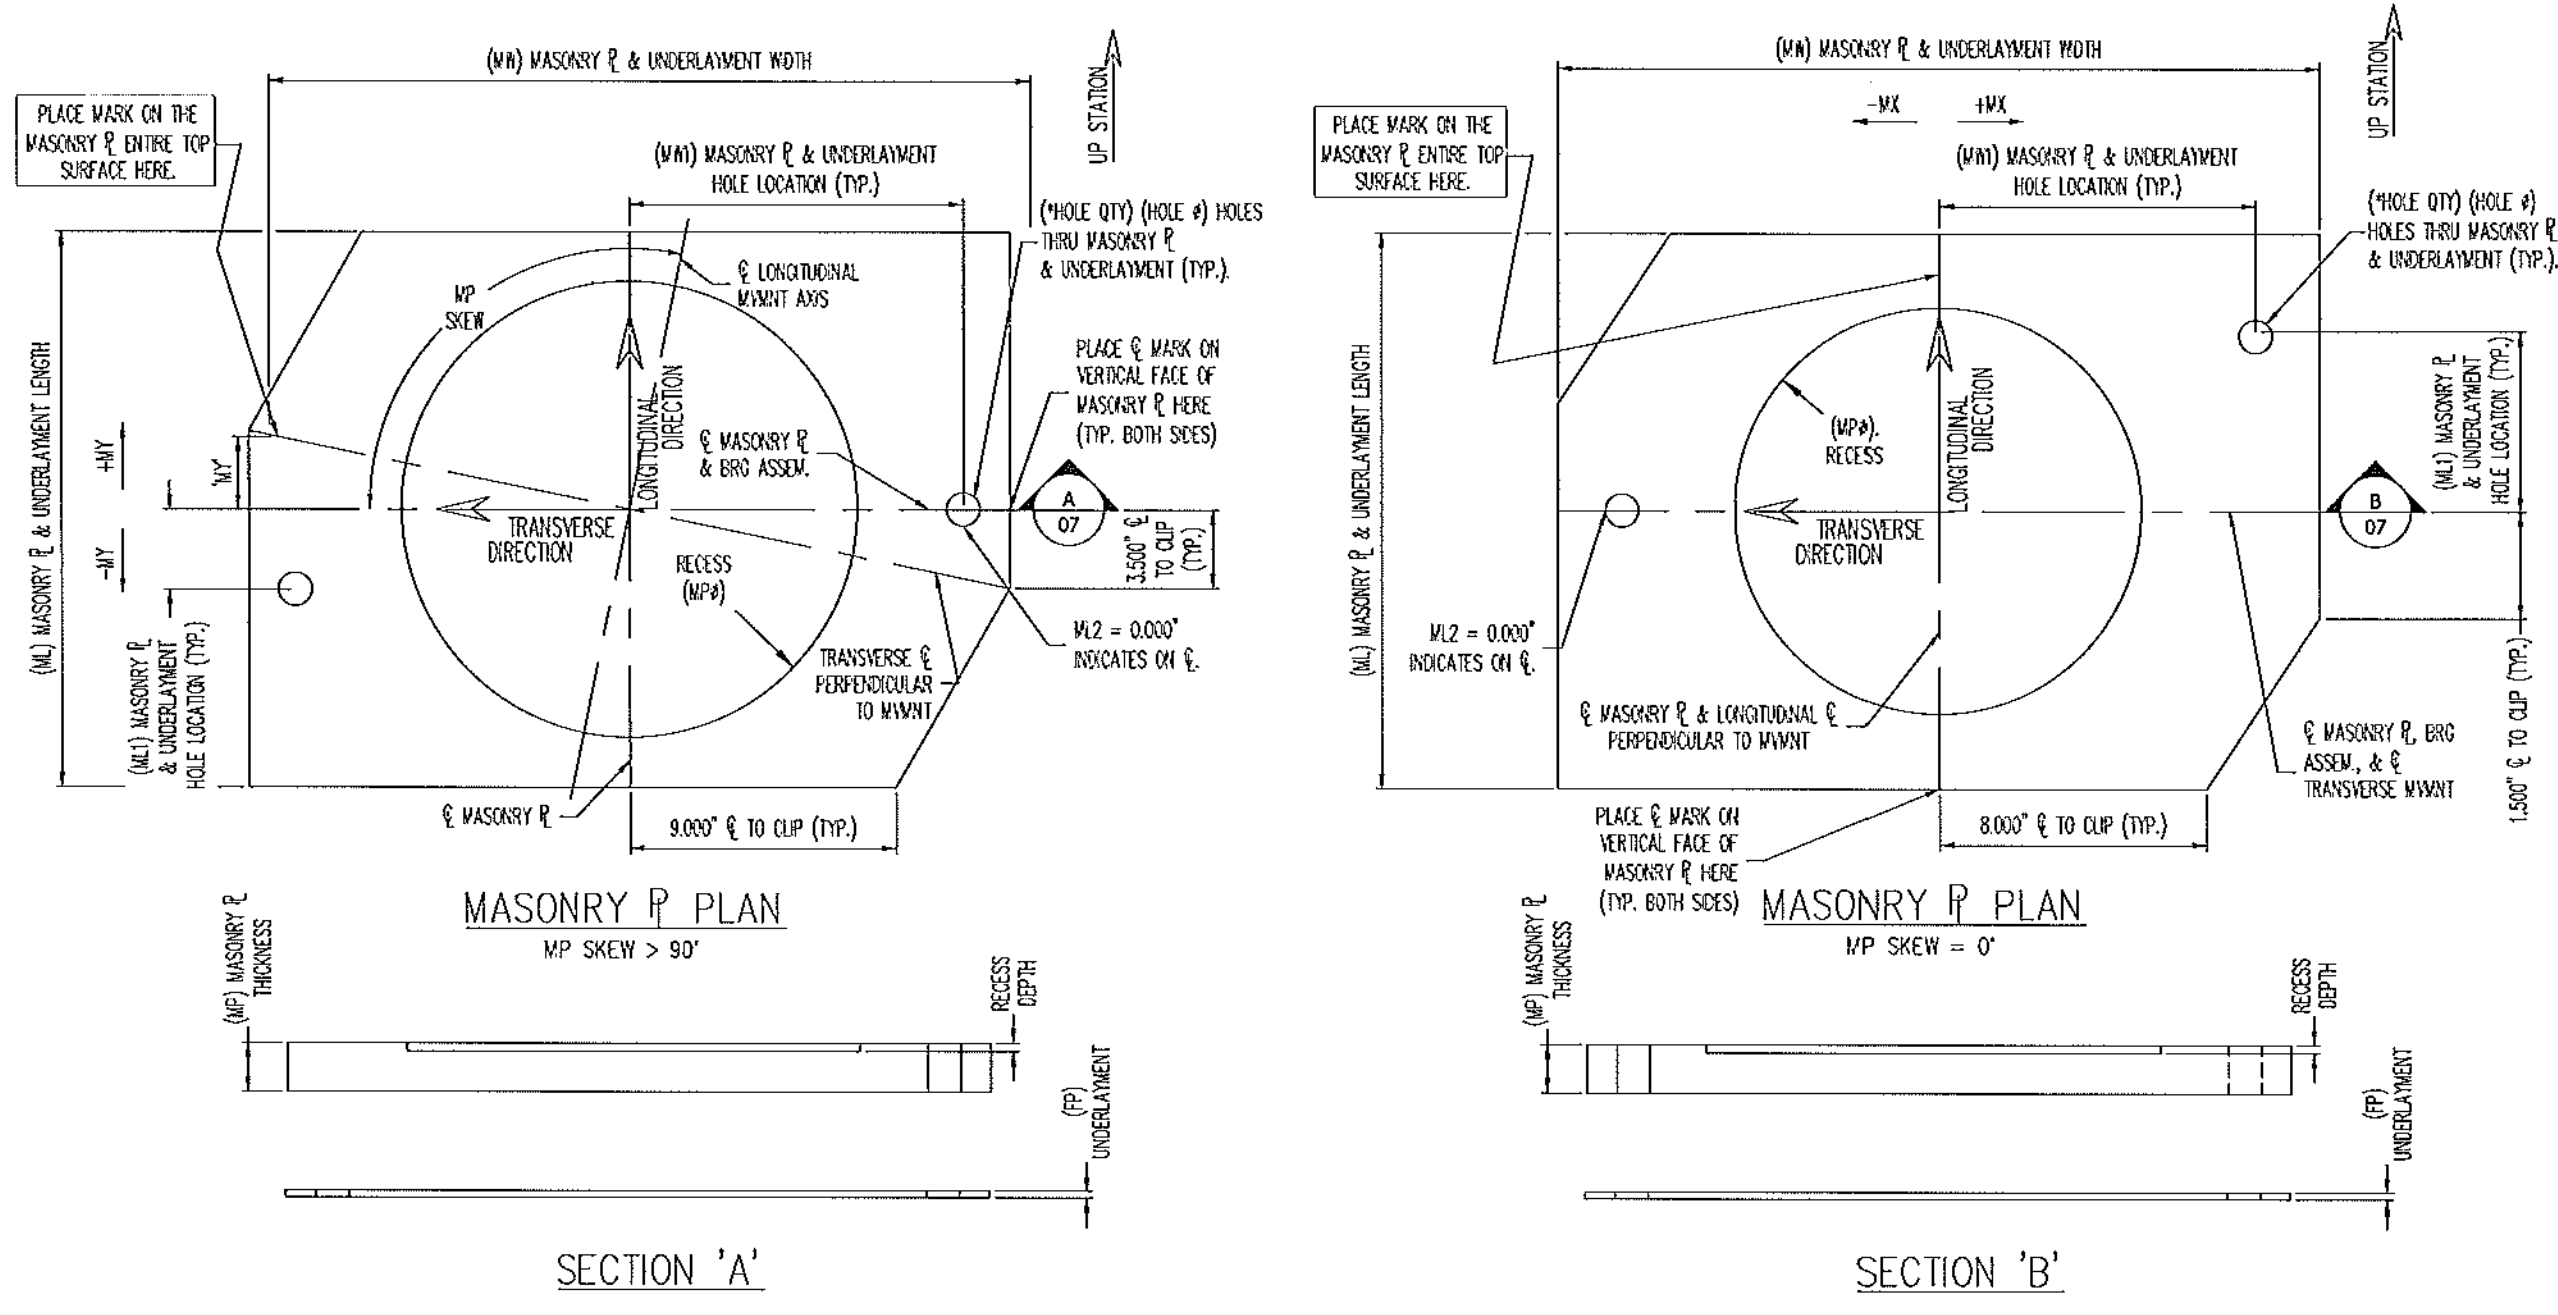


POT PLATE SCHEDULE (FWG)

ASSEM	PIECE	PT	PI	PW	PL	PB	PO	PR	TE L	TE W	PITE	POT PL
NO.	NO.	NO.	NO.	NO.	NO.	NO.	NO.	NO.	NO.	NO.	NO.	NO.
6A	6A1	1	2.400	8.750	8.750	1.175	1.227	7.750	7.750	1.000	0.031	A709 CR 50 or 50M
6B	6B1	1	2.400	8.750	8.750	1.175	1.227	7.750	7.750	1.000	0.031	A709 CR 50 or 50M
6C	6C1	1	2.750	8.500	8.500	1.083	1.083	7.500	7.250	0.875	0.031	A709 CR 50 or 50M
6D	6D1	1	3.150	12.000	12.000	1.539	1.611	10.500	10.500	1.375	0.031	A709 CR 50 or 50M

MASONRY PLATE SCHEDULE (FWG)


LOCATION	ASSEM	PIECE	QTY	MP	WH	VL	WH	WL1	WL2	RECESS	HOLE	HOLE	MP	WT	WH	UL	UL	UL	MASONRY PL
	NO.	NO.		NO.	NO.	NO.	NO.	NO.	NO.	NO.	NO.	NO.	NO.	NO.	NO.	NO.	NO.	NO.	NO.
ASSEMBLY 1: 62	6A	6A1	1	1.500	29.000	16.000	12.250	2.000	0.000	7.775	0.250	2	1.675	495.3	41.605	6FA (6ip)	0.125	AKSHTO (LRD) 18.10.2	A709 CR 50 or 50M
ASSEMBLY 1: 63	6B	6B1	1	1.500	29.000	16.000	12.250	2.000	0.000	7.775	0.250	2	1.675	495.0	40.755	6FA (6ip)	0.125	AKSHTO (LRD) 18.10.2	A709 CR 50 or 50M
ASSEMBLY 2: G1	6C	6C1	1	1.500	29.000	18.000	12.250	4.500	0.000	7.525	0.250	2	1.675	40.0	40.000	6FB (6ip)	0.125	AKSHTO (LRD) 18.10.2	A709 CR 50 or 50M
ASSEMBLY 2: G4	6D	6D1	1	2.500	29.000	18.000	11.500	4.500	0.000	10.533	0.250	2	2.375	40.0	40.000	6FC (6ip)	0.125	AKSHTO (LRD) 18.10.2	A709 CR 50 or 50M

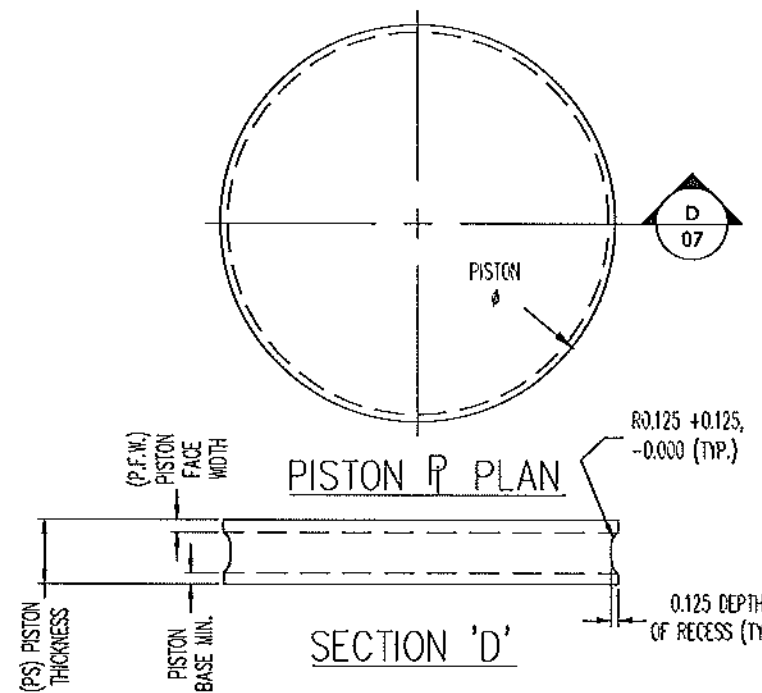

PISTON SCHEDULE (FWG)

ASSEM	PIECE	QTY	PS	PISTON	PISTON	
NO.	NO.		NO.	NO.	NO.	
6A	6A1	1	1.225	2.710	0.235	0.250
6B	6B1	1	1.225	2.710	0.235	0.250
6C	6C1	1	1.225	2.760	0.235	0.250
6D	6D1	1	1.600	10.460	0.239	0.250

Vermont Agency of Transportation
RECEIVED
CK'D BY GML OK'D BY JEL
8:53 am, Mar 29, 2012
RESUBMIT APPROVED X
BY KMH DATE 3/29/2012

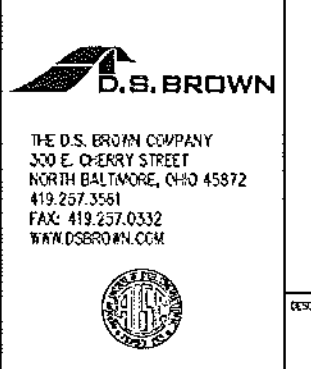


* PER PLATE
SEE SH. 08 FOR ASSEMBLY DETAILS & LOCATIONS
SEE SH. 08 FOR ADDITIONAL SUB-ASSEMBLY DETAILS
ALL DIMENSIONS ARE IN INCHES UNLESS OTHERWISE NOTED.

REV	DESCRIPTION	DATE	BY	CHKD
1	ADDED LOCATIONS TO MASONRY PLATE SCHEDULE	3/28/12	KTG	KTG


LOCATION	DESCRIPTION	ITEM	QUANTITY
LOCATION - TOWN HIGHWAY 6 BRIDGE NO. 57	BRIDGE - 57	-	-
PROJECT NO. - BRD 1442(26)	PROJECT NAME - SPRINGSFIELD	-	-
DESIGNER - VIOT	CUSTOMER - T. BUCK CONSTRUCTION, INC.	-	-

PROJ. NO.	N.T.S.	DA	SCALE	DATE
FWG UNI-DIRECTIONAL HLBR SUB-ASSEMBLY DETAIL	35029	1112	1	07


ASSEMBLY
06

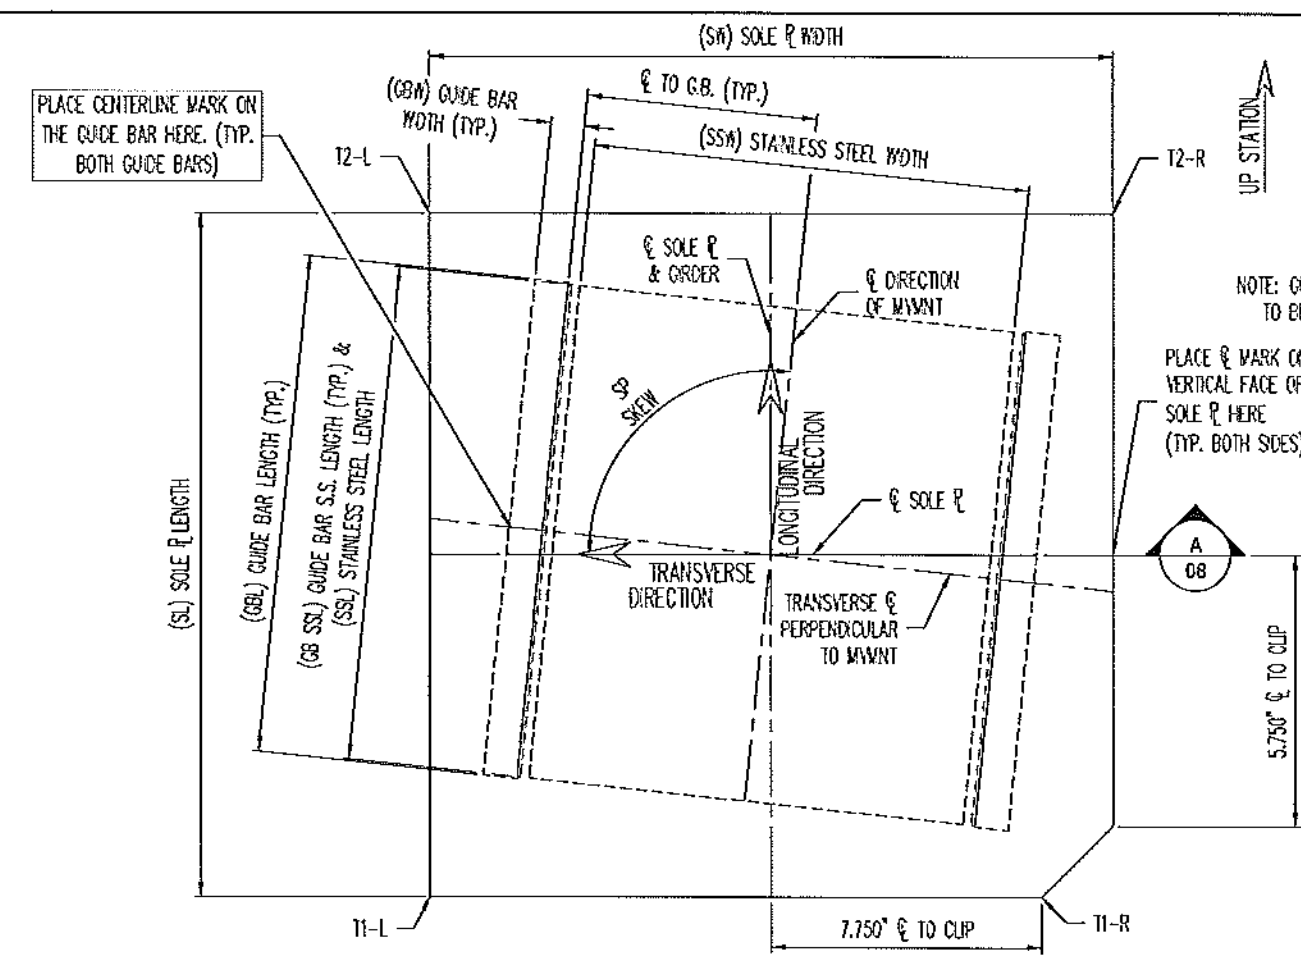

SOLE PLATE PLAN
SP SKEW > 90°

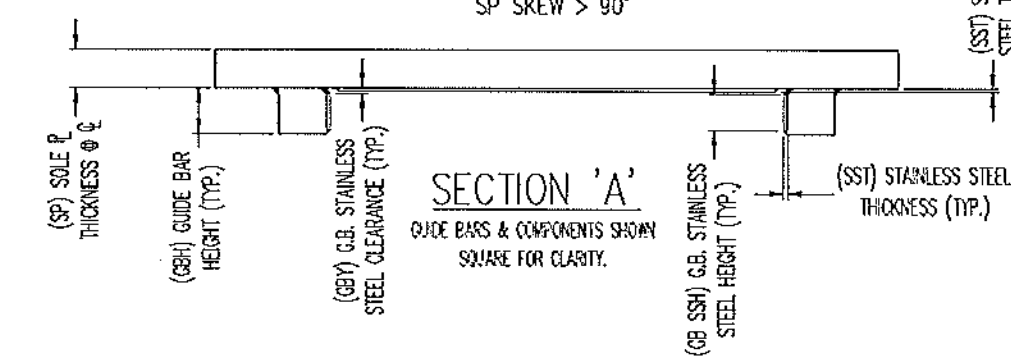


SECTION 'A'
GUIDE BARS & COMPONENTS SHOWN SQUARE FOR CLARITY

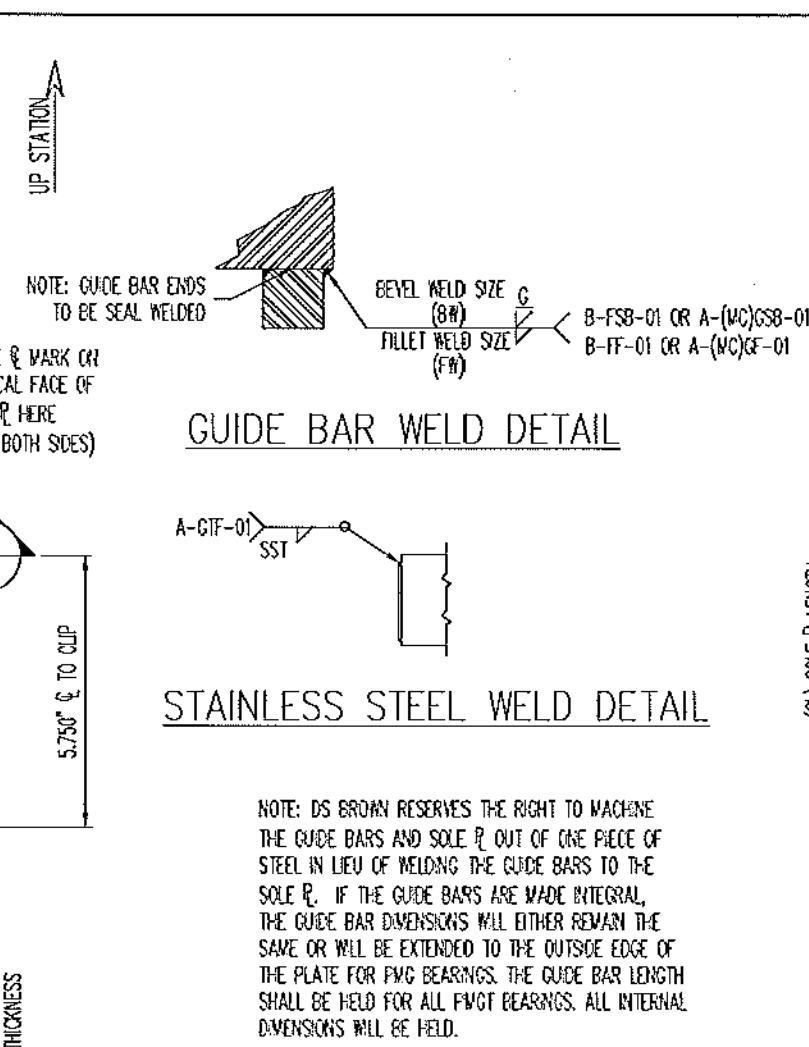


GUIDE BAR WELD DETAIL

STAINLESS STEEL WELD DETAIL

NOTE: D.S. BROWN RESERVES THE RIGHT TO MACHINE THE GUIDE BARS AND SOLE PLATE OUT OF ONE PIECE OF STEEL IN LIEU OF WELDING THE GUIDE BARS TO THE SOLE PLATE. IF THE GUIDE BARS ARE WELDED TO THE SOLE PLATE, THE GUIDE BAR DIMENSIONS WILL EITHER REMAIN THE SAME OR WILL BE EXTENDED TO THE OUTSIDE EDGE OF THE PLATE FOR FWD BEARINGS. THE GUIDE BAR LENGTH SHALL BE HELD FOR ALL FWD BEARINGS. ALL INTERNAL DIMENSIONS WILL BE HELD.

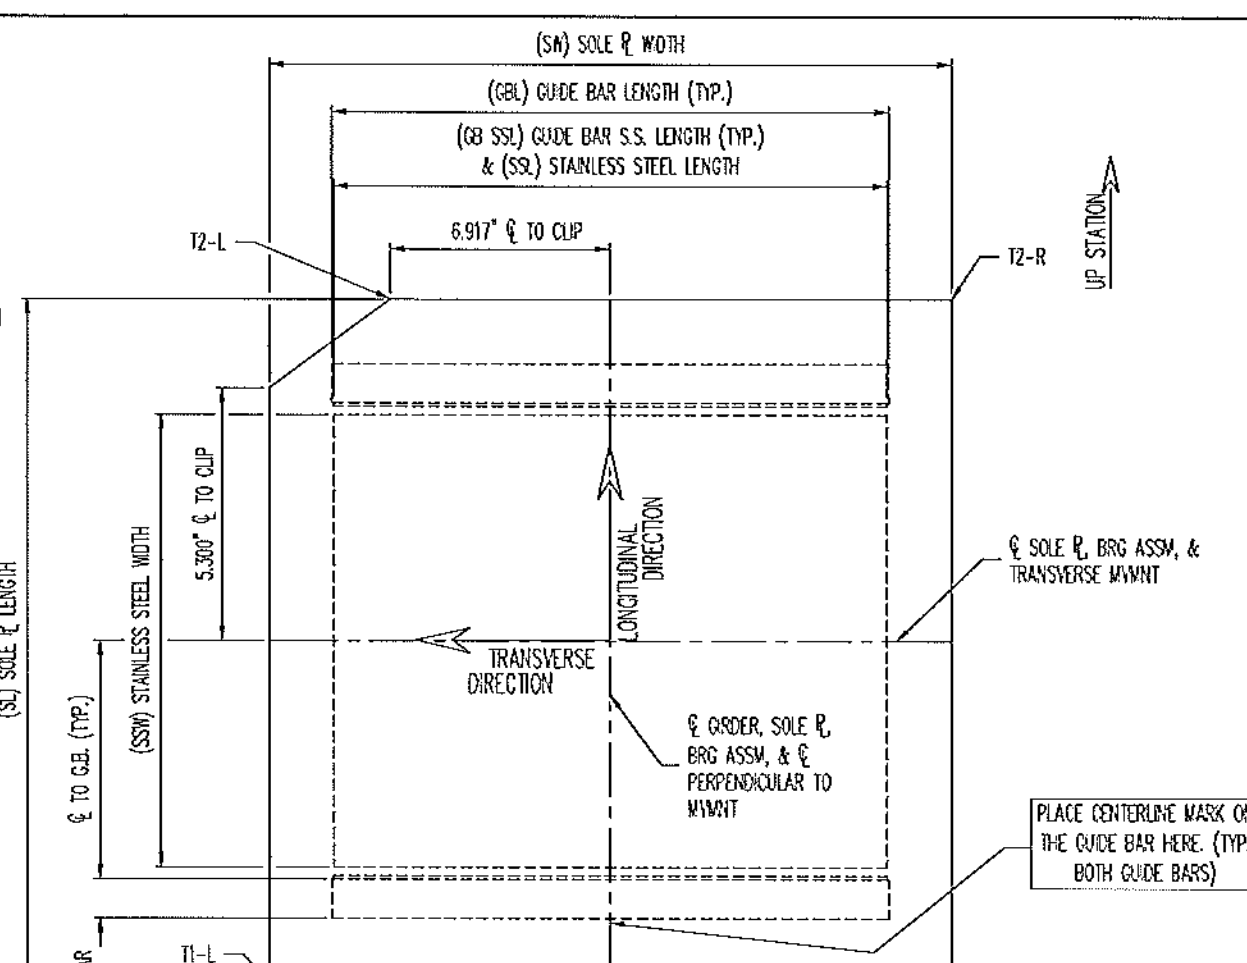

SOLE PLATE PLAN
SP SKEW = 0°

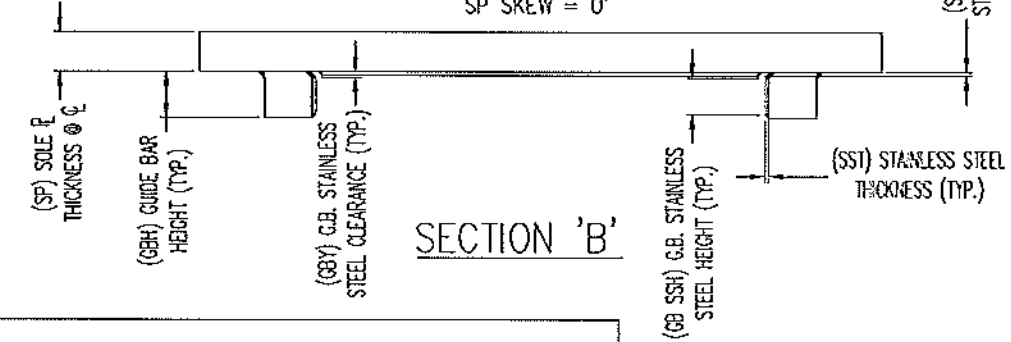


SECTION 'B'

LOCATION	ASSEMBLY	PART	QTY	BEVEL			SP	SW	SL	SOLE PLATE MATERIAL	SP SS MATERIAL			GR SS MATERIAL			GR MK	GR SH	GR SL	CL TO GR	GRY	FW	BR	GR MATERIAL	SP SKEW				
				TI-L	TI-R	TI-R					SS1	SS2	SS3	GR MK	GR SH	GR SL										GR MK	GR SH	GR SL	
ABUTMENT 1: G2	EA	Rep1	1	1.625	1.625	1.000	1.000	1.315	20.000	A709 GR 50 or 50W	6x11	0.120	8.750	11.750	A240 304, #8 & 28	6x11	1.250	11.750	A740 1304, #8 & 28	6x11	1.750	1.750	12.000	4.651	0.344	0.313	0.433 (0.313)	A709 GR 50 or 50W	+55.3"
ABUTMENT 1: G3	EB	Rep2	1	1.625	1.625	1.000	1.000	1.315	20.000	A709 GR 50 or 50W	6x11	0.120	8.750	11.750	A240 304, #8 & 28	6x11	1.250	11.750	A740 1304, #8 & 28	6x11	1.750	1.750	12.000	4.651	0.344	0.313	0.433 (0.313)	A709 GR 50 or 50W	+53.0"
ABUTMENT 2: G1	EC	Rep3	1	1.625	1.625	1.000	1.000	1.315	20.000	A709 GR 50 or 50W	6x12	0.120	8.250	10.250	A240 304, #8 & 28	6x12	1.125	10.250	A740 1304, #8 & 28	6x12	1.625	1.625	10.500	4.268	0.344	0.313	0.433 (0.313)	A709 GR 50 or 50W	+0.0"
ABUTMENT 2: G4	ED	Rep4	1	1.625	1.625	1.000	1.000	1.315	20.000	A709 GR 50 or 50W	6x13	0.120	11.500	13.500	A240 304, #8 & 28	6x13	1.625	13.500	A740 1304, #8 & 28	6x13	2.125	2.125	13.750	6.276	0.344	0.313	0.433 (0.313)	A709 GR 50 or 50W	+0.0"

SEE SH1, G6 FOR ASSEMBLY DETAILS & LOCATIONS.
SEE SH1, D7 FOR ADDITIONAL SUB-ASSEMBLY DETAILS.
ALL DIMENSIONS ARE IN INCHES UNLESS OTHERWISE NOTED.

Vermont Agency of Transportation
RECEIVED

CK'D BY GML OK'D BY JEL
8:53 am, Mar 29, 2012
RESUBMIT APPROVED X
BY KMH DATE 3/29/2012

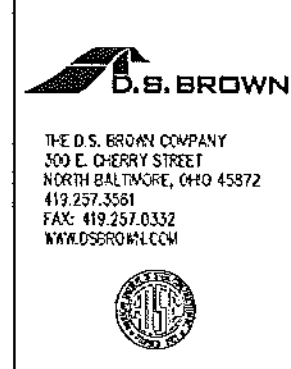

REV.	DESCRIPTION	DATE	BY	CHKD.	ITEM	QUANTITY
1	ADDED LOCATIONS TO SOLE PLATE SCHEDULE	3/28/12	KTG	KTG		
2	LOCATION --- TOWN HIGHWAY 6 BRIDGE NO. 57					
3	BRIDGE --- 57					
4	PROJECT NO. --- BRD 1442(28)					
5	PROJECT NAME --- SPRINGFIELD					
6	DESIGNER --- VDOT					
7	CUSTOMER --- T.BUCK CONSTRUCTION, INC.					

DSBROWN Production Joint Welding Procedure Specification (D1.5-08)


Procedure No: A-(MC)GF-01 Date Issued: 9-28-04 Revision No: 02 Rev. Date: 9-15-09

Contractor (Fabricator) D. S. Brown Company Prepared by: Brad Streeter, Quality Assurance Manager

1. Non-Fracture Critical Fracture Critical WPS Expiration Date: 8-11-14
2. Qualified in accordance with: AWS D1.5-2008 (5.13)
Referenced PQR No(s). PQR-(MC)GMAW-03(09)
Referenced FWST No(s). PQR-(MC)GMAW-FWST-01A(09), PQR-(MC)GMAW-FWST-01B(09)
3. Material specification(s) ASTM A709 Gr. 36, 50, 50W For DOT Approval
4. Material Thickness (es) Unlimited
5. Welding process GMAW
6. Manual , machine , or semiautomatic
7. Position(s) of welding 1F, 2F
8. Filler metal specification AWS A5.18
9. Filler metal class and brand name E70C-6M Corex Metal-Core Maxim
10. Flux class & brand N/A, Type N/A
11. Shielding gas 75% Ar / 25% CO2 Flow rate 45 CFH
12. Single pass Or multiple pass
13. Single arc Or multiple arc
14. Welding Current DCEP
15. Polarity Reverse
16. Welding progression stringers
17. Root treatment Clean to bright sound metal or per AWS D1.5 (3.2.1 & 3.11)
18. Postheat treatment N/A
19. Calculated Heat Input (KJ/in) Min 34.77 KJ/in Max 49.65 KJ/in
20. Electrode extension (electrical stickout) 3/4"

VTENS
Received
COC 6/14/12
FEB 28 2012
APPROVED
DATE 2/8/12

Weld size (in)	Pass No(s)	Electrode size (in)	Welding Process Variables		Travel Speed (IPM)
			AMPS/WFS*	VOLTS	
**1/4"	1	.052"	270-307	27.9-31	11.5-13
5/16"	1	.052"	270-307	27.9-31	11.5-13
3/8"	1-3	.052"	270-307	27.9-31	11.5-13
7/16"	2-4	.052"	270-307	27.9-31	11.5-13
1/2"	4-6	.052"	270-307	27.9-31	11.5-13
5/8"	5-7	.052"	270-307	27.9-31	11.5-13
3/4"	6-8	.052"	270-307	27.9-31	11.5-13

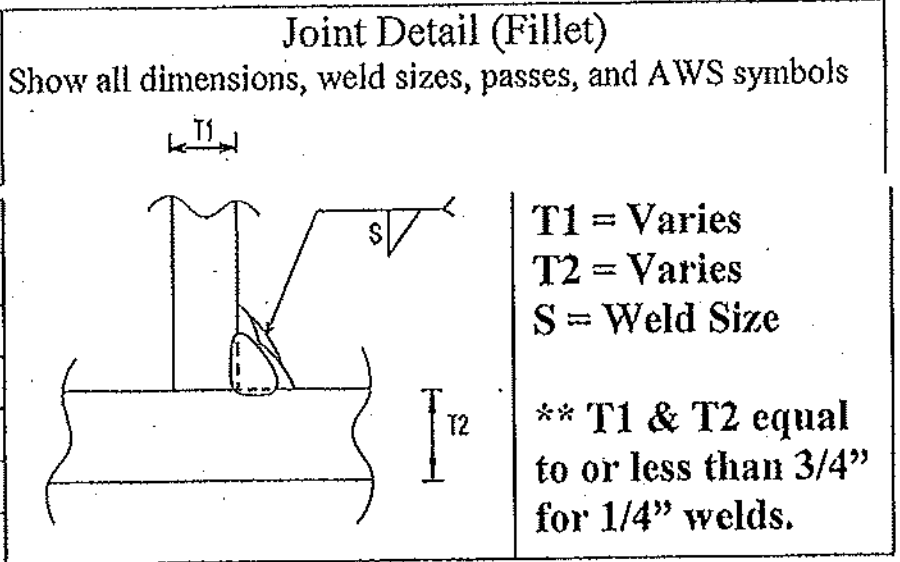

* Wire feed speed may be used along with amperage (include chart)

Prepared By: [Signature] DSB QA Manager

Project: _____

DSB Job: 35029-1112

Preheat and Interpass Temperature Chart

Base Metal Thickness range	Minimum Preheat (°F)	Max Preheat & Interpass (°F)
≤ 3/4"	50°F	450°F
> 3/4" to ≤ 1.5"	70°F	450°F
> 1.5" to ≤ 2.5"	150°F	450°F
> 2.5"	225°F	450°F

Note: When this procedure is used for A709Gr50W materials, it shall be limited to 5/16" single pass or material be coated.

DSBROWN Production Joint Welding Procedure Specification (D1.5-08)

Procedure No: A-(MC)GSB-01 Date Issued: 9-28-04 Revision No: 01 Rev. Date: 9-15-09

Contractor (Fabricator) D. S. Brown Company Prepared by: Brad Streeter, Quality Assurance Manager

1. Non-Fracture Critical Fracture Critical WPS Expiration Date: 8-11-14

2. Qualified in accordance with: AWS D1.5-2008 (5.13)

Referenced PQR No(s). PQR-(MC)GMAW-03(09)

Referenced FWST No(s). PQR-(MC)GMAW-FWST-01A(09), PQR-(MC)GMAW-FWST-01B(09)

3. Material specification(s) ASTM A709 Gr. 36, 50, 50W

For DOT Approval

4. Material Thickness (es) Unlimited

5. Welding process GMAW

6. Manual , machine , or semiautomatic

7. Position(s) of welding 1G, 2G, 1F, 2F

8. Filler metal specification AWS A5.18

9. Filler metal class and brand name E70C-6M Corex Metal-Core Maxim

10. Flux class & brand N/A, Type N/A

11. Shielding gas 75% Ar / 25% CO2 Flow rate 45 CFH

12. Single pass Or multiple pass

13. Single arc Or multiple arc

14. Welding Current DCEP

15. Polarity Reverse

16. Welding progression stringers

17. Root treatment Clean to bright sound metal or per AWS D1.5 (3.2.1 & 3.11)


18. Postheat treatment N/A

19. Calculated Heat Input (KJ/in) Min 34.77 KJ/in Max 49.65 KJ/in

20. Electrode extension (electrical stickout) 3/4"

Witness Received
OK'd by: JWC
DATE: FEB 28 2012
APPROVED BY: ST/SL

Weld size (in)	Pass No(s)	Electrode size (in)	Welding Process Variables		Travel Speed (IPM)
			AMPS/WFS*	VOLTS	
1/4"	1	.052"	270-307	27.9-31	11.5-13
5/16"	1	.052"	270-307	27.9-31	11.5-13
3/8"	1-2	.052"	270-307	27.9-31	11.5-13
1/2"	3-4	.052"	270-307	27.9-31	11.5-13
5/8"	4-6	.052"	270-307	27.9-31	11.5-13
3/4"	5-7	.052"	270-307	27.9-31	11.5-13
7/8"	6-9	.052"	270-307	27.9-31	11.5-13
1"	7-10	.052"	270-307	27.9-31	11.5-13

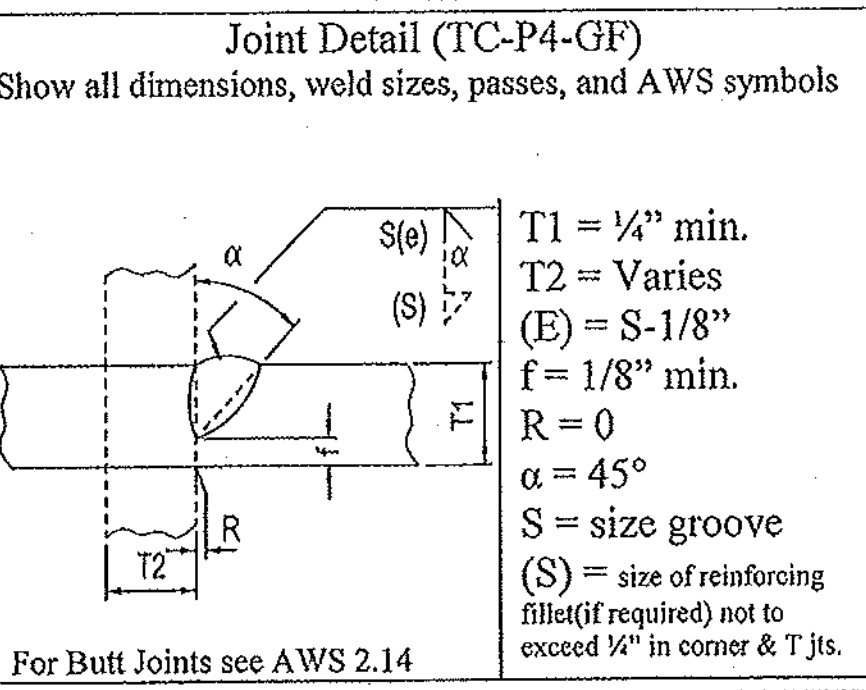

* Wire feed speed may be used along with amperage (include chart)
Prepared By: [Signature] DSB QA Manager
Project: _____
DSB Job: 35029-1112

Preheat and Interpass Temperature Chart

Base Metal Thickness range	Minimum Preheat (°F)	Max Preheat & Interpass (°F)
≤ 3/4"	50°F	450°F
>3/4" to ≤1.5"	70°F	450°F
>1.5" to ≤2.5"	150°F	450°F
>2.5"	225°F	450°F

Note: When this procedure is used for A709Gr50W materials, it shall be limited to 5/16" single pass or material be coated.


DSBROWN Production Joint Welding Procedure Specification (D1.5-08)

Procedure No: B-FF-01 Date Issued: 3-28-08 Revision No: 01 Rev. Date: 11-11-09
 Contractor (Fabricator) D. S. Brown Company Prepared by: Brad Streeter, Quality Assurance Manager

1. Non-Fracture Critical Fracture Critical WPS Expiration Date: 3-6-13
2. Qualified in accordance with: AWS D1.5-2008 (5.13)
 Referenced PQR No(s): PQR-FCAW-01-(08)
 Referenced FWST No(s): PQR-FCAW-FWST-01A(08), PQR-FCAW-FWST-01B(08)
3. Material specification(s) ASTM A709 Gr. 36, 50, 50W For DOT Approval
4. Material Thickness (es) Unlimited
5. Welding process FCAW
6. Manual , machine , or semiautomatic
7. Position(s) of welding 1F, 2F
8. Filler metal specification AWS A5.20
9. Filler metal class and brand name E71T-1CH8 (UltraCore71C)
10. Flux class & brand N/A, Type N/A
11. Shielding gas 100% CO2 Flow rate 45 CFH
12. Single pass Or multiple pass
13. Single arc Or multiple arc
14. Welding Current DCEP
15. Polarity Reverse
16. Welding progression stringers
17. Root treatment Clean to bright sound metal or per AWS D1.5 (3.2.1 & 3.11)
18. Postheat treatment N/A
19. Calculated Heat Input (KJ/in) Min 32.2 KJ/in Max 45.8 KJ/in
20. Electrode extension (electrical stickout) 3/4"

VTrans Received OK by JTW
 FEB 28 2012
 Approved by [Signature]

Weld size (in)	Pass No(s)	Electrode Size (in)	Welding Process Variables		Travel Speed (IPD)
			AMPS/WFS*	VOLTS	
**1/4"	1	1/16"	257-295	26.1-29.5	11.4-12.5
5/16"	1	1/16"	257-295	26.1-29.5	11.4-12.5
3/8"	2-3	1/16"	257-295	26.1-29.5	11.4-12.5
7/16"	3-5	1/16"	257-295	26.1-29.5	11.4-12.5
1/2"	4-6	1/16"	257-295	26.1-29.5	11.4-12.5
5/8"	5-7	1/16"	257-295	26.1-29.5	11.4-12.5
3/4"	6-8	1/16"	257-295	26.1-29.5	11.4-12.5

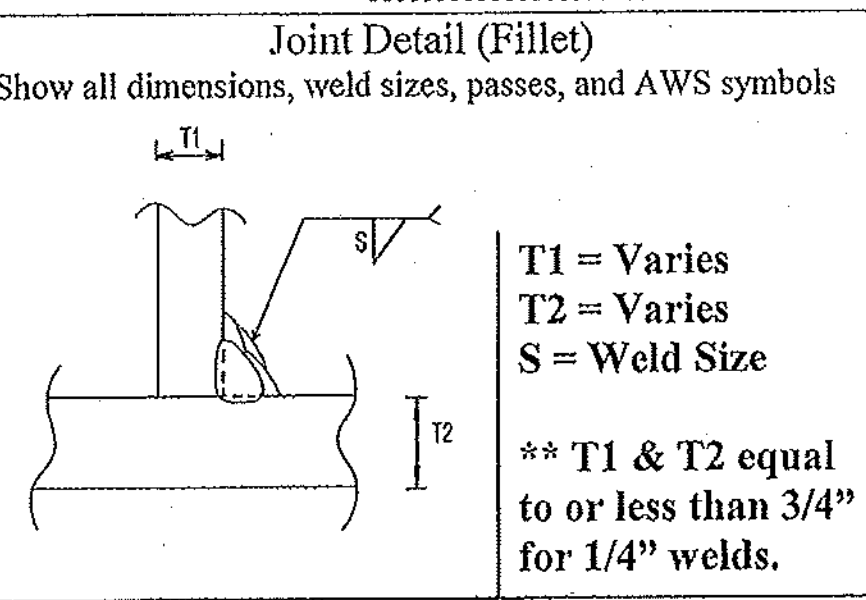

* Wire feed speed may be used along with amperage (include chart)

Prepared By: [Signature] DSB QA Manager

Project: _____

DSB Job: 35029-1112

Preheat and Interpass Temperature Chart		
Base Metal Thickness range	Minimum Preheat (°F)	Max Preheat & Interpass (°F)
≤ 3/4"	50°F	450°F
>3/4" to ≤1.5"	70°F	450°F
>1.5" to ≤2.5"	150°F	450°F
>2.5"	225°F	450°F

Note: When this procedure is used for A709Gr50W materials, it shall be limited to 5/16" single pass or material be coated.

DSBROWN Production Joint Welding Procedure Specification (D1.5-08)


Procedure No: B-FSB-01 Date Issued: 3-28-08 Revision No: 01 Rev. Date: 11-11-09
 Contractor (Fabricator) D. S. Brown Company Prepared by: Brad Streeter, Quality Assurance Manager

1. Non-Fracture Critical Fracture Critical WPS Expiration Date: 3-6-13
2. Qualified in accordance with: AWS D1.5-2008 (5.13)
 Referenced PQR No(s): PQR-FCAW-01-(08)
 Referenced FWST No(s): N/A, N/A
3. Material specification(s) ASTM A709 Gr. 36, 50, 50W
4. Material Thickness (es) Unlimited
5. Welding process FCAW
6. Manual , machine , or semiautomatic
7. Position(s) of welding 1G, 2G, (1F, 2F)
8. Filler metal specification AWS A5.20
9. Filler metal class and brand name E71T-1CH8 (UltraCore71C)
10. Flux class & brand N/A, Type N/A
11. Shielding gas 100% CO2 Flow rate 45 CFH
12. Single pass Or multiple pass
13. Single arc Or multiple arc
14. Welding Current DCEP
15. Polarity Reverse
16. Welding progression Stringers
17. Root treatment Clean to bright sound metal or per AWS D1.5 (3.2.1 & 3.11)
18. Postheat treatment N/A
19. Calculated Heat Input (KJ/in) Min 32.2 KJ/in Max 45.8 KJ/in
20. Electrode extension (electrical stickout) 3/4"

For DOT Approval

RECEIVED
 FEB 28 2012
 APPROVED
 DATE

Weld Size (in)	Pass No(s)	Electrode Size (in)	Welding Process Variables		Travel Speed (IPM)	T1 (in)	T2 (in)
			AMPS/WFS*	VOLTS			
**1/4"	1	1/16"	257-295	26.1-29.5	11.4-12.5		
5/16"	1	1/16"	257-295	26.1-29.5	11.4-12.5		
3/8"	2-3	1/16"	257-295	26.1-29.5	11.4-12.5		
1/2"	3-4	1/16"	257-295	26.1-29.5	11.4-12.5		
5/8"	4-6	1/16"	257-295	26.1-29.5	11.4-12.5		
3/4"	5-7	1/16"	257-295	26.1-29.5	11.4-12.5		
7/8"	6-8	1/16"	257-295	26.1-29.5	11.4-12.5		
1"	7-9	1/16"	257-295	26.1-29.5	11.4-12.5		

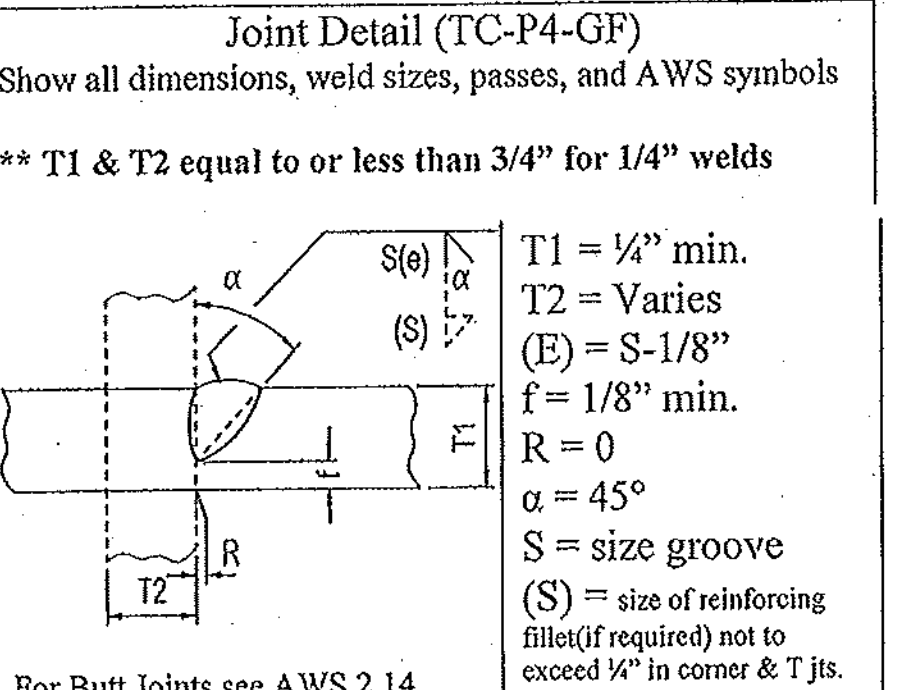

* Wire feed speed may be used along with amperage (include chart)
 Prepared By: [Signature] DSB QA Manager
 Project: _____
 DSB Job: 35029-1112

Preheat and Interpass Temperature Chart

Base Metal Thickness range	Minimum Preheat (°F)	Max Preheat & Interpass (°F)
≤ 3/4"	50°F	450°F
> 3/4" to ≤ 1.5"	70°F	450°F
> 1.5" to ≤ 2.5"	150°F	450°F
> 2.5"	225°F	450°F

Note: When this procedure is used for A709Gr50W materials, it shall be limited to 5/16" single pass or material be coated.

DSBROWN Production Joint Welding Procedure Specification (D1.5-08)

Procedure No: A-GTF-01 Date Issued: 1-9-04 Revision No: 01 Rev. Date: 5-15-09

Contractor (Fabricator) D.S. Brown Company Prepared by: Brad Streeter, Quality Assurance Manager

1. Non-Fracture Critical Fracture Critical WPS Expiration Date: _____

2. Qualified in accordance with: AWS D1.5-2008, AWS D1.6-07

Referenced PQR No(s): PQR-GTAW-01-(07)NY

Referenced FWST No(s): PQR-GTAW-01(03)

3. Material specification(s) ASTM A709 Gr. 36, 50, 50W, 304SS, 316SS For DOT Approval

4. Material Thickness (es) Unlimited

5. Welding process GTAW

6. Manual , machine , or semiautomatic

7. Position(s) of welding 1F, 2F

8. Filler metal specification AWS A5.9

9. Filler metal class and brand name EK309L (Murrex)

10. Flux class & brand N/A, Type N/A

11. Shielding gas 100% Argon Flow rate 20 CFH

12. Single pass Or multiple pass

13. Single arc Or multiple arc

14. Welding Current DCEN

15. Polarity Straight

16. Welding progression stringers


17. Root treatment Clean to bright sound metal or per AWS D1.5 (3.2.1 & 3.11)

18. Postheat treatment N/A

19. Calculated Heat Input (KJ/in) Min 10.9 KJ Max 20.4 KJ

20. Electrode extension (electrical stickout) N/A

Trans Received
DATE BY
FEB 28 2012
APPROVED
DATE BY

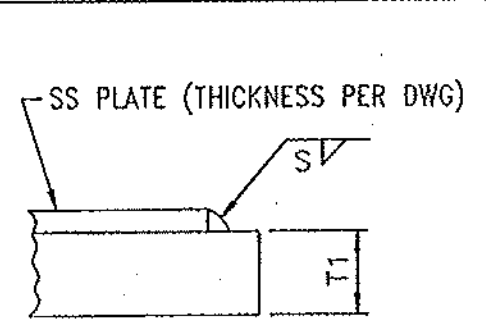Weld size (in)	Pass No.(s)	Electrode Size (in)	Welding Process Variables		Travel Speed (IPM)	Joint Detail (Fillet Weld) Show all dimensions, weld sizes, passes, and AWS symbols
			AMPS/WFS*	VOLTS		
20 ga.	1	1/8"	170-200	15-17	12.6-15.4	 <p>T₁ = Varies S = Fillet Weld Size (Fillet weld must not exceed thickness of stainless steel)</p>
16 ga.	1	1/8"	170-200	15-17	12.6-15.4	
14 ga.	1	1/8"	170-200	15-17	12.6-15.4	
12 ga.	1	1/8"	170-200	15-17	12.6-15.4	
11 ga.	1	1/8"	170-200	15-17	12.6-15.4	
10 ga.	1	1/8"	170-200	15-17	12.6-15.4	
8 ga.	1	1/8"	170-200	15-17	12.6-15.4	
3/16"	1	1/8"	170-200	15-17	12.6-15.4	

* Wire feed speed may be used along with amperage (include chart)
Prepared By: [Signature] DSB QA Manager

Project: _____

DSB Job: 35029-1112

Base Metal Thickness range	Minimum Preheat (°F)	Max Preheat & Interpass (°F)
≤ 3/4"	50°F	450°F
>3/4" to ≤1.5"	70°F	450°F
>1.5" to ≤2.5"	150°F	450°F
>2.5"	225°F	450°F

Note: When this procedure is used for A709Gr50W materials, it shall be limited to 5/16" single pass or material be coated.

VERMONT DEPARTMENT OF TRANSPORTATION
RECEIVED
 CRD BY: GWH, CRD BY: JWC

6:29 AM, Feb 29, 2012
 RESUBMIT APPROVED X PROCLAIMER X QUALITY CERTIFIED YES (X)
 BY KWH DATE 3/14/2012 PROCLAIMER QUALITY CERTIFIED YES (X)

Company Name: ABC Electrical, Inc.
 Registration No: 12345678
 Licensee Name: GWH
 License No: 12345678
 Expiration Date: 12/31/2012
 License Type: Electrical
 License Status: Active

WIREMAN INFORMATION

NAME: JOHN DOE
 ADDRESS: 123 MAIN ST, VERMONT, VT 05401
 PHONE: (802) 123-4567
 EMAIL: john.doe@abc.com

EMPLOYER INFORMATION


COMPANY: ABC ELECTRICAL, INC.
 ADDRESS: 456 MARKET ST, VERMONT, VT 05401
 PHONE: (802) 987-6543
 EMAIL: info@abc.com

PROJECT INFORMATION


PROJECT NAME: WIREMAN TRAINING
 ADDRESS: 789 RIVER ST, VERMONT, VT 05401
 PHONE: (802) 234-5678
 EMAIL: training@abc.com

Plate or Label	Size	Class	Quantity	Type & Weight	Quantity	Value	Notes
1	1/2"	2000A	100	10000	100	1000	
1	1/4"	2000A	100	10000	100	1000	
1	1/8"	2000A	100	10000	100	1000	
1	3/16"	2000A	100	10000	100	1000	
1	1/4"	2000A	100	10000	100	1000	
1	3/16"	2000A	100	10000	100	1000	
1	1/2"	2000A	100	10000	100	1000	
1	3/4"	2000A	100	10000	100	1000	
1	1"	2000A	100	10000	100	1000	
1	1 1/2"	2000A	100	10000	100	1000	
1	2"	2000A	100	10000	100	1000	
1	2 1/2"	2000A	100	10000	100	1000	
1	3"	2000A	100	10000	100	1000	
1	3 1/2"	2000A	100	10000	100	1000	
1	4"	2000A	100	10000	100	1000	
1	4 1/2"	2000A	100	10000	100	1000	
1	5"	2000A	100	10000	100	1000	
1	5 1/2"	2000A	100	10000	100	1000	
1	6"	2000A	100	10000	100	1000	
1	6 1/2"	2000A	100	10000	100	1000	
1	7"	2000A	100	10000	100	1000	
1	7 1/2"	2000A	100	10000	100	1000	
1	8"	2000A	100	10000	100	1000	
1	8 1/2"	2000A	100	10000	100	1000	
1	9"	2000A	100	10000	100	1000	
1	9 1/2"	2000A	100	10000	100	1000	
1	10"	2000A	100	10000	100	1000	
1	10 1/2"	2000A	100	10000	100	1000	
1	11"	2000A	100	10000	100	1000	
1	11 1/2"	2000A	100	10000	100	1000	
1	12"	2000A	100	10000	100	1000	
1	12 1/2"	2000A	100	10000	100	1000	
1	49"	2000A	100	10000	100	1000	
1	49 1/2"	2000A	100	10000	100	1000	
1	50"	2000A	100	10000	100	1000	


ABC

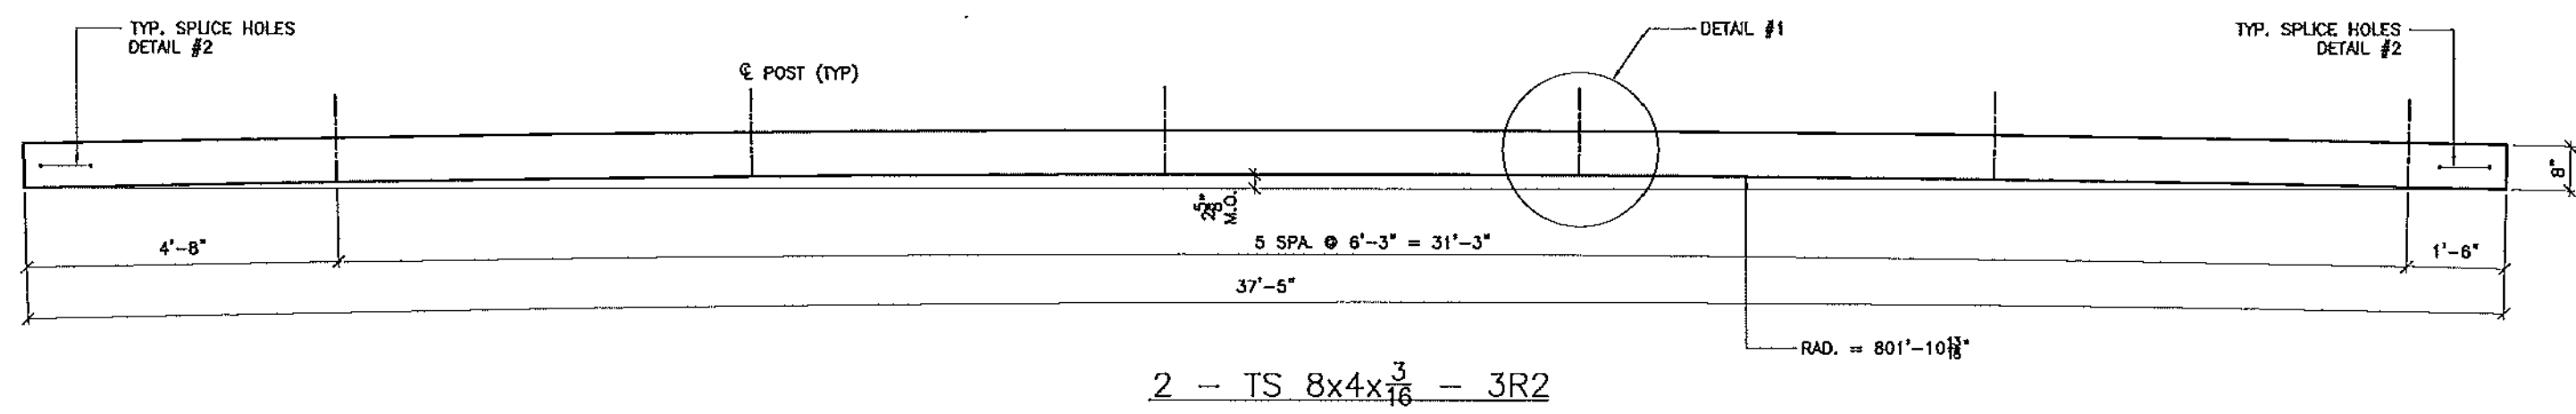


2 - TS 8x4x³/₁₆ - 3R2

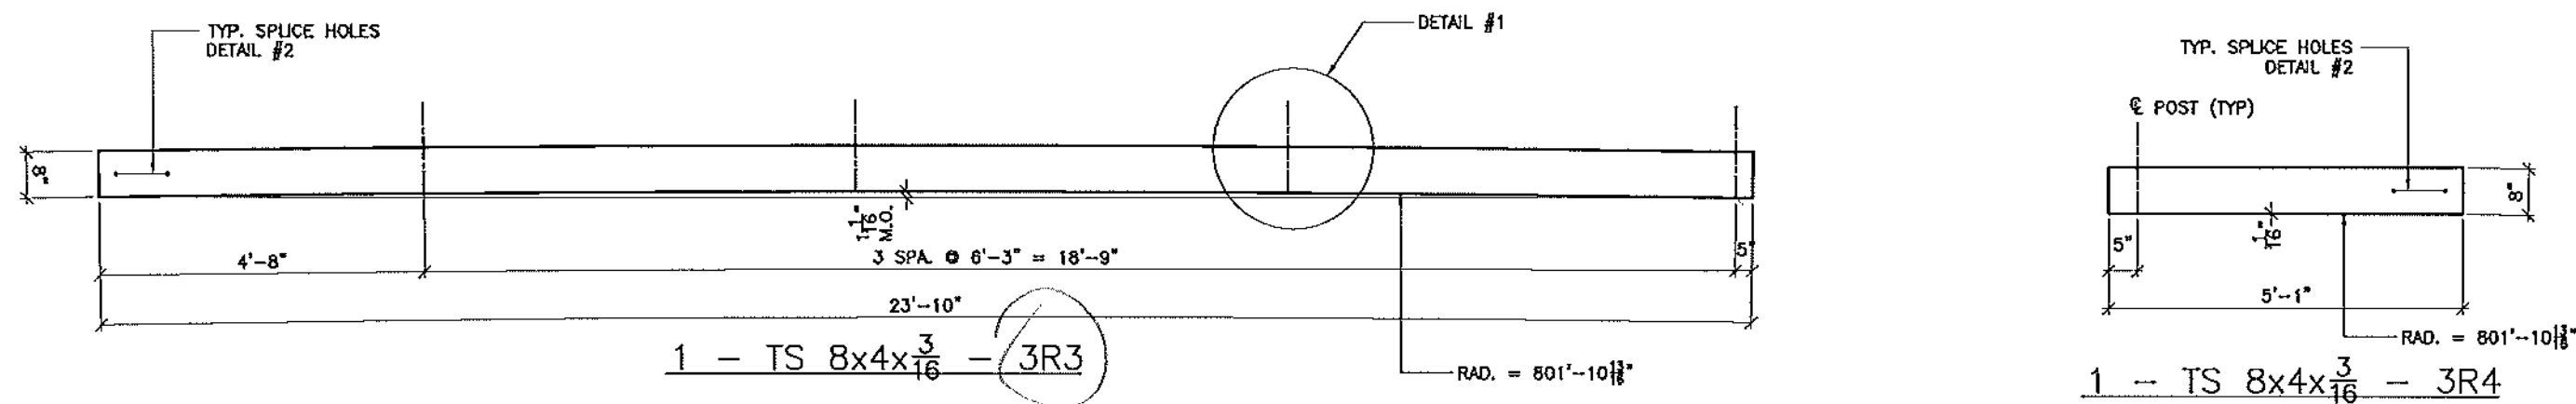


1 - TS 8x4x³/₁₆ - 3R3

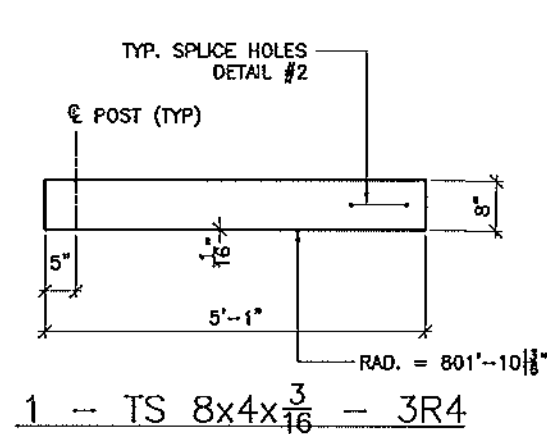


1 - TS 8x4x³/₁₆ - 3R4

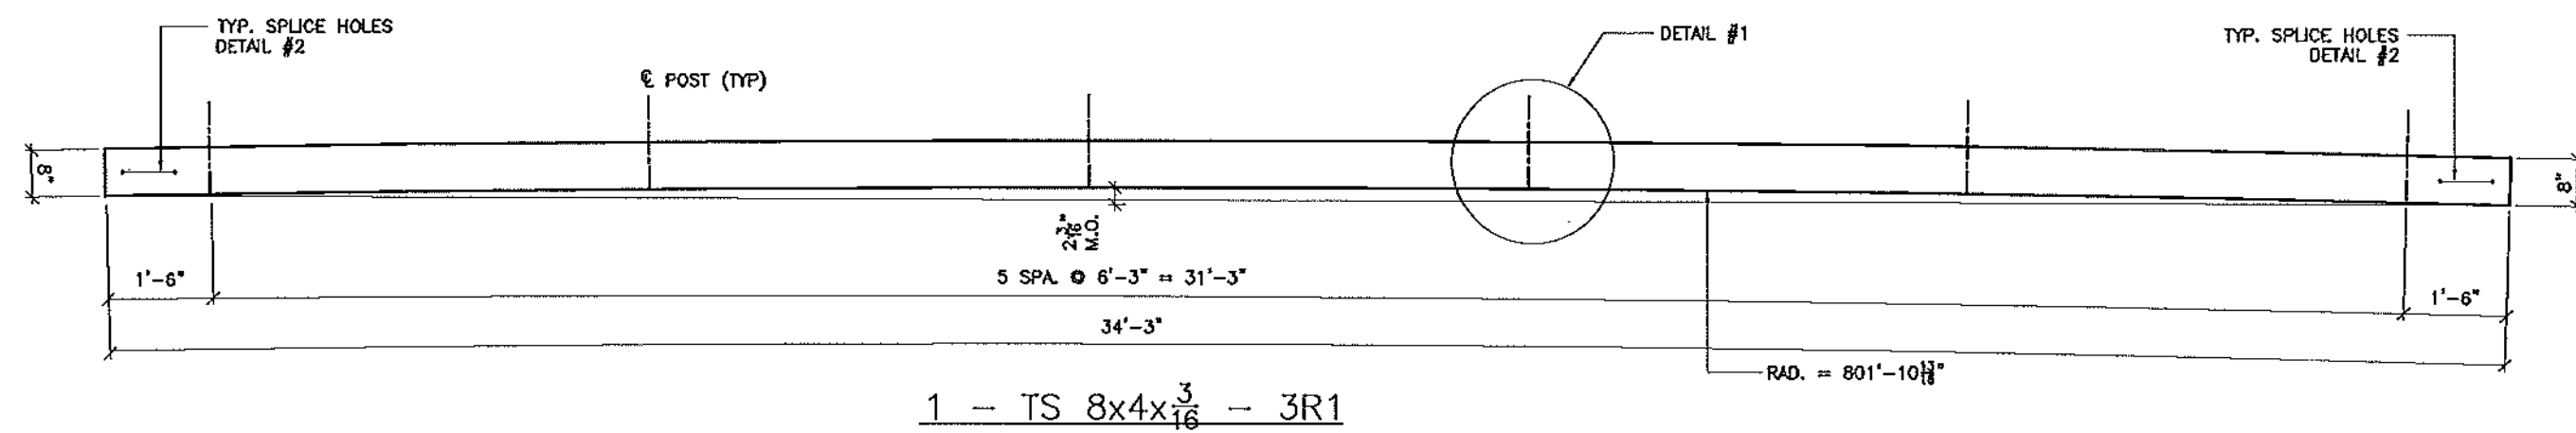


1 - TS 8x4x³/₁₆ - 3R1

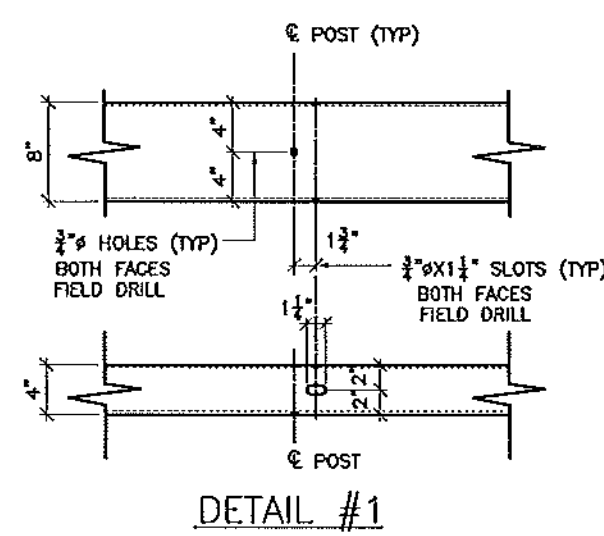

DETAIL #1

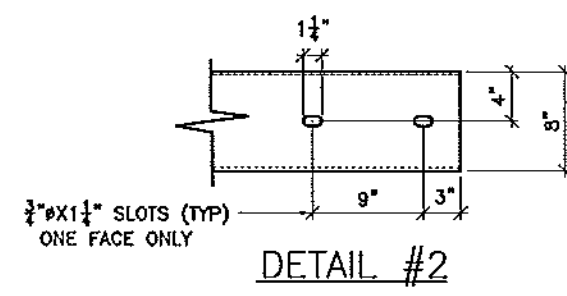

DETAIL #2

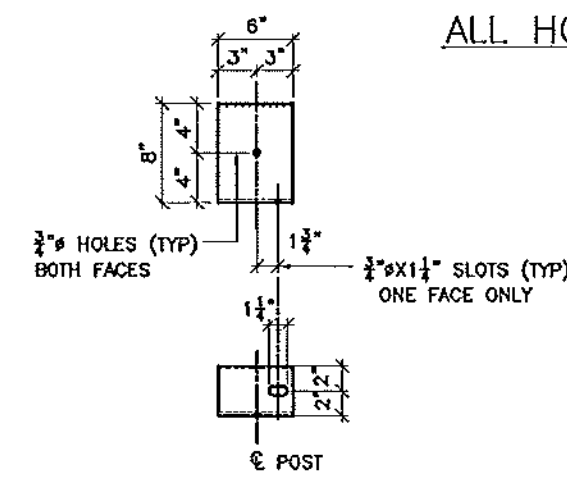

92 REQ'D. TS8X4X³/₁₆. MARK "T1"

ALL HOLES FOR POSTS ARE FIELD DRILLED

BILL OF MATERIAL

SNIP	SNIP MARK	NO. PCS.	PIECE MARK	DESCRIPTION	LENGTH	REMARKS	WT
1	3R1			TS 8x4x ³ / ₁₆	34'-3"	A500 GR.B	488
2	3R2			TS 8x4x ³ / ₁₆	37'-5"	A500 GR.B	1089
1	3R3			TS 8x4x ³ / ₁₆	23'-10"	A500 GR.B	345
1	3R4			TS 8x4x ³ / ₁₆	5'-1"	A500 GR.B	73
1	4R1			TS 8x4x ³ / ₁₆	37'-8"	A500 GR.B	544
2	4R2			TS 8x4x ³ / ₁₆	37'-5"	A500 GR.B	1089
1	4R3			TS 8x4x ³ / ₁₆	24'-11"	A500 GR.B	363
1	4R4			TS 8x4x ³ / ₁₆	5'-1"	A500 GR.B	73
92	T1			TS 8x4x ³ / ₁₆	0'-6"	A500 GR.B	688

TUBE: ASTM A500 GR. B
GALVANIZE AFTER FABRICATION PER AASHTO M111

Vermont Agency of Transportation
RECEIVED
OK'D BY J.GML OK'D BY JTS


3:46 pm, Mar 26, 2012

RESUBMIT APPROVED X
BY KMH DATE 3/28/2012


QUAN.	SIZE	LENGTH	TYPE	WASHERS	FINISH
				FLAT	RAW. AASHTO WASH

FINISH	HOT DIPPED GALVANIZED		
MATERIAL	AASHTO M270 GR. 30		
HOLES	AS NOTED		
ELECTRODES	PER W.P.S.		
WELDS	AS NOTED		
SURFACE PREP	SSPO-SPS		
NO.	DATE	PER APPROVAL	JAC
REVISIONS			


	ADVANCED RESOURCES & CONST. ENTERPRISES, INCORPORATED P.O. BOX 120 WINDFORD, ME 04947 PHONE: (207) 255-2848 - FAX: (207) 255-4054
DRAFTER JAC DATE 2/8/12 CHECKED MTD JOB 11-175	BRIDGE RAIL DETAILS VERMONT AGENCY OF TRANSPORTATION TOWN OF SPRINGFIELD, 11 # CLASS IN LOCAL ROAD T. BUCK CONSTRUCTION, INC.
	PROJECT NO. BR0 1442(24) DWG. NO. R3

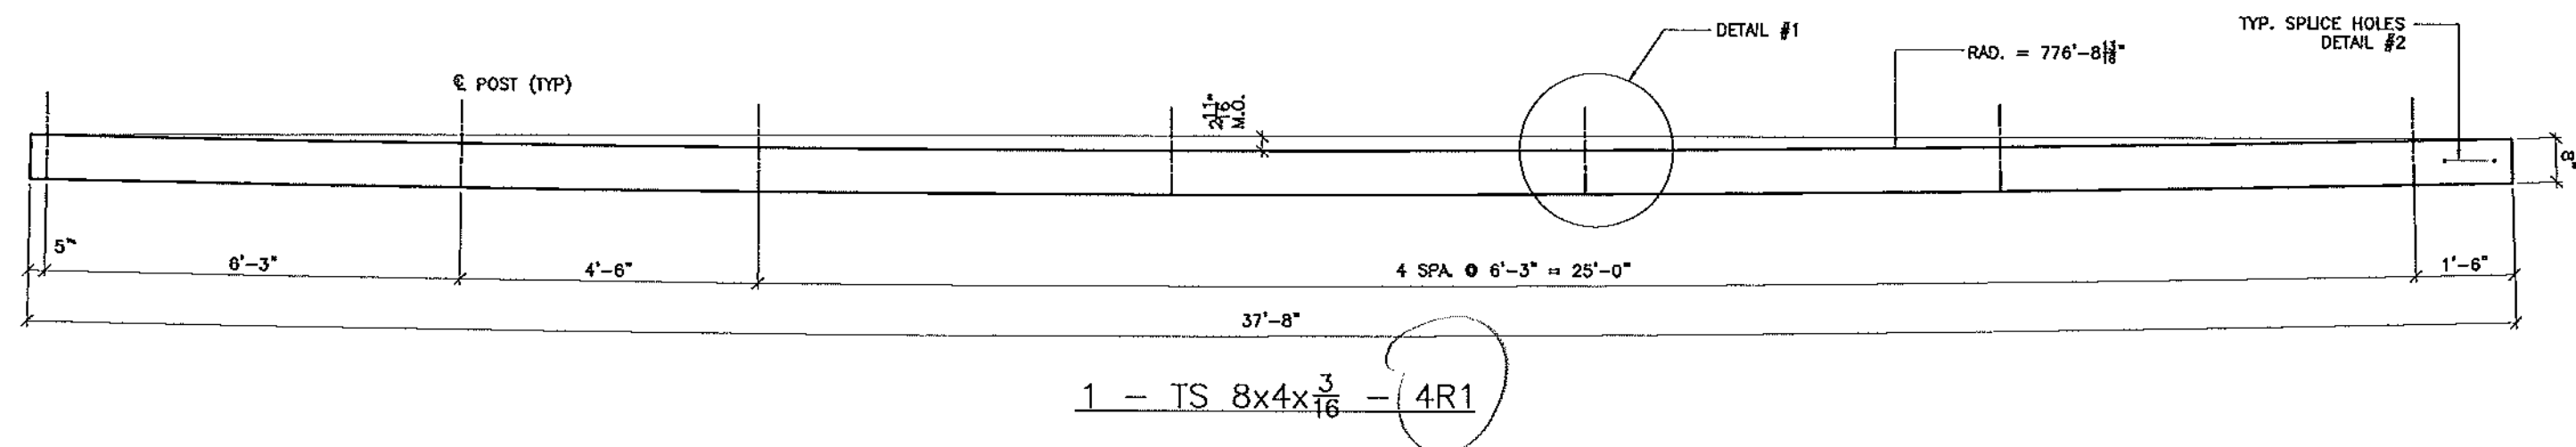


1 - TS 8x4x³/₁₆ - 4R1

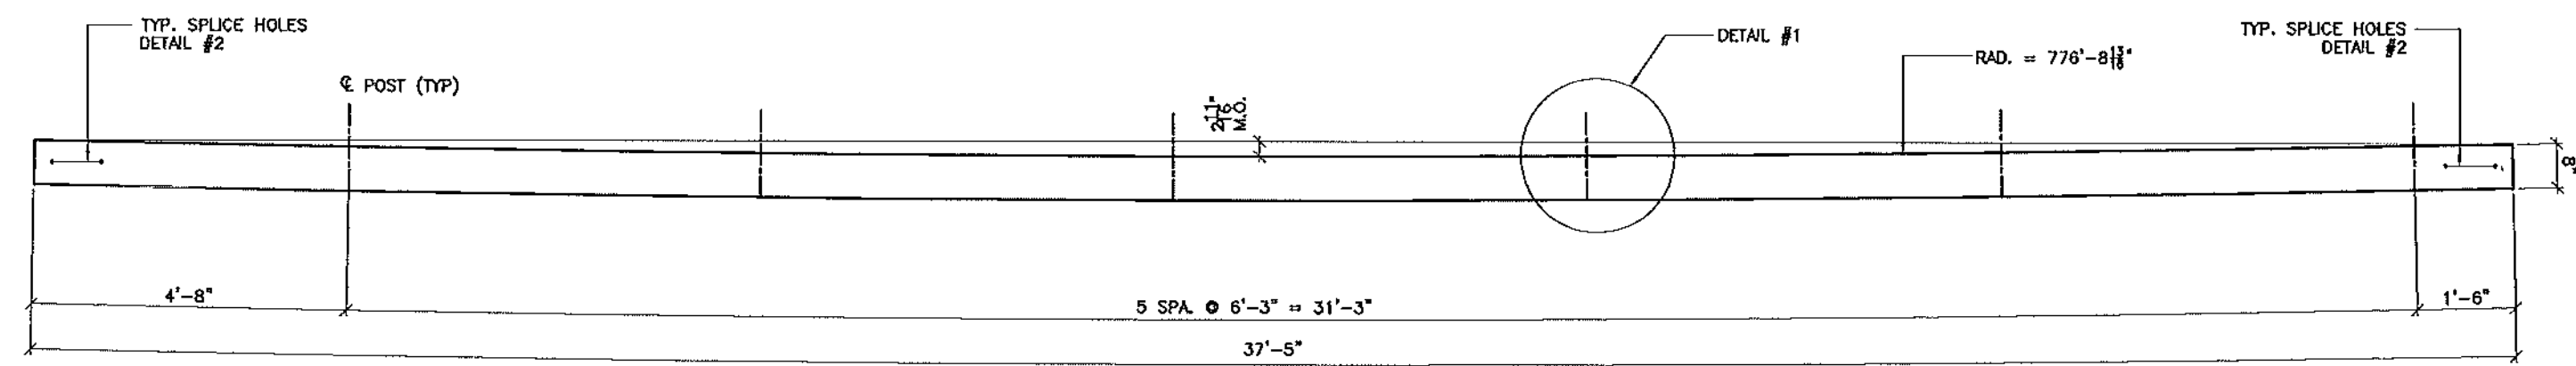

2 - TS 8x4x³/₁₆ - 4R2

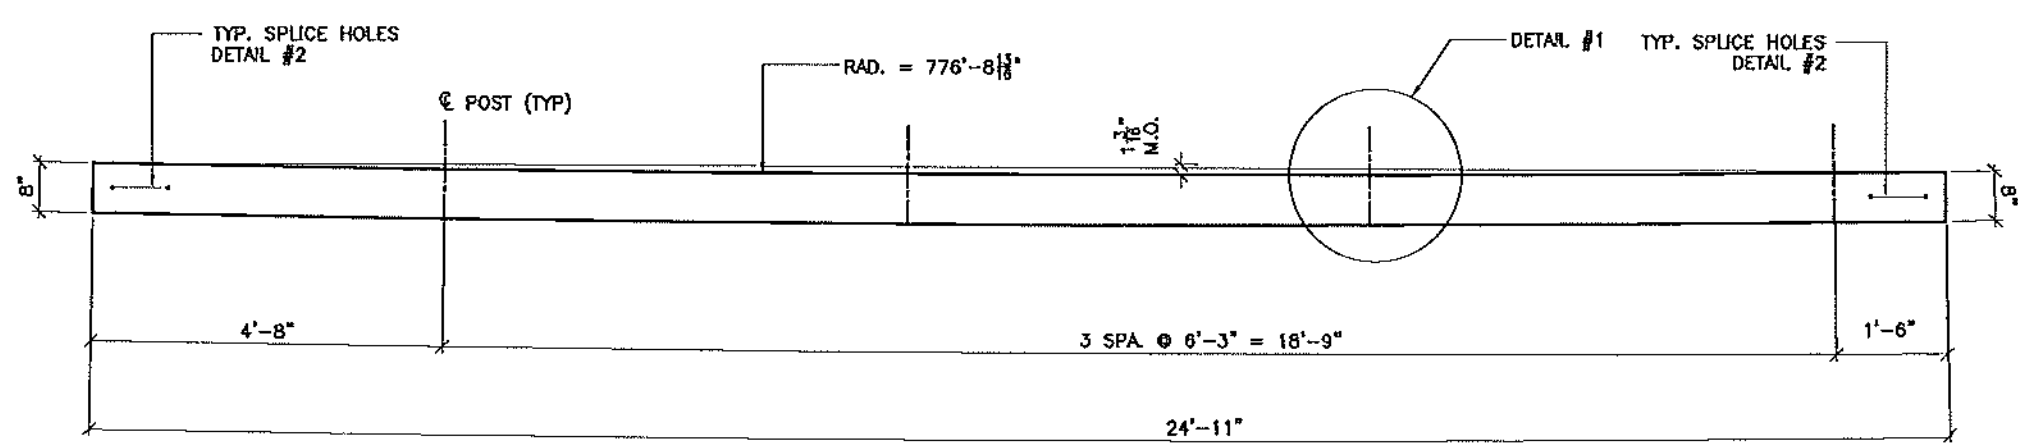

1 - TS 8x4x³/₁₆ - 4R3

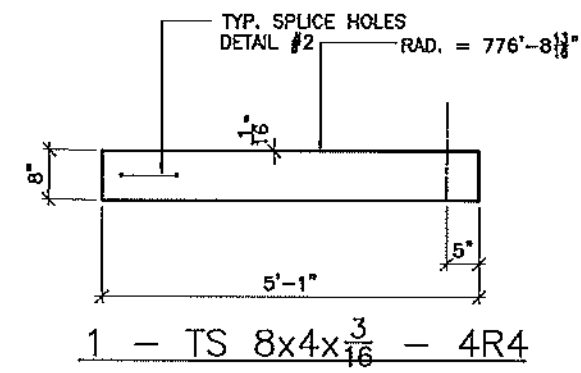

1 - TS 8x4x³/₁₆ - 4R4

ALL HOLES FOR POSTS ARE FIELD DRILLED

SEE DWG R3 FOR B.O.M. & DETAILS NOT SHOWN

TUBE: ASTM A500 GR. B
GALVANIZE AFTER FABRICATION PER AASHTO M111

Vermont Agency of Transportation

RECEIVED

CHK'D BY GML OK'D BY JTS






3:46 pm, Mar 26, 2012

RESUBMIT APPROVED X
BY KMH DATE 3/28/2012

DIRECTION BOLTS W/HAUL			WASHERS		FINISH	
QUAN.	SIZE	LENGTH	TYPE	FLAT	DRY.	CALV. AASHTO M250
FINISH			HOT DIPPED GALVANIZED			
MATERIAL			ASTM A500 GR. B			
HOLES			AS NOTED			
ELECTRODES			PER W.P.S.			
WELDS			AS NOTED			
SURFACE PREP			SSPC-SP8			
			NO.		DATE	
			NO.		DATE	

ARC
ADVANCED RESOURCES & CONST.
ENTERPRISES, INCORPORATED
P.O. BOX 120 NEWFIELd, ME 04847
PHONE: (207) 555-2669 - FAX: (207) 555-4054

DATE	2/9/12	PROJECT NO.	BRD 1442(24)
CHECKED	MTD	DWG. NO.	R4
JOB	11-175	BY	T. BUCK CONSTRUCTION, INC.

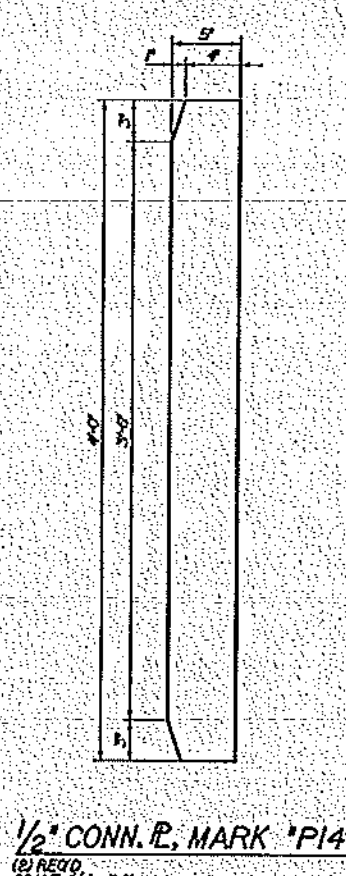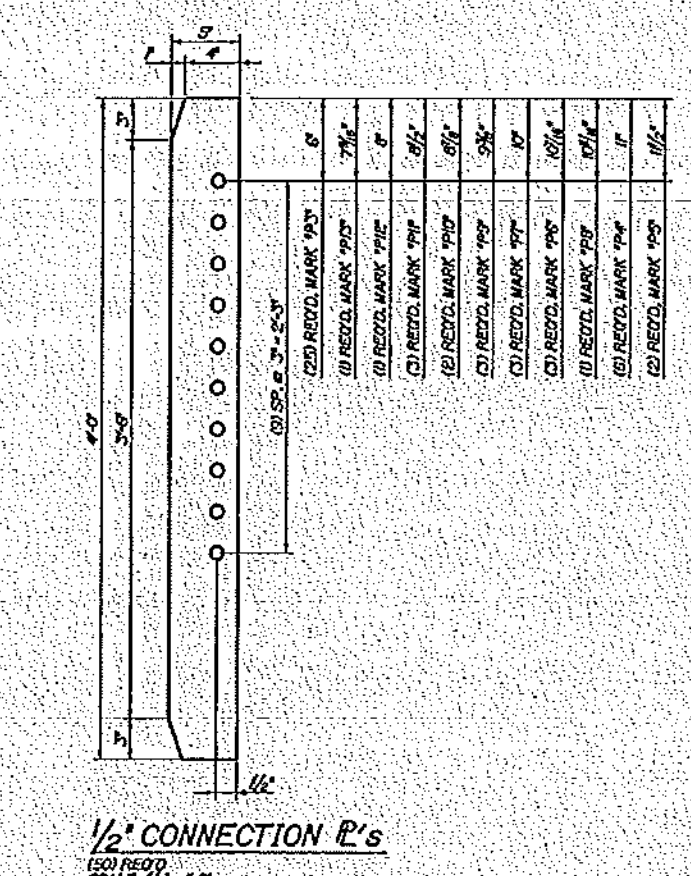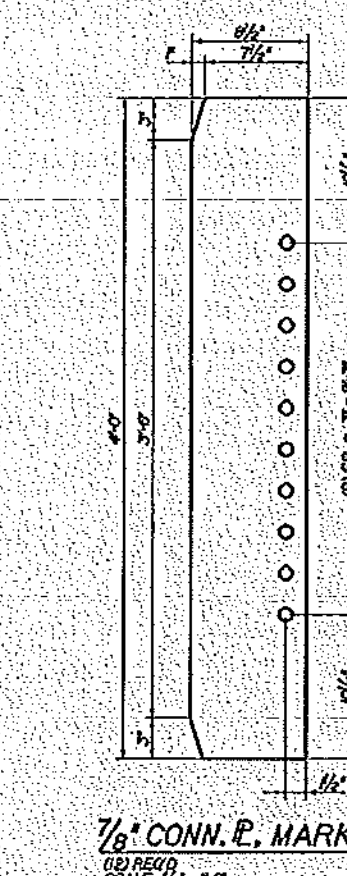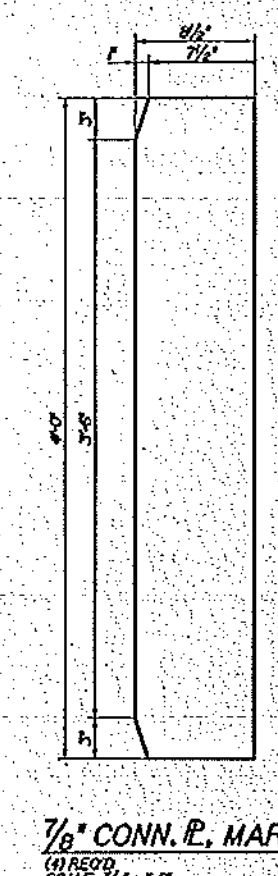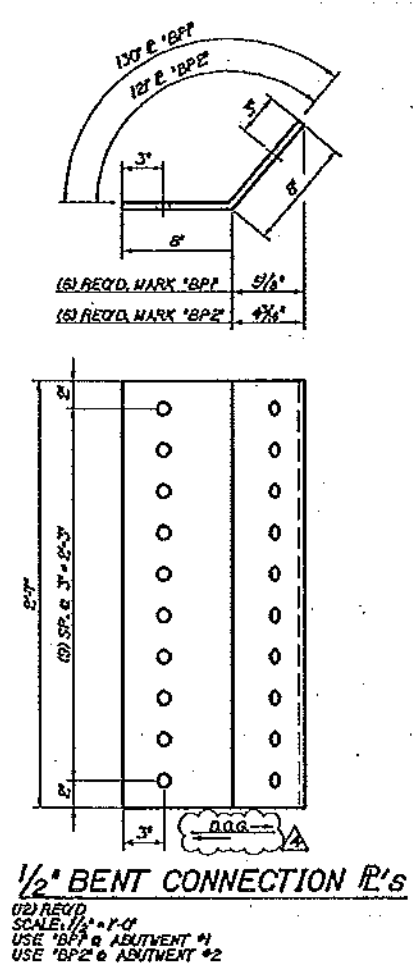




BILL OF MATERIALS

SHOP MARK	SHOP NO.	PIECE MARK	DESCRIPTION	LENGTH	REMARKS	MAT'L
	4	B11	E 1/2" x 1/2"	20"	TOP EACH	CON
	5	B12	E 1/2" x 1/2"	20"	TOP EACH	CON
	4	P1	E 1/2" x 1/2"	40"	TOP EACH	CON
	12	P2	E 1/2" x 1/2"	40"	TOP EACH	CON
	25	P3	E 1/2" x 1/2"	40"	3M EACH	CON
	6	P4	E 1/2" x 1/2"	40"	3M EACH	CON
	8	P5	E 1/2" x 1/2"	40"	3M EACH	CON
	3	P6	E 1/2" x 1/2"	40"	3M EACH	CON
	3	P7	E 1/2" x 1/2"	40"	3M EACH	CON
	1	P8	E 1/2" x 1/2"	40"	3M EACH	CON
	3	P9	E 1/2" x 1/2"	40"	3M EACH	CON
	2	P10	E 1/2" x 1/2"	40"	3M EACH	CON
	3	P11	E 1/2" x 1/2"	40"	3M EACH	CON
	1	P12	E 1/2" x 1/2"	40"	3M EACH	CON
	1	P13	E 1/2" x 1/2"	40"	3M EACH	CON
	2	P14	E 1/2" x 1/2"	40"	3M EACH	CON

FIELD BOLTS

NO.	MARK	SIZE	TYPE	ASTM
500	B01	1/2" BOLT W/ NUT	304	ASTM A307, TYPE 3
60	B02	3/4" BOLT W/ NUT	304	ASTM A307, TYPE 304/304L
60	B03	1/2" BOLT W/ NUT	304	ASTM A307, TYPE 304/304L
60	B04	1/2" BOLT W/ NUT	304	ASTM A307, TYPE 3

NOTES:
 ALL ASTM TYPE SUBJECTS ARE TO BE USED OUTSIDE THE PAINT LIMITS.
 ALL ASTM TYPE DISCONTINUED MARKS ARE TO BE USED WITH PAINT LIMITS.
 USE SHEET METAL UNITS.

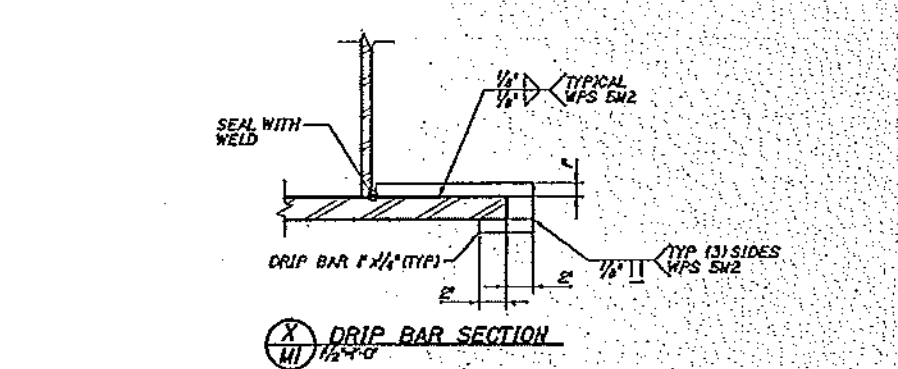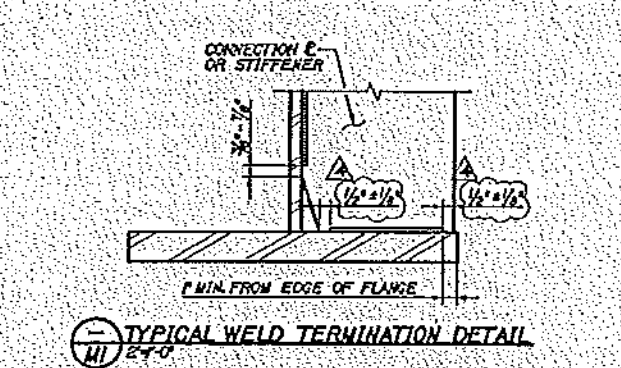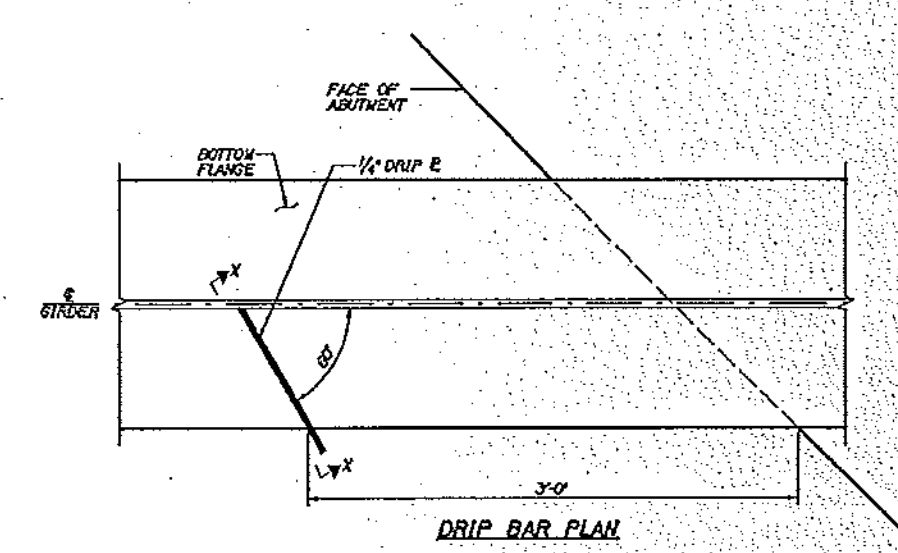



Vermont Agency of Transportation
RECEIVED
 CK'D BY GML OK'D BY JEL
 11:20 am, Mar 19, 2012
 RESUBMIT _____ APPROVED X
 BY KMH DATE 3/19/2012

NO.	DATE	REVISIONS
1	3/19/2012	ISSUED FOR PERMIT

ARC
 ADVANCED RESOURCES & CONST.
 ENTERPRISES, INCORPORATED
 P.O. BOX 10300, VERMONT, VT 05404
 PHONE: (802) 254-5151 FAX: (802) 254-5154








NO.	DATE	REVISIONS
1	3/19/2012	ISSUED FOR PERMIT

NO.	DATE	REVISIONS
1	3/19/2012	ISSUED FOR PERMIT

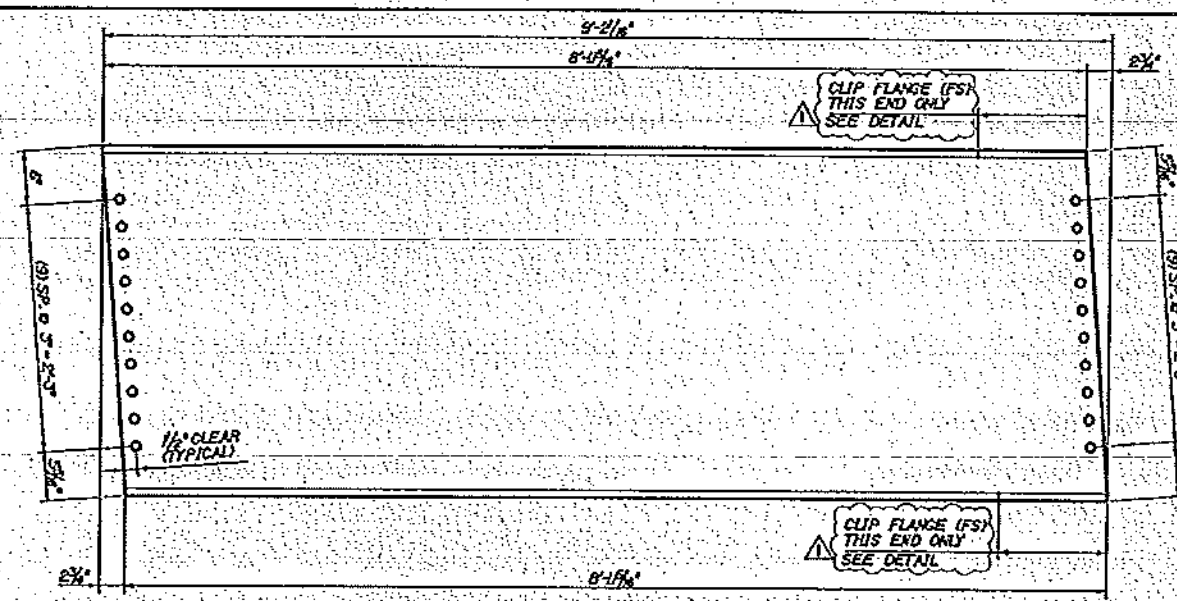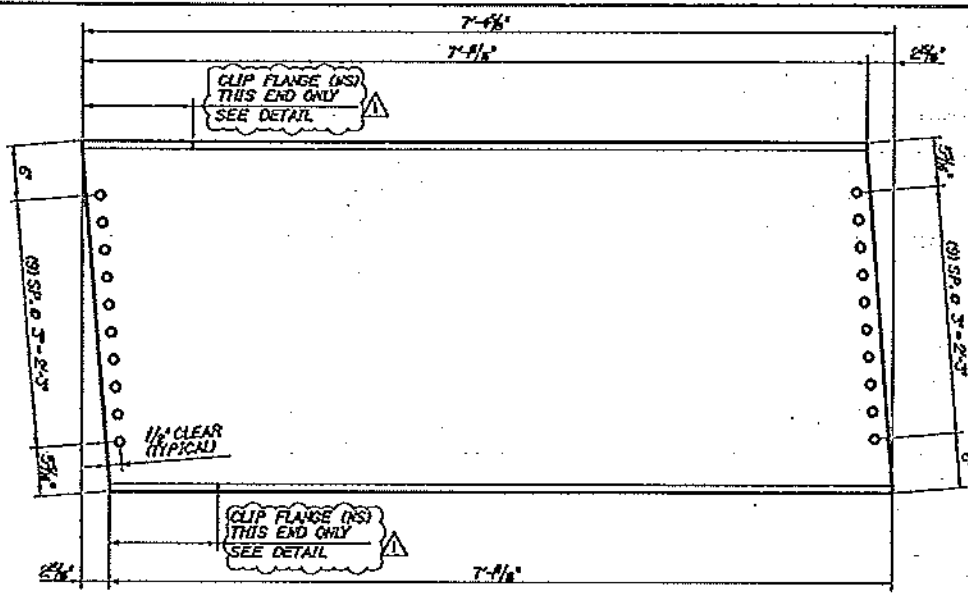

BILL OF MATERIALS

SHOP MARK	SHOP POS.	PIECE MARK	DESCRIPTION	LENGTH	REMARKS	QTY
		D1	W40x149	7'-0"	1055' EACH	1055
		D2	W40x149	7'-0"	1055' EACH	1055
		D3	W40x149	7'-0"	1055' EACH	1055
		D4	W40x149	9'-0"	1355' EACH	1355
		D5	W40x149	9'-0"	1355' EACH	1355
		D6	W40x149	9'-0"	1355' EACH	1355
		D7	W36x135	9'-0"	805' EACH	805

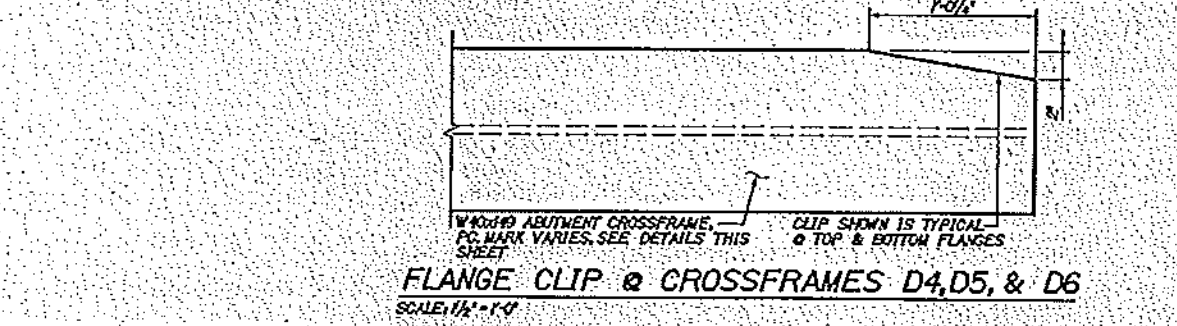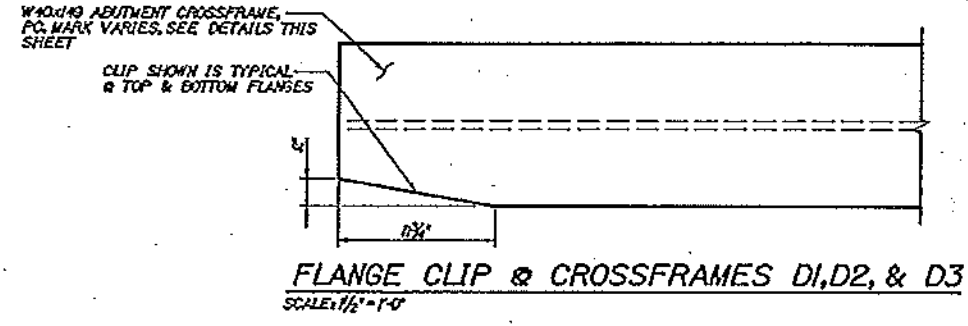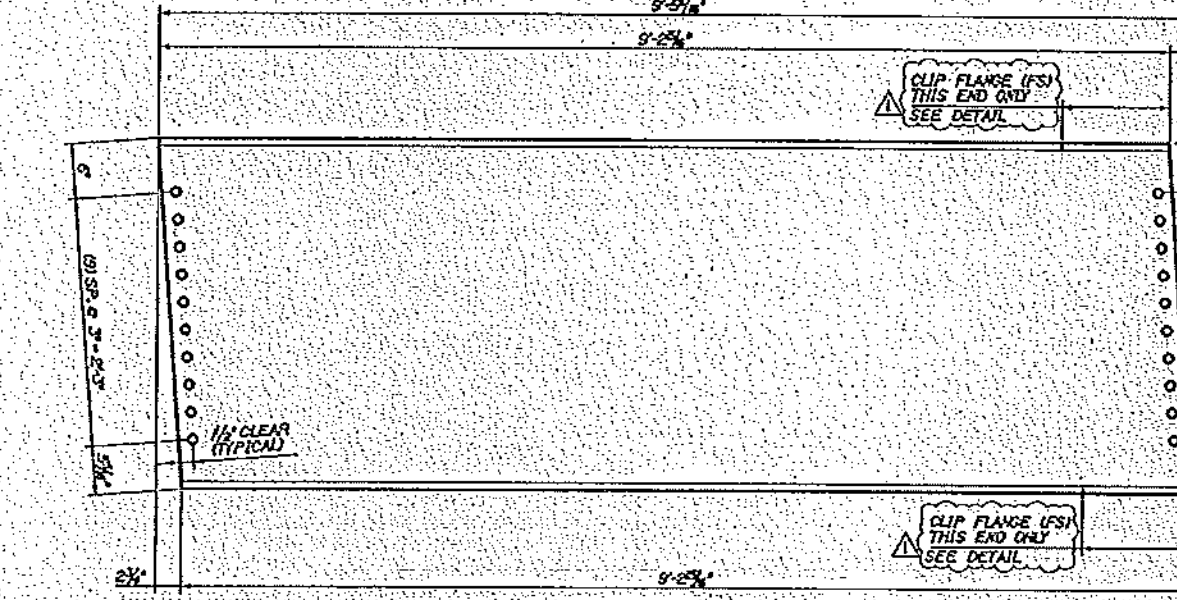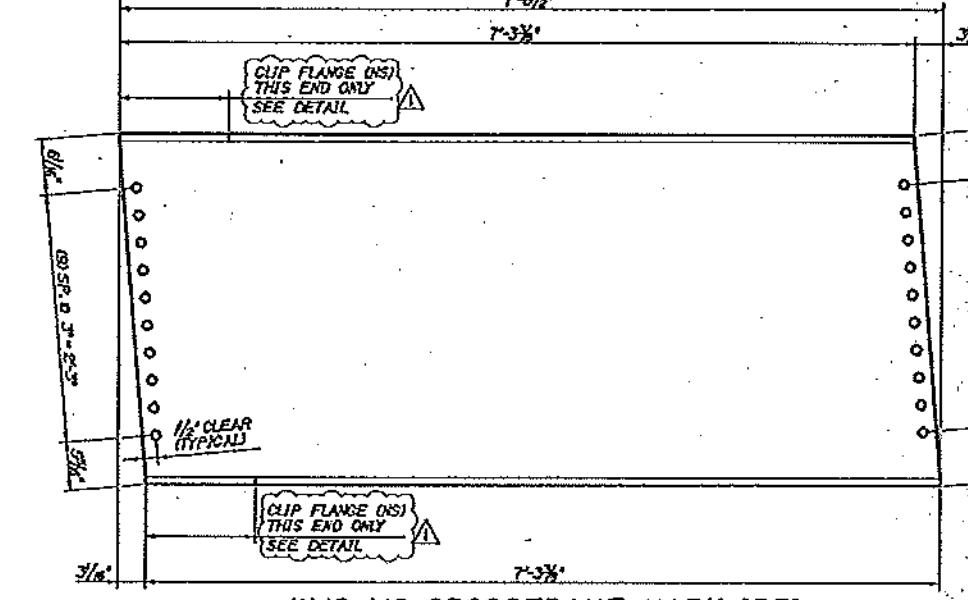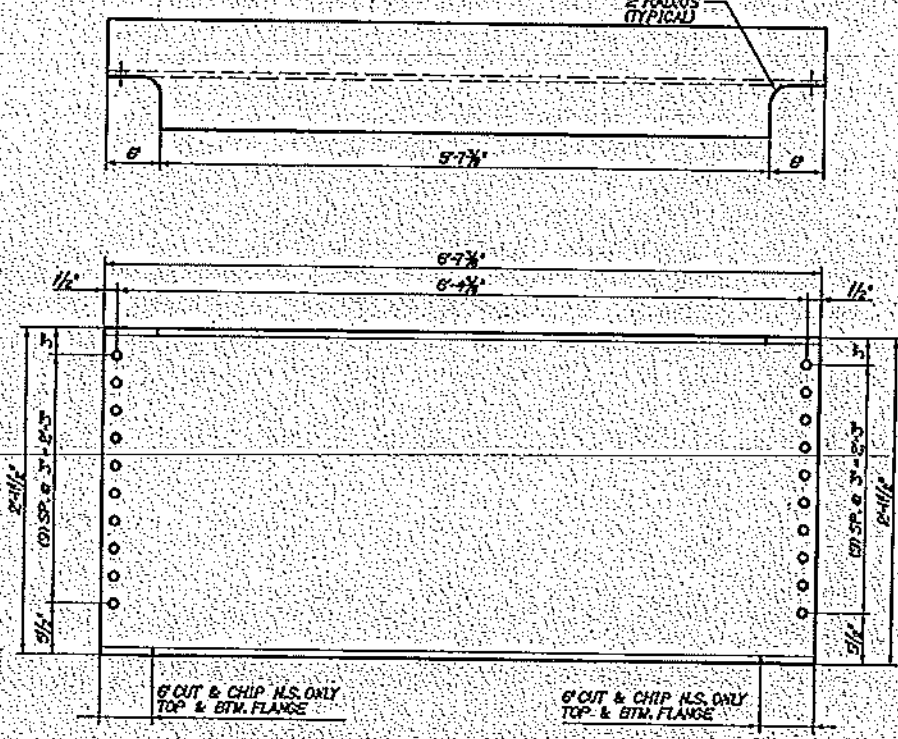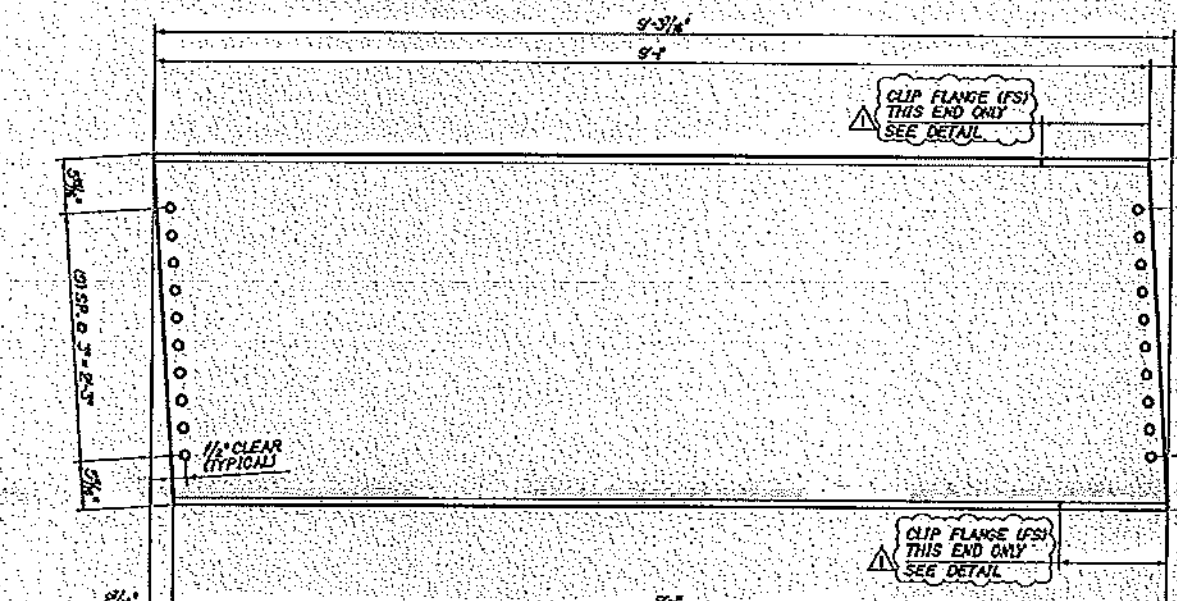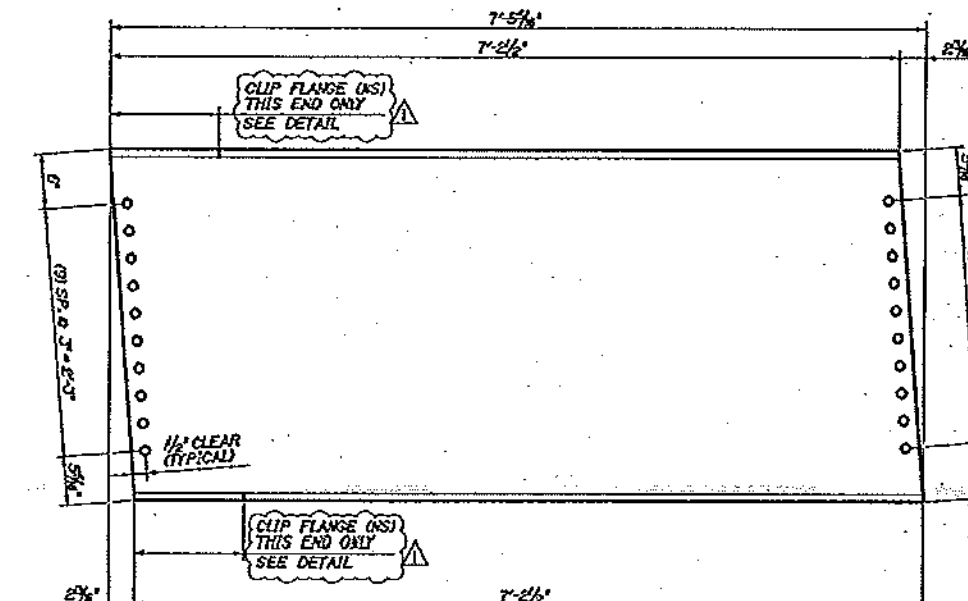

Vermont Agency of Transportation
RECEIVED
 CK'D BY GML OK'D BY JEL
 11:20 am, Mar 19, 2012
 RESUBMIT APPROVED X
 BY KMH DATE 3/19/2012

ARC
 ADVANCED RESOURCES & CONST. ENTERPRISES, INCORPORATED
 1000 W. BROAD ST. SUITE 100
 COLCHESTER, VT 05445
 PHONE: (802) 243-4444 FAX: (802) 243-4444

REVISIONS

NO.	DATE	DESCRIPTION	BY
1	03/19/12	CROSS FRAMES	JEL
2	03/19/12	CHANGE FROM W40x149 TO W40x149	JEL
3	03/19/12	FLANGE CLIP	JEL
4	03/19/12	FLANGE CLIP	JEL
5	03/19/12	FLANGE CLIP	JEL

PROJECT NO. 100110008
 SHEET NO. 100110008-01
 DATE 03/19/12
 T BUCK CONSTRUCTION



State of Vermont
PDD/Structures Design Section
National Life Building - Drawer 33
Montpelier, VT 05633-5001
www.aot.state.vt.us

Agency of Transportation

[phone] 802-828-2621
[fax] 802-828-3566
[tdd] 800-253-0191

April 28, 2012

J.P. Carrara & Sons, Inc
2464 Case St.
Middlebury, VT 05753

Project Name: East Haven Project #: BRF 0269(11)


Structure Identification: Bridge #18 over East Branch Passumpsic River

The Prestressed Concrete Box Beam fabrication drawings [Item 510.21 Prestressed Concrete Box Beams] for the above project (General Contractor - Austin Construction, Inc.) have been reviewed and are being returned herewith.

All sheets are approved. I have included section 10.11 from the PCI Manual as our inspector will be checking for conformance throughout the fabrication process.

You must provide notice to our fabrication inspector, Jim Wild, as to the date fabrication represented by these drawings will begin. Jim must receive and acknowledge your notice at least seven days prior to that date. You may contact Jim by phone at (802)828-6931 or email at jim.wild@state.vt.us. Any material fabricated prior to the notification date is subject to rejection without further cause.


Sincerely,

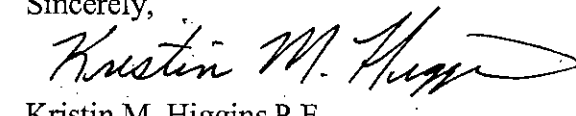
Kristin M. Higgins P.E.
Project Manager


Attachments

cc: [x] Resident Engineer - Doug Bumps w/prints
[x] Shop Inspector - Jim Wild w/prints
[x] Contractor - Austin Construction, Inc. w/prints
[x] Construction Division - letter only
[x] Materials & Research Section (C&IA Unit) - letter only
[x] Files (Structures & Central)




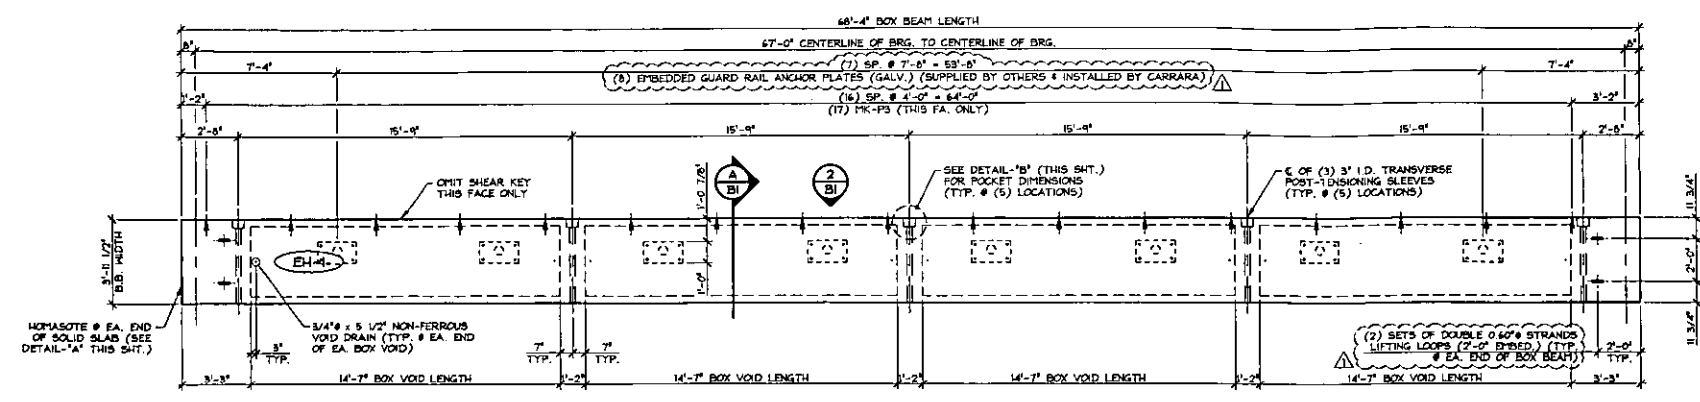


1 DIMENSIONAL PLAN VIEW IN FORM

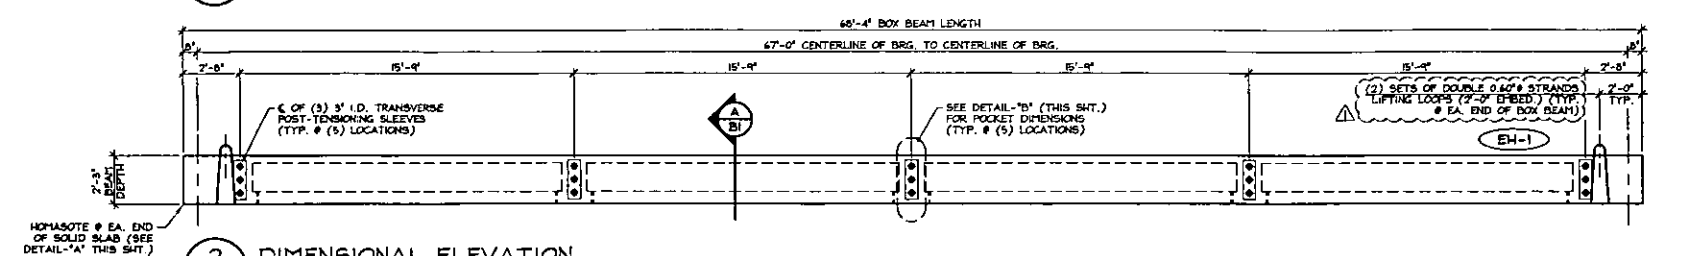


2 DIMENSIONAL ELEVATION

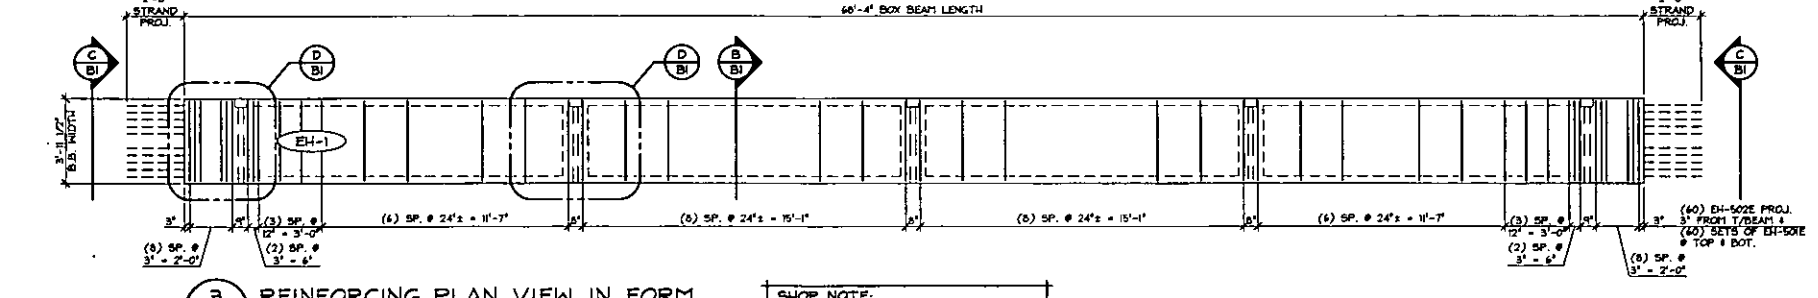


3 REINFORCING PLAN VIEW IN FORM

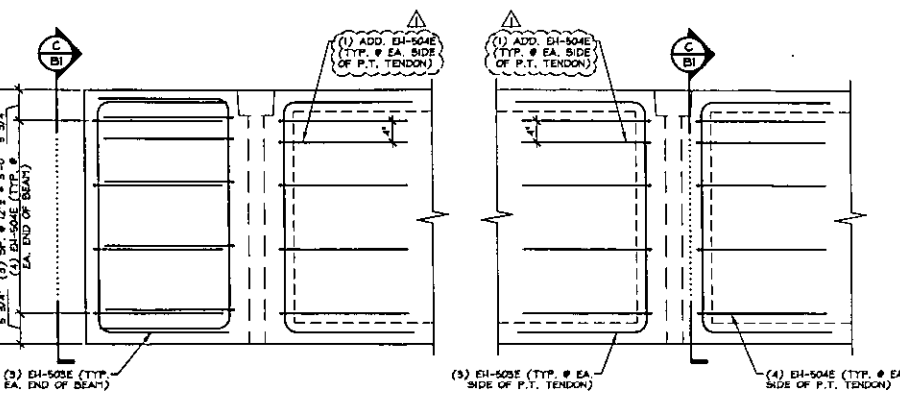

4 END DIAPHRAGM & INTERMEDIATE DIAPHRAGM REINF. PLAN

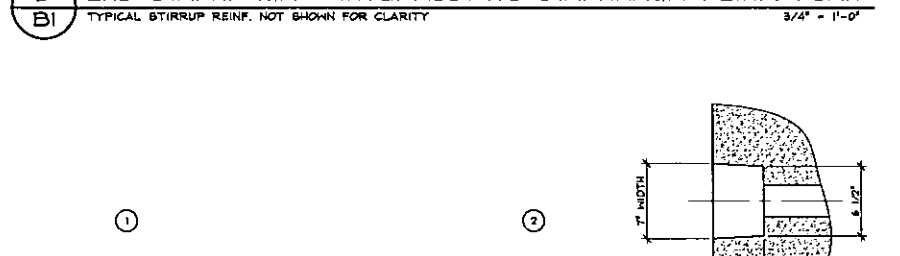


5 DETAILING SCHEDULE

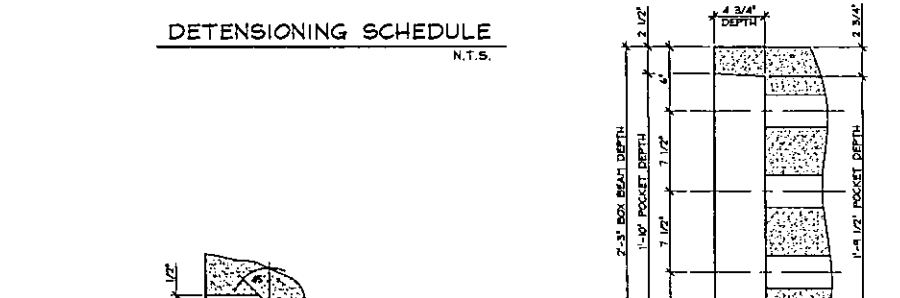


6 DETAIL - 'A'


7 DETAIL - 'B'

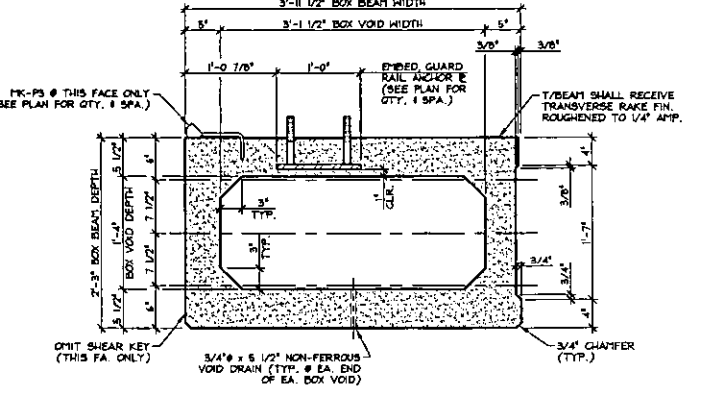

8 DIMENSIONAL SECTION

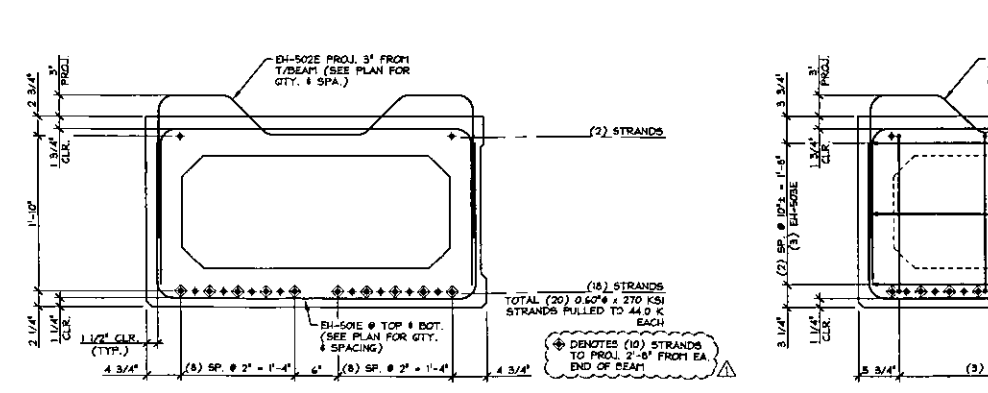


9 REINFORCING SECTION

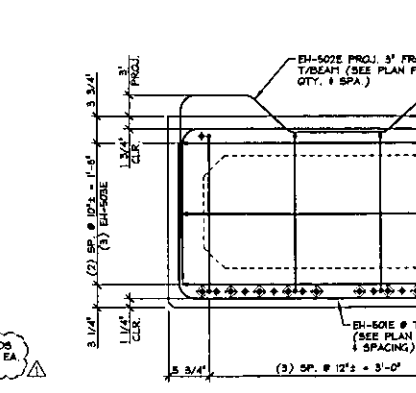


10 REINFORCING SECTION

ITEM	MARK	DESCRIPTION	QTY
1	1	PRESTRESSED CONCRETE BOX BEAM	1
2	2	REINFORCING BARS	100
3	3	STIRRUPS	50
4	4	END DIAPHRAGM REINFORCEMENT	1
5	5	INTERMEDIATE DIAPHRAGM REINFORCEMENT	1
6	6	ANCHOR PLATE	1
7	7	STIRRUPS	1
8	8	ANCHOR PLATE	1
9	9	STIRRUPS	1
10	10	ANCHOR PLATE	1


<p>Vermont Agency of Transportation</p> <p>RECEIVED</p> <p>CK'D BY: JAD OK'D BY: JTS</p> <p>10:19 am, Mar 05, 2012</p> <p>RESUBMIT BY: KMH APPROVED BY: ATE</p>	<p>STATE OF VERMONT</p> <p>AGENCY OF TRANSPORTATION</p>	<p>DRAWN: S. LORNE</p> <p>DESIGNED: _____</p> <p>CHECKED: _____</p> <p>APPROVED: _____</p>	<p>J.P. CARRARA & SONS INC.</p> <p>1000-Cone Point Rd. Ferris, VT 05752</p> <p>Phone: 802-888-1111 Fax: 802-888-1112</p>	<p>AUSTIN CONSTRUCTION</p> <p>CONCORD, VT</p>	<p>Project Name: TOWN OF EAST HAVEN, VT</p> <p>STATE ROUTE 114 - MAJOR COLLECTOR BRIDGE NO. 18</p> <p>PROJECT NO. BKF 024(1)</p> <p>PRESTRESSED BOX BEAM DETAILS</p>	<p>SCALE: 3/8" = 1'-0"</p> <p>NOTED: 2/24/12</p> <p>DATE: 2/24/12</p> <p>SHEET # 1</p>
---	---	--	---	---	--	--

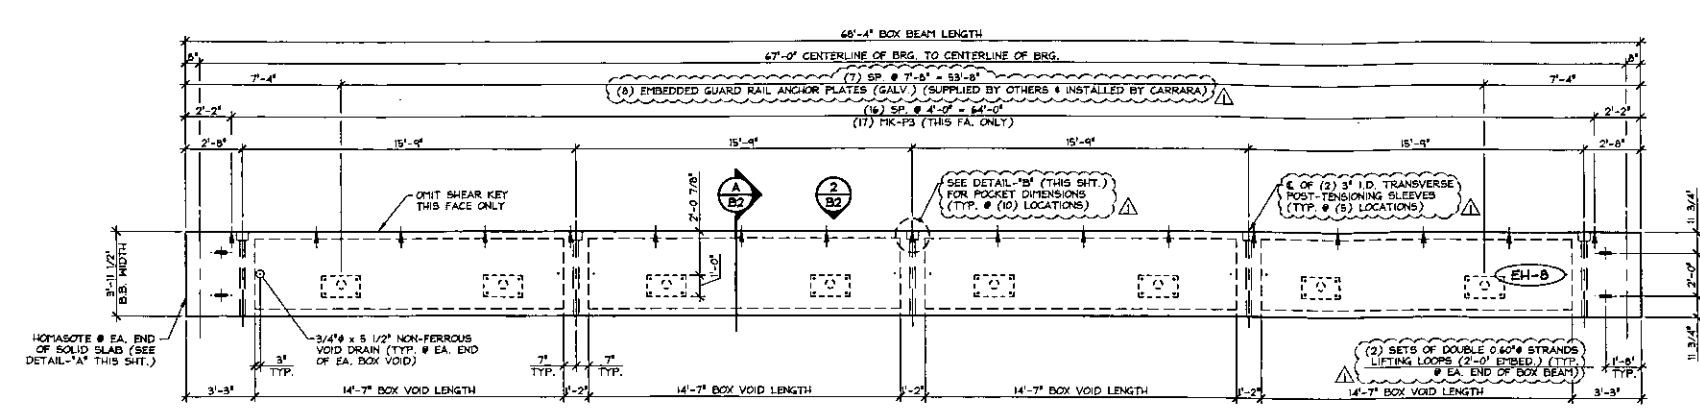


1 DIMENSIONAL PLAN VIEW IN FORM
1/4" = 1'-0"

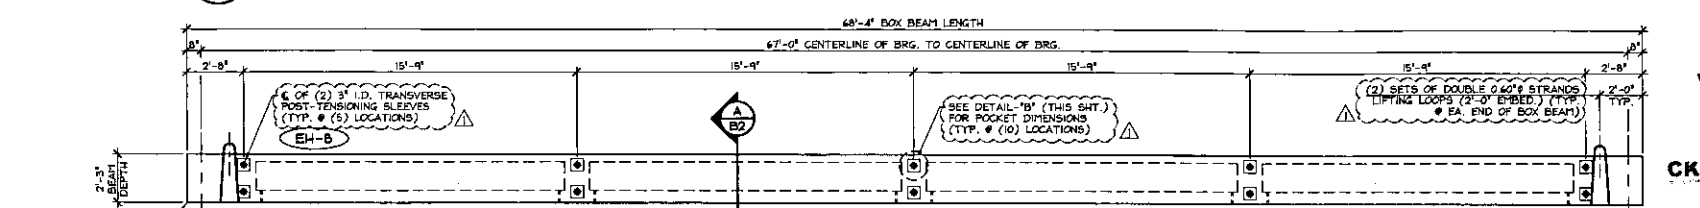


2 DIMENSIONAL ELEVATION
1/4" = 1'-0"

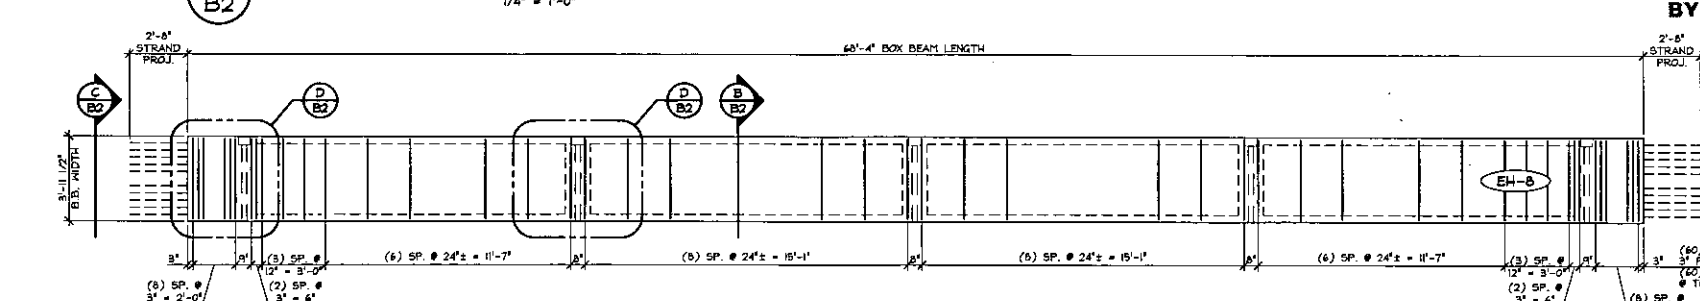


3 REINFORCING PLAN VIEW IN FORM
1/4" = 1'-0"

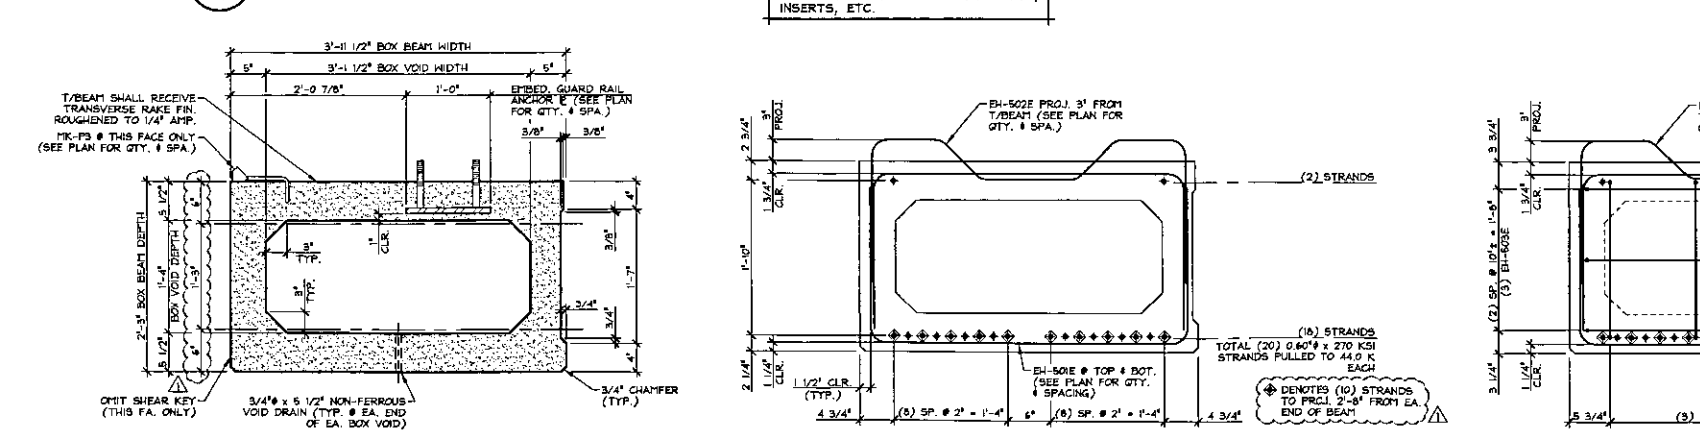


A DIMENSIONAL SECTION
1/4" = 1'-0"

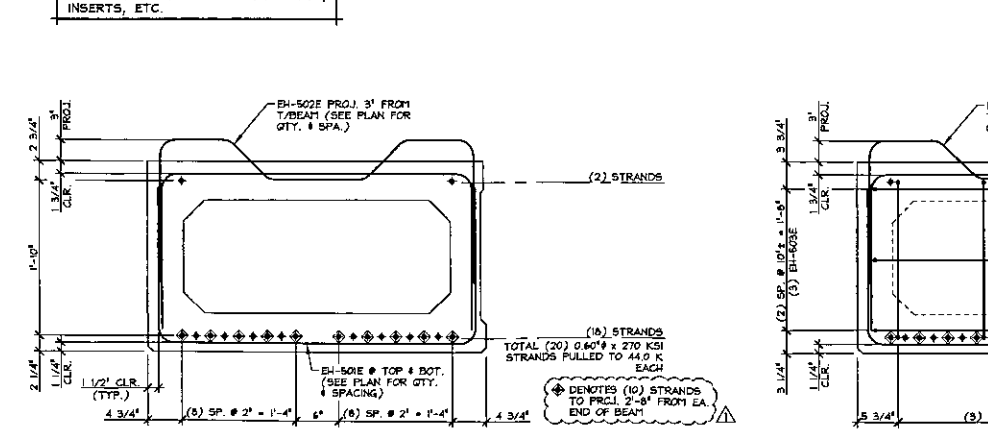

B REINFORCING SECTION
1/4" = 1'-0"

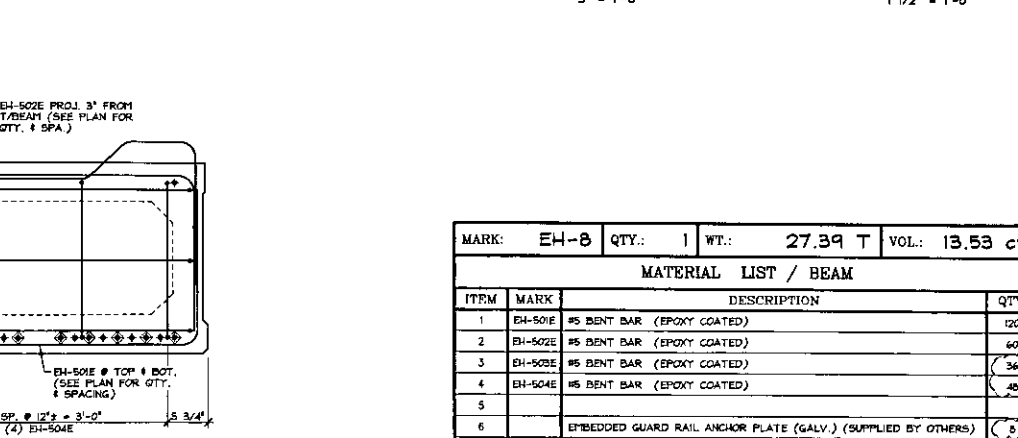

C REINFORCING SECTION
1/4" = 1'-0"

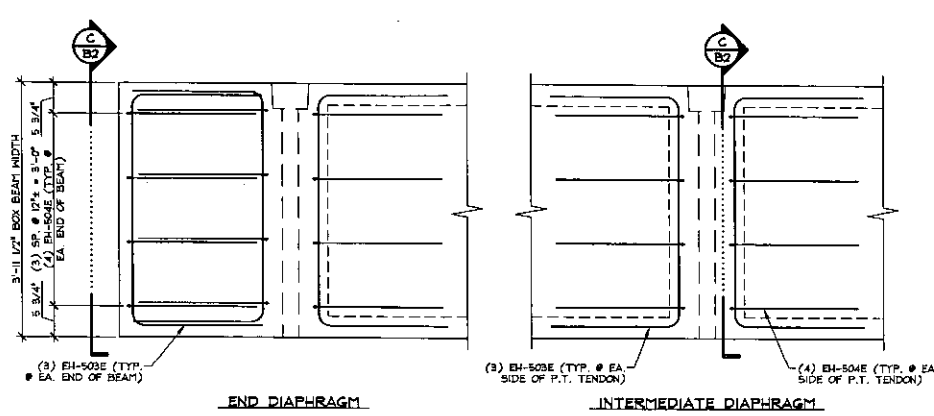


D END DIAPHRAGM & INTERMEDIATE DIAPHRAGM REINF. PLAN
TYPICAL STRAP REIN. NOT SHOWN FOR CLARITY
1/4" = 1'-0"

Vermont Agency of Transportation
RECEIVED
CK'D BY JAS OK'D BY JTS
10:19 am, Mar 05, 2012
RESUBMIT BY ATE APPROVED BY ATE 3-16-12

DETENSIONING SCHEDULE

1	100%
2	100%
3	100%
4	100%
5	100%
6	100%
7	100%
8	100%
9	100%
10	100%

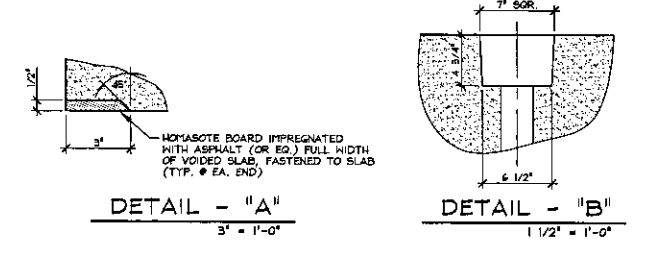


MARK: EN-B QTY: 1 WT: 27.39 T VOL: 13.53 cy

ITEM	MARK	DESCRIPTION	QTY
1	EN-B	PRESTRESSED BOX BEAM (CONCRETE)	1
2	EN-B	REINFORCING BAR (CONCRETE)	1
3	EN-B	REINFORCING BAR (CONCRETE)	1
4	EN-B	REINFORCING BAR (CONCRETE)	1
5	EN-B	REINFORCING BAR (CONCRETE)	1
6	EN-B	REINFORCING BAR (CONCRETE)	1
7	EN-B	REINFORCING BAR (CONCRETE)	1
8	EN-B	REINFORCING BAR (CONCRETE)	1
9	EN-B	REINFORCING BAR (CONCRETE)	1
10	EN-B	REINFORCING BAR (CONCRETE)	1


1/17/2012 10:19 AM

STATE OF VERMONT AGENCY OF TRANSPORTATION	DRAWN: S. LOPES	J.P. CARRARA & SONS INC.	Project Name: TOWN OF EAST HAVEN, VT	SCALE: 1/4" = 1'-0"
DESIGNED: _____	CHECKED: _____	AUSTIN CONSTRUCTION CONCORD, VT	TOWN OF EAST HAVEN, VT STATE ROUTE 104 - MAJOR COLLECTOR BRIDGE NO. 19 PROJECT NO. BRP 024(11)	NOTED: 2/24/12
APPROVED: _____	DATE: 1-22-11	Double-Flow Holes-Cone Pipe 1/2" Round	PRESTRESSED BOX BEAM DETAILS	SHEET # B2

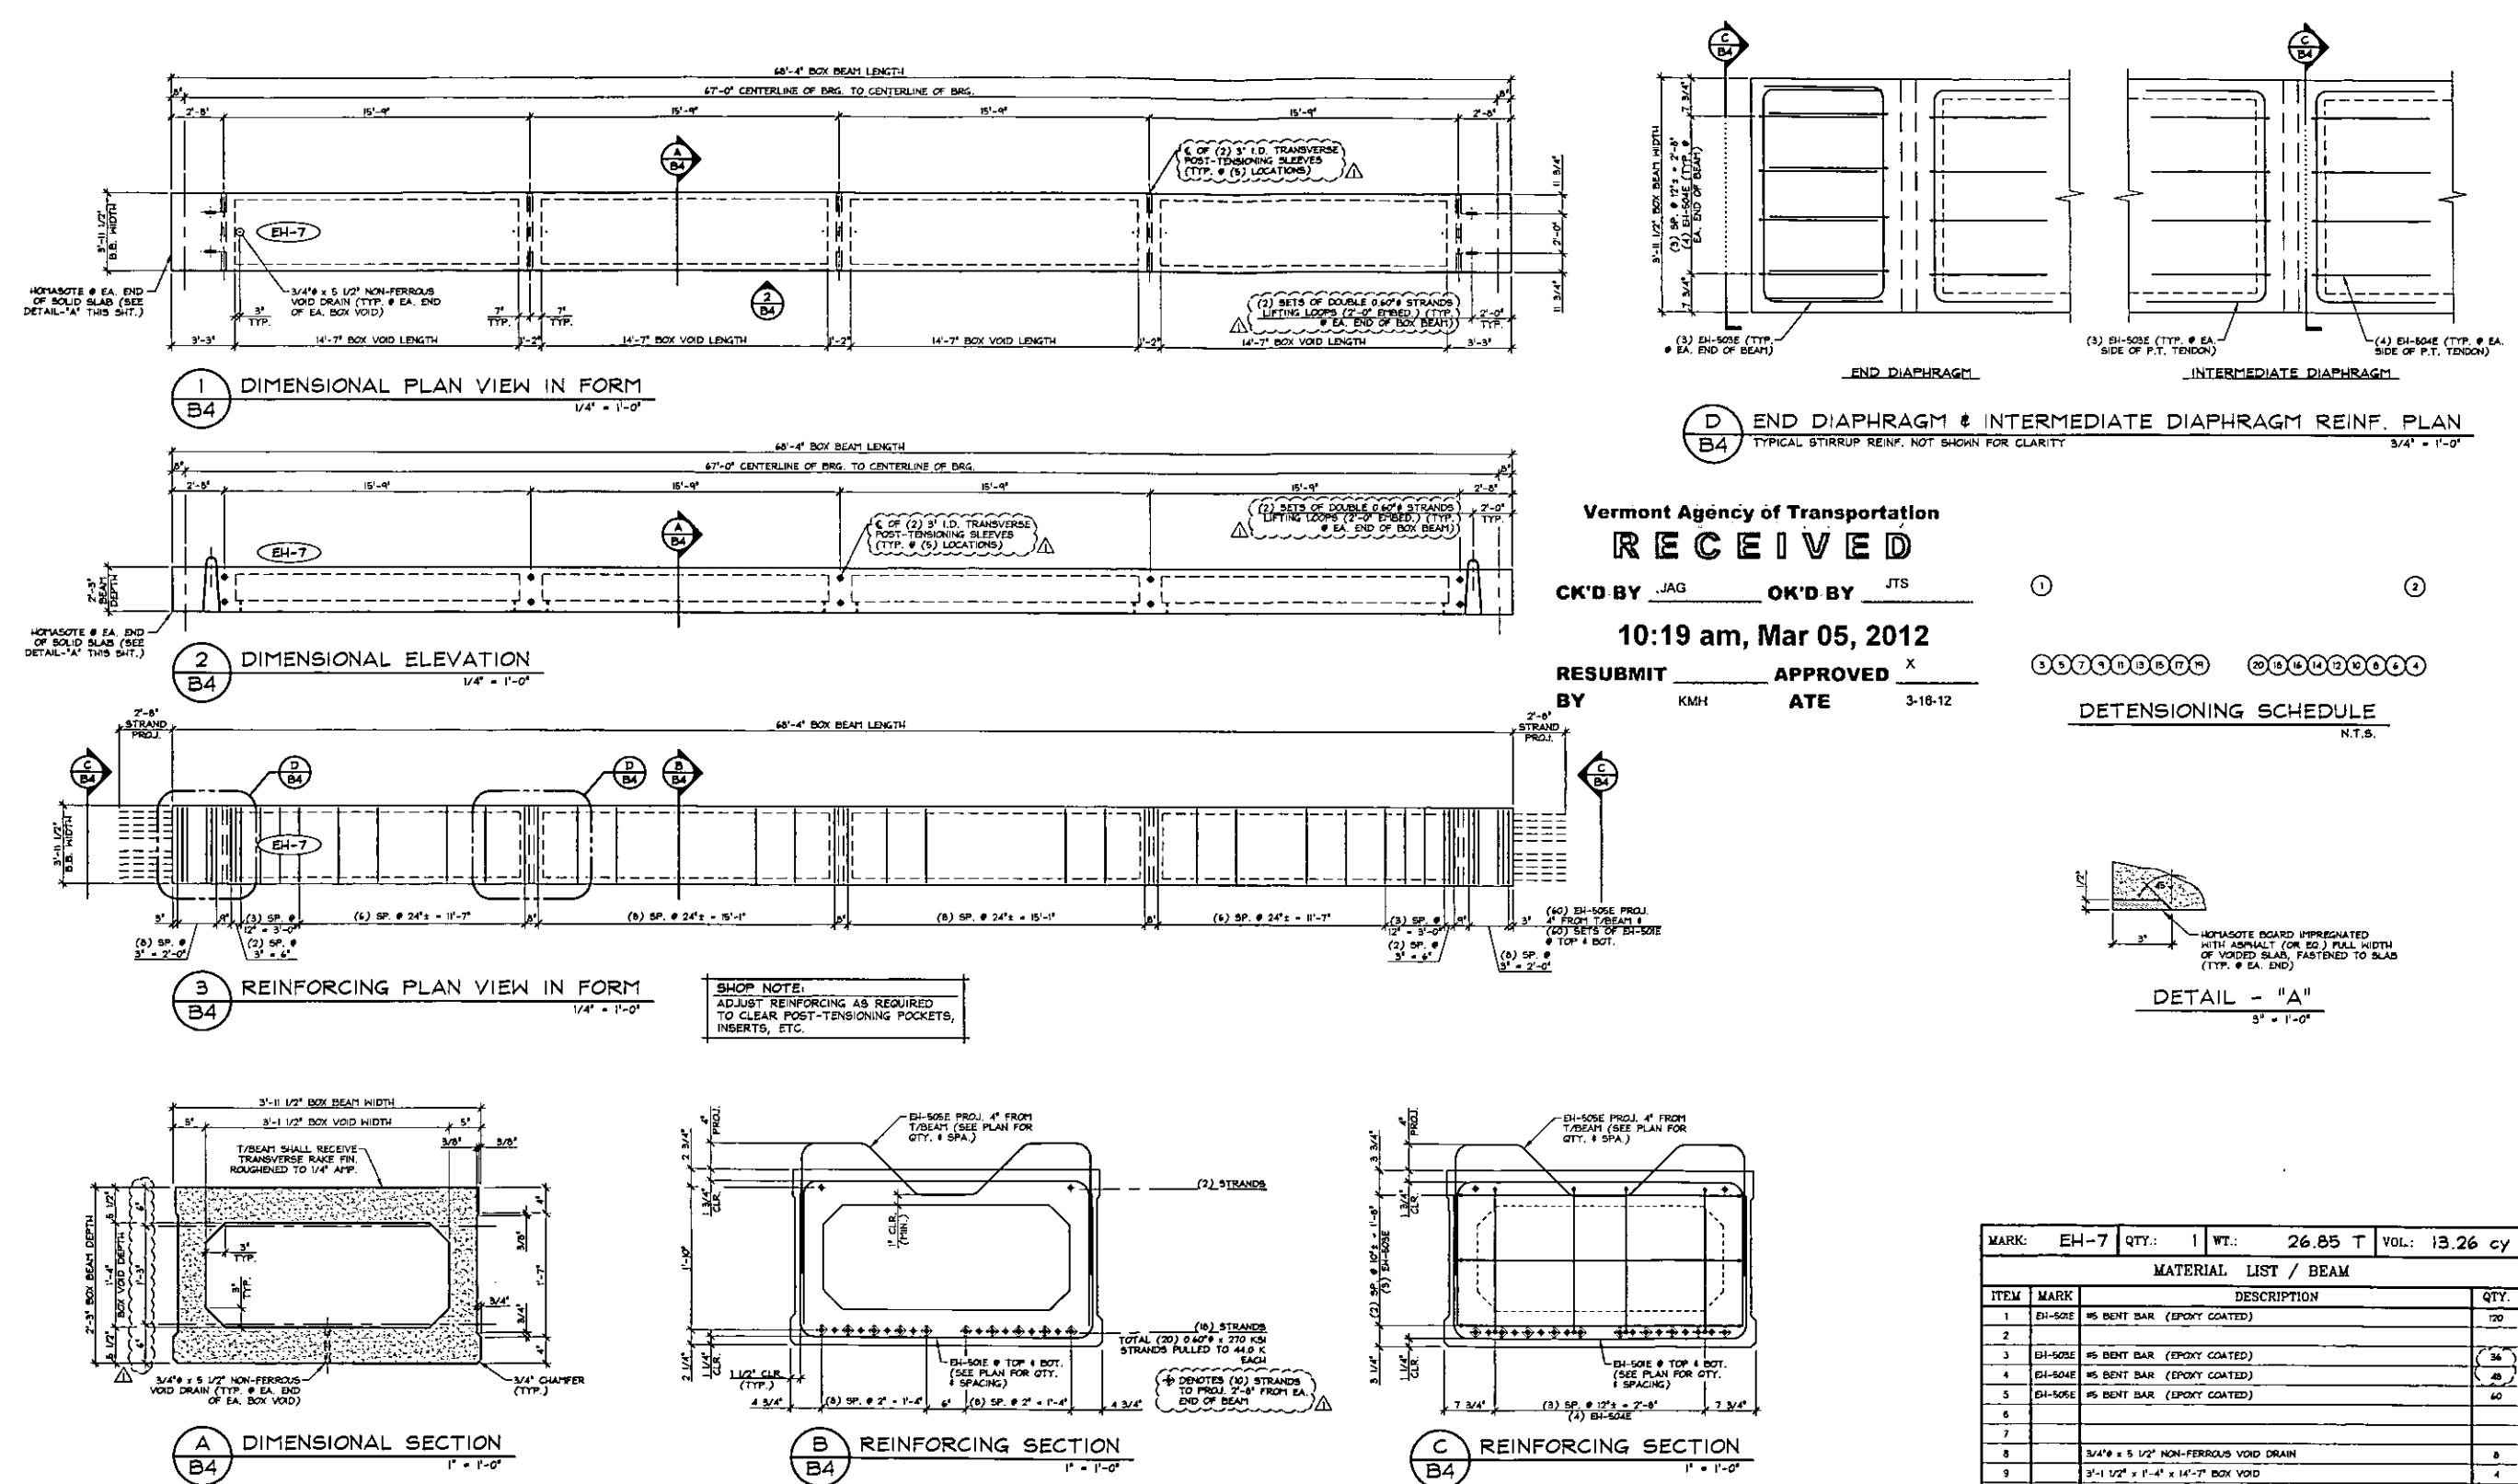

Vermont Agency of Transportation
RECEIVED
 CK'D BY JAG OK'D BY JTS
 10:19 am, Mar 05, 2012
 RESUBMIT APPROVED X
 BY KMH ATE 3-16-12
 DETENSING SCHEDULE
 M.T.A.

MARK	EN-7	QTY	WT.	26.85 T	VOL.	13.26 cy
1	END DIAPHRAGM	1				
2	INTERMEDIATE DIAPHRAGM	1				
3	END DIAPHRAGM	1				
4	INTERMEDIATE DIAPHRAGM	1				
5	END DIAPHRAGM	1				
6	INTERMEDIATE DIAPHRAGM	1				
7	END DIAPHRAGM	1				
8	INTERMEDIATE DIAPHRAGM	1				
9	END DIAPHRAGM	1				
10	INTERMEDIATE DIAPHRAGM	1				

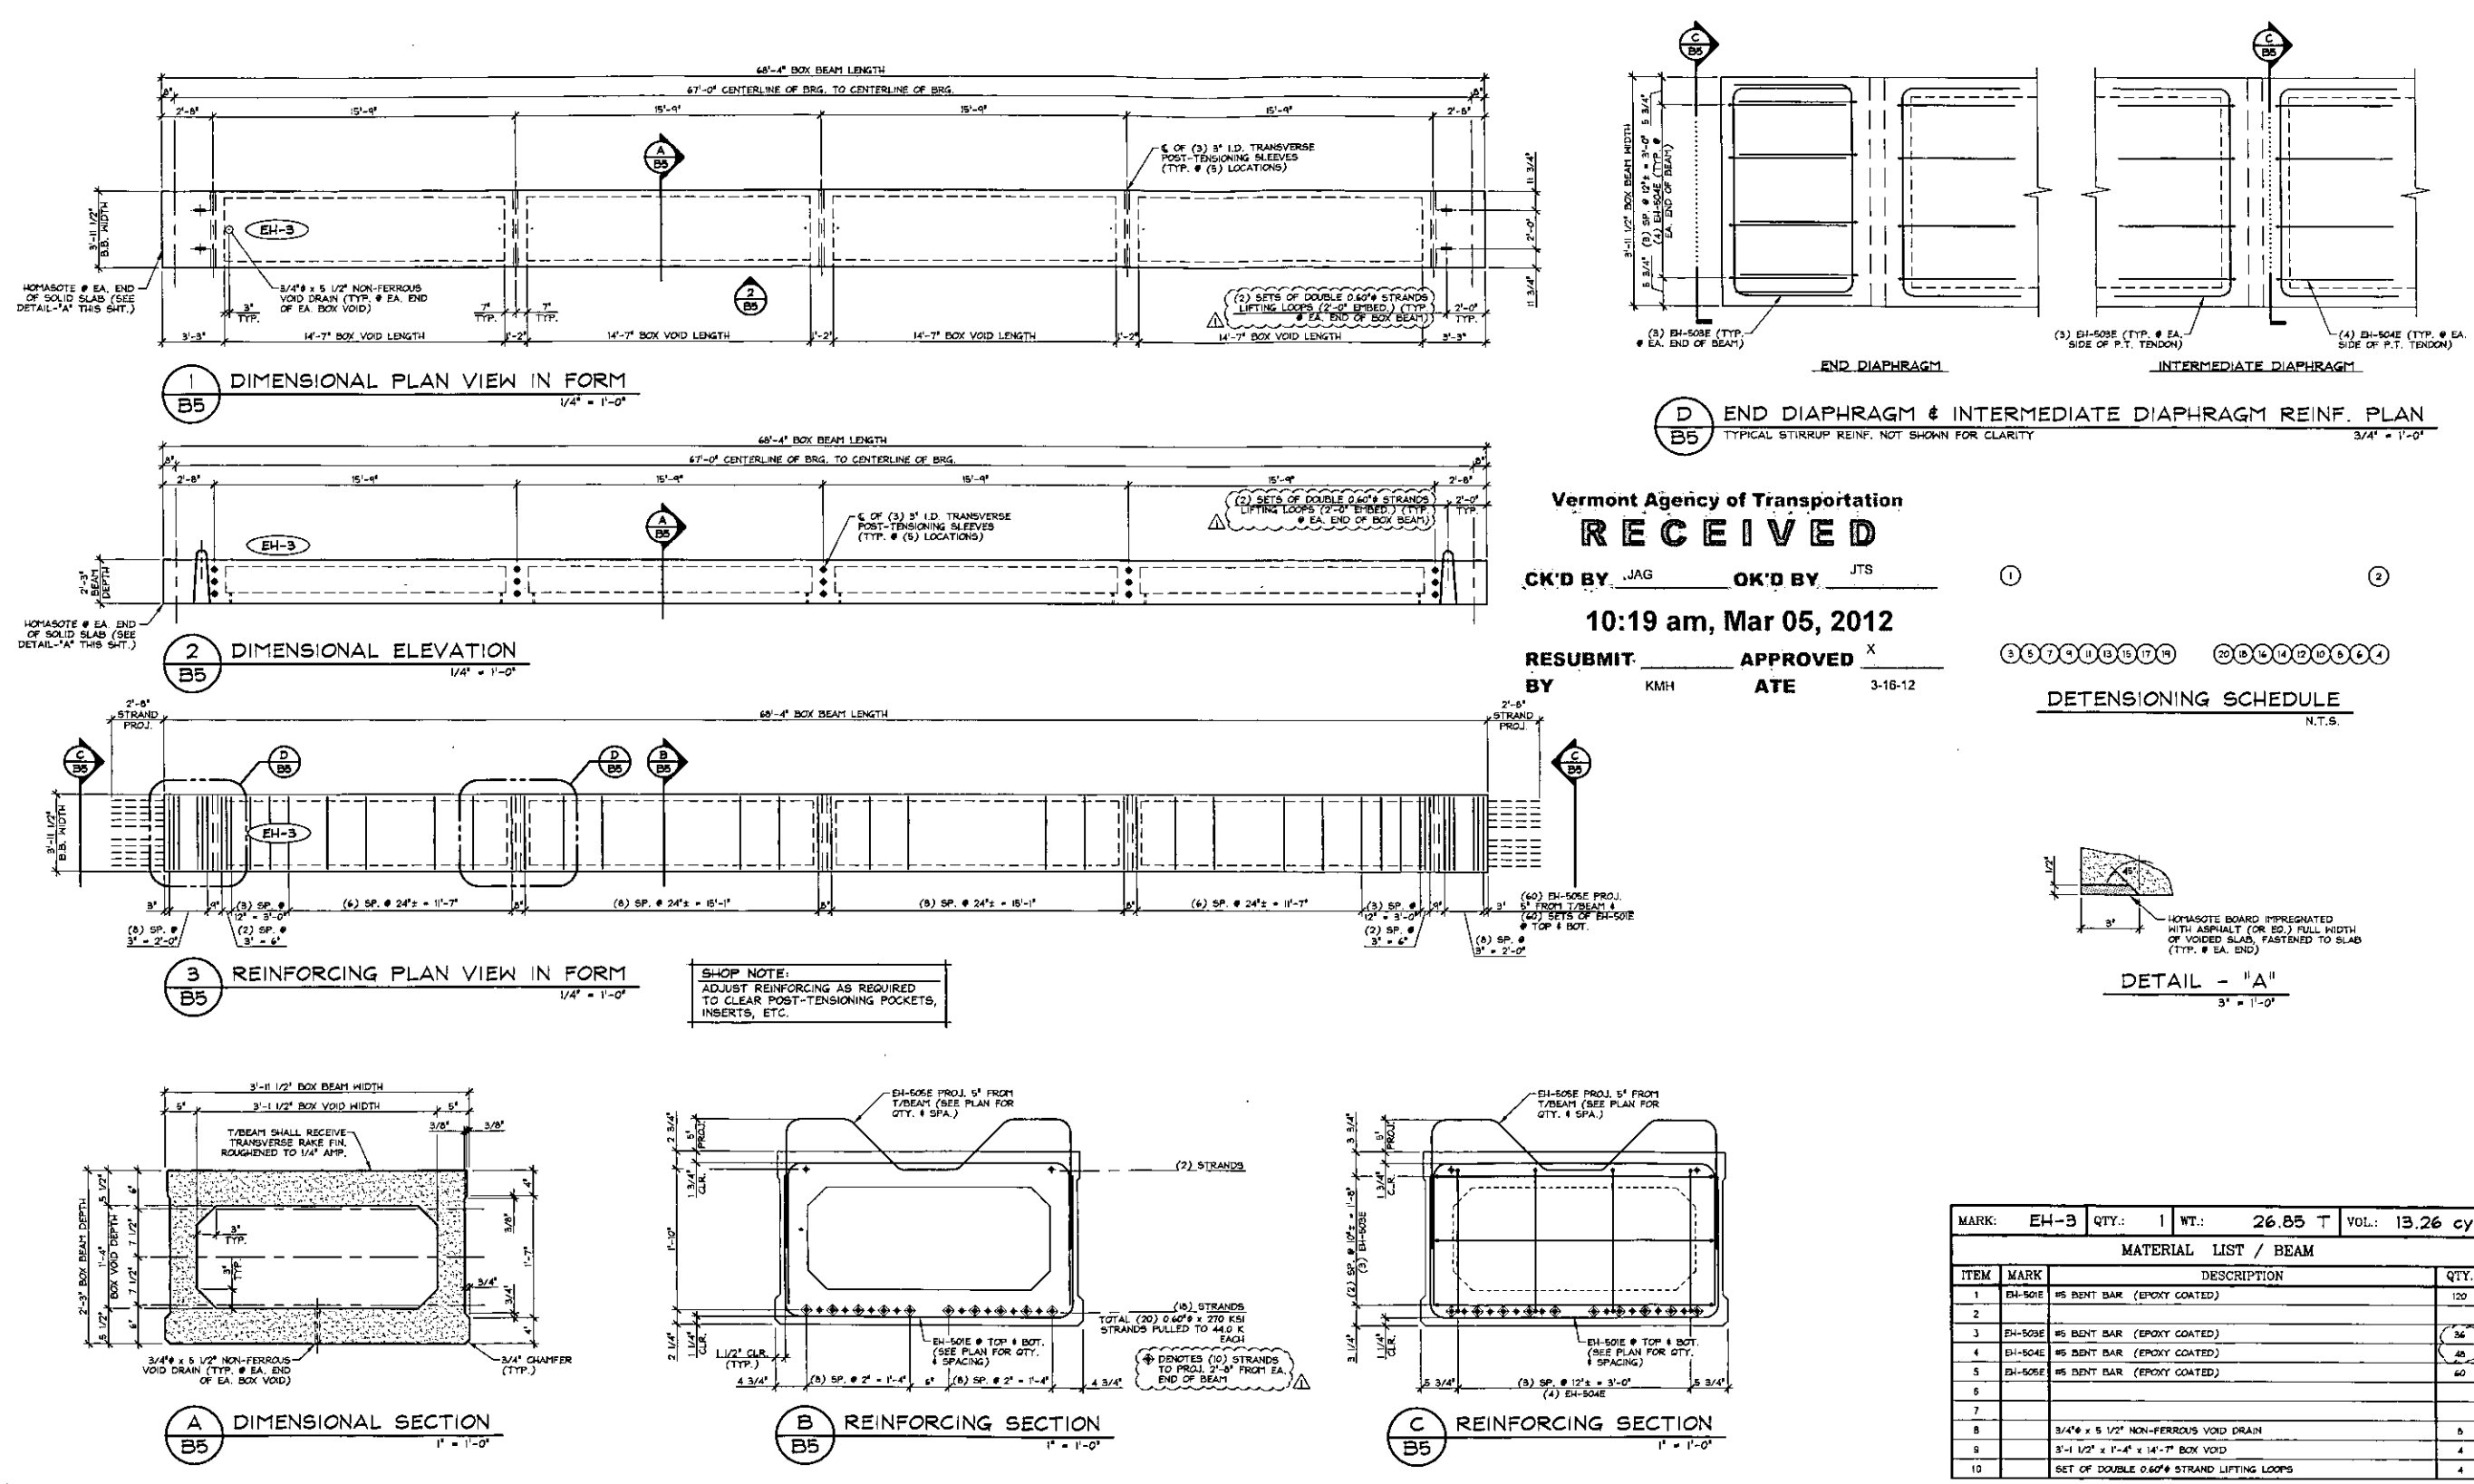


Vermont Agency of Transportation
RECEIVED
 CK'D BY JMS OK'D BY JTB
 10:19 am, Mar 05, 2012
 RESUBMIT APPROVED
 BY KBE ATE 3-16-12

MARK: E4-B QTY: 1 WT: 26.55 T VOL: 19.26 cy

ITEM	MARK	DESCRIPTION	QTY
1	E4-B	PRESTRESSED BOX BEAM (CONCRETE)	1
2	E4-B	REINFORCING BARS (CONCRETE)	1
3	E4-B	REINFORCING BARS (CONCRETE)	1
4	E4-B	REINFORCING BARS (CONCRETE)	1
5	E4-B	REINFORCING BARS (CONCRETE)	1
6	E4-B	REINFORCING BARS (CONCRETE)	1
7	E4-B	REINFORCING BARS (CONCRETE)	1
8	E4-B	REINFORCING BARS (CONCRETE)	1
9	E4-B	REINFORCING BARS (CONCRETE)	1
10	E4-B	REINFORCING BARS (CONCRETE)	1
11	E4-B	REINFORCING BARS (CONCRETE)	1

11/15/2010 11:51 AM Vermont Agency of Transportation 10:19 AM 3/5/12

STATE OF VERMONT AGENCY OF TRANSPORTATION	DRAWN BY: [] DESIGNED BY: [] CHECKED BY: [] APPROVED BY: []	J.P. CARRARA & SONS INC. 1000 W. Rte. 100, Vergennes, VT 05491 (802) 244-1111	PROJECT NAME: TOWN OF EAST HAVEN, VT STATE ROUTE 14 - MAJOR COLLECTOR BRIDGE NO. 18 PROJECT NO. BRF 028R(1) PRESTRESSED BOX BEAM DETAILS	SCALE: 1"=1'-0" JOB #: NOTED: 23849-01 DATE: 1-20-11 SHEET #: B5
--	--	--	--	--

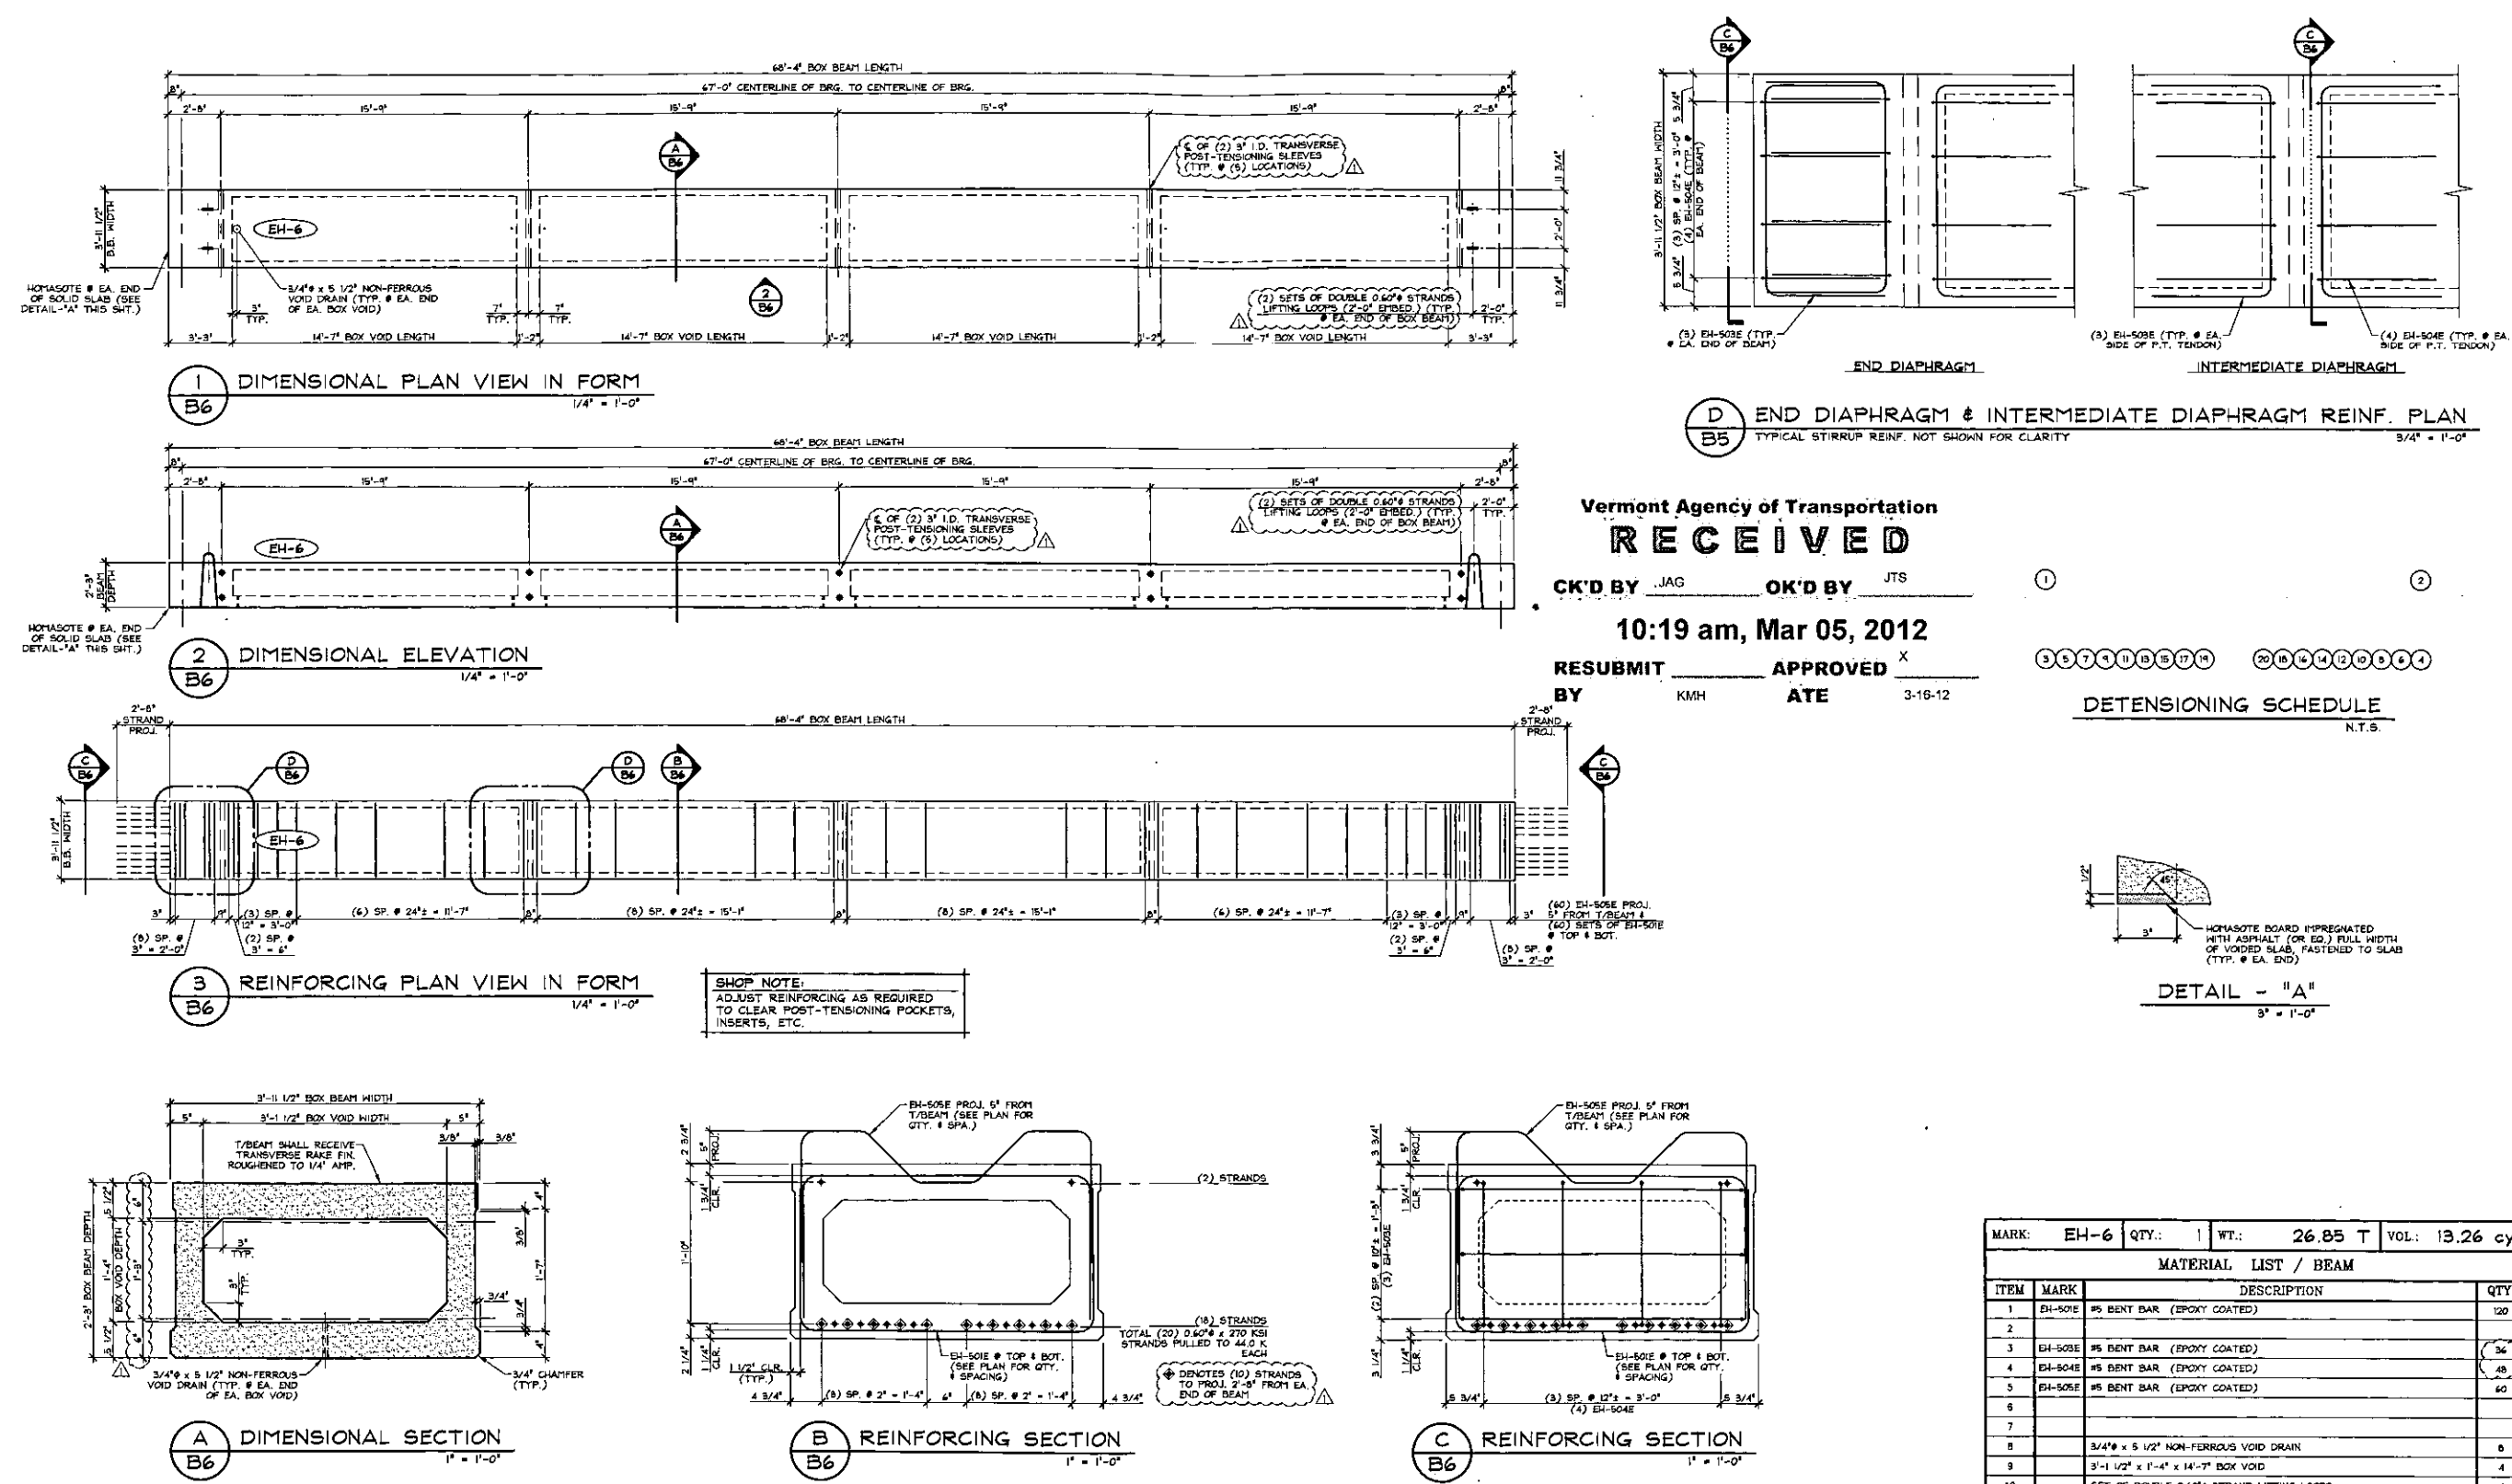

Vermont Agency of Transportation
RECEIVED
 CK'D BY JAG OK'D BY JTS
 10:19 am, Mar 05, 2012
 RESUBMIT APPROVED
 BY ATE 3-16-12

DETERMINING SCHEDULE


MARK	QTY.	WT.	VOL.
EA4-6	1	26.85 T	13.26 cy

MATERIAL LIST / BEAM

ITEM	MARK	DESCRIPTION	QTY.
1	EA4-6	PRESTRESSED CONCRETE BOX BEAM (CONCRETE)	1
2	EA4-6	REINFORCING BAR (CONCRETE)	26.85 T
3	EA4-6	REINFORCING BAR (CONCRETE)	13.26 cy
4	EA4-6	REINFORCING BAR (CONCRETE)	26.85 T
5	EA4-6	REINFORCING BAR (CONCRETE)	13.26 cy
6	EA4-6	REINFORCING BAR (CONCRETE)	26.85 T
7	EA4-6	REINFORCING BAR (CONCRETE)	13.26 cy
8	EA4-6	REINFORCING BAR (CONCRETE)	26.85 T
9	EA4-6	REINFORCING BAR (CONCRETE)	13.26 cy
10	EA4-6	REINFORCING BAR (CONCRETE)	26.85 T

STATE OF VERMONT AGENCY OF TRANSPORTATION	DRWING: B. LOPER	J.P. CARRARA & SONS INC. Professional Engineer 1000 North Main Street Concord, VT 05732	Project Name: TOWN OF EAST HAVEN, VT STATE ROUTE 114 - MAJOR COLLECTOR BRIDGE NO. 10 PROJECT NO. BRP 024(1)	SCALE: NOTED 2004-01	JOB #
DESIGNED: B.L.	CHECKED: B.L.	AUSTIN CONSTRUCTION CONCORD, VT	DATE: 1-20-11	SHEET #	B6
REVISIONS: 1. REVISED FOR ENGINEER COMMENTS B.L.	APPROVED: B.L.				

1/17/2004 11:58 AM REVISED FOR ENGINEER COMMENTS B.L.

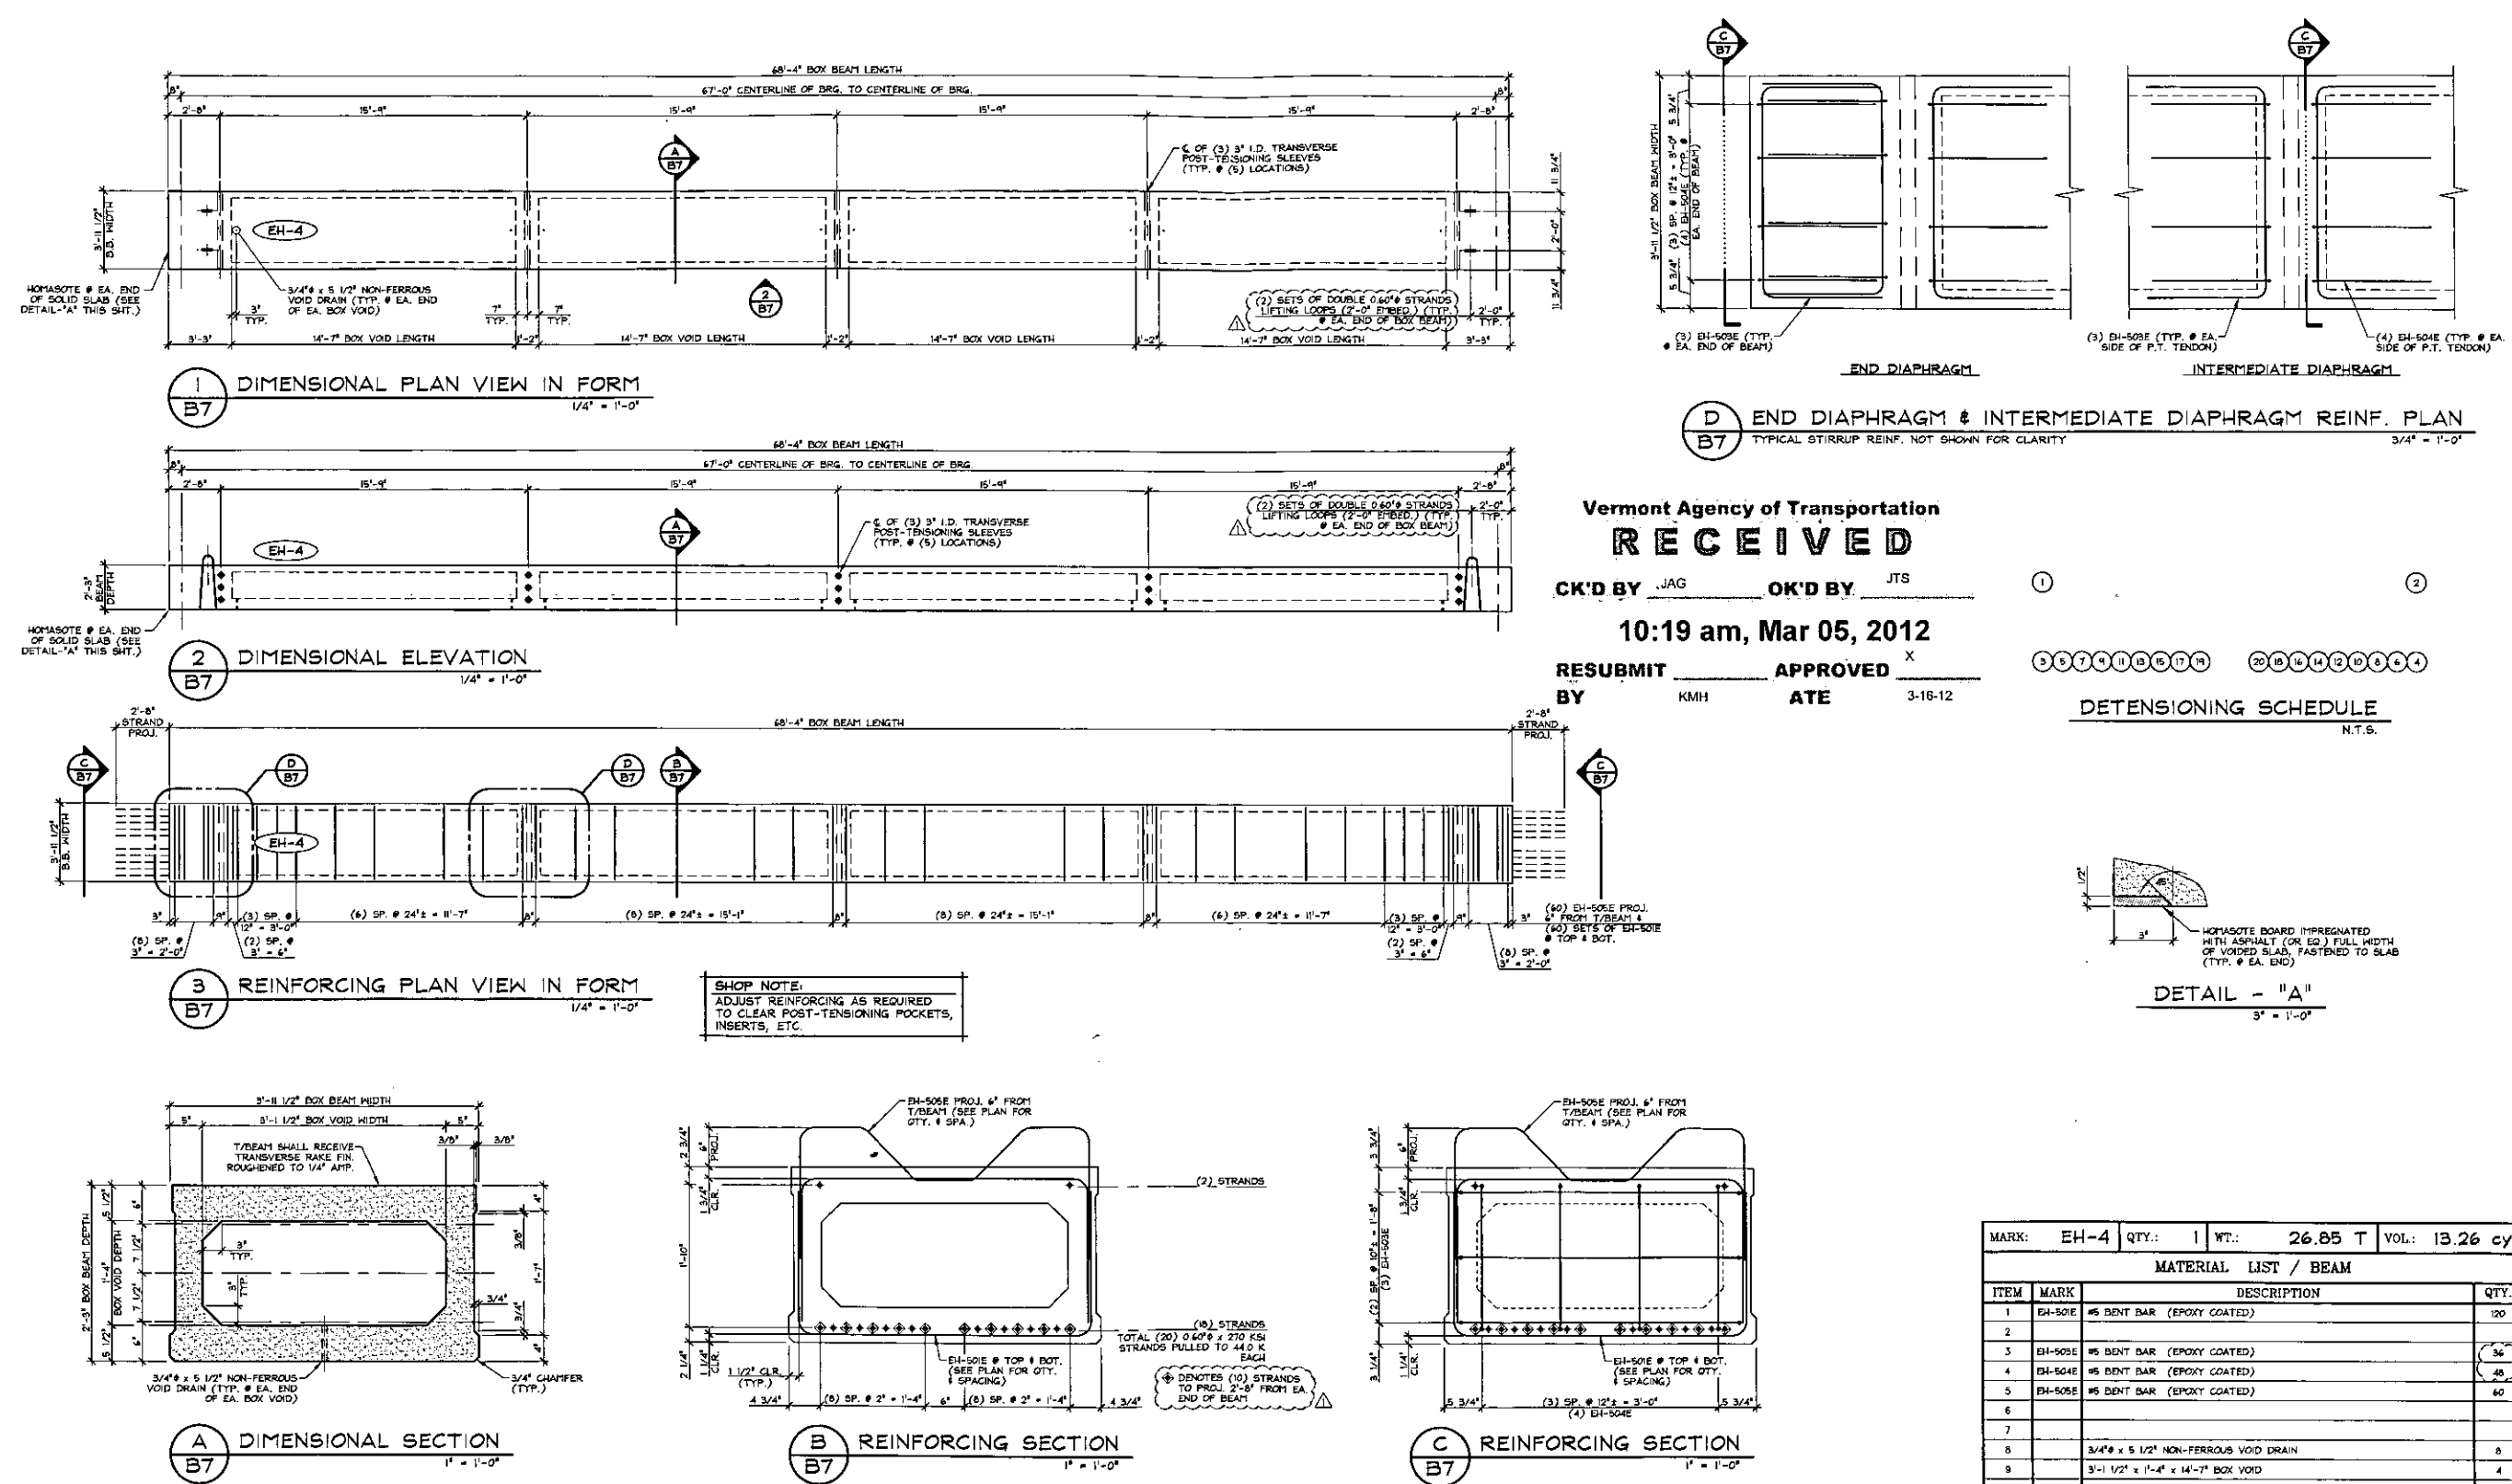

Vermont Agency of Transportation
RECEIVED
 CK'D BY JAG OK'D BY JTS
 10:19 am, Mar 05, 2012
 RESUBMIT BY NRM1 APPROVED BY ATE 3-16-12

DETONISING SCHEDULE

1	2	3	4	5	6	7	8	9	10
---	---	---	---	---	---	---	---	---	----

MARK: BH-4 QTY: 1 WT: 26.85 T VOL: 19.26 cy

ITEM	MARK	DESCRIPTION	QTY
1	BH-4	#4 TOP BAR (CONCRETE)	1
2	BH-4	#4 BOTTOM BAR (CONCRETE)	1
3	BH-4	#4 TOP BAR (CONCRETE)	1
4	BH-4	#4 BOTTOM BAR (CONCRETE)	1
5	BH-4	#4 TOP BAR (CONCRETE)	1
6	BH-4	#4 BOTTOM BAR (CONCRETE)	1
7	BH-4	#4 TOP BAR (CONCRETE)	1
8	BH-4	#4 BOTTOM BAR (CONCRETE)	1
9	BH-4	#4 TOP BAR (CONCRETE)	1
10	BH-4	#4 BOTTOM BAR (CONCRETE)	1

