


TEMPORARY EROSION MATTING
 STA 95+50.00 - 96+96.83 RT
 STA 97+79.17 - 99+20.00 RT

**GEOTEXTILE FOR SILT FENCE,
 WOVEN WIRE REINFORCED**
 STA 95+50.00 - 95+97.19 LT
 STA 95+50.00 - 97+00.00 RT
 STA 96+06.62 - 96+90.00 LT
 STA 97+65.00 - 99+20.00 LT/RT

BARRIER FENCE
 STA 95+50.00 - 95+97.19 LT
 STA 96+06.62 - 96+90.00 LT


PROJECT DEMARCATION FENCE
 STA 95+50.00 - 97+05.00 RT
 STA 97+65.00 - 99+20.00 LT/RT

TEMPORARY STONE CHECK DAM, TYPE I
 STA 98+25.00 - 99+25.00 RT

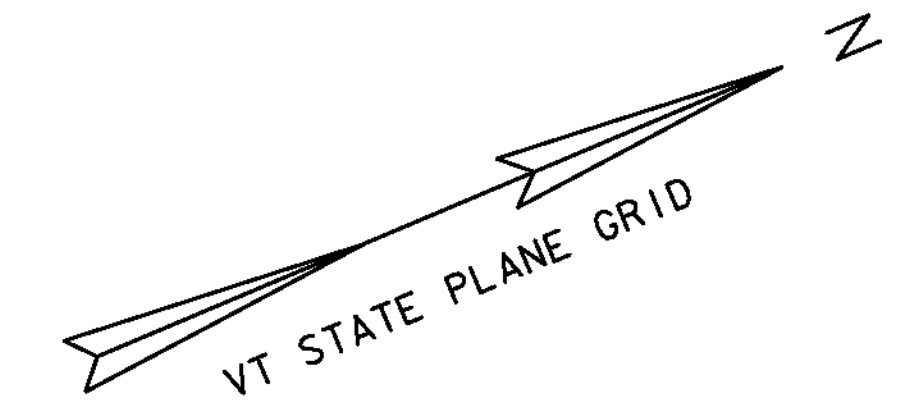

**11B
 SHEEPSKOT GRAVELLY
 FINE SANDY LOAM
 3-8% SLOPES
 K FACTOR = 0.10**

**12A
 MOOSILAUKE VERY
 FINE SANDY LOAM
 0-3% SLOPES
 K FACTOR = 0.24**

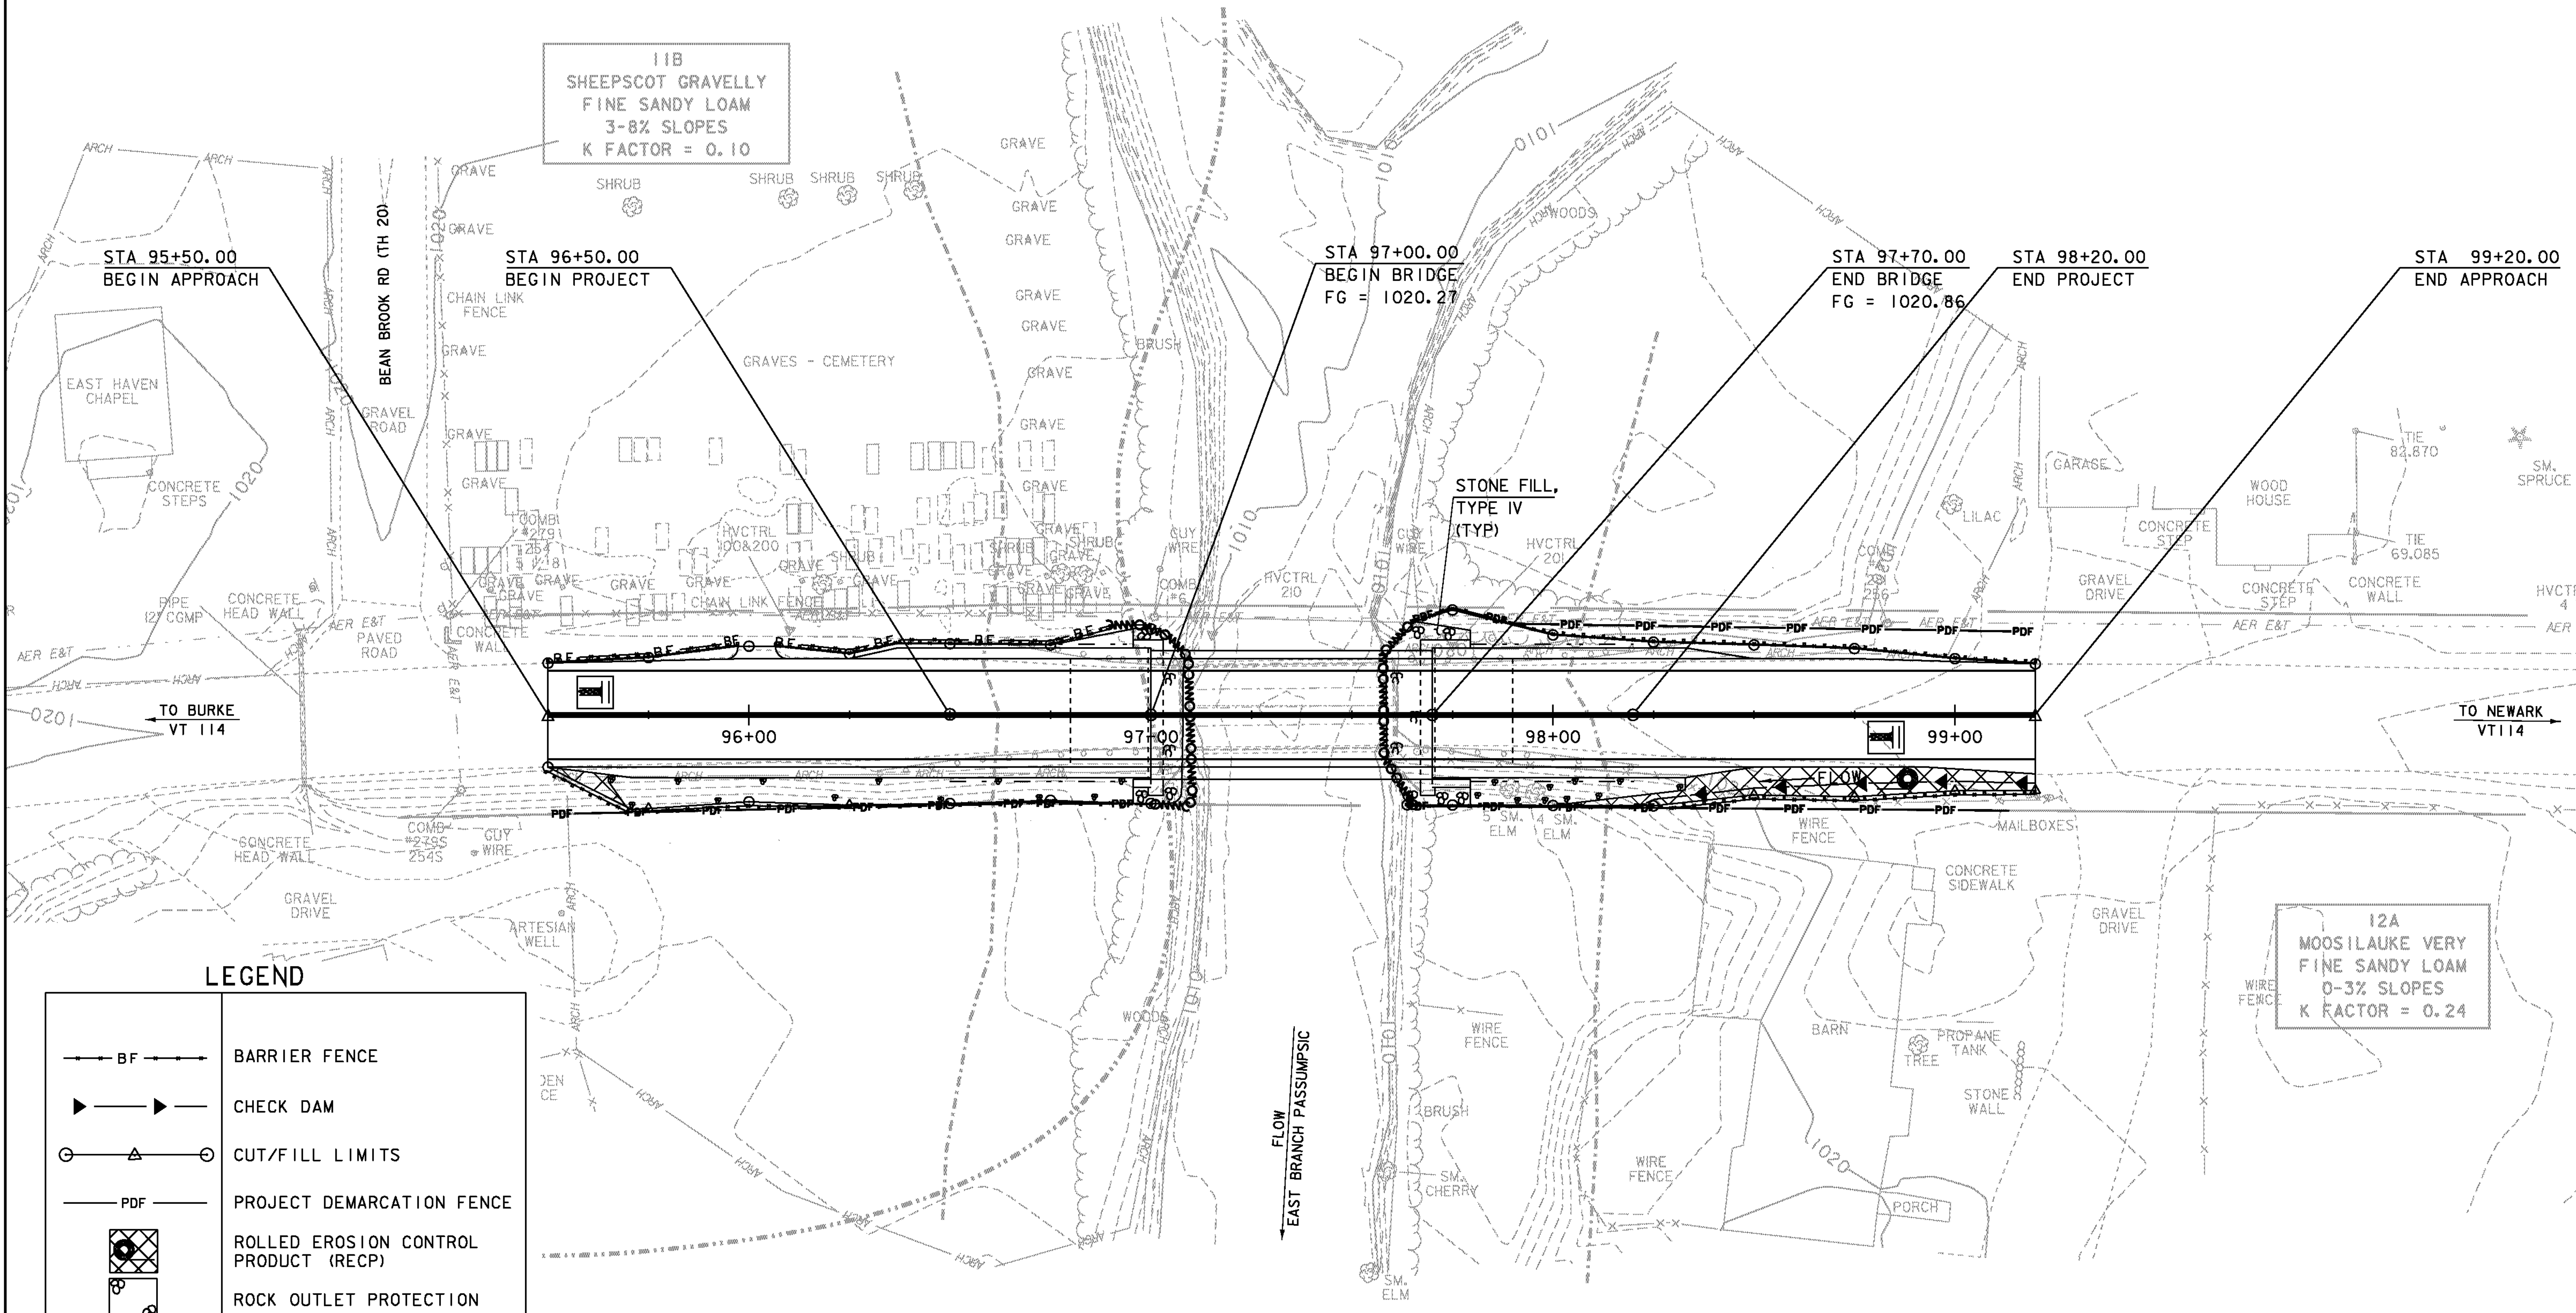

LEGEND

	BARRIER FENCE
	CHECK DAM
	CUT/FILL LIMITS
	PROJECT DEMARCATION FENCE
	ROLLED EROSION CONTROL PRODUCT (RECP)
	ROCK OUTLET PROTECTION
	SILT FENCE, WIRE WOVEN REINFORCED
	STABILIZED CONSTRUCTION ENTRANCE
	TURBIDITY CURTAIN

EPSC CONSTRUCTION SITE PLAN

SCALE 1" = 20' - 0"
 20 0 20

PROJECT NAME: EAST HAVEN	PLOT DATE: 08-AUG-2011
PROJECT NUMBER: BRF 0269(II)	DRAWN BY: R. PELLET
FILE NAME: s00cl62erobdr.dgn	CHECKED BY: J. LACROIX
PROJECT LEADER: K. HIGGINS	SHEET 31 OF 40
DESIGNED BY: J. LACROIX	
EPSC CONSTRUCTION SITE PLAN	