



SEE NOTE SHEET II

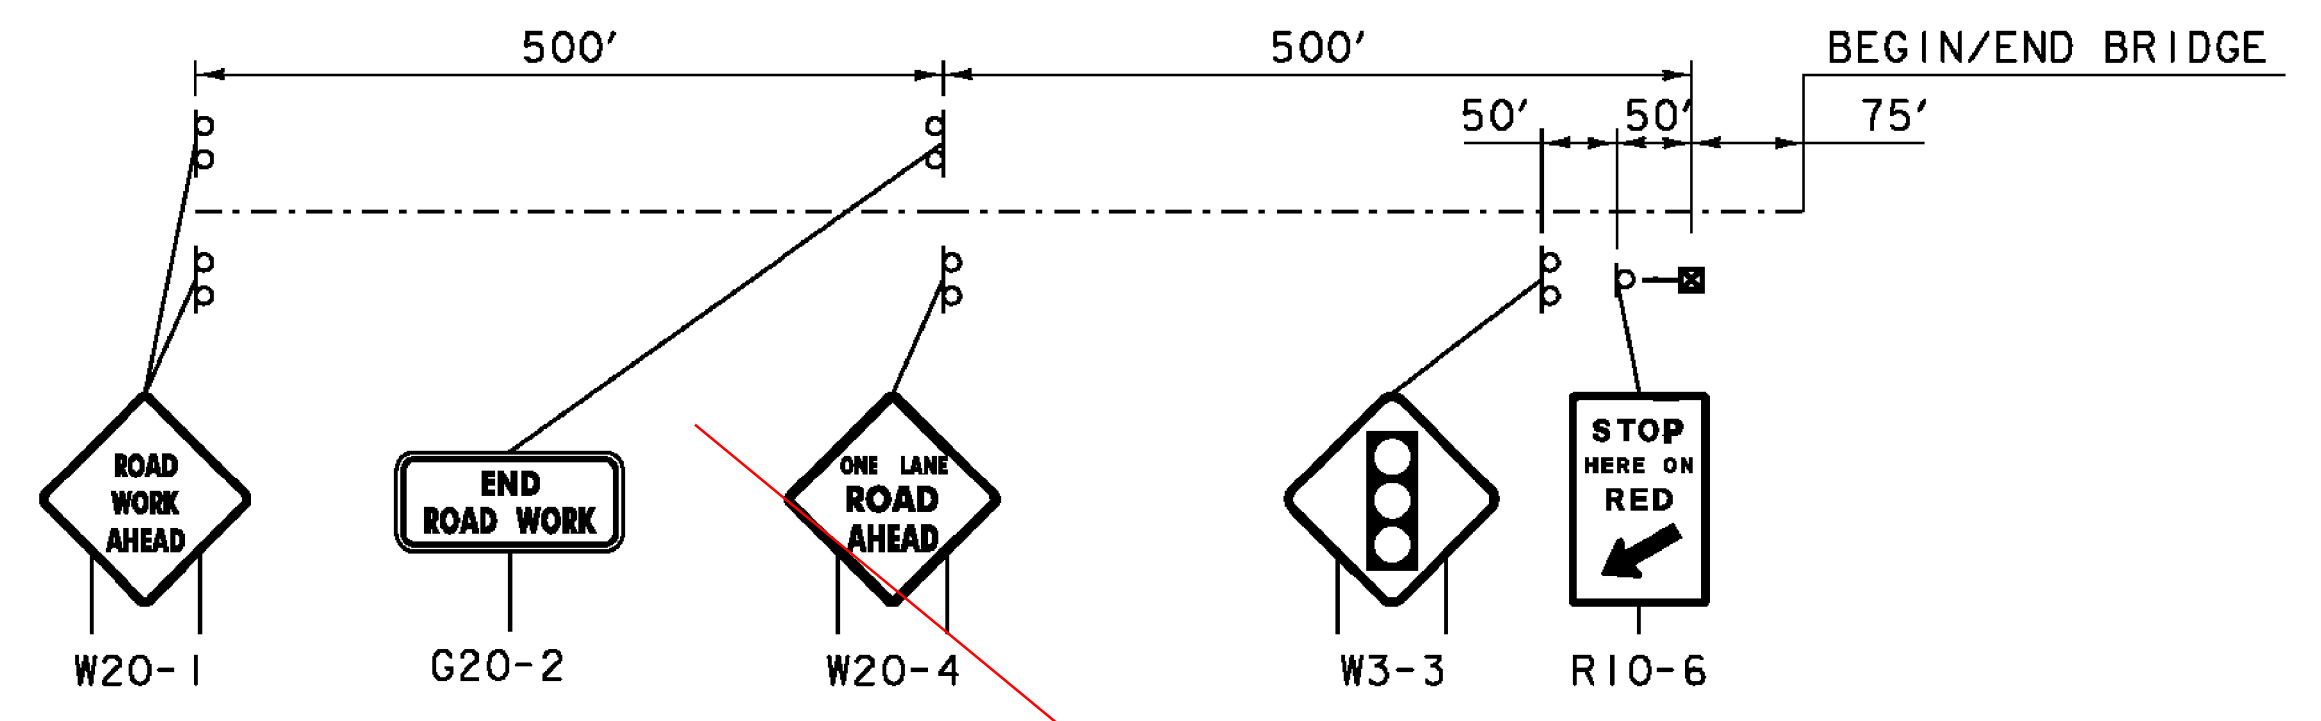

APPROACH SIGNS
NOT TO SCALE

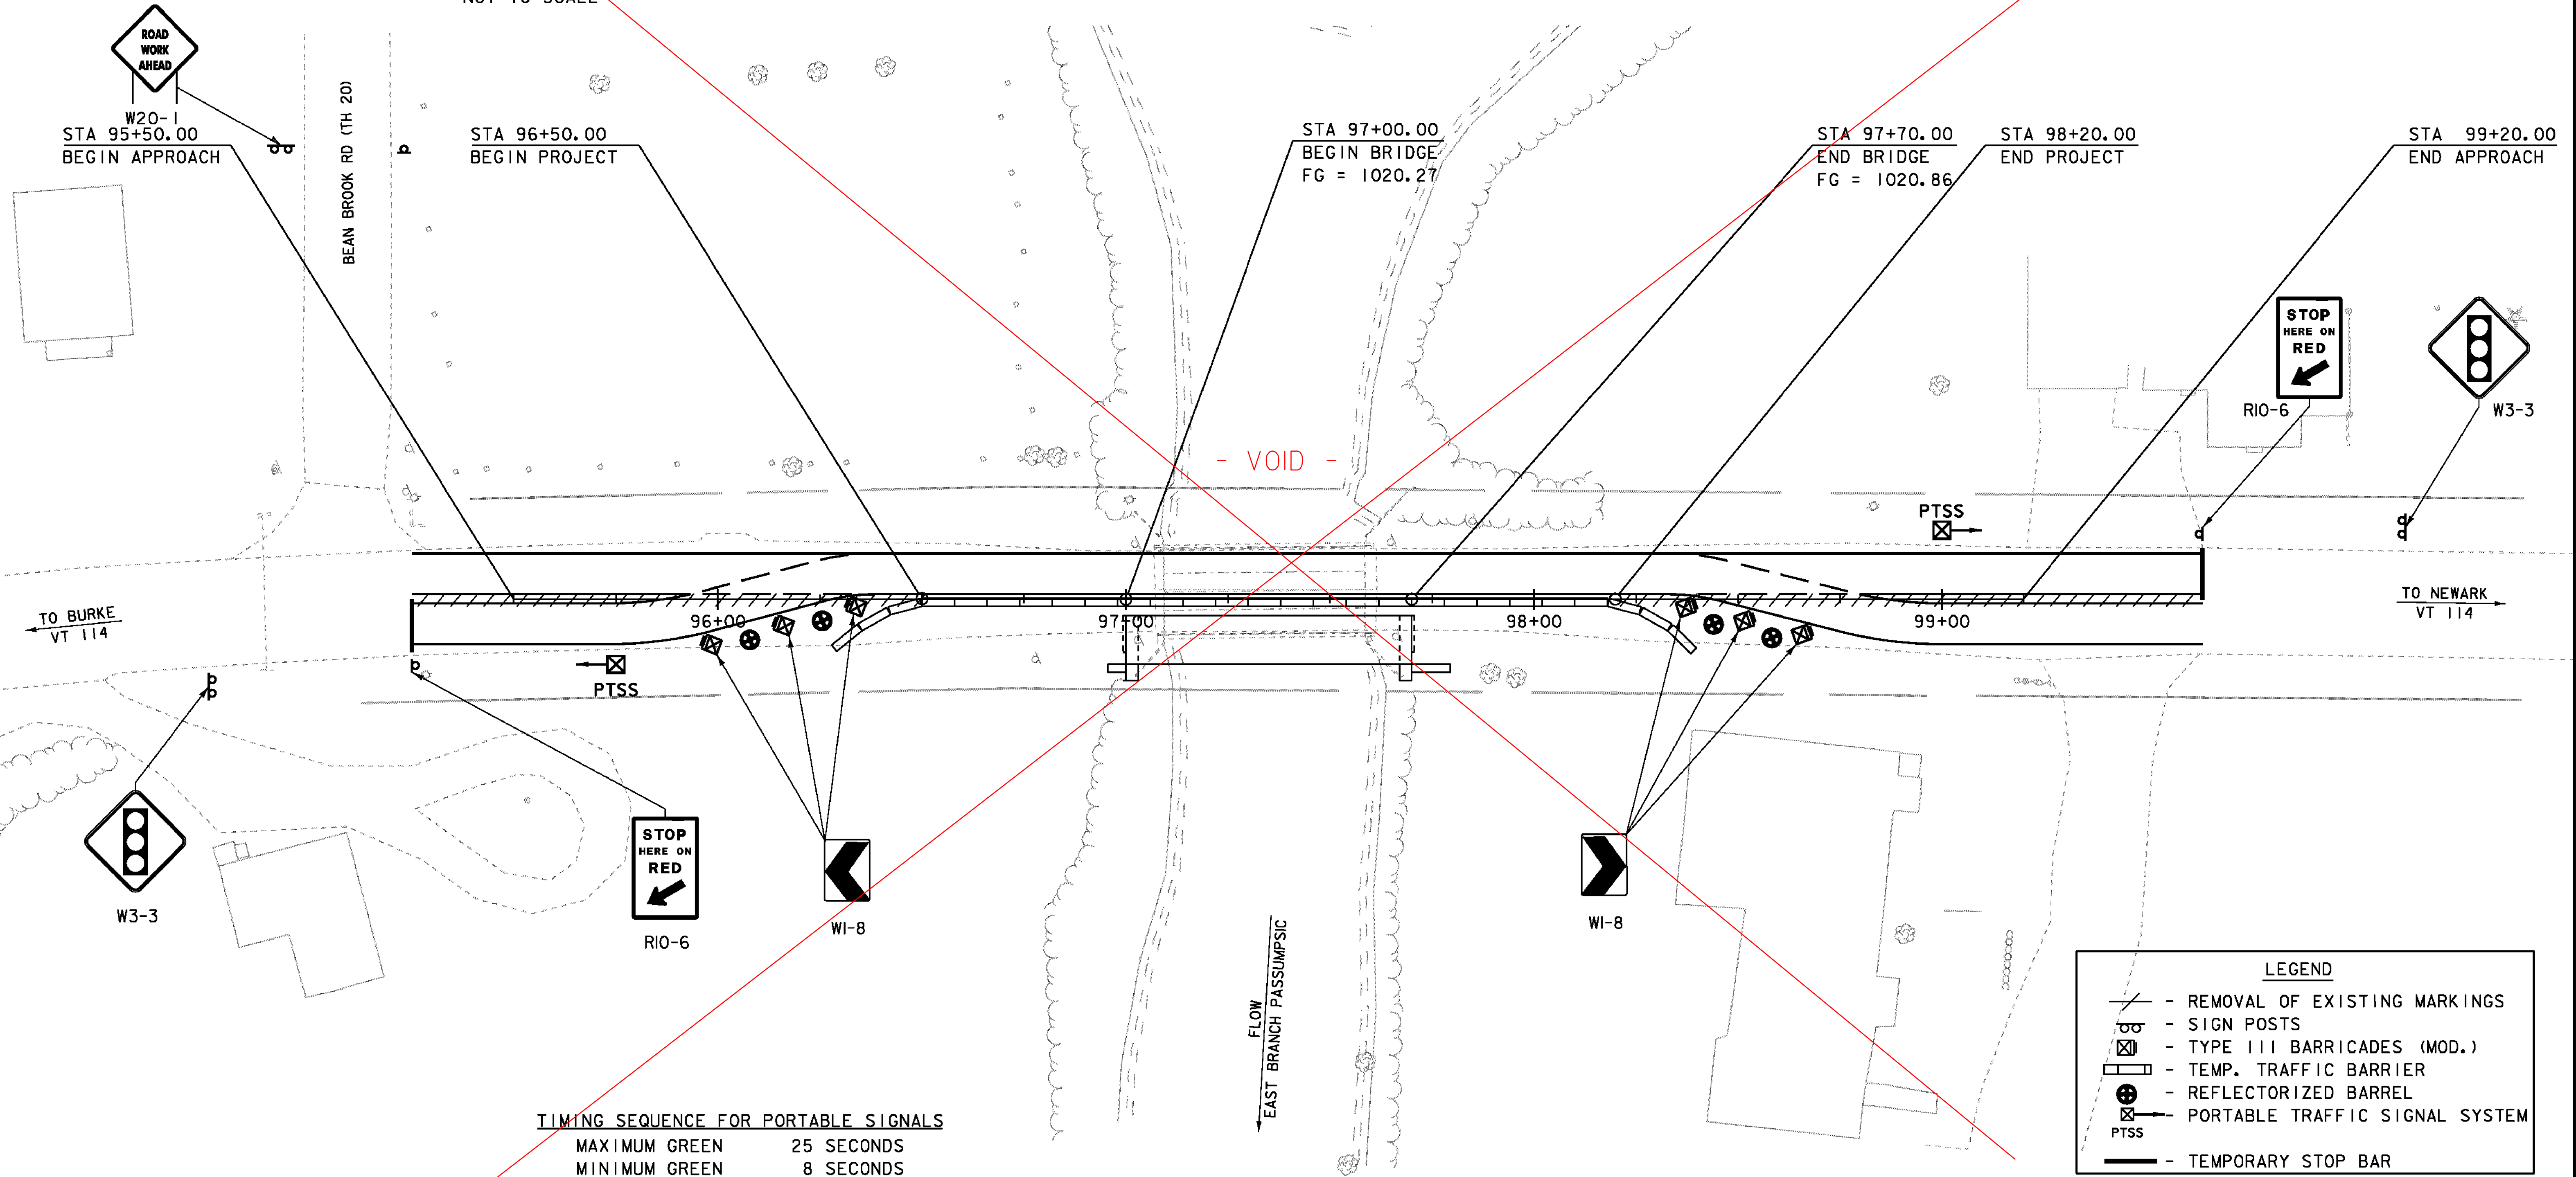


TIMING SEQUENCE FOR PORTABLE SIGNALS

MAXIMUM GREEN	25 SECONDS
MINIMUM GREEN	8 SECONDS
EXTENSION	2 SECONDS
ALL-RED CLEARANCE	16 SECONDS

LEGEND

- REMOVAL OF EXISTING MARKINGS
- SIGN POSTS
- TYPE III BARRICADES (MOD.)
- TEMP. TRAFFIC BARRIER
- REFLECTORIZED BARREL
- PORTABLE TRAFFIC SIGNAL SYSTEM
- TEMPORARY STOP BAR

TRAFFIC CONTROL - PHASE I

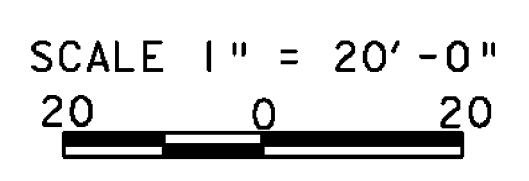

PROJECT NAME: EAST HAVEN	PLOT DATE: 08-AUG-2011
PROJECT NUMBER: BRF 0269(II)	DRAWN BY: R. PELLETT
FILE NAME: s00c162ph1a.dgn	CHECKED BY: J. SALVATORI
PROJECT LEADER: K. HIGGINS	TRAFFIC CONTROL - PHASE I
DESIGNED BY: J. SALVATORI	SHEET 12 OF 40