



SEE NOTE - SHEET II

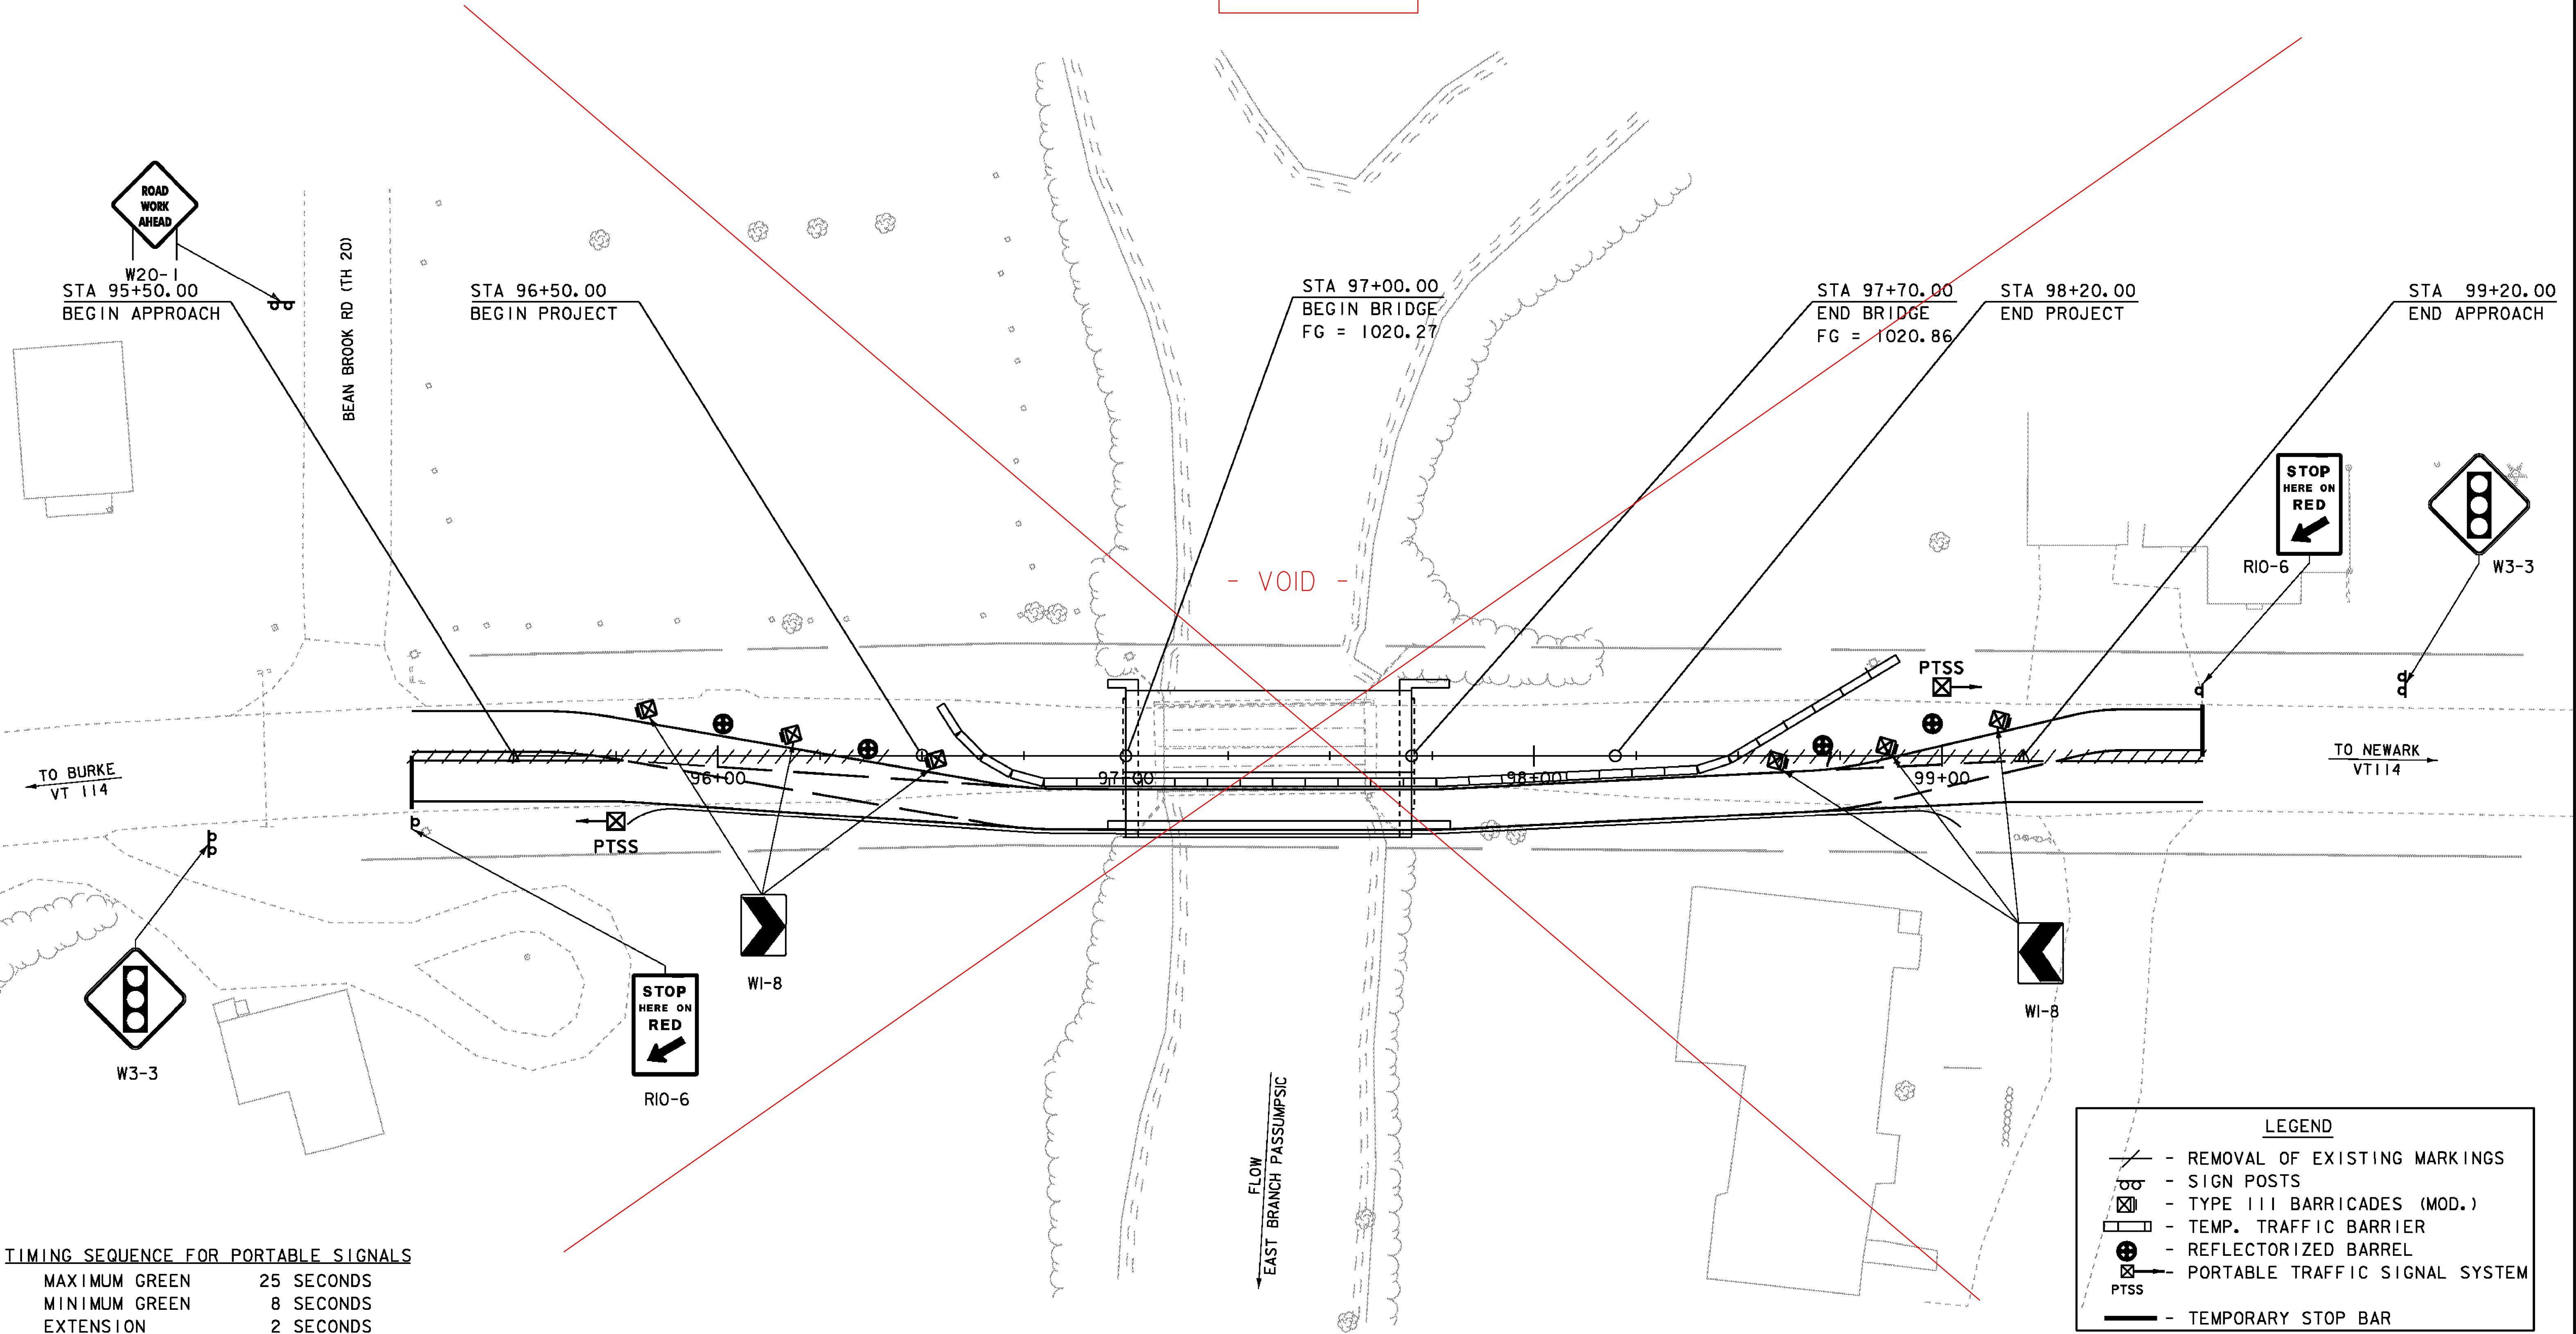

TIMING SEQUENCE FOR PORTABLE SIGNALS

| | |
|-------------------|------------|
| MAXIMUM GREEN | 25 SECONDS |
| MINIMUM GREEN | 8 SECONDS |
| EXTENSION | 2 SECONDS |
| ALL-RED CLEARANCE | 16 SECONDS |

TRAFFIC CONTROL - PHASE II

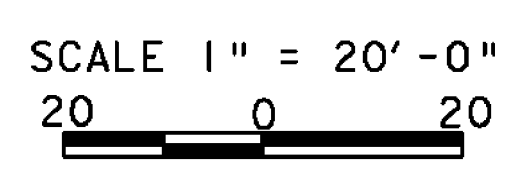

| | | | |
|-----------------|------------------|----------------------------|----------------|
| PROJECT NAME: | EAST HAVEN | PLOT DATE: | 08-AUG-2011 |
| PROJECT NUMBER: | BRF 0269(II) | DRAWN BY: | R. PELLETT |
| FILE NAME: | s00c162ph1a2.dgn | CHECKED BY: | J. SALVATORI |
| PROJECT LEADER: | K. HIGGINS | TRAFFIC CONTROL - PHASE II | SHEET 13 OF 40 |