


ABUTMENT #1 PLAN VIEW

SCALE 1/2" = 1'-0"

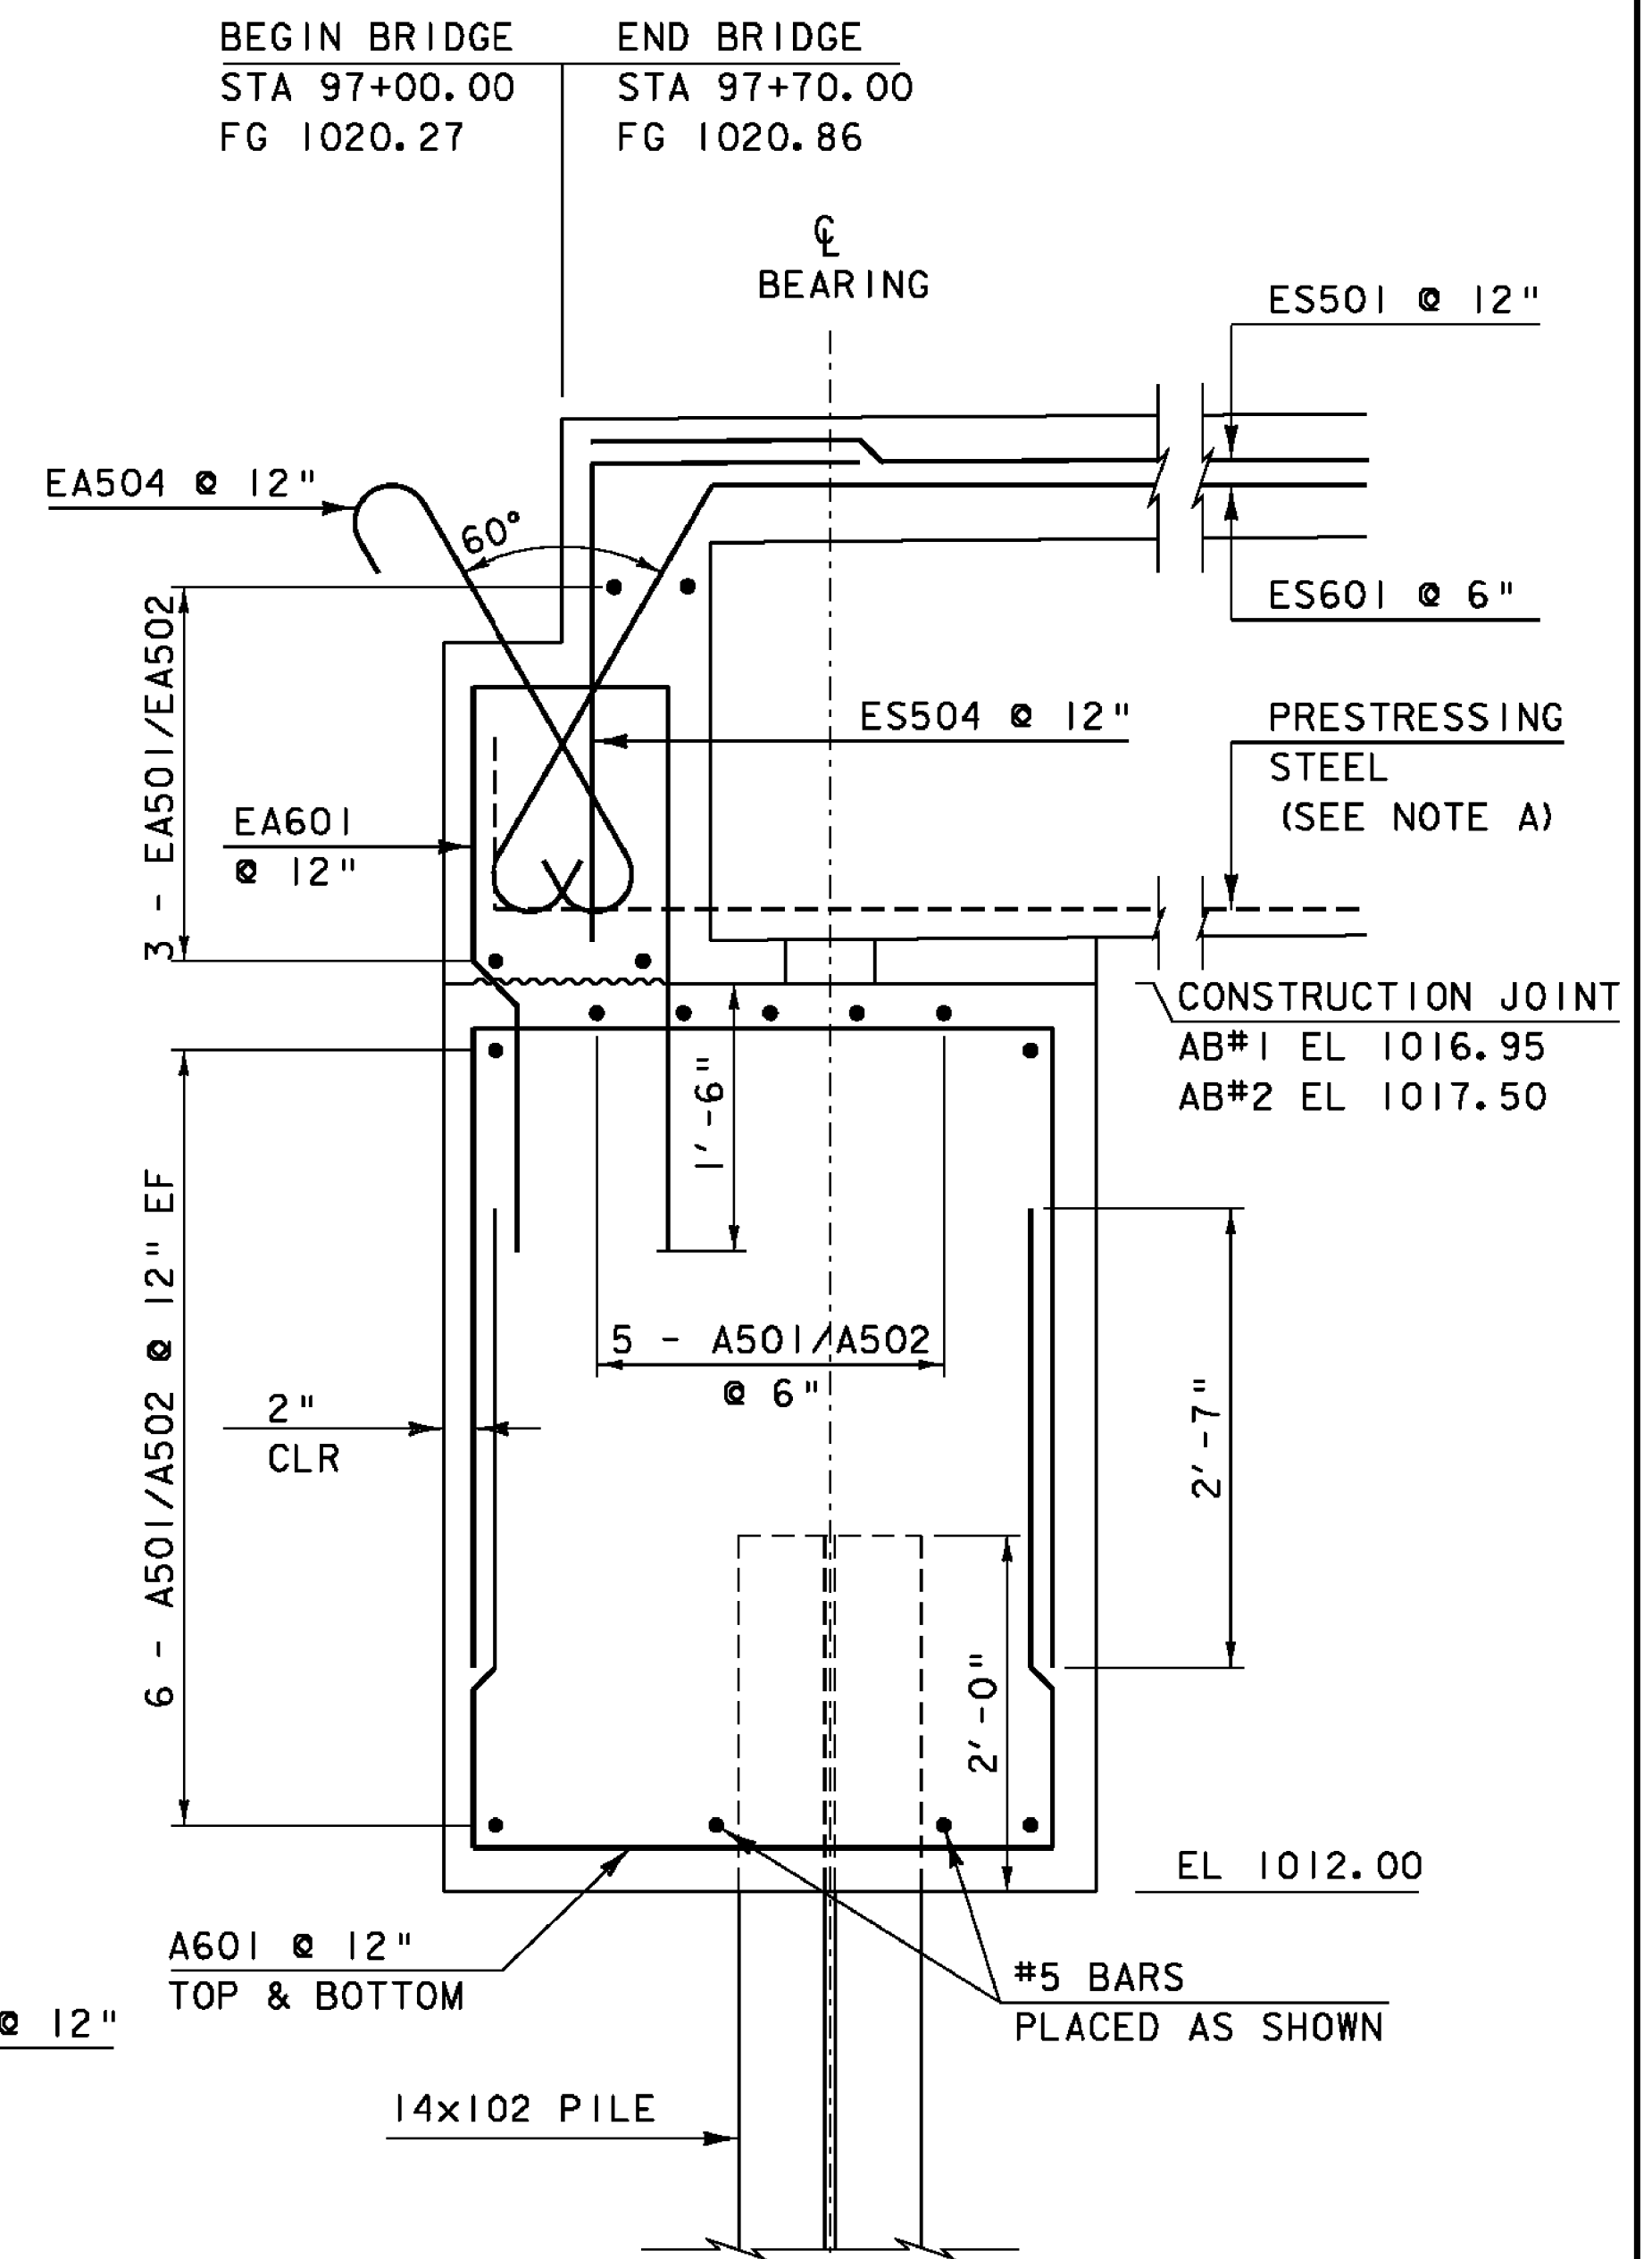


NOTE:
A. EXTEND EVERY OTHER BONDED PRESTRESSED STRANDS ON THE BOTTOM ROW 2'-8". IN LIEU OF EXTENDING THE STRANDS, THE CONTRACTOR MAY PROPOSE AN ALTERNATE DETAIL.

ABUTMENT TYPICAL

SCALE 1" = 1'-0"



NOTE:
NF = NEAR FACE
FF = FAR FACE
EF = EACH FACE
▲ = CUT TO FIT IN FIELD
3" CLEAR, UNLESS OTHERWISE SPECIFIED ON THE PLANS.
2'-2" BAR LAP UNLESS OTHERWISE SPECIFIED ON THE PLANS.

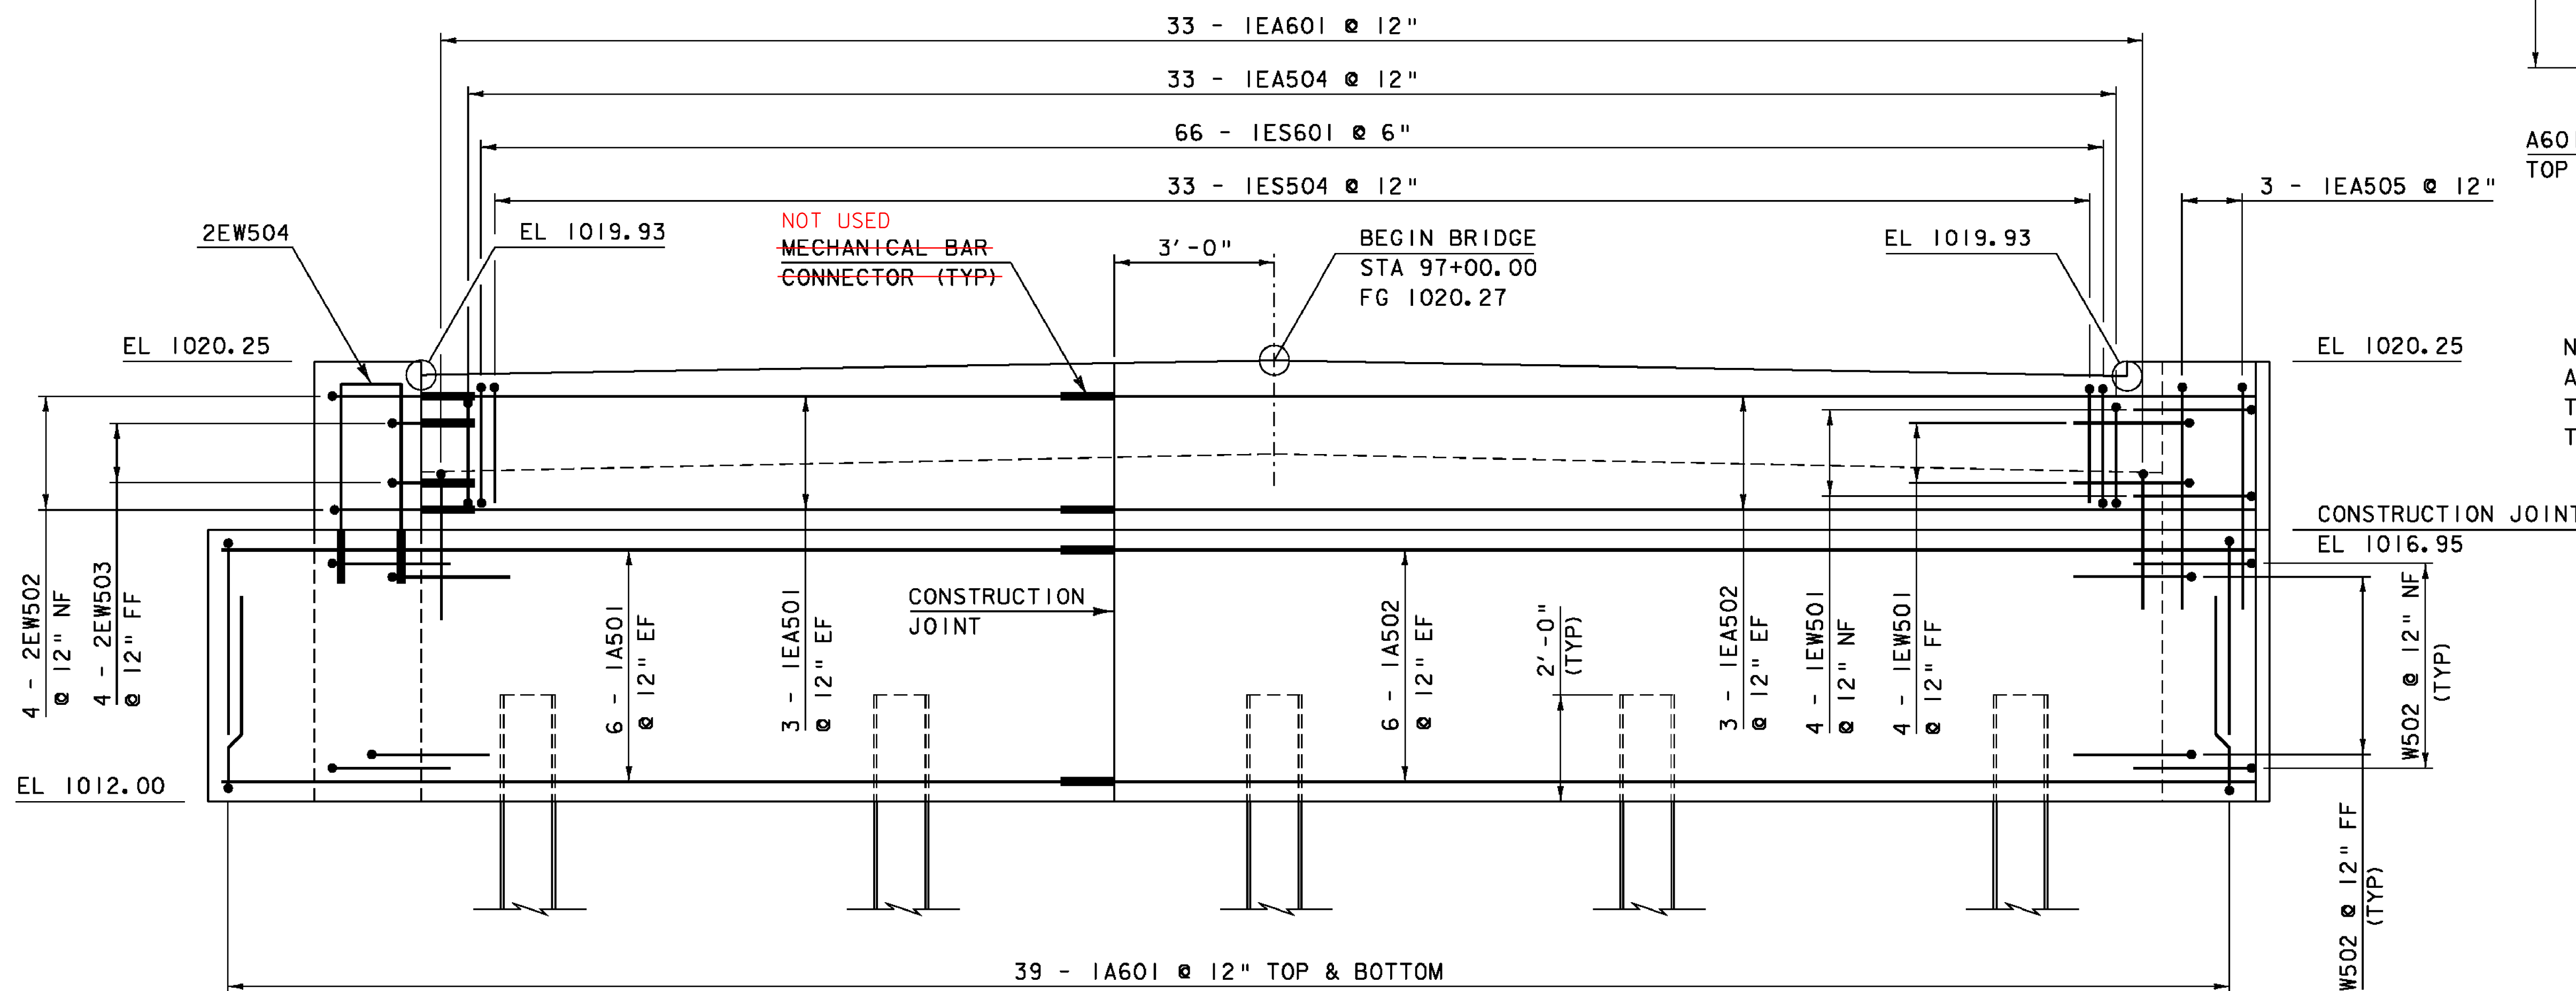

ABUTMENT #1 ELEVATION VIEW

SCALE 1/2" = 1'-0"



PROJECT NAME: EAST HAVEN
PROJECT NUMBER: BRF 0269(II)

FILE NAME: s00cl62sub.dgn
PROJECT LEADER: K. HIGGINS
DESIGNED BY: J. GRIFFIN
ABUTMENT #1 DETAILS

PLOT DATE: 08-AUG-2011
DRAWN BY: J. SALVATORI
CHECKED BY: J. LACROIX
SHEET 24 OF 40