

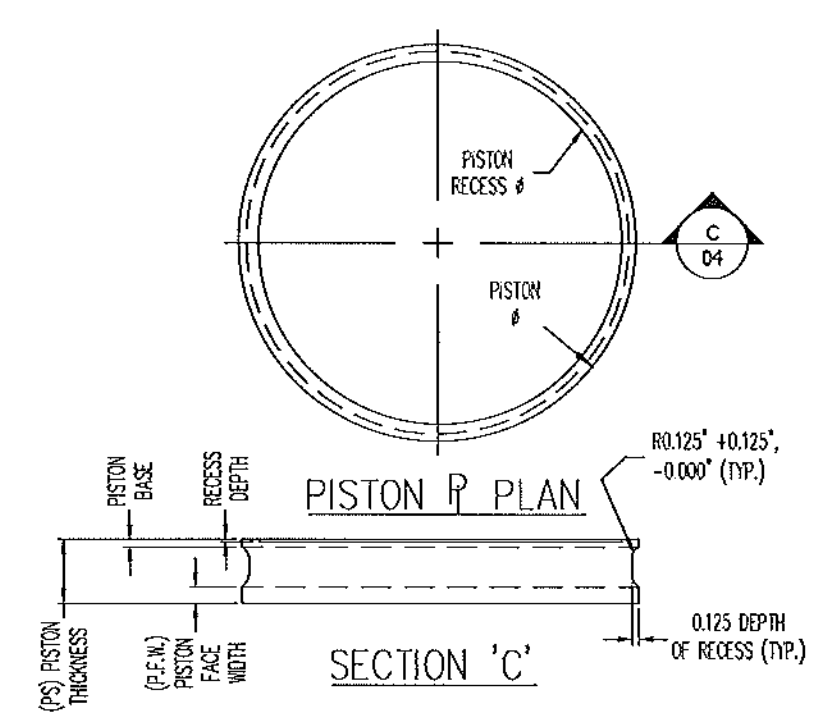


ASSEMBLY 03

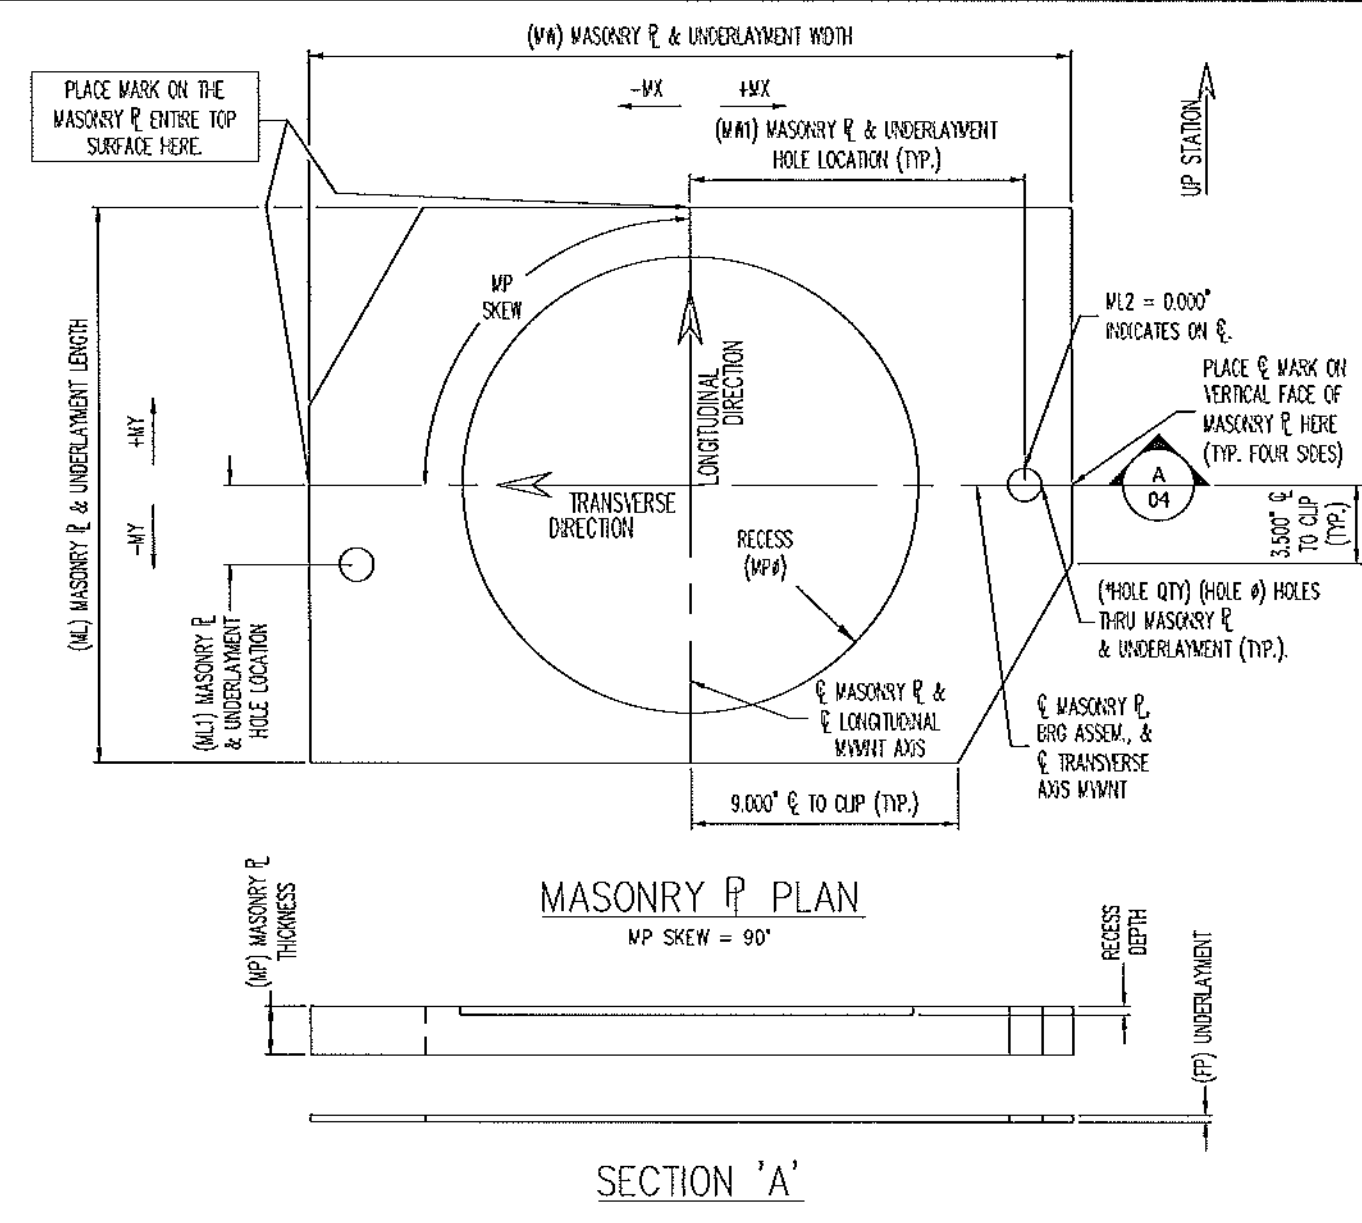


ASSEM	PIECE	QTY	PS	PISTON #	PISTON BASE	RECESS DEPTH	PISTON RECESS #	PISTON MATERIAL
3A	3P1	2	0.900	7.400	0.225	0.188	0.094	7.250

ASSEM	PIECE	QTY	MP	M#	M1	M2	M3	M100
3A	3P1	2	1.500	23.000	18.000	12.250	2.000	0.600	9.063	0.250	2	1.875	+9.00	+0.000	+0.000	3/4 (3/4)	0.125	ANSI10 (ASTM) 18.10.2	AR30 GR 50 or 50W																																																																																					

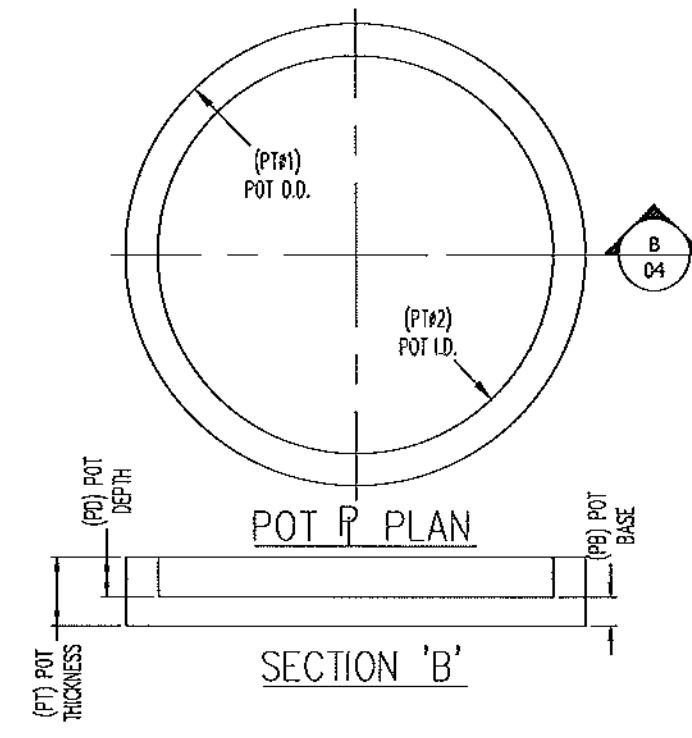

ASSEM	PIECE	QTY	PT #1	PT #2	3A	3P1	2	1.175	9.000	7.500	0.688	1.888	AR30 GR 50 or 50W																																																																																														

Vermont Agency of Transportation
RECEIVED
 CK'D BY GML OK'D BY JEL
 8:53 am, Mar 29, 2012
 RESUBMIT APPROVED X
 BY KMH DATE 3/29/2012

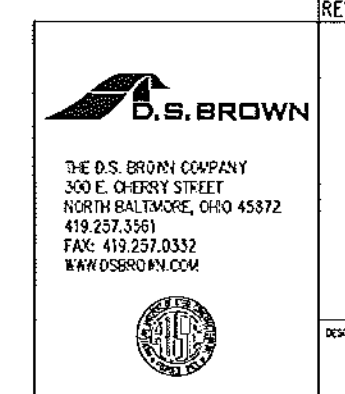

* PER PLATE
 SEE SHE. 03 FOR ASSEMBLY INFORMATION & DETAILS.
 SEE SHE. 05 FOR SUB-ASSEMBLY DETAILS.
 ALL DIMENSIONS IN INCHES UNLESS OTHERWISE NOTED.

REV.	DESCRIPTION	DATE	DET.	CHKD.
1	LOCATION --- TOWN HIGHWAY 6 BRIDGE NO. 57			
2	BRIDGE --- 57			
3	PROJECT NO. --- BRD 1442(26)			
4	PROJECT NAME --- SPRINGFIELD			
5	DESIGNER --- VDOT			
6	CUSTOMER --- T. BUCK CONSTRUCTION, INC.			

DATE	REV.	DESCRIPTION	DATE	REV.	DESCRIPTION
3/29/12	1	ISSUED FOR PRODUCTION			

PROJECT NO.	PROJECT NAME	PROJECT LOCATION	PROJECT DATE	PROJECT SHEET
35029	FM MULTI-DIRECTIONAL HMR SUB-ASSEMBLY DETAIL	WINDSOR CO., VT	1/28/12	04