



ASSEMBLY
03

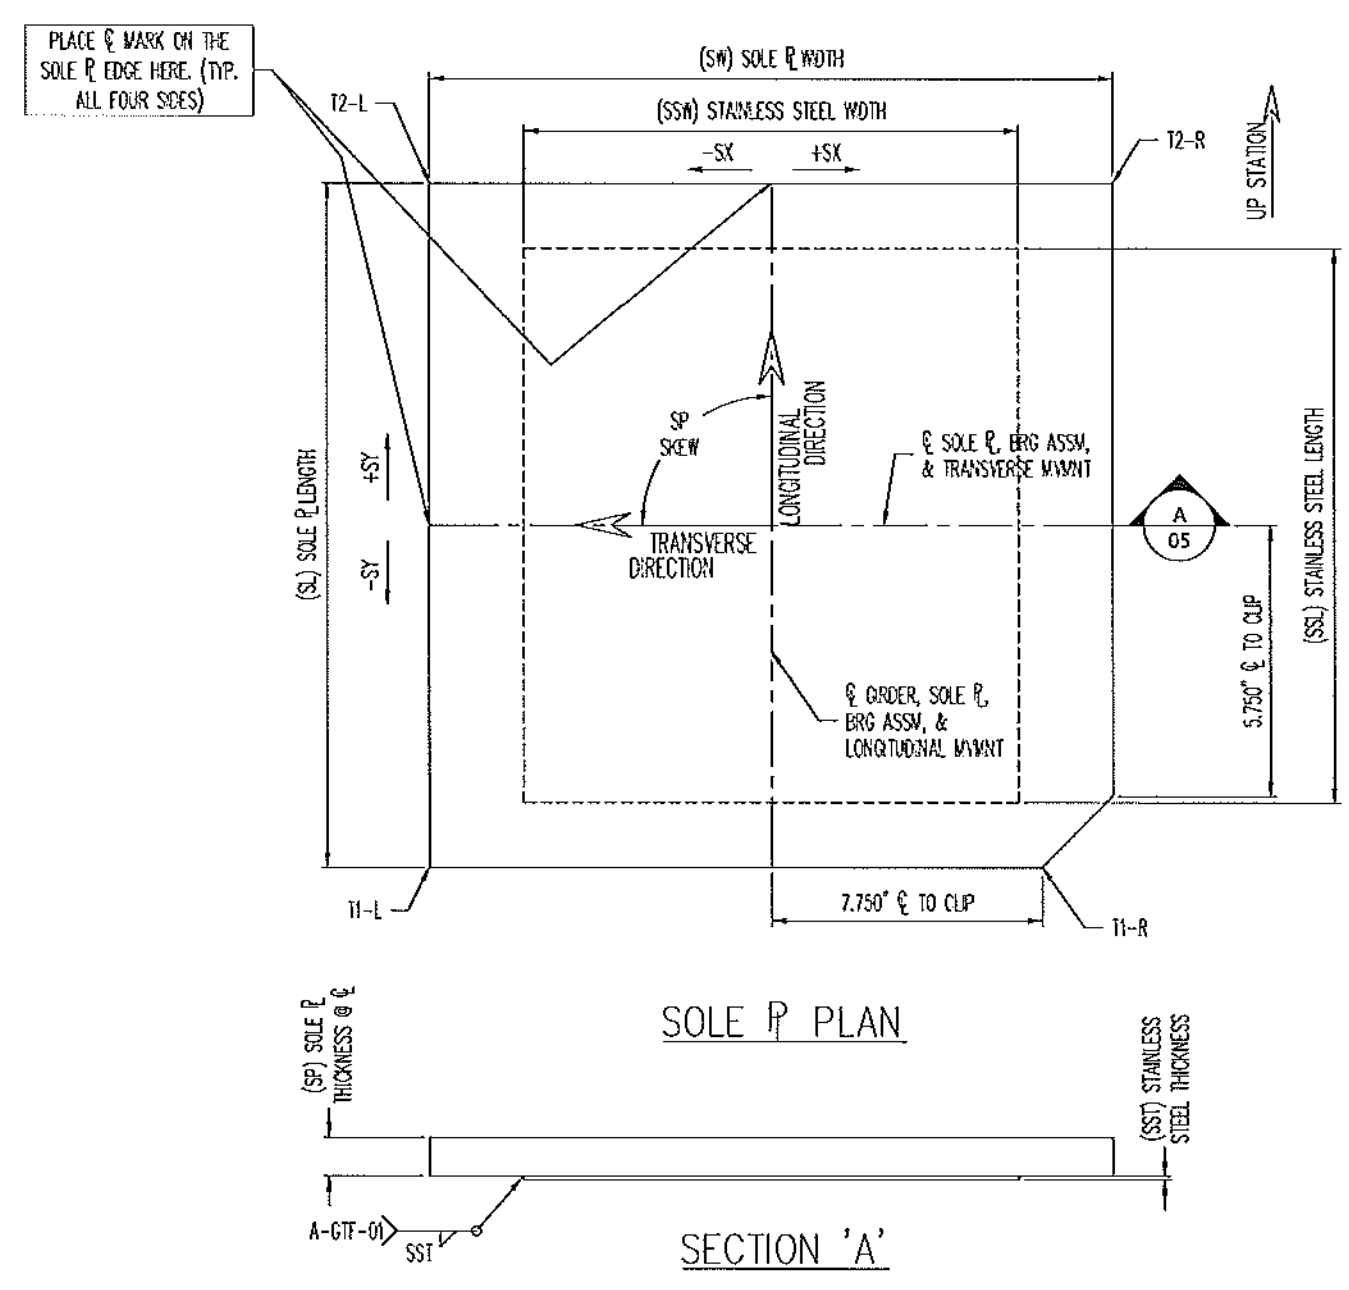

SOLE PLATE & STAINLESS STEEL SCHEDULE (PW)																	
ASSEM	PCCE	BEVEL	BEVEL	BEVEL	SP	SW	S	SOLE PLATE	SP SS	SP	SP SS						
SK	WT	11-L	11-R	12-L	12-R			MATERIAL	SK	SS1	SS2						
SA	3501	2	1.625	1.625	1.000	1.315	20.000	16.000	A102 OR S304 50#	3/8"	0.120	10.250	11.250	+60.0"	+10.000	+10.000	A240 151L #8 & 28

Vermont Agency of Transportation
RECEIVED
CK'D BY GML OK'D BY JEL
8:53 am, Mar 29, 2012
RESUBMIT APPROVED X
BY KMH DATE 3/29/2012

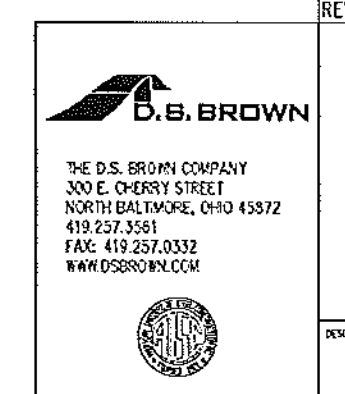

SEE SHIT. 03 FOR ASSEMBLY INFORMATION & DETAILS.
SEE SHIT. 04 FOR SUB-ASSEMBLY DETAILS.
ALL DIMENSIONS IN INCHES UNLESS OTHERWISE NOTED.

REV.	DESCRIPTION	DATE	DET.	CHKD.
1	LOCATION --- TOWN HIGHWAY 8 BRIDGE NO. 57			
	BRIDGE --- 57			
	PROJECT NO. --- BR0 1442(26)			
	PROJECT NAME --- SPRINGFIELD			
	DESIGNER --- VIDOT			
	CUSTOMER --- T BUCK CONSTRUCTION, INC.			

PROJ. NO.	DA	REV.	DATE	BY	CHKD.
FW MULTI-DIRECTIONAL HELM SUB-ASSEMBLY DETAIL	35029	1112	1/26/12		
WINDSOR CO., VT					05