


ASSEMBLY  
06


ASSEM	PIECE	PK	QTY	PT	PW	PL	PB	PO	PR	TE L	TE W	PITE	POT PL
PK	PK	QTY	PK	PK	PK	PK	PK	PK	PK	PK	PK	PK	PK
6A	6A1	1	2.400	8.750	8.750	1.175	1.227	7.750	7.750	1.000	0.031	A709 CR 50 or 50M	
6B	6B1	1	2.400	8.750	8.750	1.175	1.227	7.750	7.750	1.000	0.031	A709 CR 50 or 50M	
6C	6C1	1	2.750	8.500	8.500	1.083	1.083	7.500	7.250	0.875	0.031	A709 CR 50 or 50M	
6D	6D1	1	3.150	12.000	12.000	1.539	1.611	10.500	10.500	1.375	0.031	A709 CR 50 or 50M	

LOCATION	ASSEM	PIECE	QTY	MP	MW	ML	MH	ML1	ML2	RECESS	HOLE	MP	MT	MW1	UL	UL	UL	MASONRY PL		
	PK	PK		PK	PK	PK	PK	PK	PK	PK	PK	PK	PK	PK	PK	PK	PK	PK		
ASSEMBLY 1: 62	6A	6A1	1	1.500	29.000	16.000	12.250	2.000	0.000	7.775	0.250	2	1.675	495.3	41.605		6FA (6ip)	0.125	AKSHTO (LRFD) 18.10.2	A709 CR 50 or 50M
ASSEMBLY 1: 63	6B	6B1	1	1.500	29.000	16.000	12.250	2.000	0.000	7.775	0.250	2	1.675	495.0	40.755		6FA (6ip)	0.125	AKSHTO (LRFD) 18.10.2	A709 CR 50 or 50M
ASSEMBLY 2: 61	6C	6C1	1	1.500	29.000	18.000	12.250	4.500	0.000	7.525	0.250	2	1.675	40.0	40.000		6FB (6ip)	0.125	AKSHTO (LRFD) 18.10.2	A709 CR 50 or 50M
ASSEMBLY 2: 64	6D	6D1	1	2.500	29.000	18.000	11.500	4.500	0.000	10.533	0.250	2	2.375	40.0	40.000		6FC (6ip)	0.125	AKSHTO (LRFD) 18.10.2	A709 CR 50 or 50M

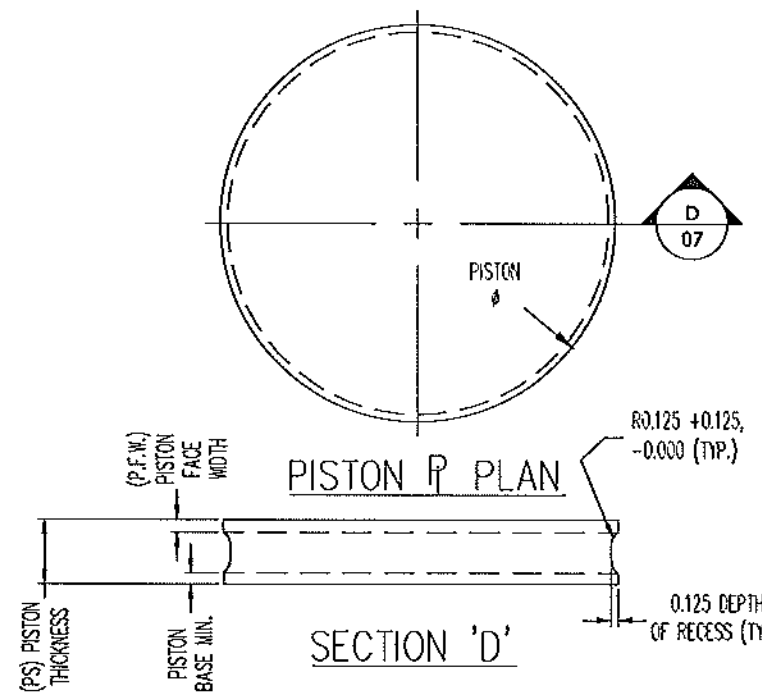

ASSEM	PIECE	QTY	PK	PK	PK	PK	PK	PK	PK	PK	PK	PK	PK
PK	PK	PK	PK	PK	PK	PK	PK	PK	PK	PK	PK	PK	PK
6A	6A1	1	1.225	2.710	0.235	0.250							A709 CR 50 or 50M
6B	6B1	1	1.225	2.710	0.235	0.250							A709 CR 50 or 50M
6C	6C1	1	1.225	2.760	0.235	0.250							A709 CR 50 or 50M
6D	6D1	1	1.600	10.460	0.294	0.250							A709 CR 50 or 50M

Vermont Agency of Transportation  
**RECEIVED**  
CK'D BY GML OK'D BY JEL  
8:53 am, Mar 29, 2012  
RESUBMIT APPROVED X  
BY KMH DATE 3/29/2012

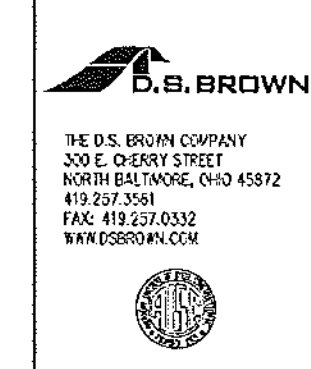

\* PER PLATE  
SEE SH. 08 FOR ASSEMBLY DETAILS & LOCATIONS  
SEE SH. 08 FOR ADDITIONAL SUB-ASSEMBLY DETAILS  
ALL DIMENSIONS ARE IN INCHES UNLESS OTHERWISE NOTED.

REV	DESCRIPTION	DATE	BY	CHKD
1	ADDED LOCATIONS TO MASONRY PLATE SCHEDULE	3/28/12	KTG	KTG

LOCATION	DESCRIPTION	ITEM	QUANTITY
TOWN HIGHWAY 6 BRIDGE NO. 57	BRIDGE - 57		
	PROJECT NO. - BRD 1442(26)		
	PROJECT NAME - SPRINGSFIELD		
	DESIGNER - VIOT		
	CUSTOMER - T. BUCK CONSTRUCTION, INC.		

NO. OF	N.T.S.	DA	DATE	BY	CHKD
35029	1112	1	07		