




1 DIMENSIONAL PLAN VIEW IN FORM

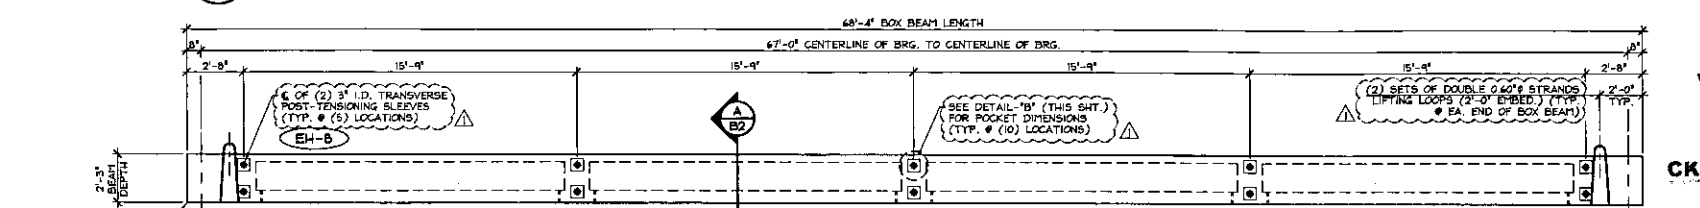


2 DIMENSIONAL ELEVATION

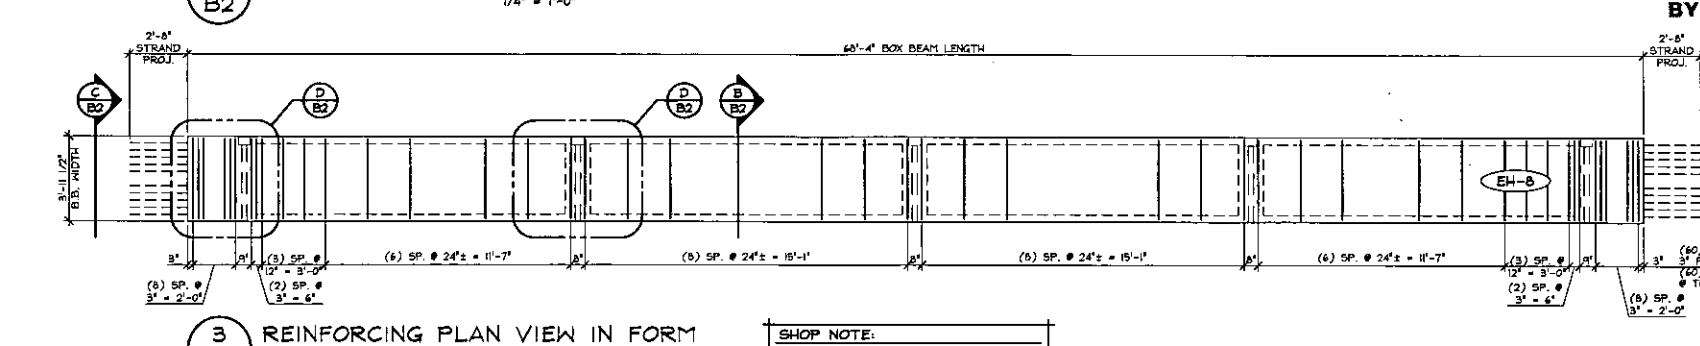


3 REINFORCING PLAN VIEW IN FORM

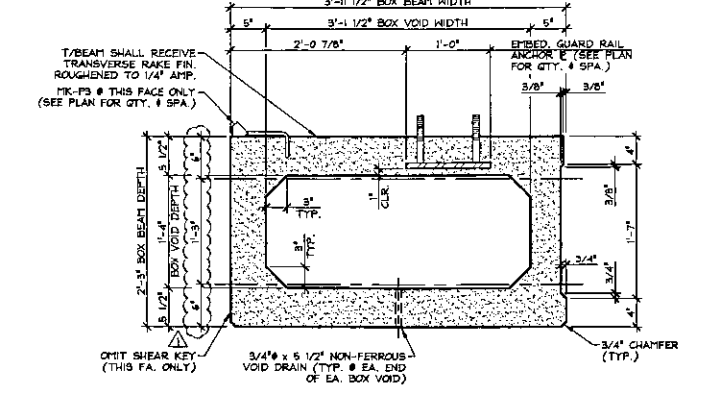

A DIMENSIONAL SECTION

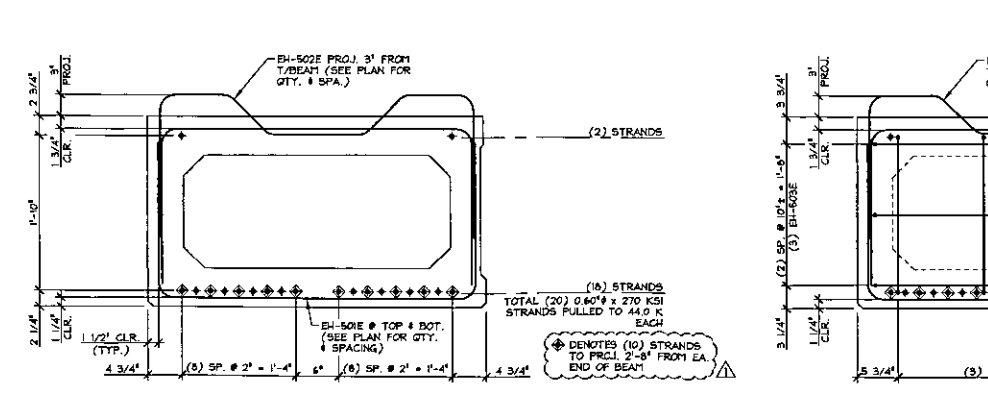


B REINFORCING SECTION

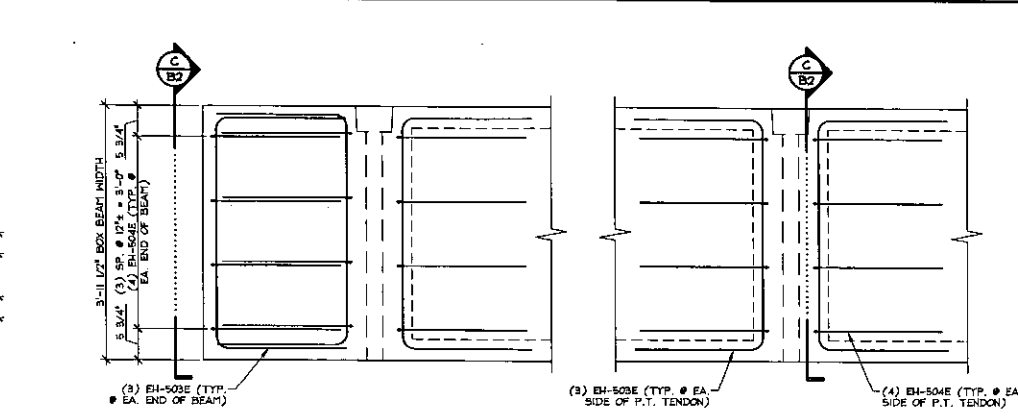

D END DIAPHRAGM & INTERMEDIATE DIAPHRAGM REINF. PLAN

Vermont Agency of Transportation
RECEIVED
 CK'D BY [Signature] OK'D BY [Signature]
 10:19 am, Mar 05, 2012
 RESUBMIT BY [Signature] APPROVED BY [Signature]
 ATE 3-16-12

DENSIFICATION SCHEDULE

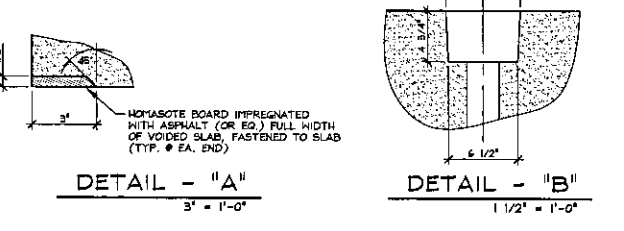

DETAIL 'A' and DETAIL 'B'

ITEM	MARK	QTY.	WT.	T	VOL.	CU YD
1	REINFORCING BAR (CONCRETE)	27.34	13.53			
2	REINFORCING BAR (CONCRETE)					
3	REINFORCING BAR (CONCRETE)					
4	REINFORCING BAR (CONCRETE)					
5	PRESTRESSED GUARD RAIL (HEAVY PLATE (GALV)) (COMPLETED BY OTHERS)					
6	2X4X8 LATHING (2X4 X 8) (CONCRETE)					
7	2X4X8 LATHING (2X4 X 8) (CONCRETE)					
8	SET OF DOUBLE END BRACKETS (LIFTING LOOPS)					

11/17/2011 11:11 AM

STATE OF VERMONT AGENCY OF TRANSPORTATION	DRAWN BY: [Signature]	J.P. CARRARA & SONS INC.	Project Name: TOWN OF EAST HAVEN, VT	SCALE: 3/8" = 1'-0"
DESIGNED BY: [Signature]	CHECKED BY: [Signature]	AUSTIN CONSTRUCTION CONCORD, VT	TOWN OF EAST HAVEN, VT STATE ROUTE 104 - MAJOR COLLECTOR BRIDGE NO. 10 PROJECT NO. BRP 024(11)	NOTED: 2/24/12
APPROVED BY: [Signature]			DATE: 1-20-11	SHEET # B2