


Vermont Agency of Transportation
RECEIVED
 CK'D BY JMS OK'D BY JTS
 10:19 am, Mar 05, 2012
 RESUBMIT APPROVED
 BY HSH ATE 3/16/12
 DETENSURING SCHEDULE
 RT&E

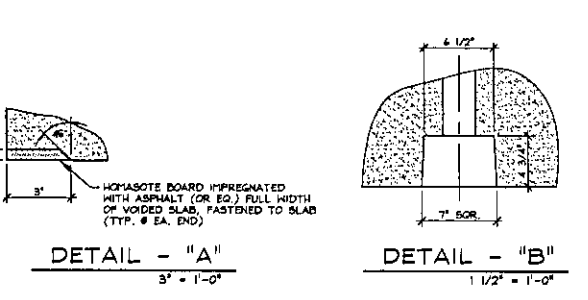

MARK: E4-B QTY: 1 WT: 26.85 T VOL: 13.26 cy

ITEM	MARK	DESCRIPTION	QTY
1	REINFORCING	REINFORCING (CONCRETE)	1
2	REINFORCING	REINFORCING (CONCRETE)	1
3	REINFORCING	REINFORCING (CONCRETE)	1
4	REINFORCING	REINFORCING (CONCRETE)	1
5	REINFORCING	REINFORCING (CONCRETE)	1
6	REINFORCING	REINFORCING (CONCRETE)	1
7	REINFORCING	REINFORCING (CONCRETE)	1
8	REINFORCING	REINFORCING (CONCRETE)	1
9	REINFORCING	REINFORCING (CONCRETE)	1
10	REINFORCING	REINFORCING (CONCRETE)	1

STATE OF VERMONT AGENCY OF TRANSPORTATION	DESIGNED BY: J.P. CARRARA & SONS INC.	PROJECT NAME: TOWN OF EAST HAVEN, VT STATE ROUTE 114 - MAJOR COLLECTOR BRIDGE NO. 18 PROJECT NO. BRP 024(1)	SCALE: NOTED 23343-01
APPROVED BY: [Signature]	AUSTIN CONSTRUCTION CONCORD, VT	DATE: 1-20-11	SHEET # B8