

STATE OF VERMONT
AGENCY OF TRANSPORTATION



PROPOSED IMPROVEMENT
TOWN OF WEATHERSFIELD
COUNTY OF WINDSOR
VT ROUTE 131 (RURAL MAJOR COLLECTOR)
BRIDGE NO: 11B

RECORD PLANS

CONTRACTOR: PIKE INDUSTRIES, INC. - BERLIN, VT

RESIDENT ENGINEER: CHRIS BARKER

CONSTRUCTION BEGAN: AUGUST 24, 2013


CONSTRUCTION COMPLETE: SEPTEMBER 27, 2013

RECORD PLANS BY: CHRIS BARKER & NICK GARBACIK

I HEREBY CERTIFY THAT ALL THE CONSTRUCTION REQUIRED BY THIS SET OF DRAWINGS HAS BEEN ACCOMPLISHED AS INDICATED HEREIN.

BY *Chris Barker* RESIDENT ENGINEER
DATE: 08/04/15


NOTE: Any further information concerning final quantities, amounts or other details relative to this project may be found by contacting Virans Records Management.

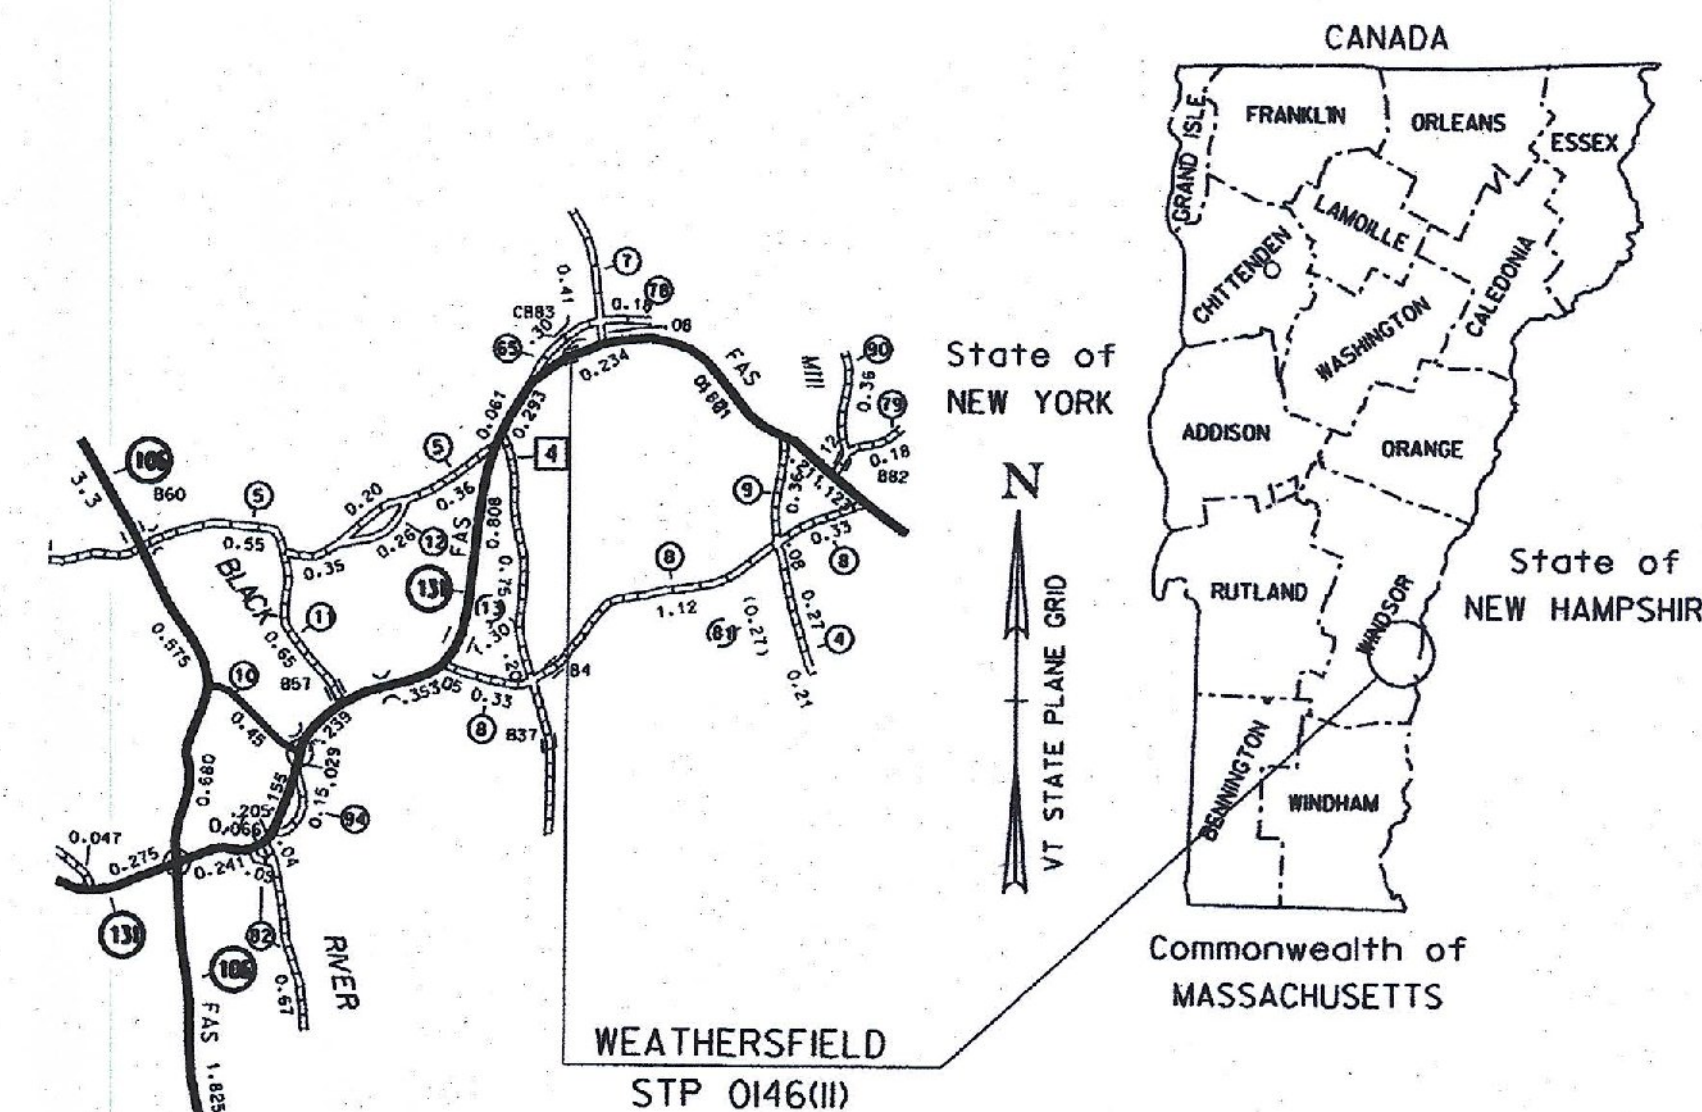

PROJECT LOCATION: APPROXIMATELY 2.5 MILES EAST OF THE JUNCTION WITH VT 106.

PROJECT DESCRIPTION: THE PROJECT SHALL CONSIST OF LINING THE EXISTING CULVERT WITH A CURED-IN-PLACE PIPE (CIPP) LINER AND MINOR HEADWALL REPAIRS.

LENGTH OF STRUCTURE: 6.91 FEET
LENGTH OF PROJECT: 125 FEET

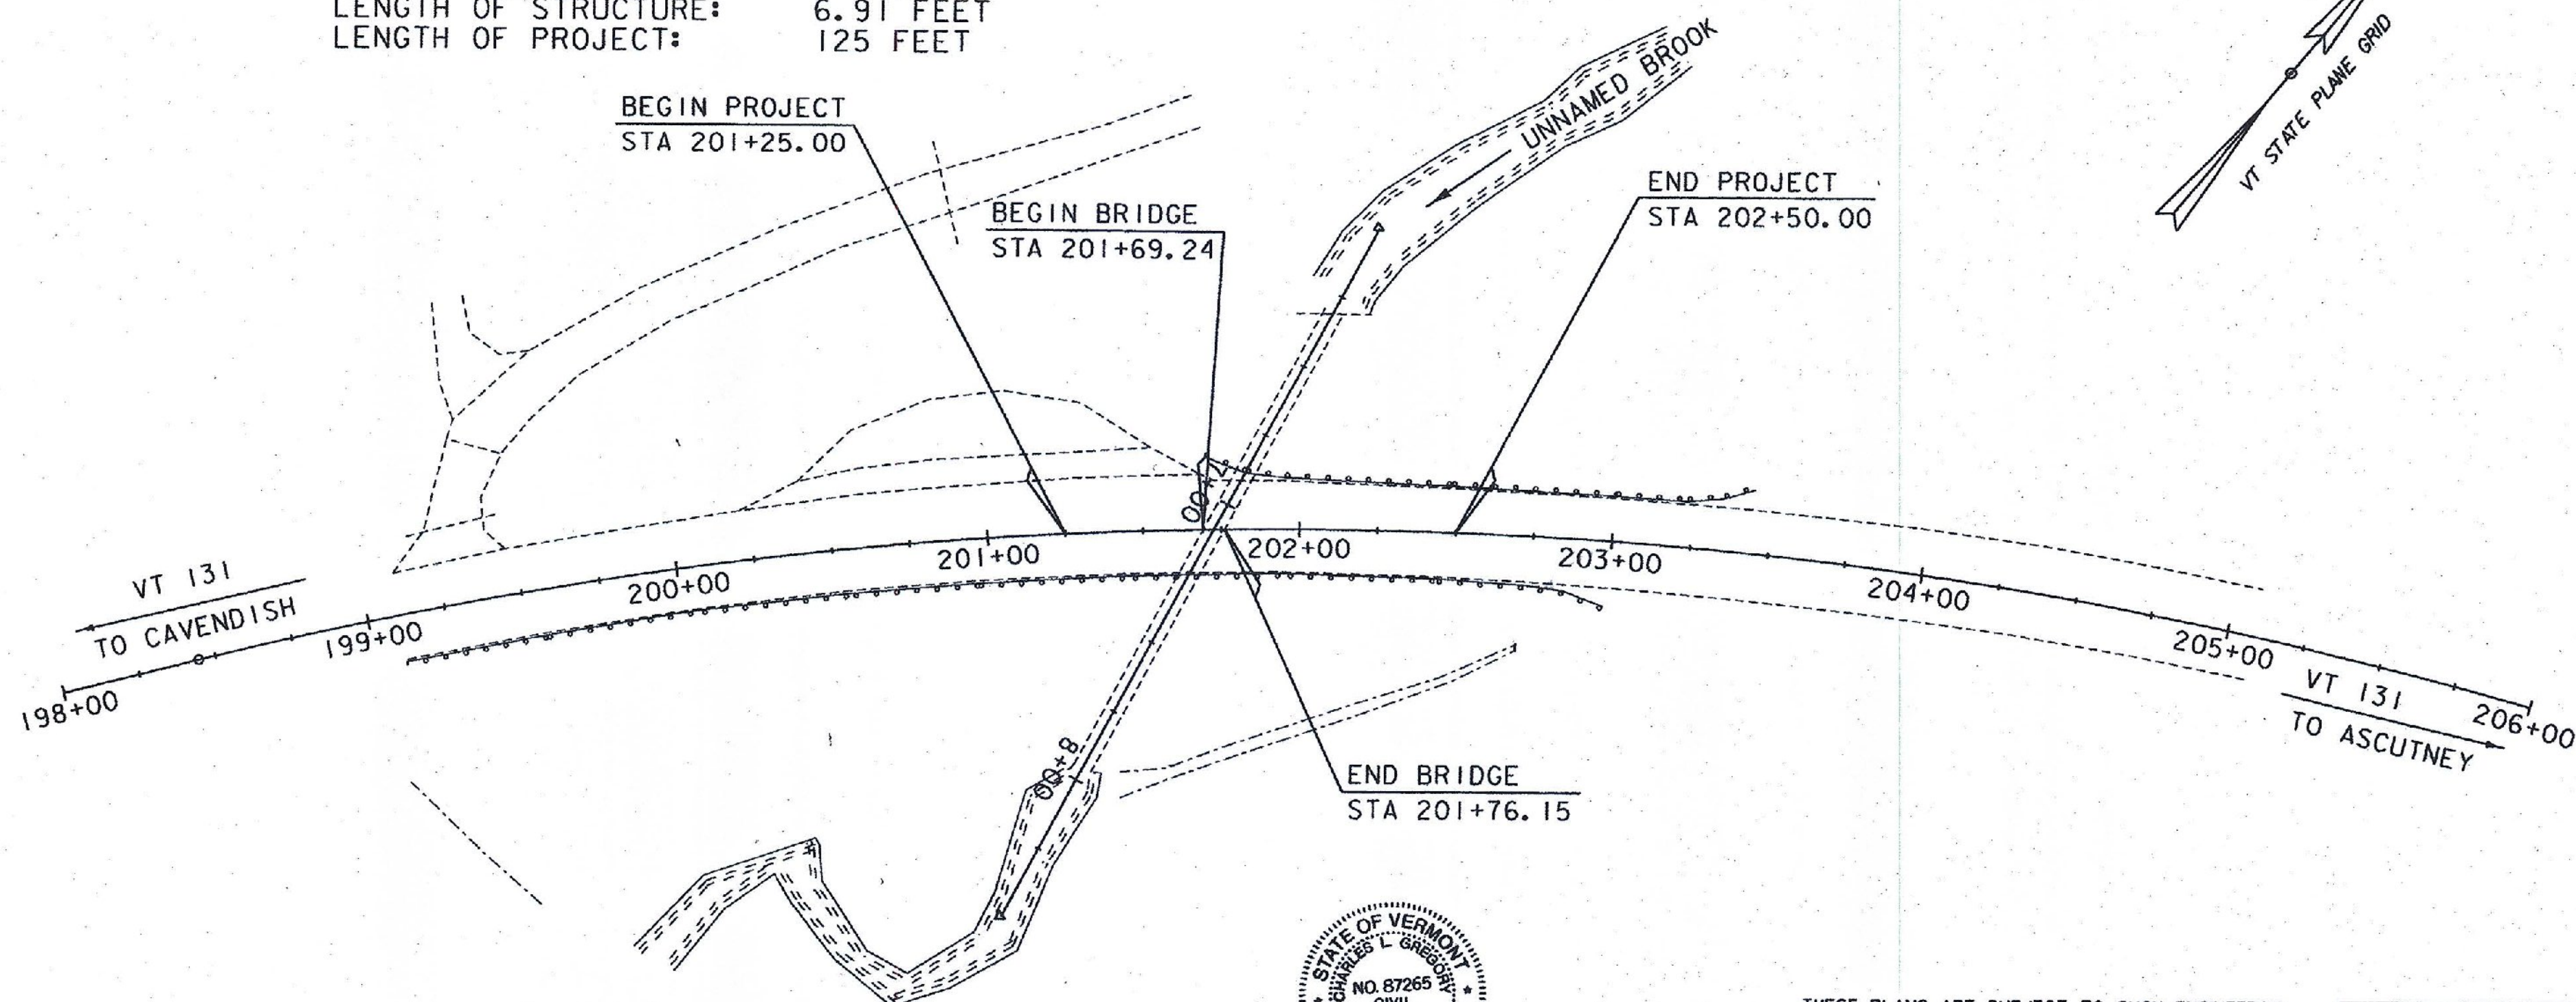

QUALITY ASSURANCE PROGRAM: LEVEL 2

CONVENTIONAL SYMBOLS

COUNTY LINE	
TOWN LINE	
LIMITS OF ACCESS	
POINT OF ACCESS	
FENCE LINE	
STONE WALL	
TRAVELED WAY	
GUARD RAIL	
RAILROAD	
SURVEY LINE	
CULVERT	
POWER POLE	
TELEPHONE POLE	
TREES	
CONTROL OF ACCESS	
PROPERTY LINE	
R.O.W. TAKING LINE	
SLOPE RIGHTS	
TOP OF CUT	
TOE OF SLOPE	

SURVEYED BY : VTRANS (R. GILMAN)
SURVEYED DATE : 01/25/2001

DATUM
VERTICAL NAVD 88
HORIZONTAL NAD 83 (1996)

CONSULTING ENGINEERS Inc.

540 Commercial Street • Manchester, NH 03101
603) 668-8223 • Fax: 603) 668-8802
email: cled@cedengineers.com • www.cedengineers.com
Wafne • New Hampshire • Vermont

STATE OF VERMONT
L. GILMAN
NO. 87265
CIVIL

SCALE 1" = 40'-0"

THESE PLANS ARE SUBJECT TO SUCH ENGINEERING CHANGES AS MAY BE REQUIRED BY THE FEDERAL HIGHWAY ADMINISTRATION OR THE DIRECTOR OF PROGRAM DEVELOPMENT.

CONSTRUCTION IS TO BE CARRIED ON IN ACCORDANCE WITH THESE PLANS AND THE STANDARD SPECIFICATIONS FOR CONSTRUCTION DATED 2011 AS APPROVED BY THE FEDERAL HIGHWAY ADMINISTRATION ON JULY 20, 2011 FOR USE ON THIS PROJECT, INCLUDING ALL SUBSEQUENT REVISIONS AND SUCH REVISED SPECIFICATIONS AND SPECIAL PROVISIONS AS ARE INCORPORATED IN THESE PLANS.

DIRECTOR OF PROGRAM DEVELOPMENT
APPROVED: *Jennifer Fitch* DATE: 4-2-13

PROJECT MANAGER : JENNIFER FITCH

PROJECT NAME : WEATHERSFIELD
PROJECT NUMBER : STP 0146 (111)

SHEET 1 OF 14 SHEETS