


CURVE (14)  
 DELTA = 44°59'20"  
 D = 3°57'05"  
 R = 1450.00'  
 T = 600.44'  
 L = 1138.54'  
 E = 119.41'  
 BANK = 0.060

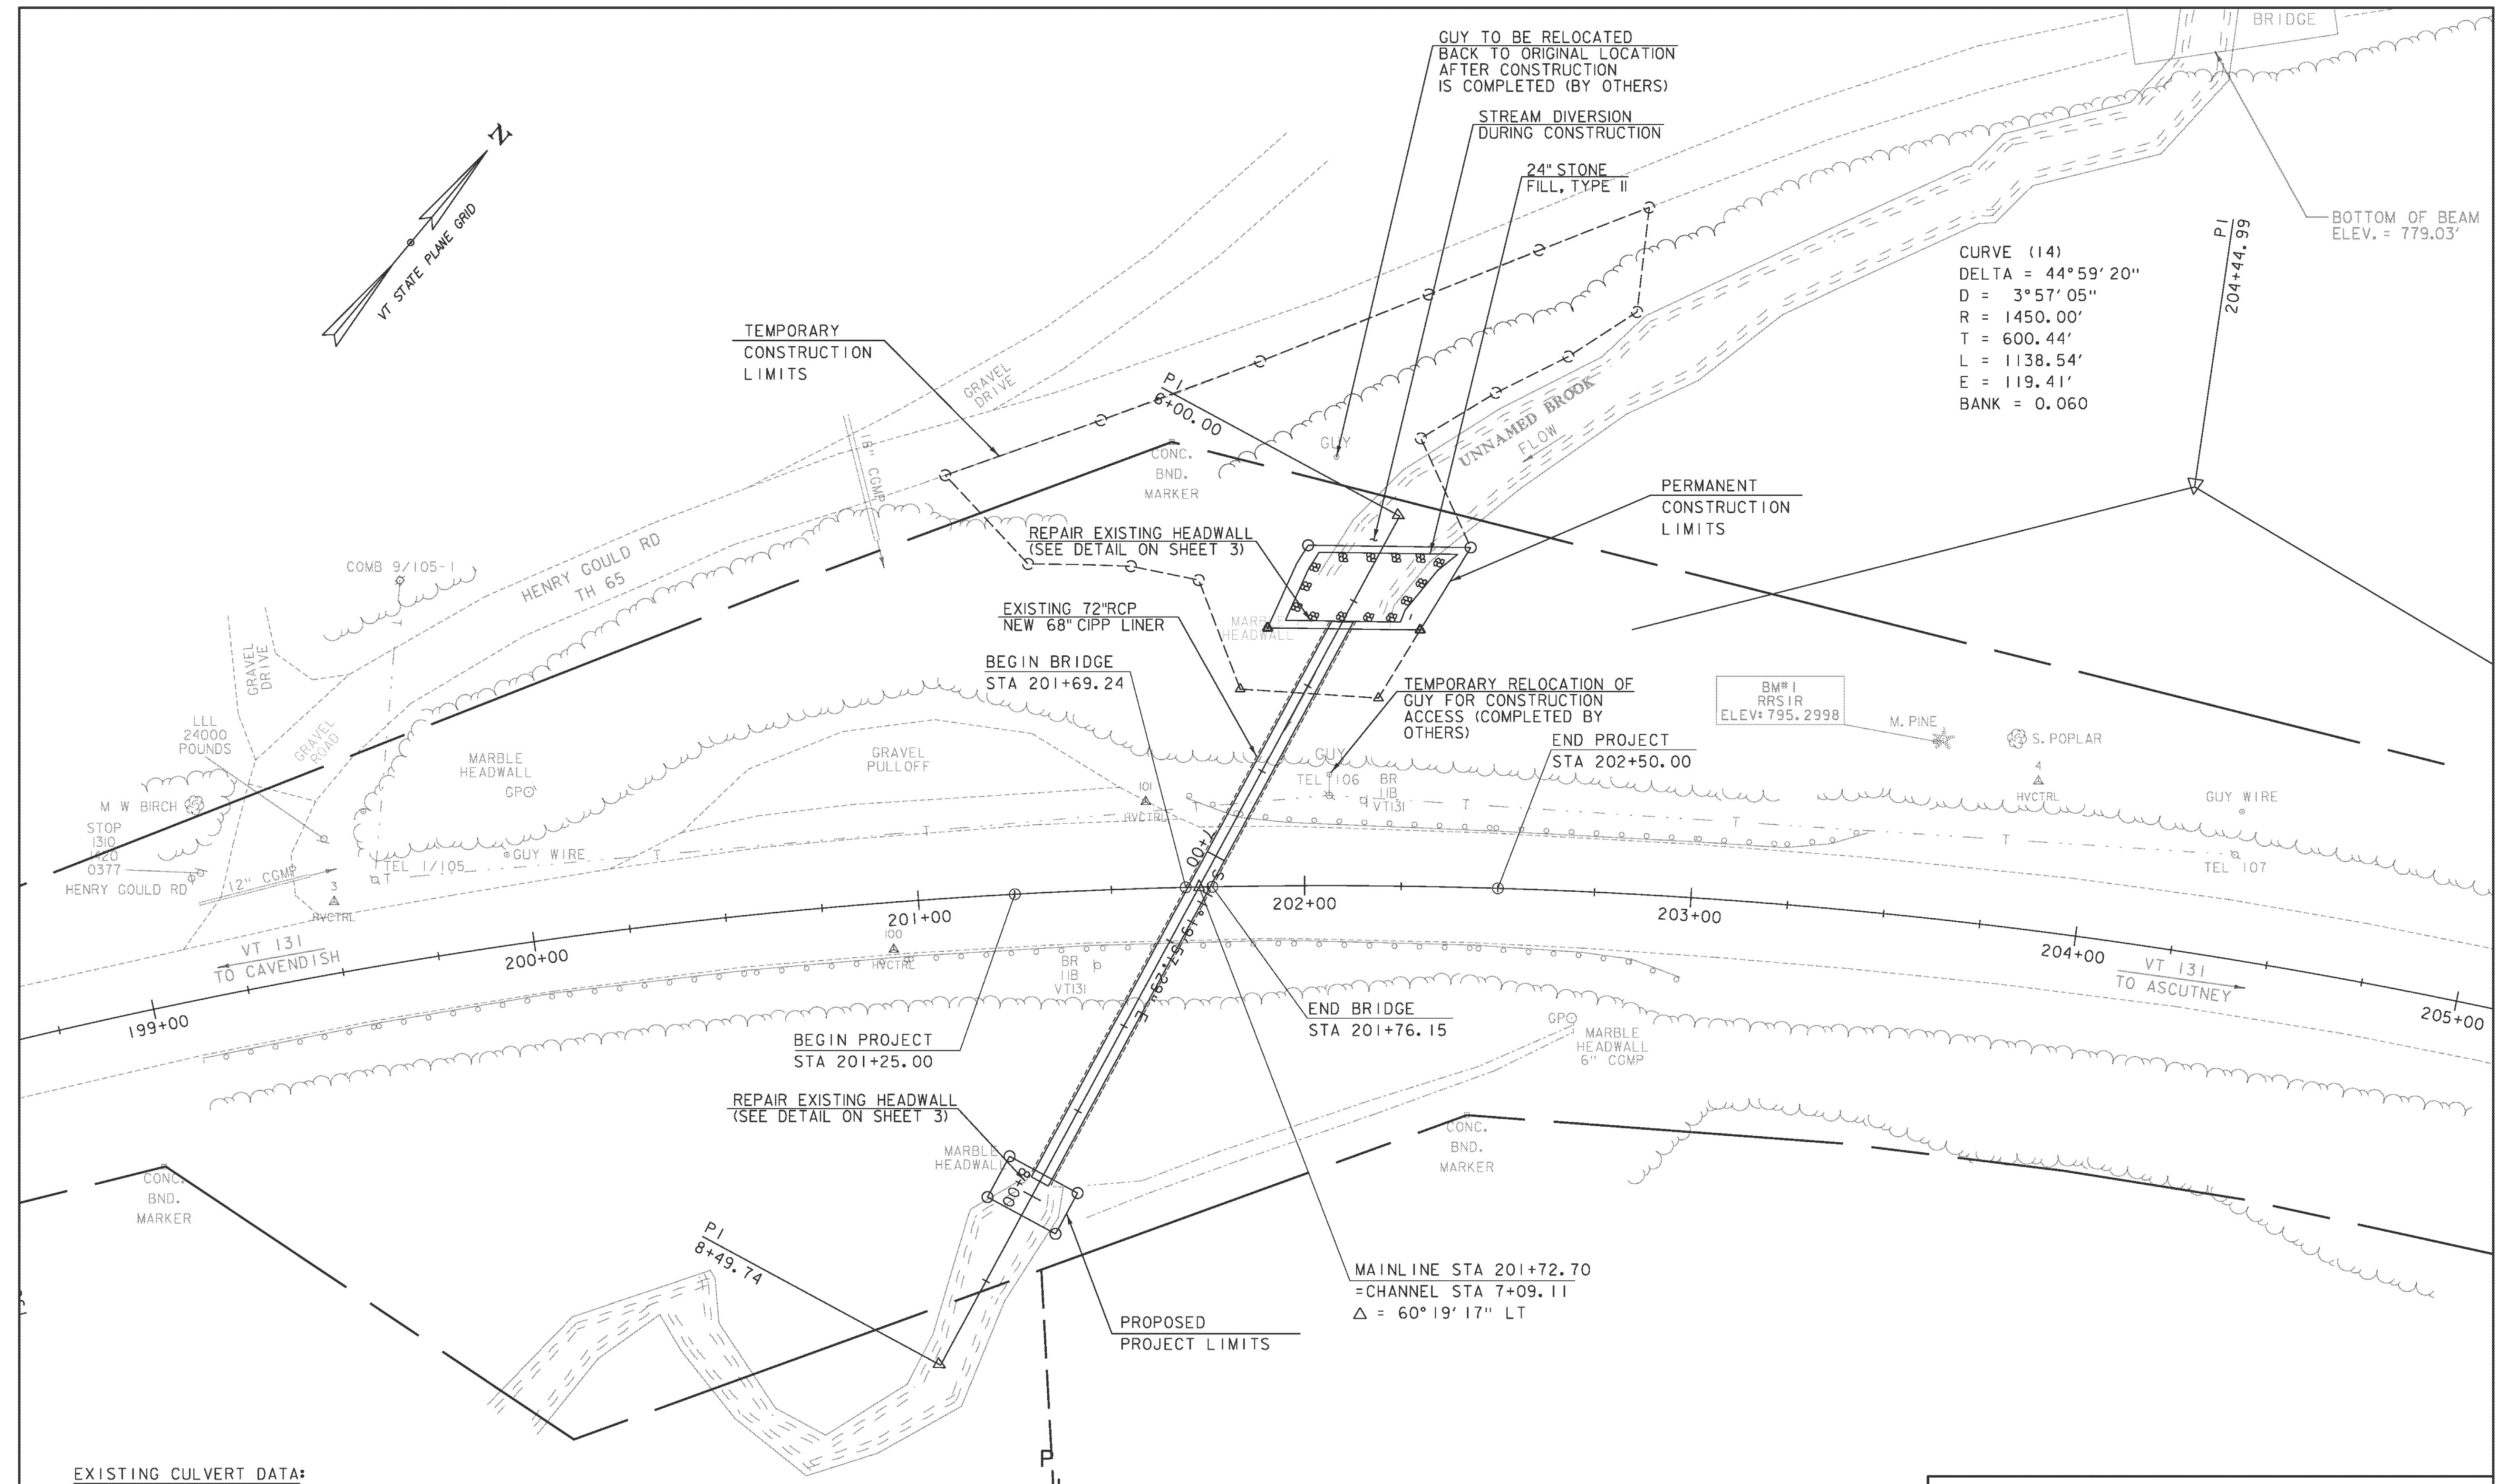

EXISTING CULVERT DATA:  
 72" REINFORCED CONCRETE PIPE  
 APPROXIMATE STRUCTURE LENGTH = 165'  
 BUILT IN 1959

SCALE 1" = 20'-0"  
 20 0 20

**CLD**  
 CONSULTING ENGINEERS  
 640 Commercial Street, Manchester, NH 03101  
 (603) 668-8223 • Fax: (603) 668-8802  
 cld@cldeengineers.com • www.cldeengineers.com  
 Maine • New Hampshire • Vermont

PROJECT NAME: WEATHERSFIELD	PLOT DATE: 4/2/2013
PROJECT NUMBER: STP 0146(II)	DRAWN BY: K.RUTTER
FILE NAME: z00c268-rdy.dgn	CHECKED BY: C.GREGORY
PROJECT LEADER: J. FITCH	SHEET 6 OF 14
DESIGNED BY: K.RUTTER	
LAYOUT SHEET	

MODEL: \$MODEL\$