




6+25

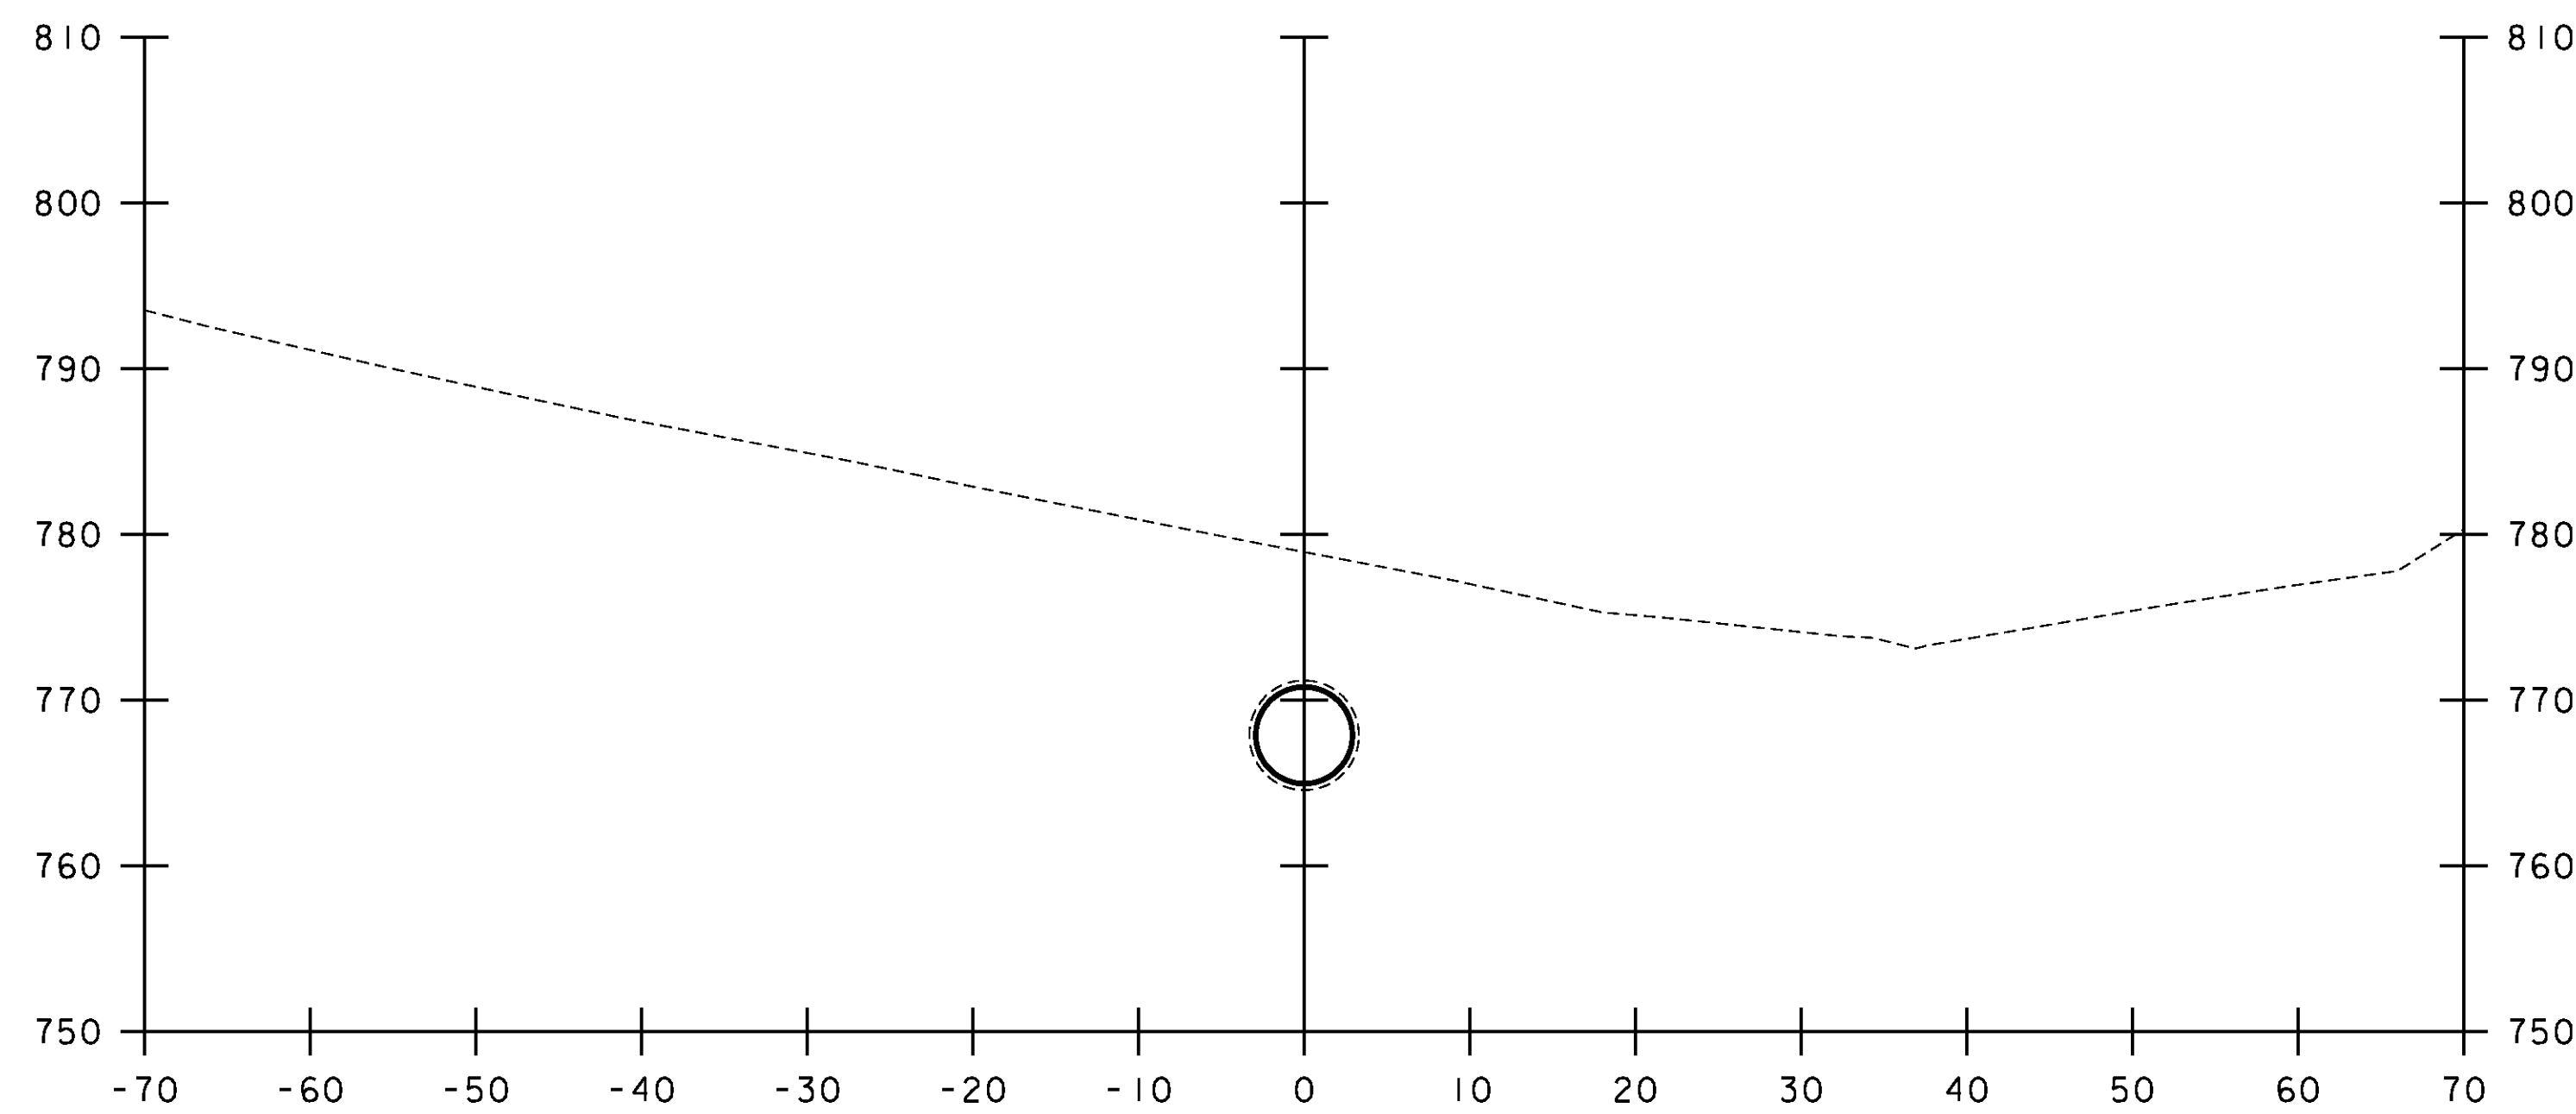

6+50

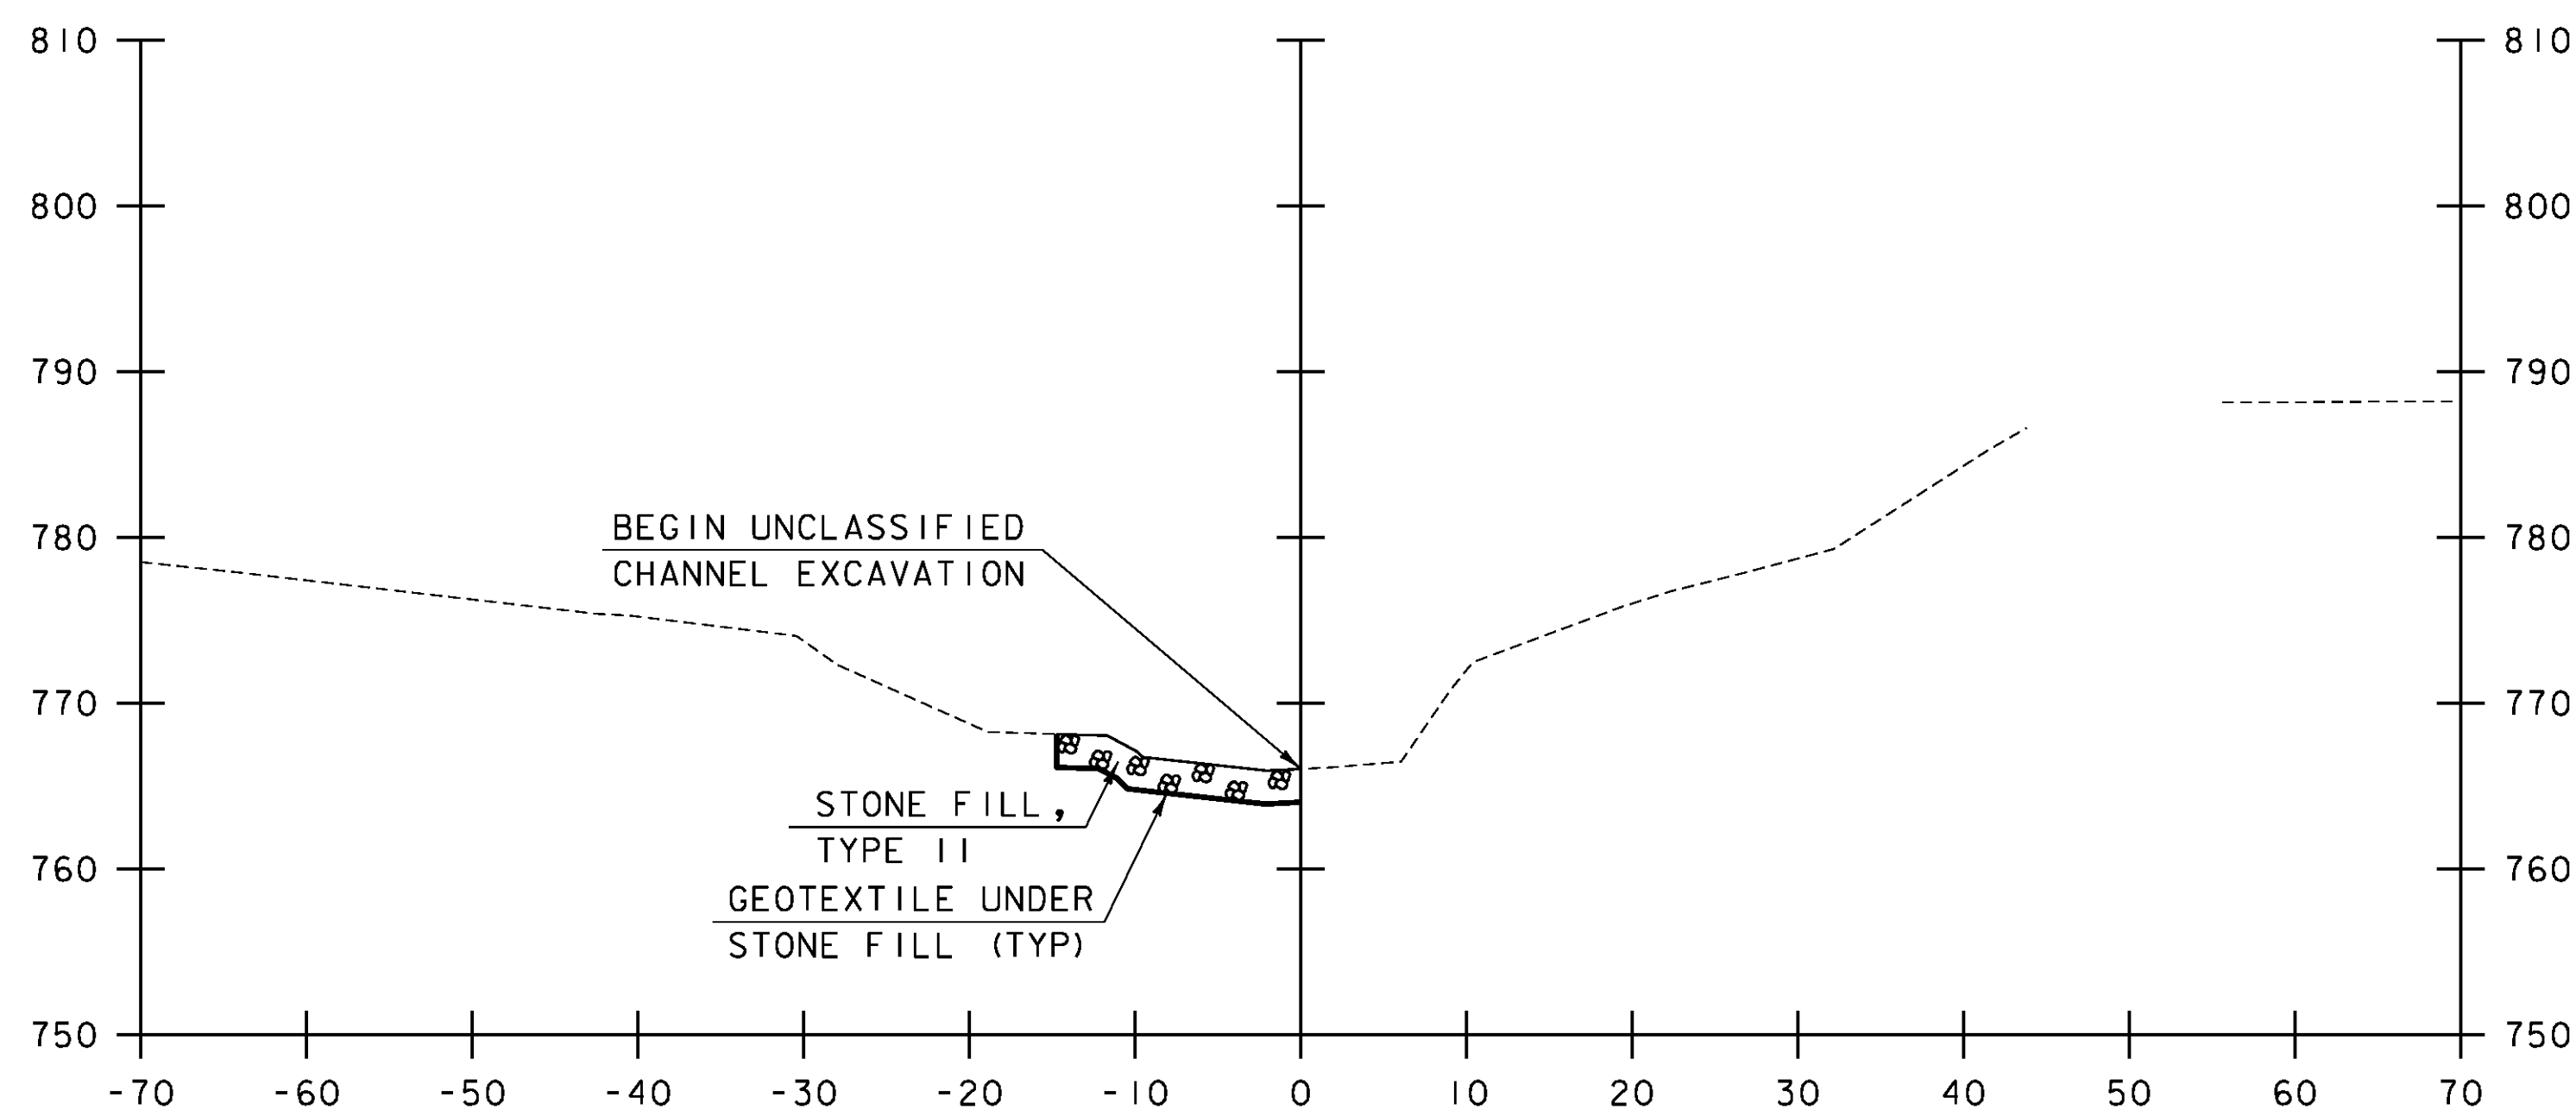

6+10

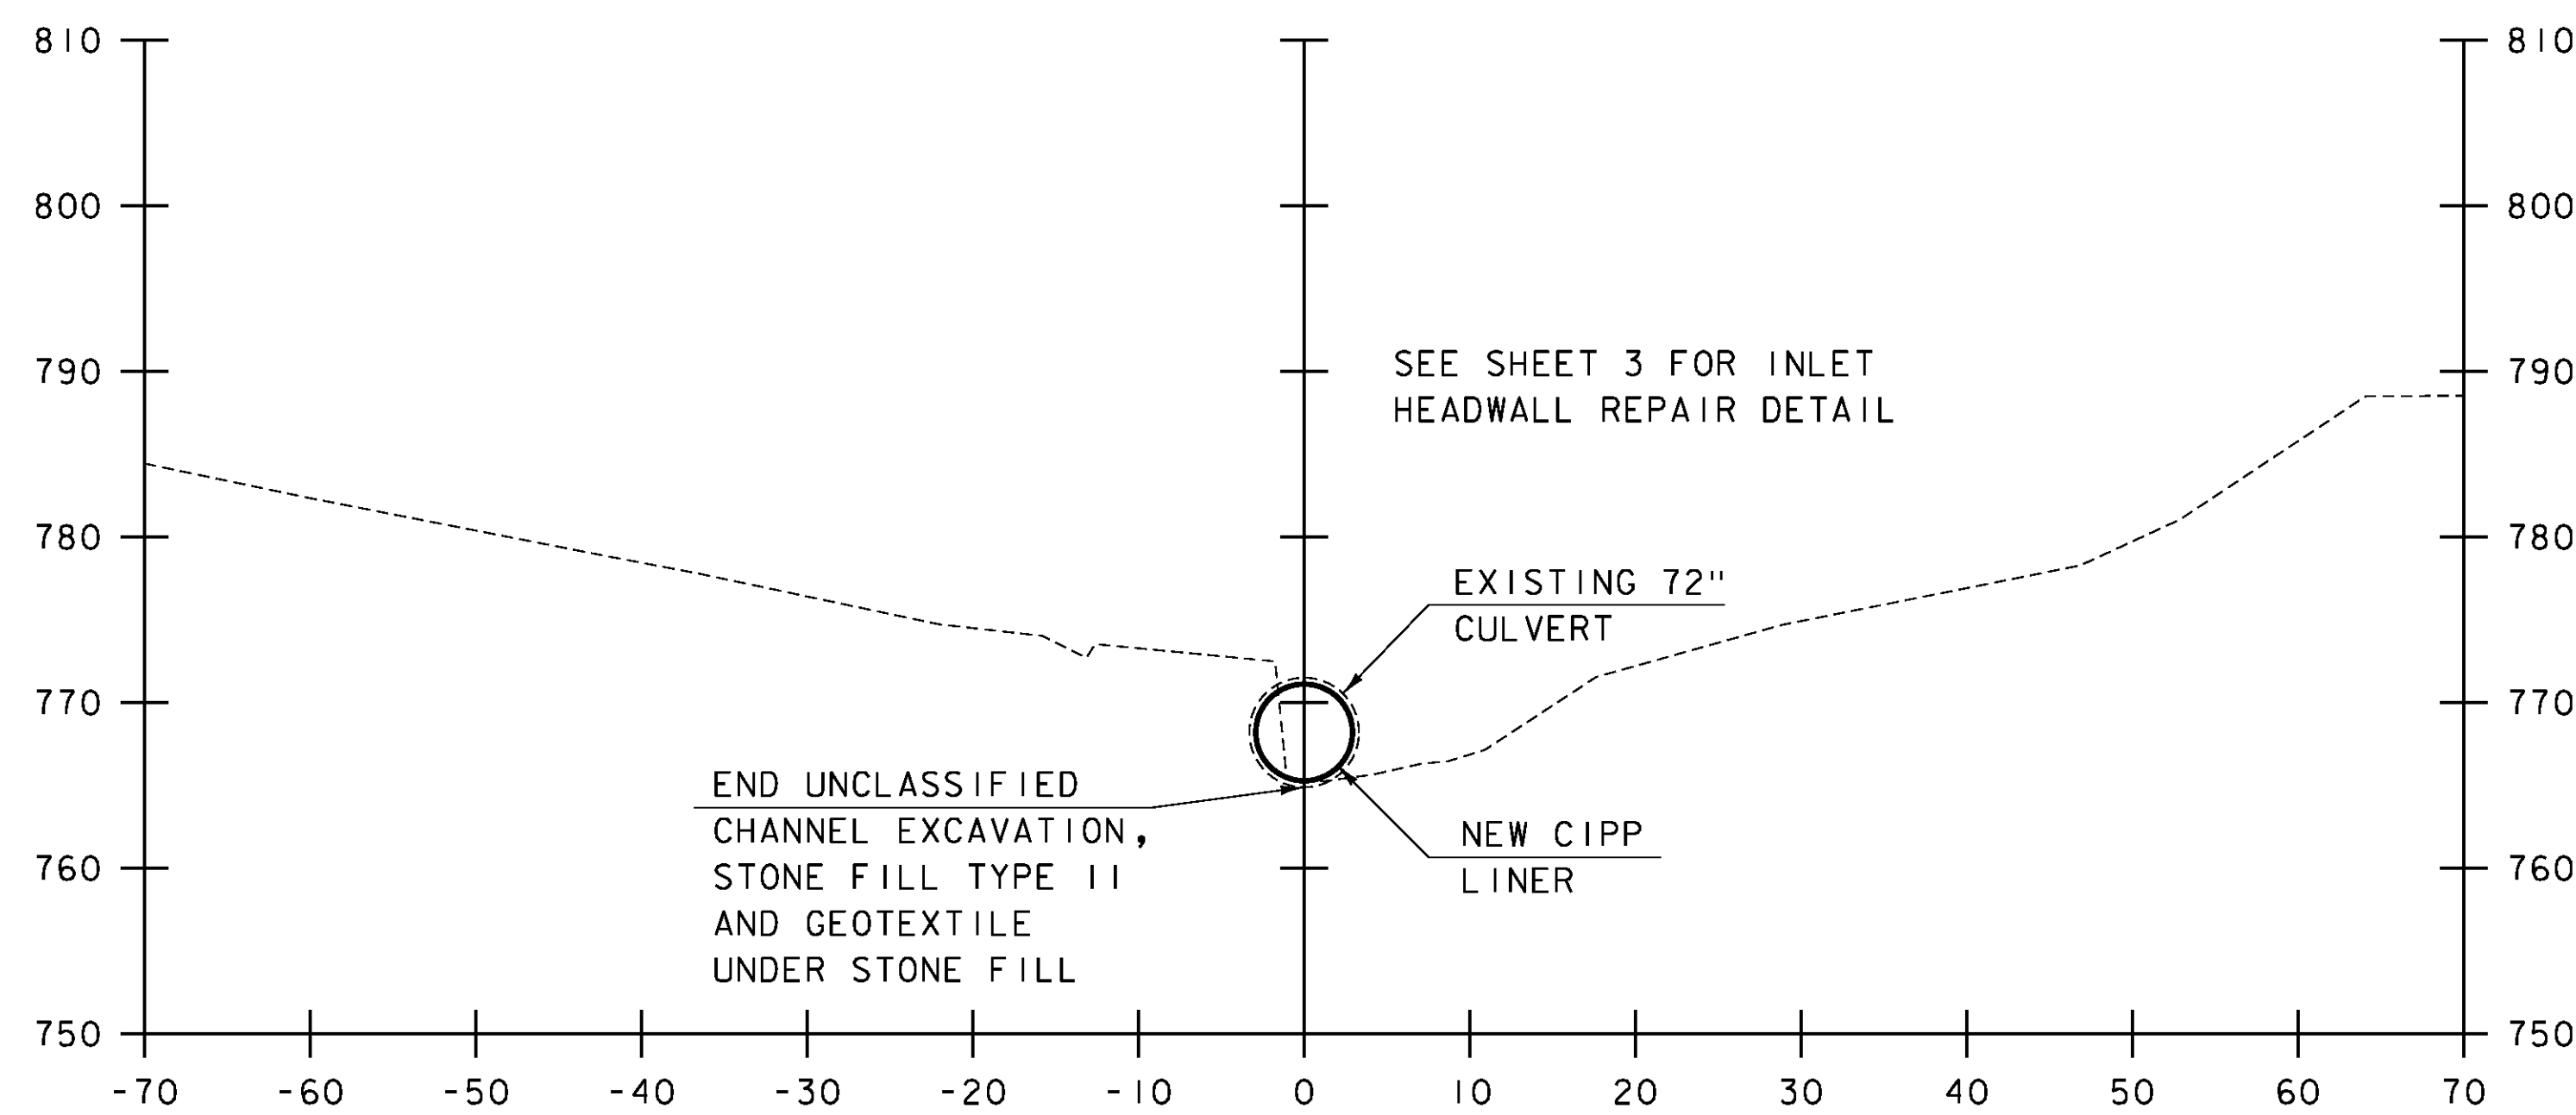

6+30

SCALE 1" = 10'-0"



STA. 6+11 TO STA. 6+50



540 Commercial Street, Manchester, NH 03101
 (603) 668-8223 • Fax: (603) 668-8802
 cld@cdengineers.com • www.cdengineers.com
 Maine • New Hampshire • Vermont

PROJECT NAME: WEATHERSFIELD
 PROJECT NUMBER: STP 0146(II)

FILE NAME: 00c268\s00c268xs.dgn
 PROJECT LEADER: J. FITCH
 DESIGNED BY: K. RUTTER
 CHANNEL CROSS SECTIONS I

PLOT DATE: 4/2/2013
 DRAWN BY: K. RUTTER
 CHECKED BY: C. GREGORY
 SHEET 12 OF 14