




7+00

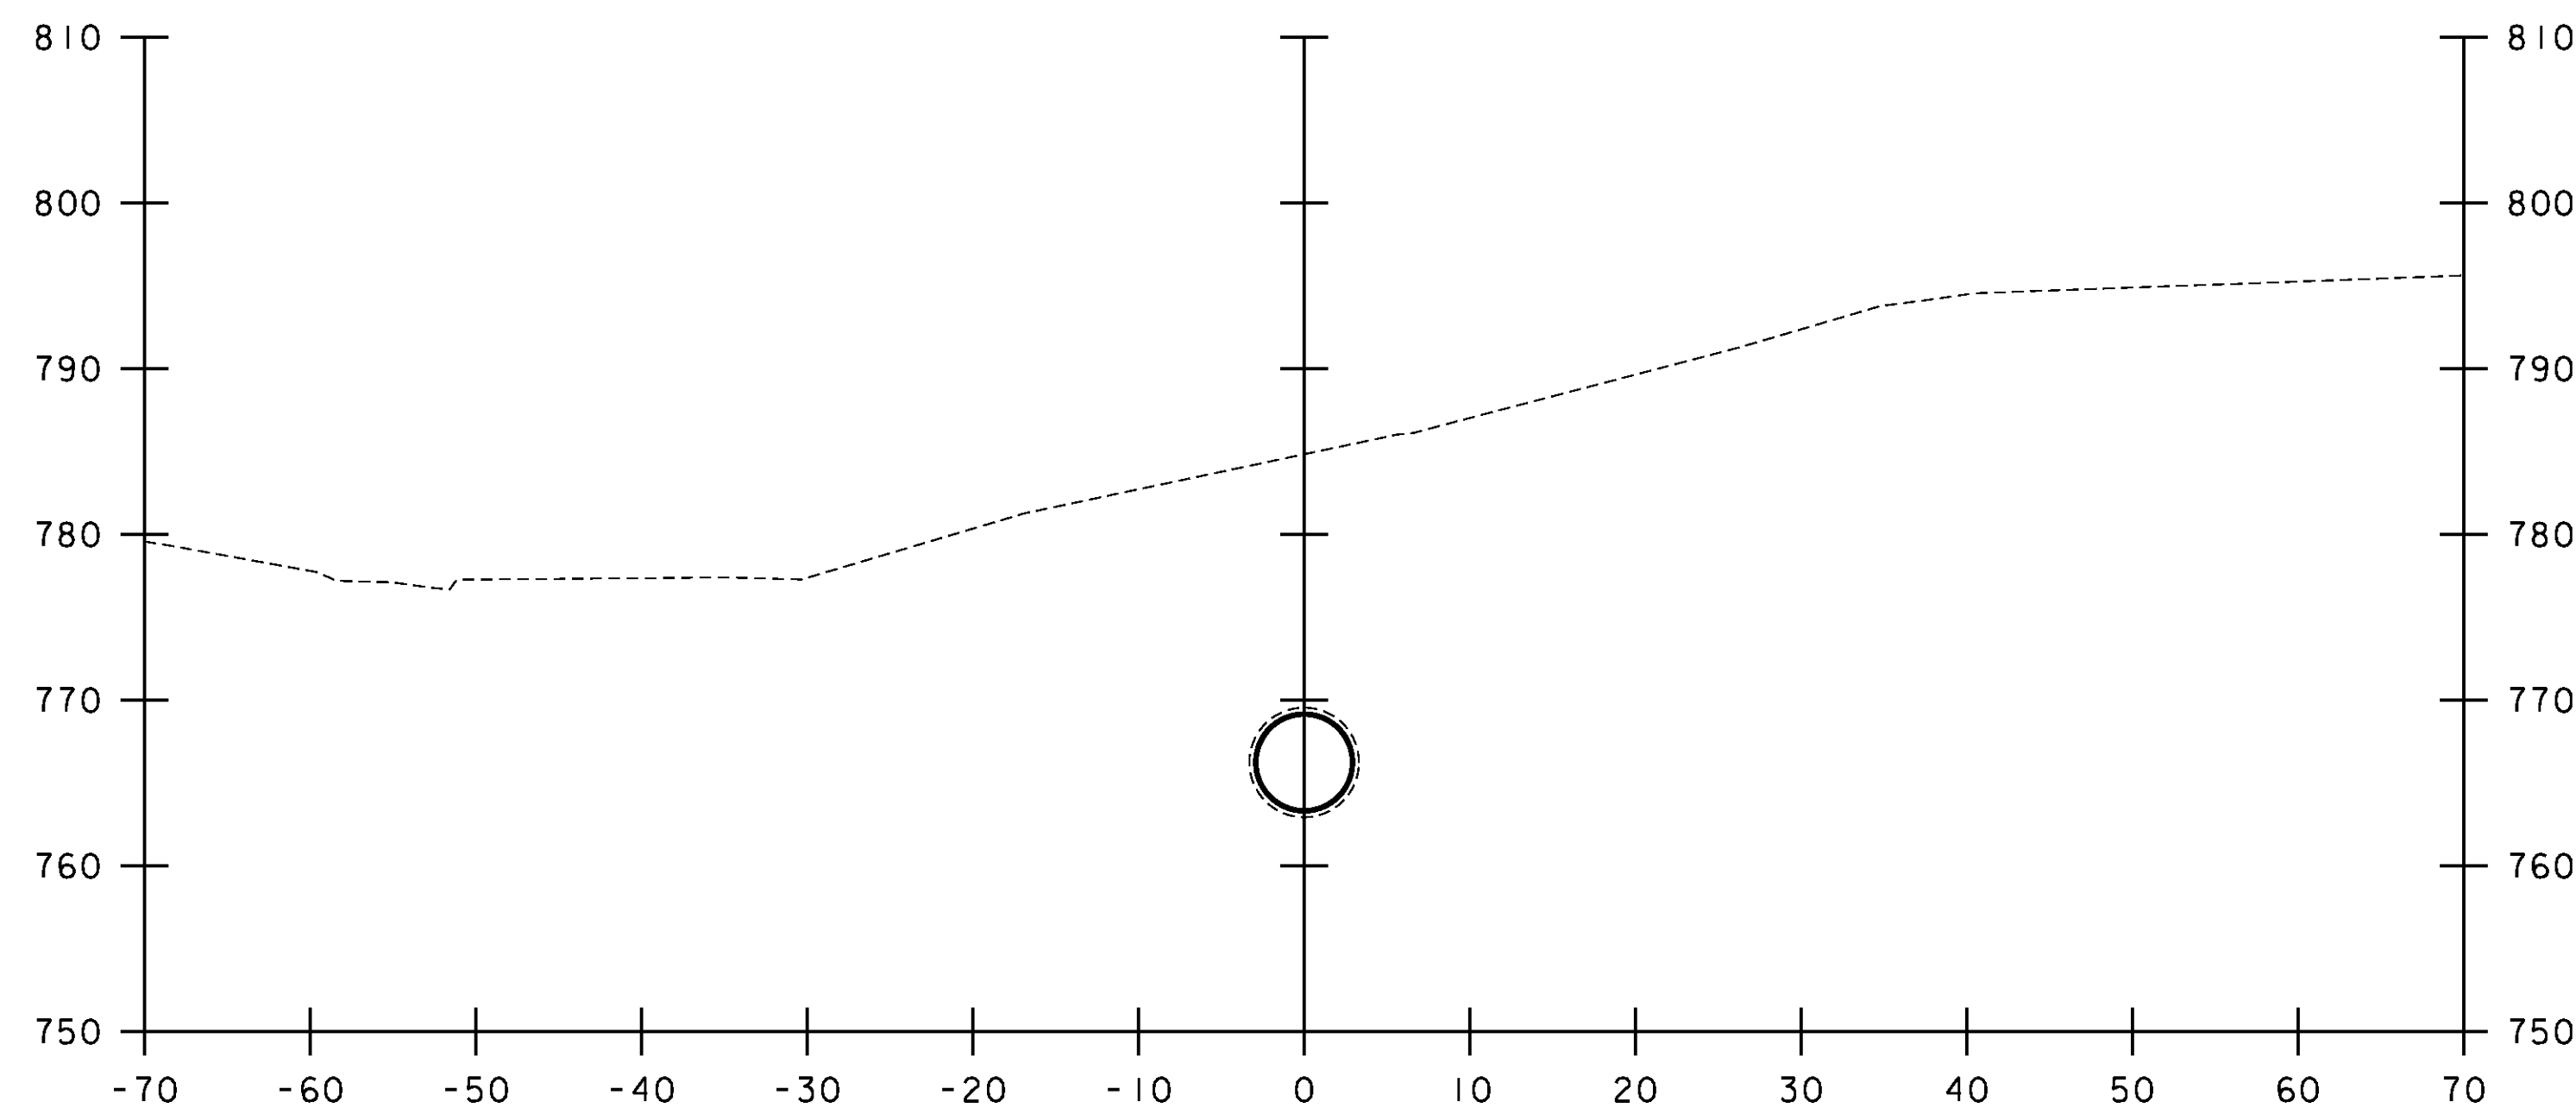

7+50

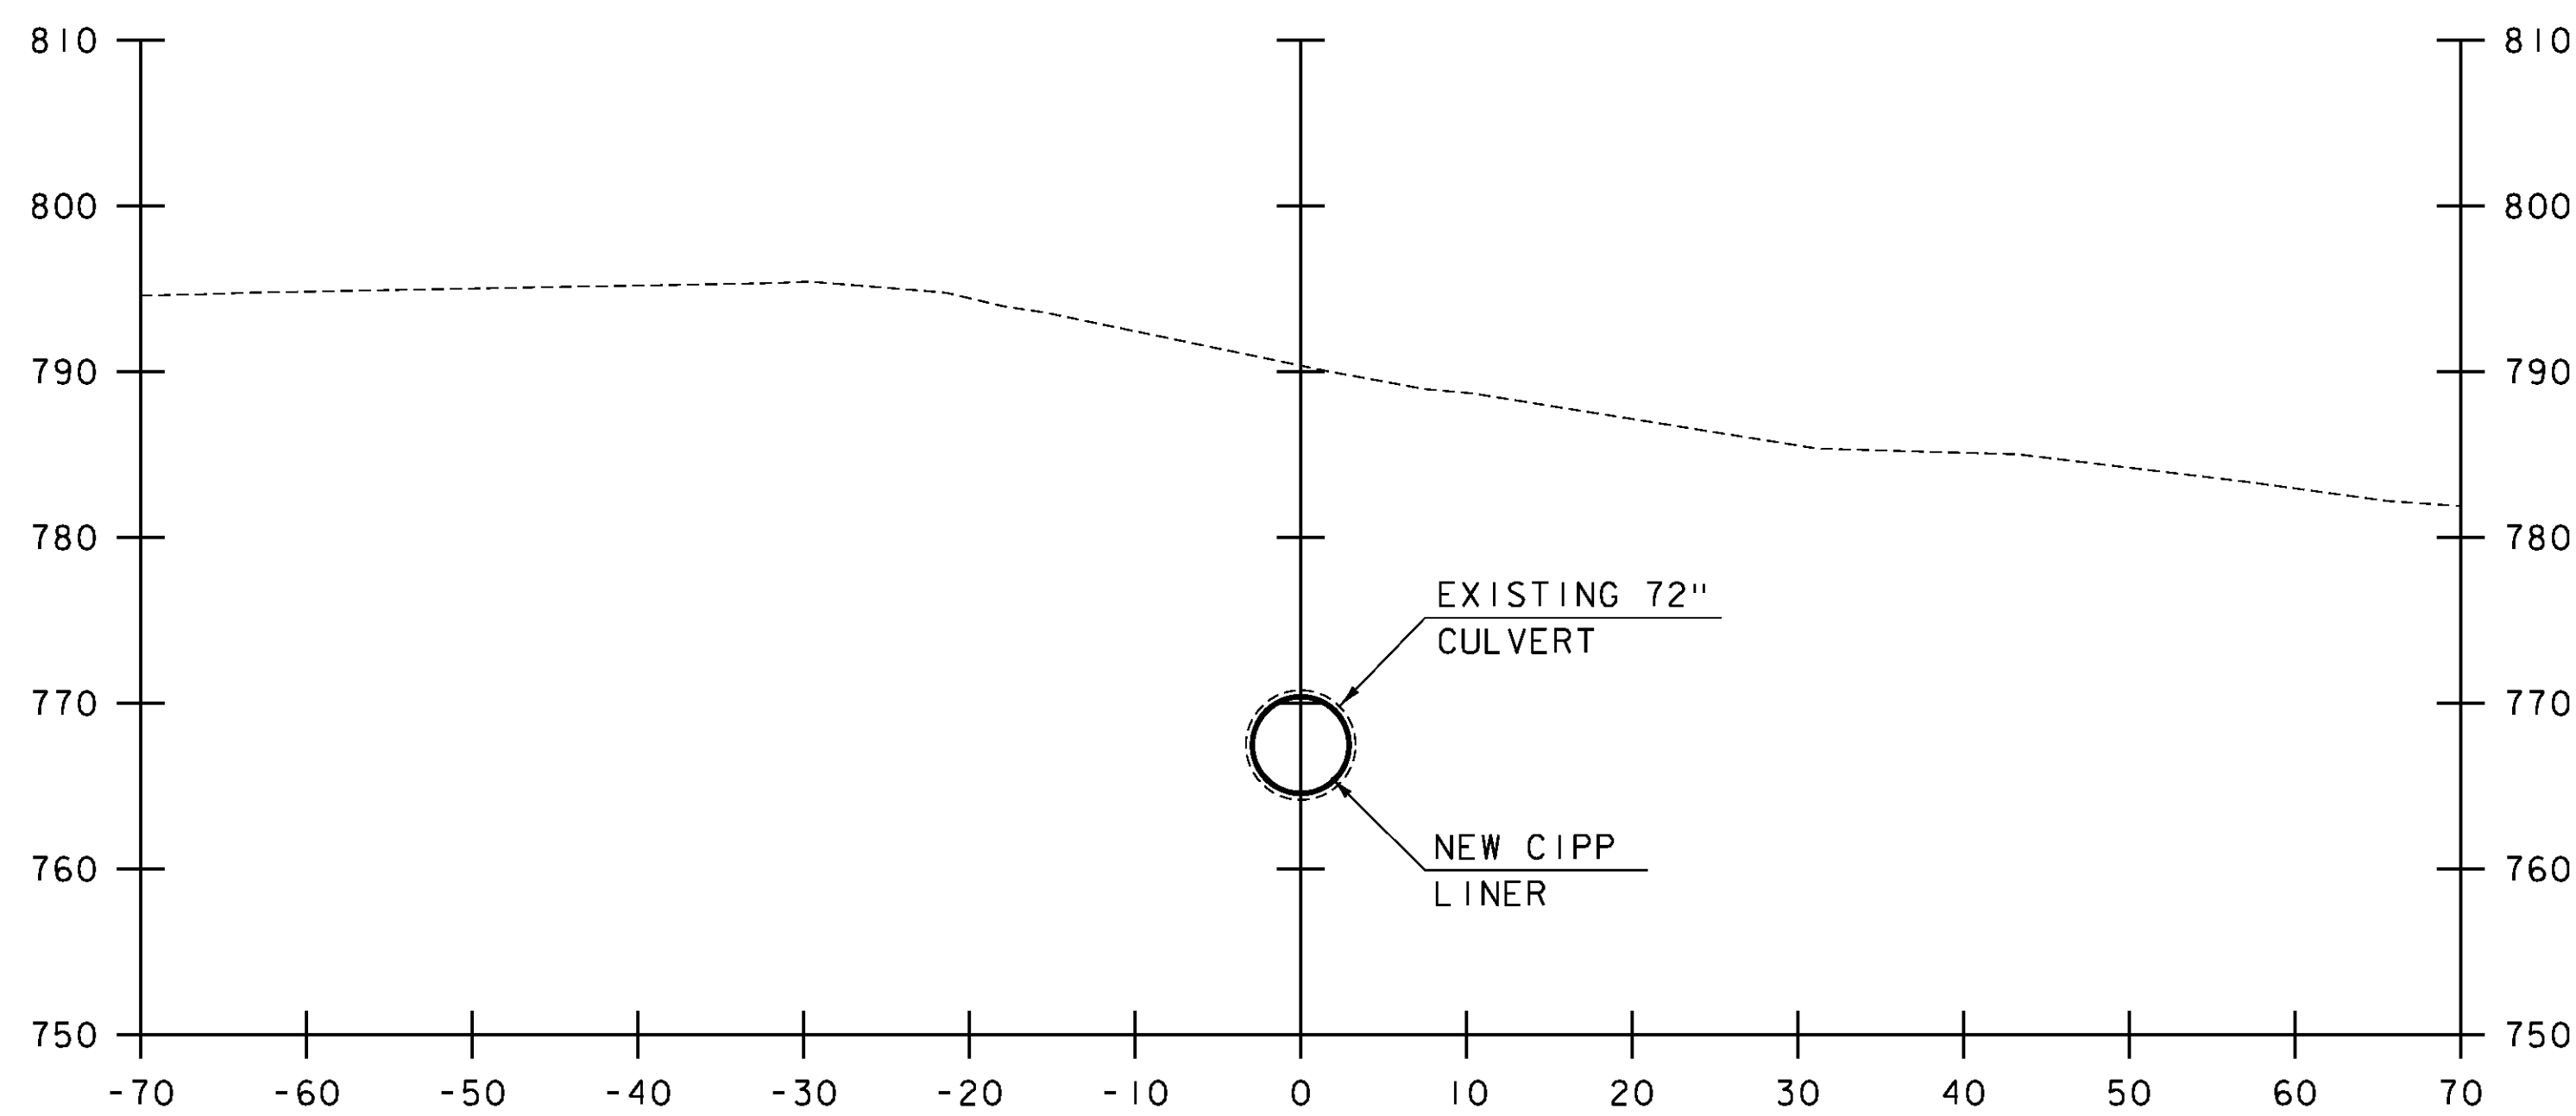


6+75

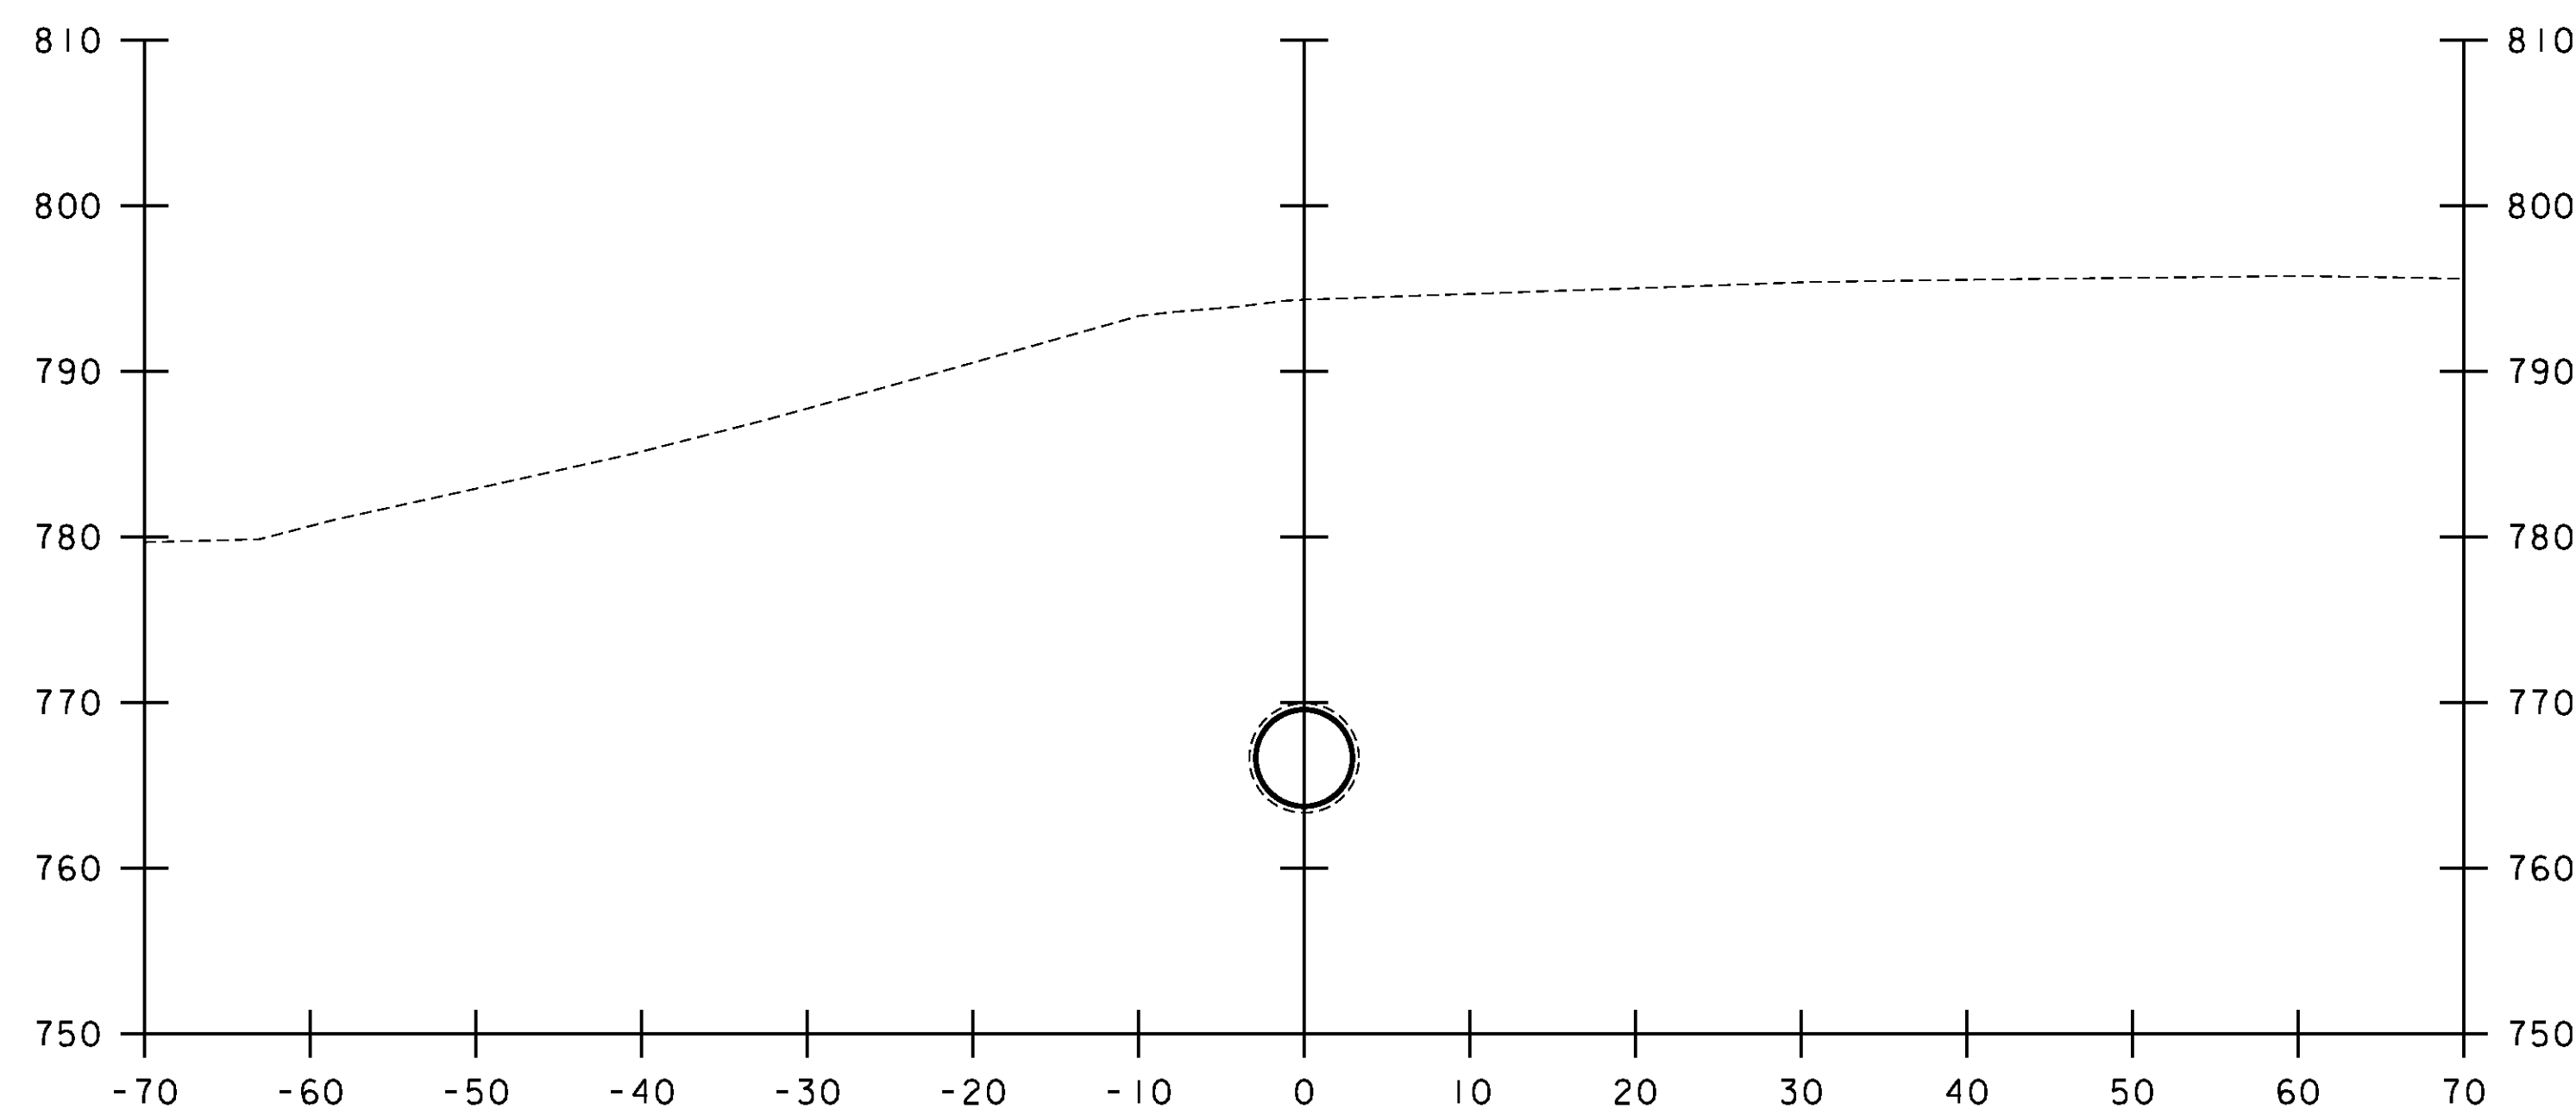

7+25

SCALE 1" = 10'-0"  
10 0 10

STA. 6+75 TO STA. 7+50

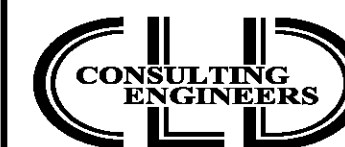

540 Commercial Street, Manchester, NH 03101  
(603) 668-8223 • Fax: (603) 668-8802  
cld@cldeengineers.com • www.cldeengineers.com  
Maine • New Hampshire • Vermont

PROJECT NAME: WEATHERSFIELD  
PROJECT NUMBER: STP 0146(II)

FILE NAME: 00c268\s00c268xs.dgn  
PROJECT LEADER: J. FITCH  
DESIGNED BY: K. RUTTER  
CHANNEL CROSS SECTIONS 2

PLOT DATE: 4/2/2013  
DRAWN BY: K. RUTTER  
CHECKED BY: C. GREGORY  
SHEET 13 OF 14