




7+96

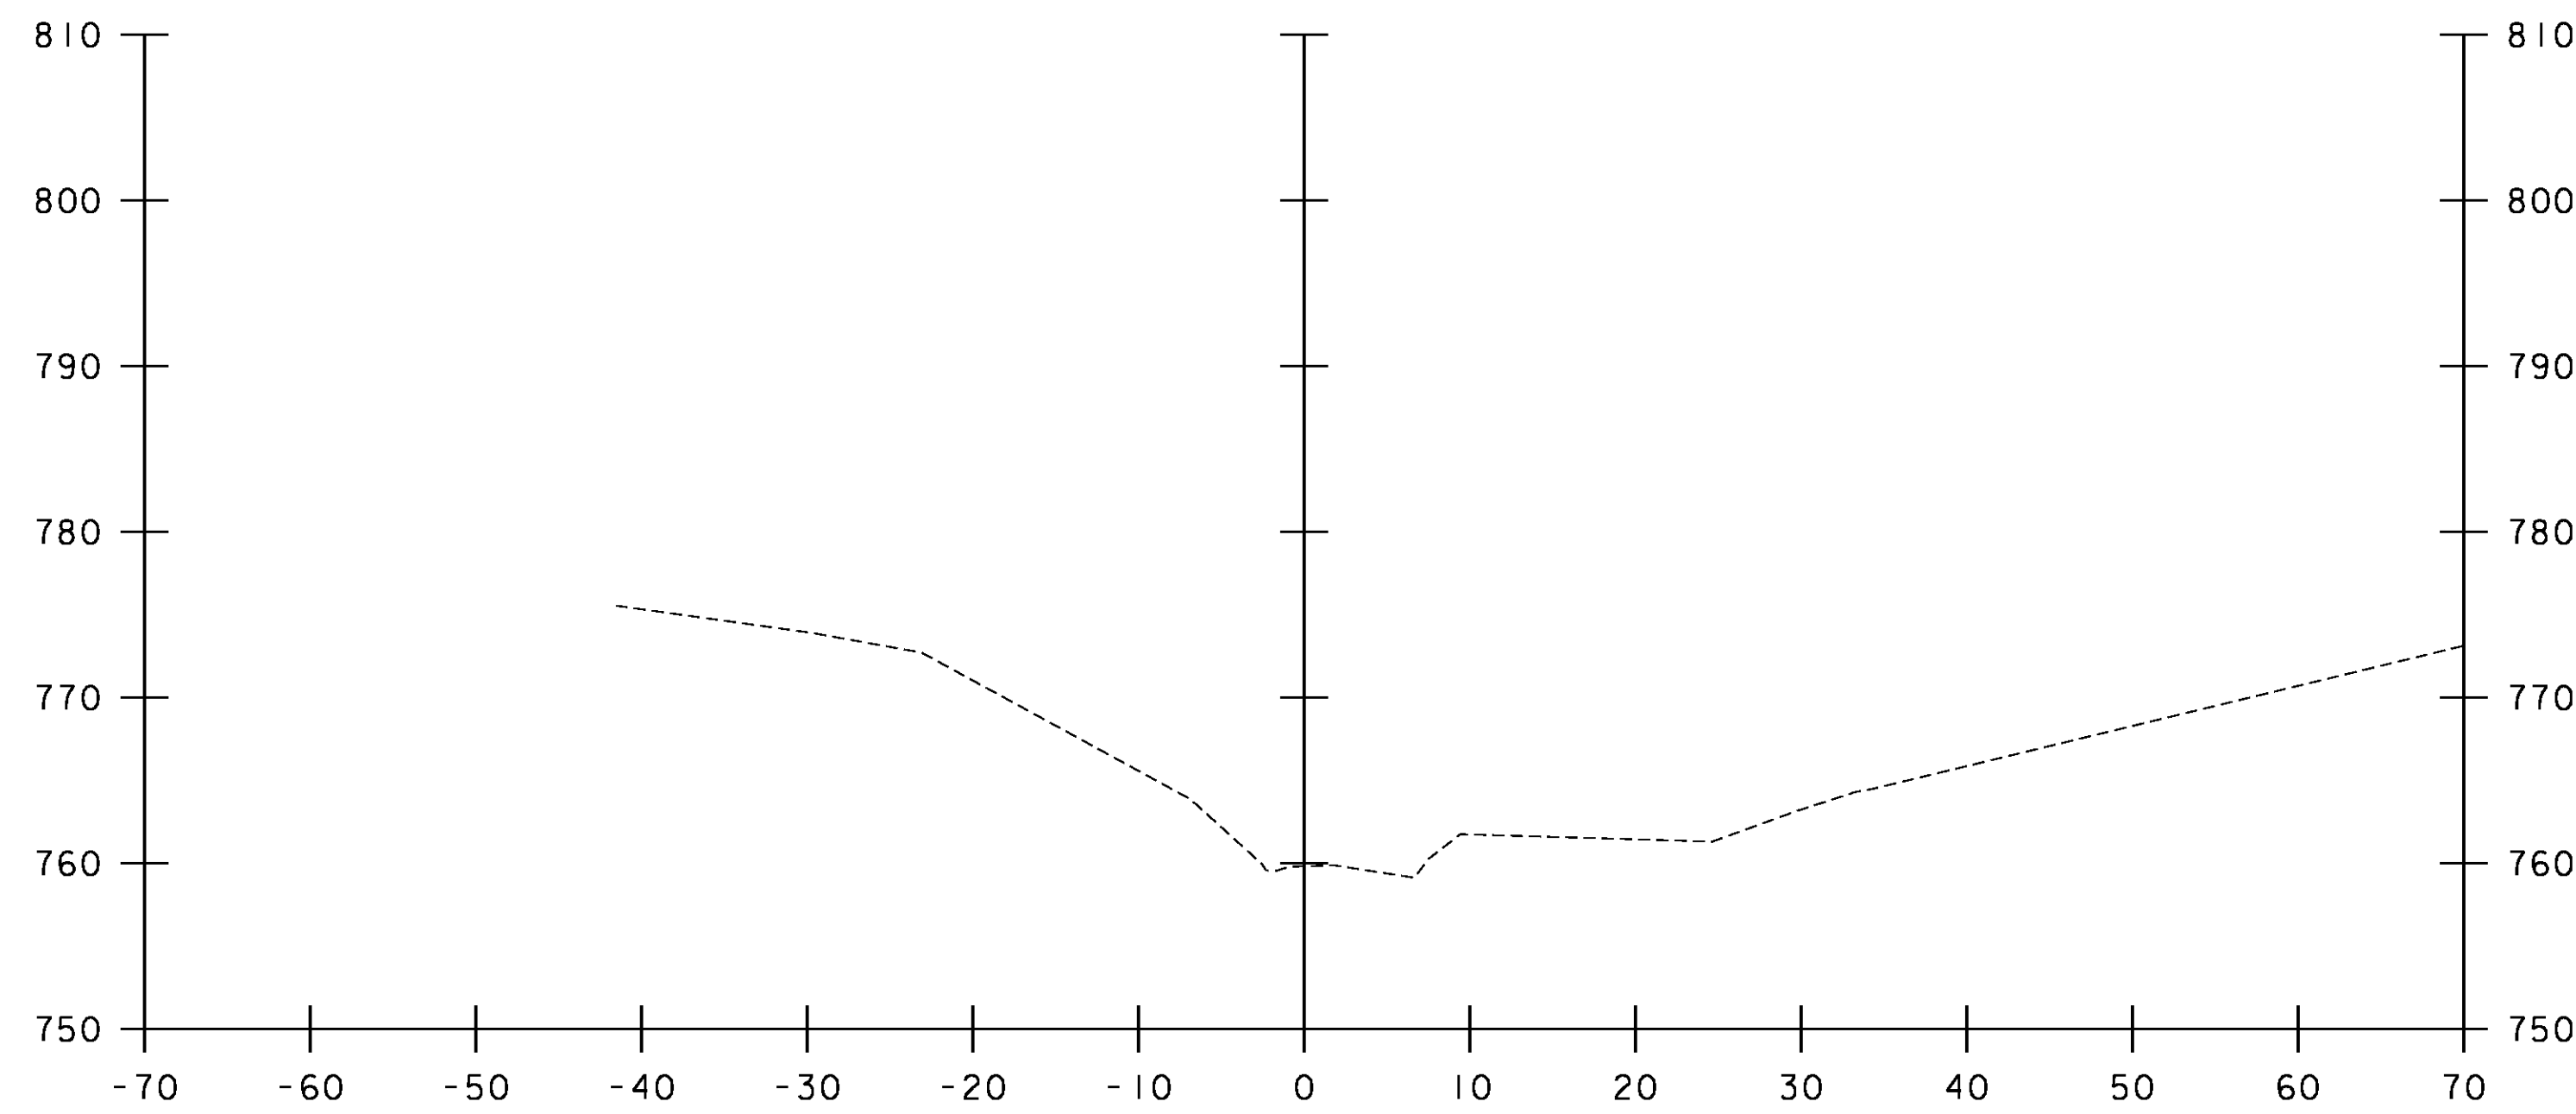

8+25

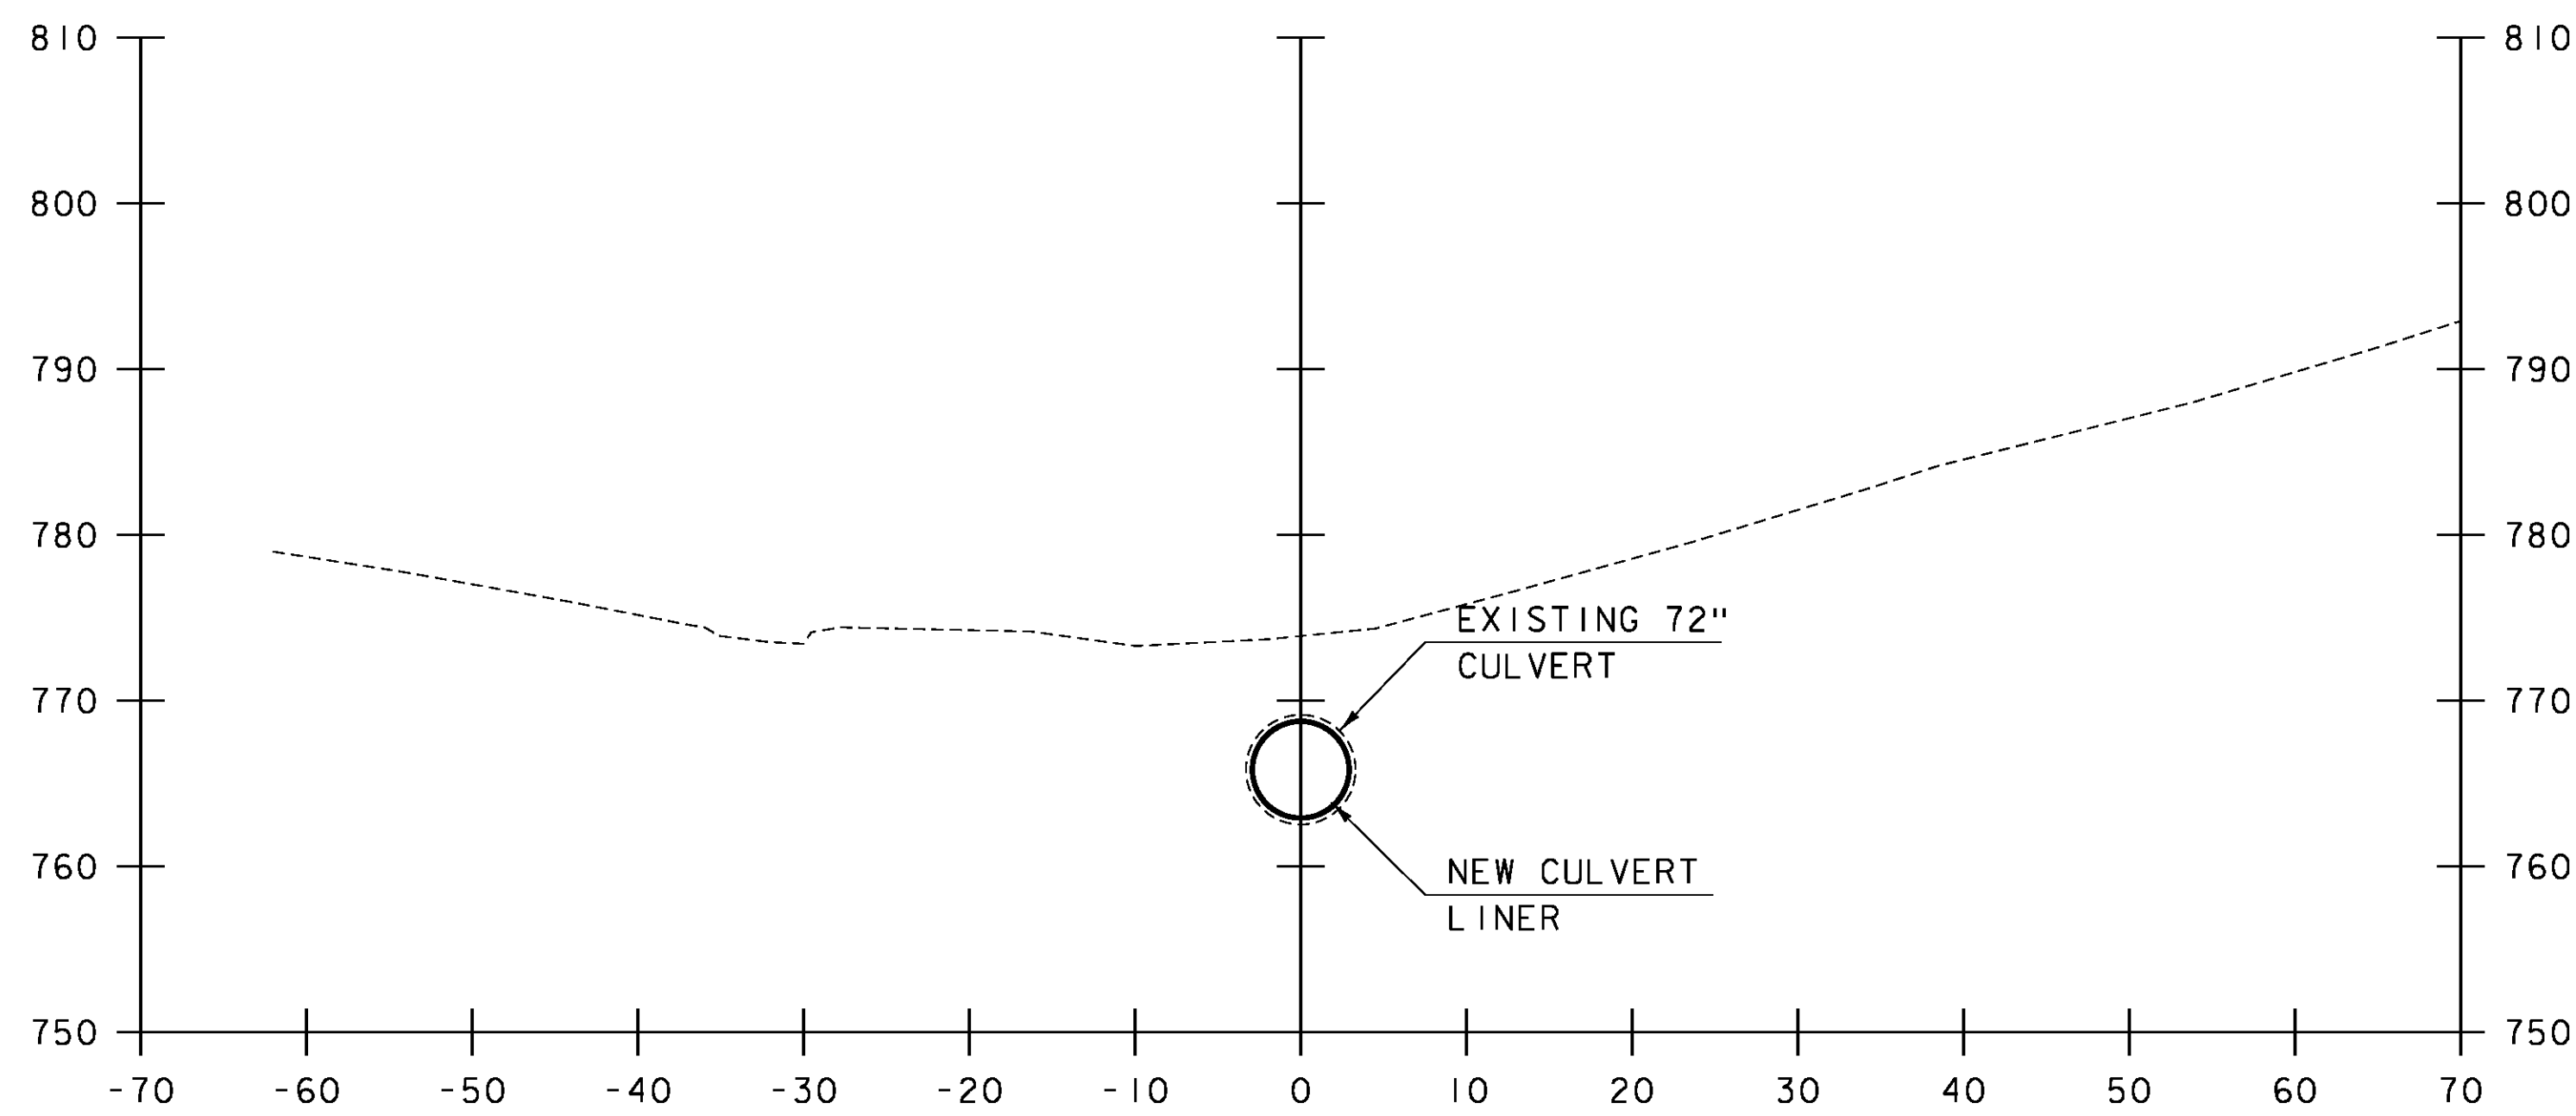

7+75

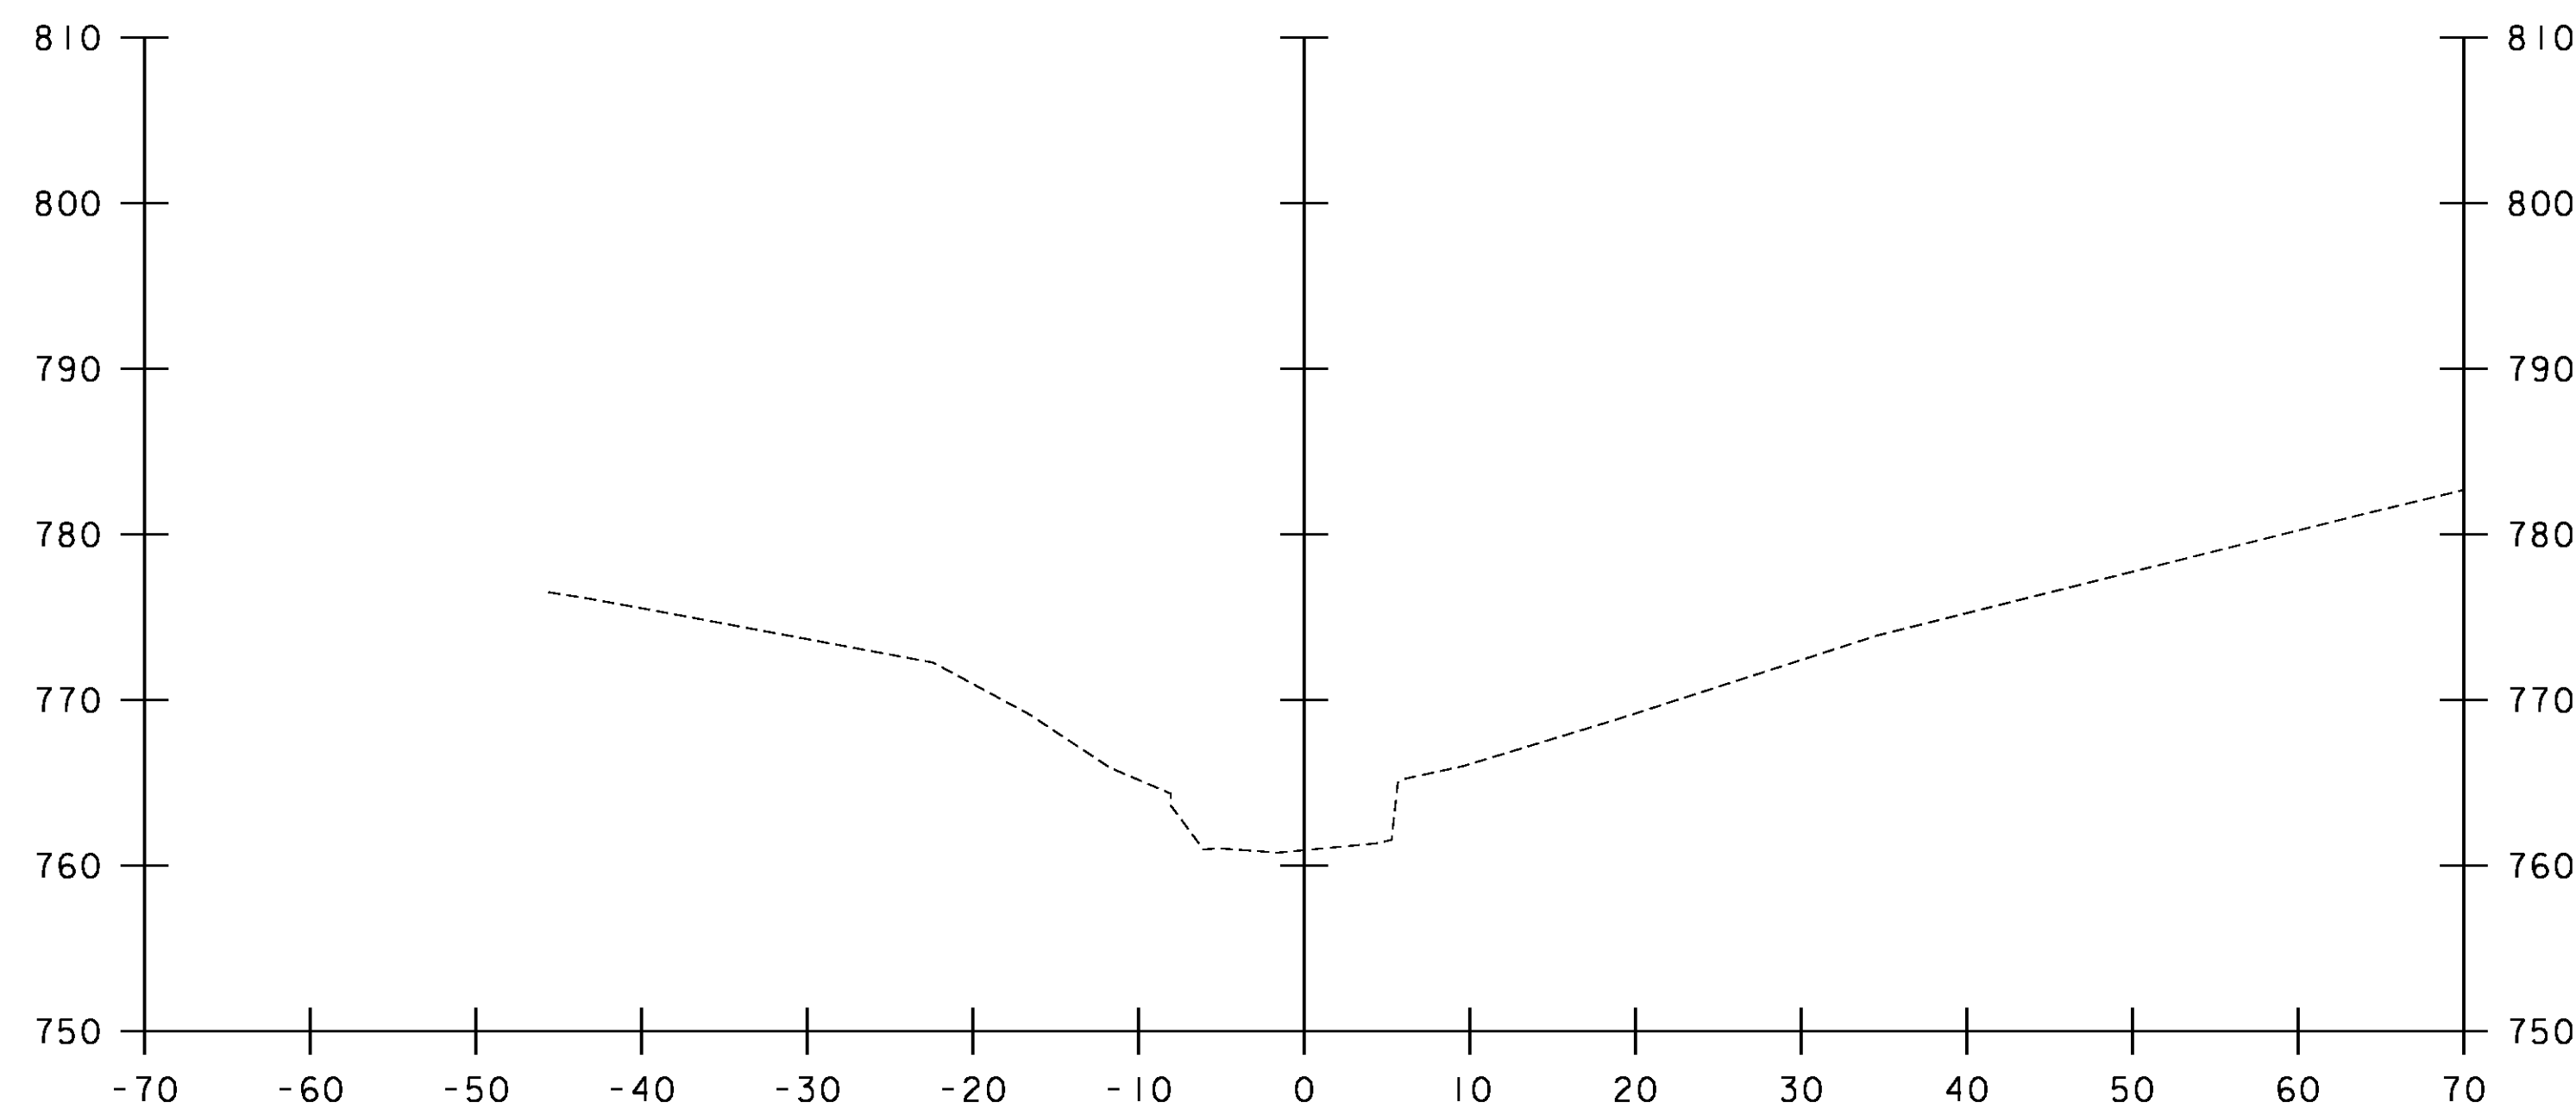

8+00

SCALE 1" = 10' - 0"

STA. 7+75 TO STA. 8+25



540 Commercial Street, Manchester, NH 03101  
 (603) 868-8223 • Fax: (603) 868-8802  
 cld@cldeengineers.com • www.cldeengineers.com  
 Maine • New Hampshire • Vermont

PROJECT NAME: WEATHERSFIELD  
 PROJECT NUMBER: STP 0146(II)

FILE NAME: 00c268\s00c268xs.dgn  
 PROJECT LEADER: J. FITCH  
 DESIGNED BY: K. RUTTER  
 CHANNEL CROSS SECTIONS 3

PLOT DATE: 4/2/2013  
 DRAWN BY: K. RUTTER  
 CHECKED BY: C. GREGORY  
 SHEET 14 OF 14