


DATUM
 VERTICAL NAVD 88
 HORIZONTAL NAD 83 (1996)
VT SPC (FEET)

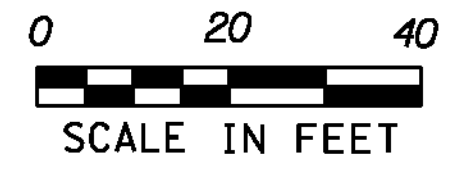

PROJECT NAME: ENOSBURG
 PROJECT NUMBER: CMG PARK(20)
 FILE NAME: ...\\PlotFiles\I\gradingplan.plt PLOT DATE: 5/23/2011
 PROJECT LEADER: WLD DRAWN BY: STANTEC
 DESIGNED BY: CSP/GGG CHECKED BY: GAS
GRADING PLAN SHEET 10 OF 32