


13+50  
END PARK-AND-RIDE

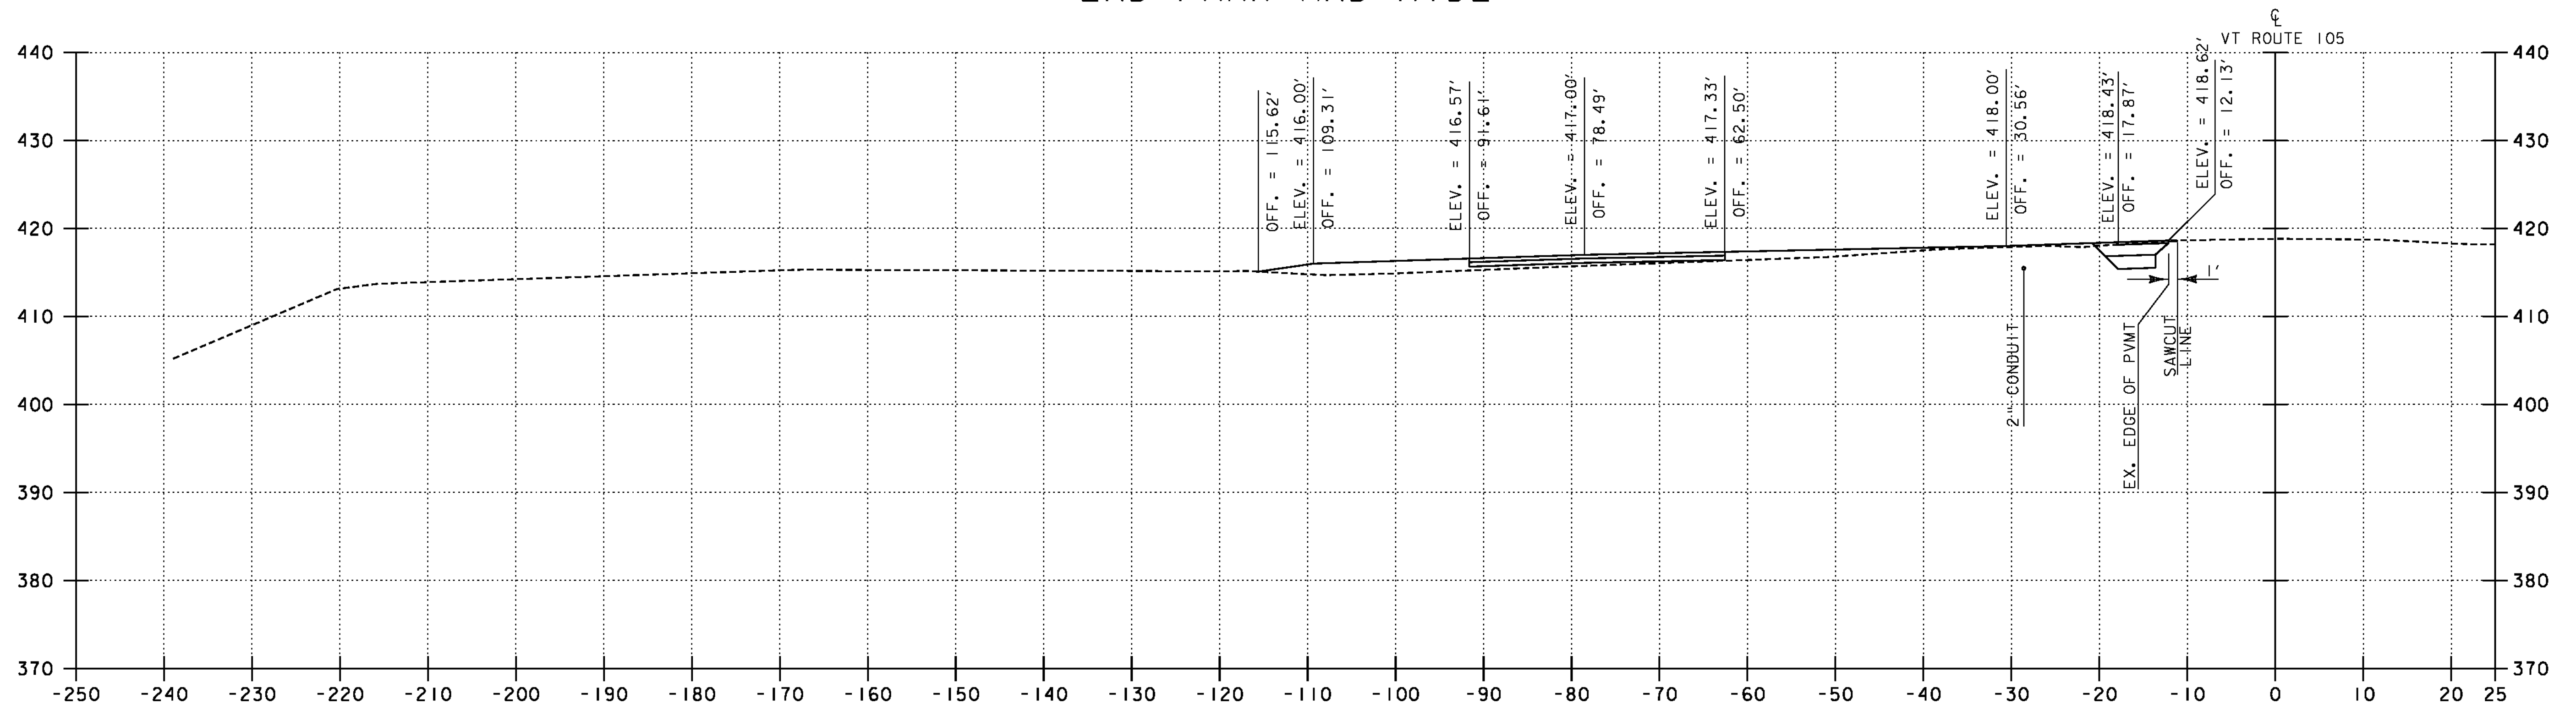

13+00

STA 13+00 TO 13+50

PROJECT NAME:	ENOSBURG
PROJECT NUMBER:	CMG PARK(20)
FILE NAME: ... \PlotFiles\32sections4.ptf	PLOT DATE: 5/23/2011
PROJECT LEADER: WLD	DRAWN BY: KJR
DESIGNED BY: GGG	CHECKED BY: GAS
<b>CROSS SECTIONS 4</b>	SHEET 32 OF 32

