

TYPICAL SECTIONS

MATERIAL ITEM THICKNESS / TOLERANCE


BITUMINOUS CONCRETE PAVEMENT	+/- 1/4" (TOTAL DEPTH)
SUBBASE OF DENSE GRADED CRUSHED STONE	+/- 1"
SAND BORROW	+/- 1"

SEEDING FORMULA - RURAL AREAS

SEE LANDSCAPING DETAILS (SHEET 52 OF 63)

ALTERNATE A:

- 1 3/4" BITUMINOUS CONCRETE PAVEMENT (1 LIFT - TYPE III)
- 1 3/4" BITUMINOUS CONCRETE PAVEMENT (1 LIFT - TYPE III)
- 15" SUBBASE OF DENSE GRADED CRUSHED STONE
- 20" SAND BORROW
- GEOTEXTILE FOR ROADBED SEPARATOR

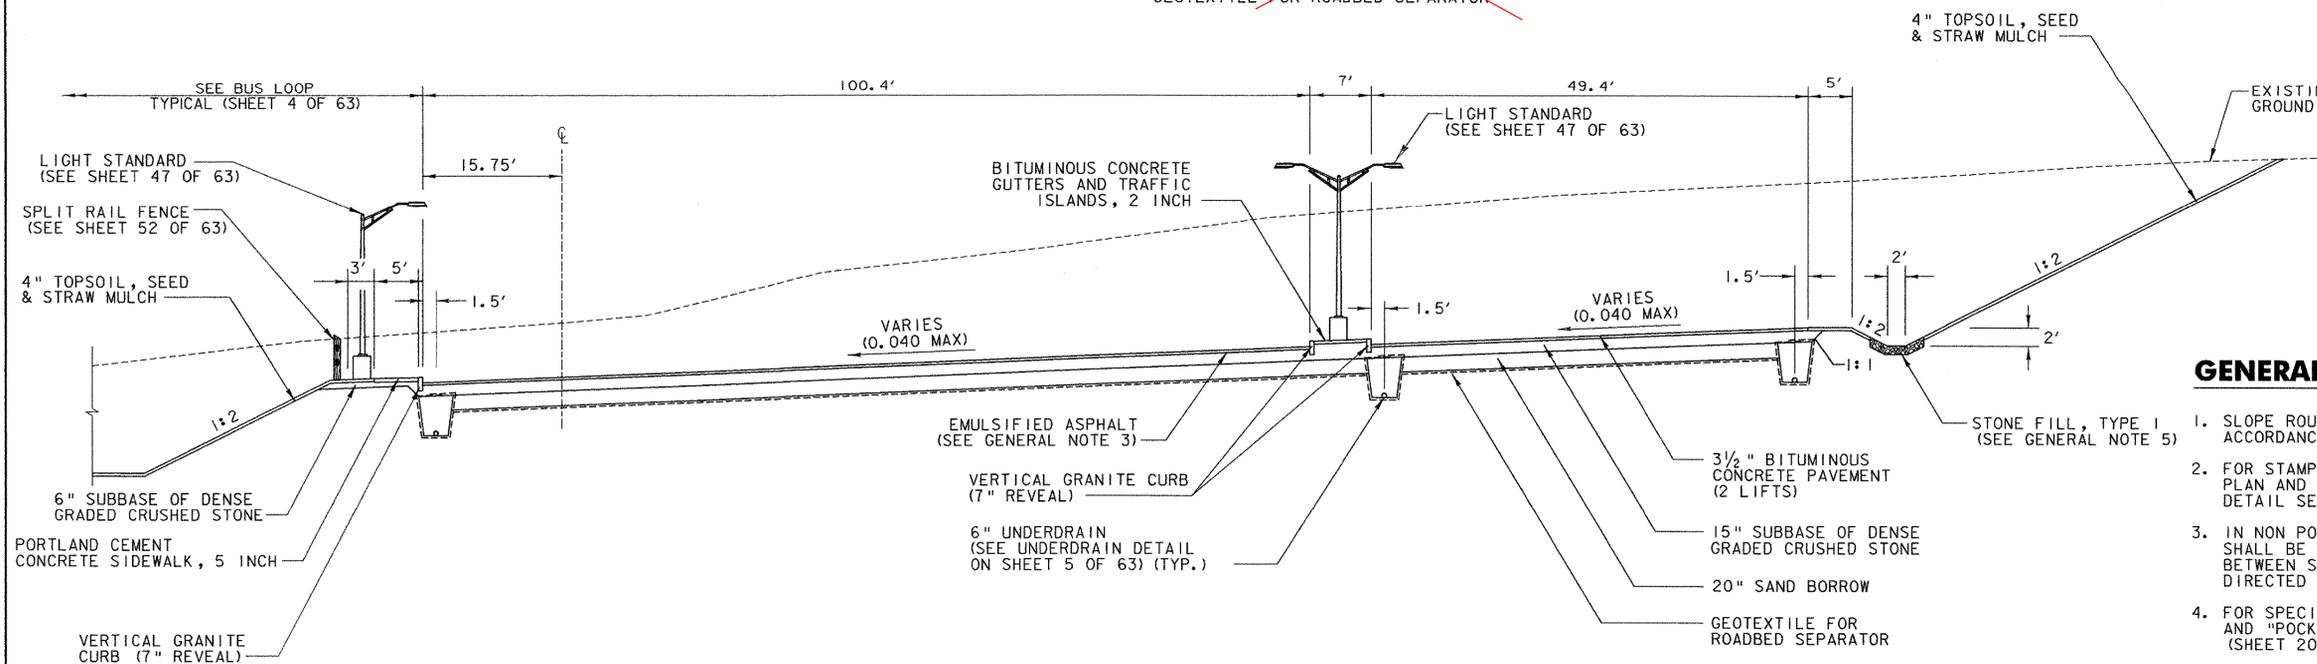


GENERAL NOTES:

1. SLOPE ROUNDING: ALL CUT SLOPES TO BE ROUNDED IN ACCORDANCE WITH STANDARD SHEET B-5.
2. FOR STAMPED CONCRETE ISLAND LOCATIONS, SEE LAYOUT PLAN AND LAYOUT POINTS (SHEETS 16 AND 17 OF 63). FOR DETAIL SEE SHEET 5 OF 63.
3. IN NON POROUS PAVEMENT AREAS EMULSIFIED ASPHALT SHALL BE APPLIED AT THE RATE OF 0.025 GAL/SY BETWEEN SUCCESSIVE COURSES OF PAVEMENT OR AS DIRECTED BY ENGINEER.
4. FOR SPECIFIC GRADING REQUIREMENTS WITHIN THE FOREBAY AND "POCKET POND", SEE THE GRADING AND DRAINAGE PLAN (SHEET 20 OF 63).
5. FOR DITCH PROTECTION LOCATIONS AND DETAILS, SEE THE DRAINAGE DETAILS (SHEETS 22-27 OF 63)

PARKING LOT TYPICAL

NOT TO SCALE
STA. 21+23 TO STA. 23+27

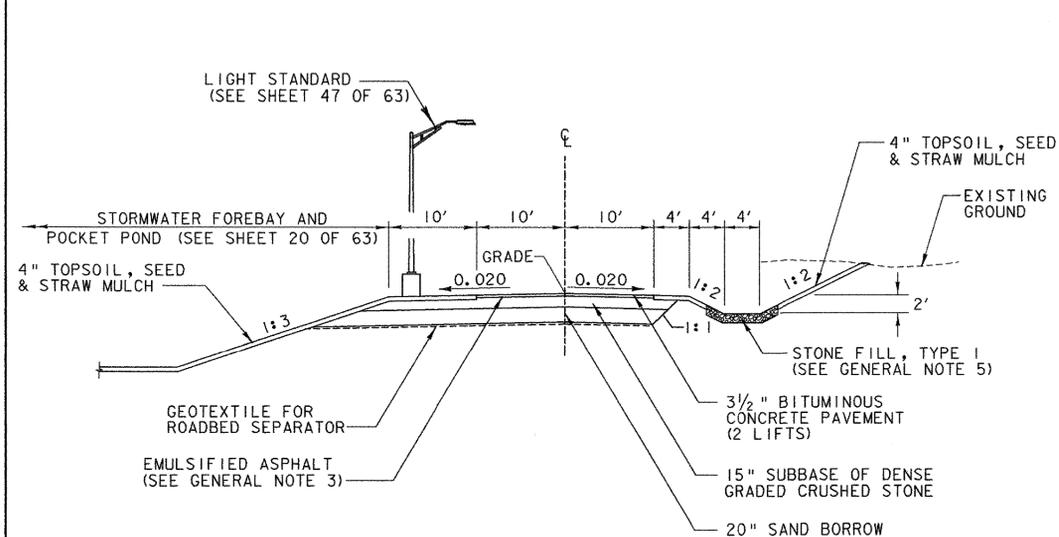

LEFT EDGE CONDITION


STA. 0+25 +/- TO STA. 0+75 +/-

RIGHT EDGE CONDITION

STA. 0+25 +/- TO STA. 0+60 +/-

ACCESS ROAD TYPICAL 1

NOT TO SCALE

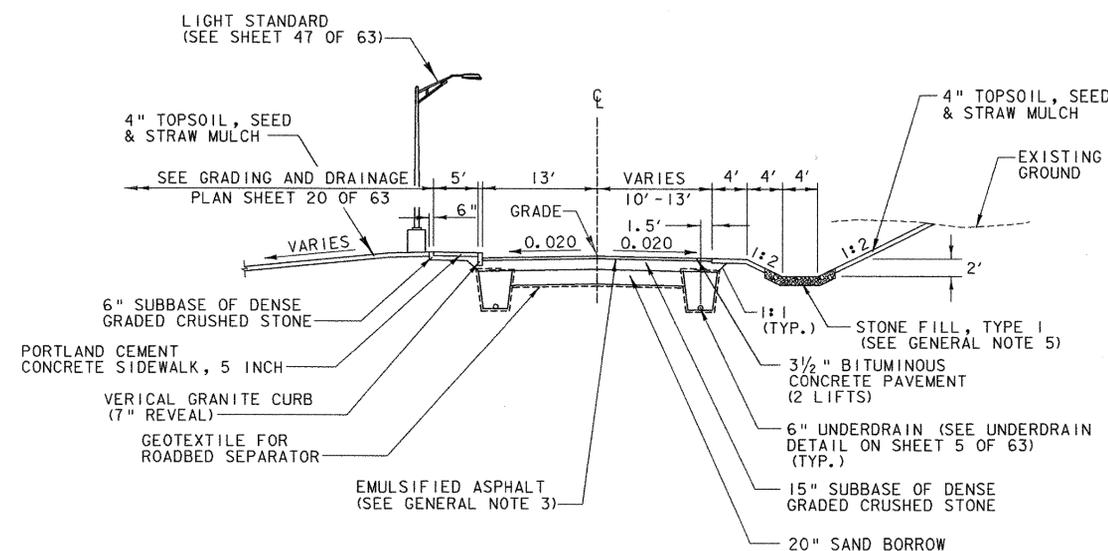

LEFT EDGE CONDITION

STA. 1+14 +/- TO STA. 1+85 +/-

RIGHT EDGE CONDITION

STA. 0+60 +/- TO STA. 3+42 +/-

ACCESS ROAD TYPICAL 2

NOT TO SCALE

ALTERNATE 'A'



Stantec

PROJECT NAME: RANDOLPH
PROJECT NUMBER: CMG PARK(2)IS

FILE NAME: ... \Plot+files\02_zk000frm_por.plot DATE: 8/3/2007
PROJECT LEADER: WLD DRAWN BY: STANTEC
DESIGNED BY: STANTEC CHECKED BY: GAS
TYPICAL SECTIONS SHEET 1 SHEET 2 OF 63