

TYPICAL SECTIONS

ALTERNATE 'B'

4" - SPECIAL PROVISION (POROUS BITUMINOUS CONCRETE PAVEMENT)
 2" - SPECIAL PROVISION (CHOKER COURSE, POROUS PAVEMENT)
 36" MIN - SPECIAL PROVISION (SUBBASE, POROUS PAVEMENT)
 GEOTEXTILE FOR ROADBED SEPERATOR



ALTERNATE 'C'

6" - SPECIAL PROVISION (POROUS PORTLAND CEMENT CONCRETE PAVEMENT)
 2" - SPECIAL PROVISION (CHOKER COURSE, POROUS PAVEMENT)
 34" MIN - SPECIAL PROVISION (SUBBASE, POROUS PAVEMENT)
 GEOTEXTILE FOR ROADBED SEPERATOR

MATERIAL ITEM THICKNESS / TOLERANCE
 (SEE SHEET 2 OF 63)


SEEDING FORMULA - RURAL AREAS
 SEE LANDSCAPING DETAILS (SHEET 52 OF 63)

GENERAL NOTES:

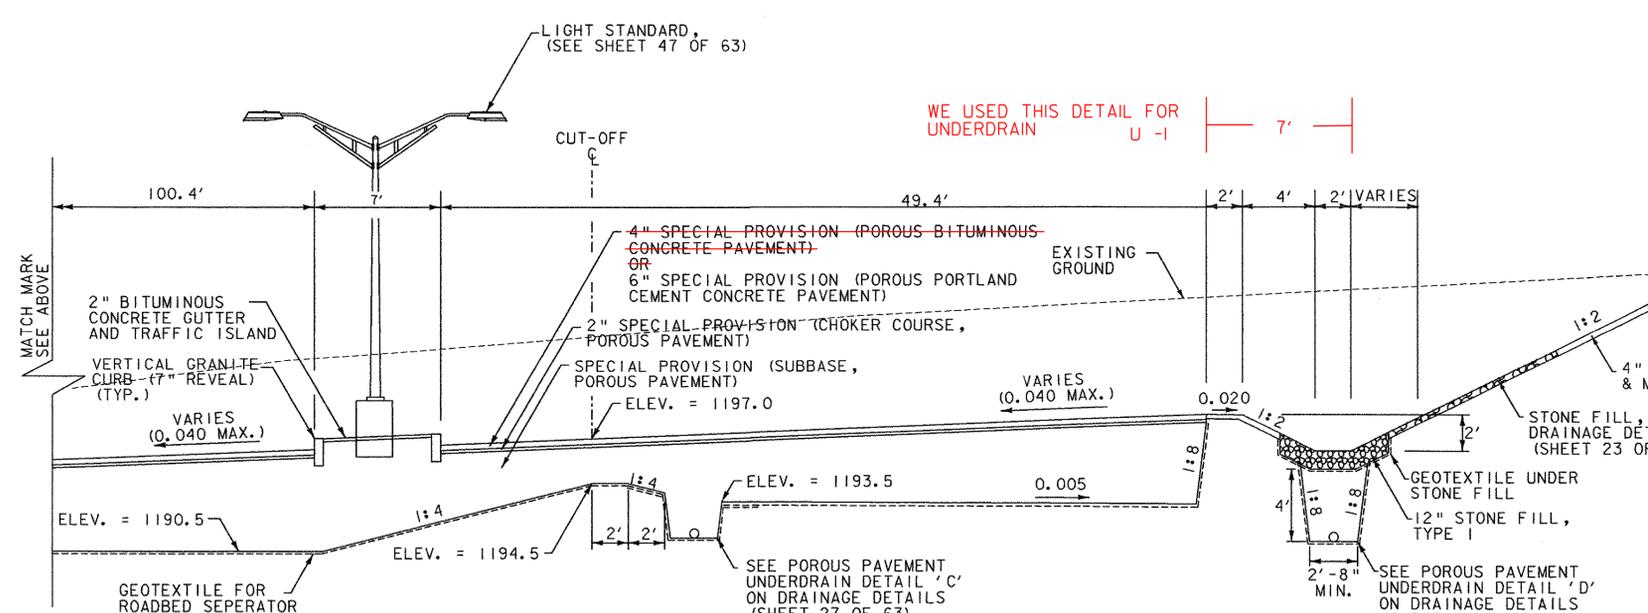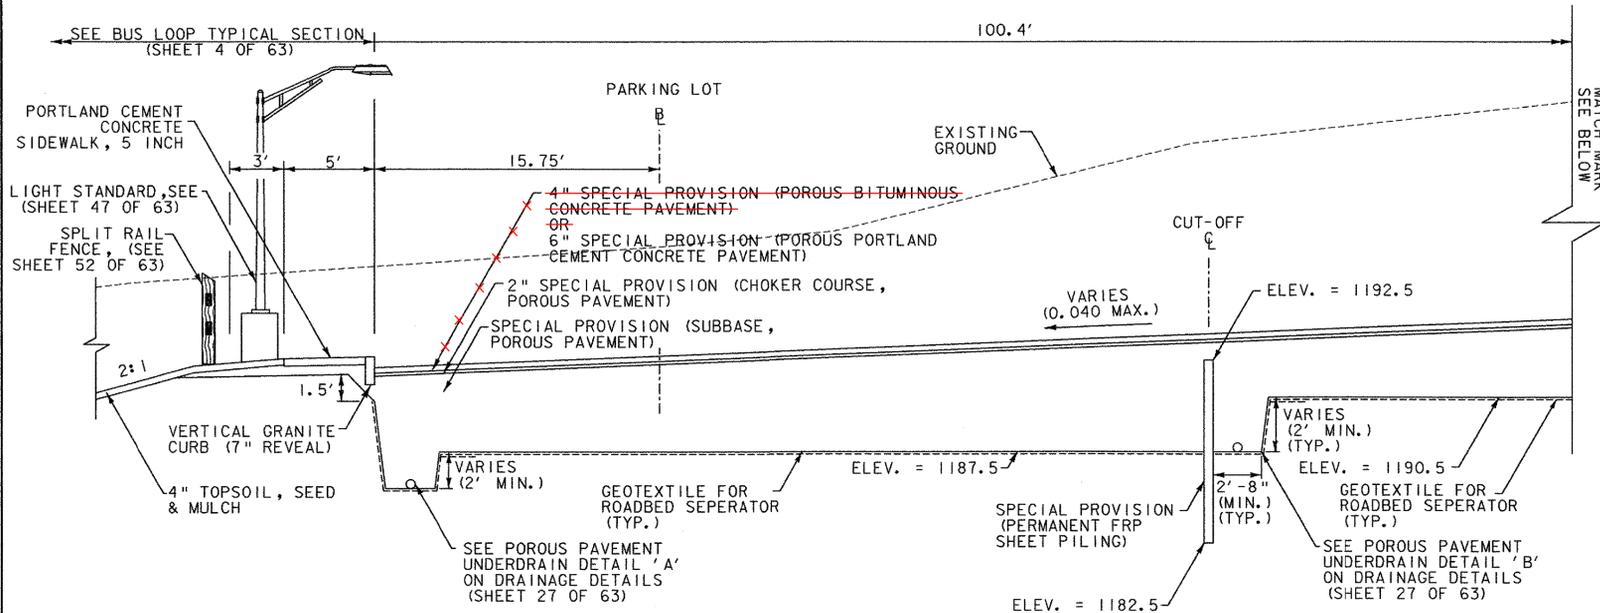


**PARKING LOT TYPICAL SECTION
 ALTERNATE 'B' AND 'C'**

STA. 21+23 TO STA. 23+27
 NOT TO SCALE

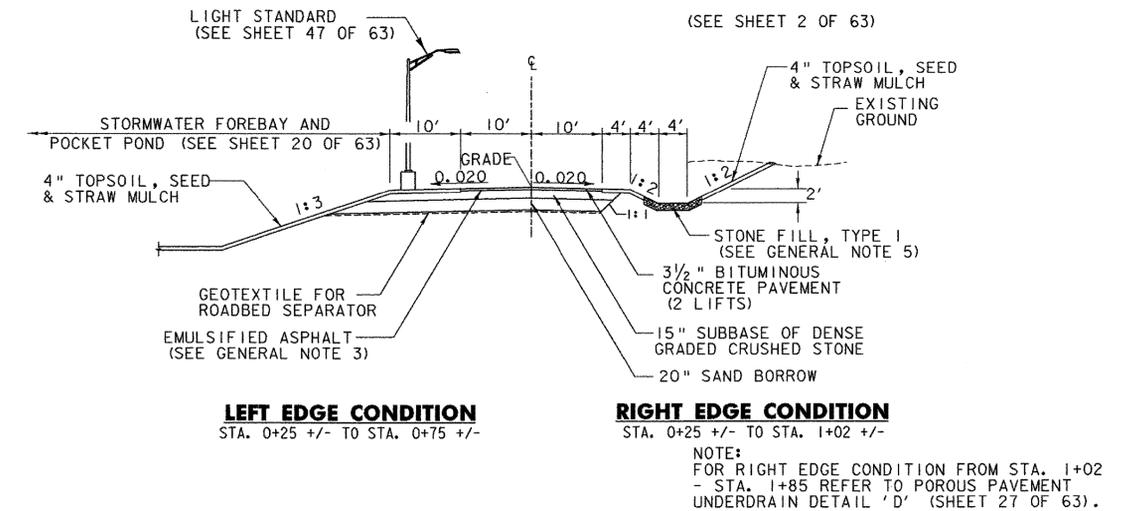

ACCESS ROAD TYPICAL 1
 NOT TO SCALE

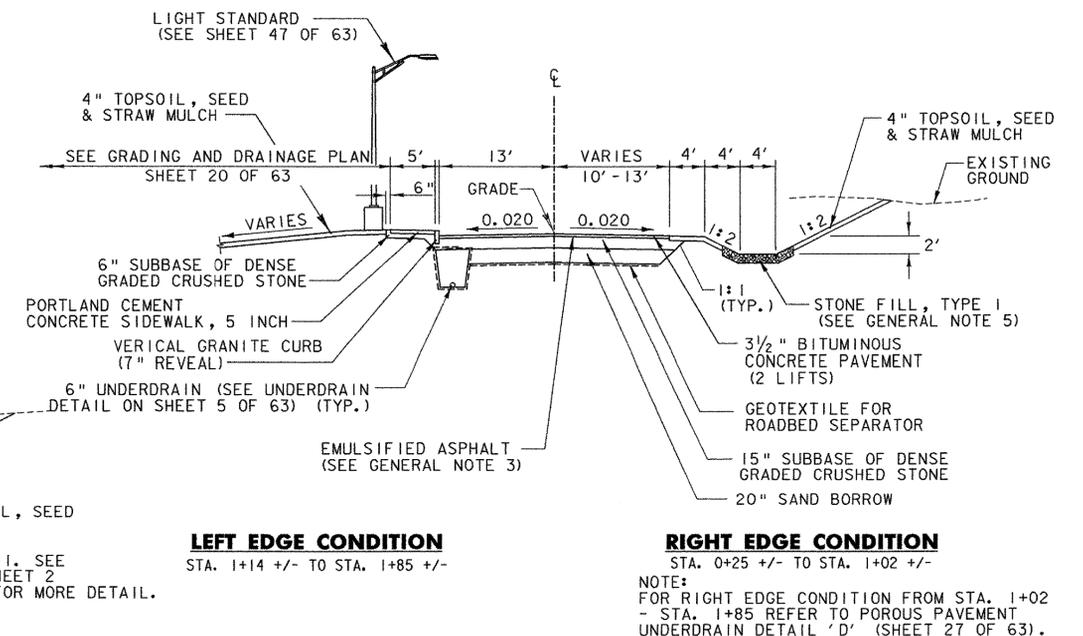

ACCESS ROAD TYPICAL 2
 NOT TO SCALE

**ALTERNATES
 'B' AND 'C'**



PROJECT NAME: RANDOLPH
 PROJECT NUMBER: CMG PARK(2)S

FILE NAME: ...\\plotfiles\02_zk000frm_por.p... DATE: 8/3/2007
 PROJECT LEADER: WLD DRAWN BY: STANTEC
 DESIGNED BY: STANTEC CHECKED BY: GAS
TYPICAL SECTIONS SHEET 1 SHEET 3 OF 63