

**NOTES:**

- FOR PAVEMENT MARKING DETAILS, SEE VTrans STANDARD SHEETS E-191, E-192 AND E-193.
- FOR FLUSH ISLAND STRIPING DETAILS, SEE MISCELLANEOUS DETAILS SHEET 46 of 63.
- FOR HANDICAPPED PARKING STRIPING DETAILS, SEE MISCELLANEOUS DETAILS SHEET 46 of 63.

**DURABLE 4" WHITE LINE**

- 0+00 TO 2+02, SOLID RT.
- 1+33 TO 1+53, SOLID LT.
- NW EDGE OF FLUSH CONCRETE ISLAND
- 10+09 TO 10+38, SOLID RT.
- 10+38 TO 11+97, DASHED RT.
- 11+97 TO 13+04, SOLID RT.
- 11+49 TO 11+76, SOLID RT. (HANDICAPPED PARKING SPACES & DIAGONALS)
- 21+23 TO 23+27, SOLID RT. & LT. (PARKING SPACES & DIAGONALS)
- 51+23 TO 57+62, SOLID RT.
- 51+40 TO 53+12, SOLID LT.
- 53+40 TO 57+62, SOLID LT.
- 51+45 TO 52+98, SOLID RT.
- 52+98 TO 53+95, DASHED RT.

**DURABLE 24" STOP BAR**

- 13+04, LT.-RT.
- 53+00 - 53+24, LT.

**DURABLE 4" YELLOW LINE**

- 0+00 TO 0+58, LT. SOLID
- 1+26 TO 2+02, DOUBLE SOLID
- NE EDGE OF FLUSH CONCRETE ISLAND
- SOUTH EDGE OF FLUSH CONCRETE ISLAND
- 51+41 TO 53+03, LT. SOLID
- 53+90 TO 55+68, C SOLID & DIAGONALS

**DURABLE LETTER OR SYMBOL**

- 0+10, C -
- 0+80, LT. -
- 0+80, RT. -
- 1+50, LT. -
- 1+50, RT. -

**PAINTED CURB**

- 51+42, 6' LT. - 51+72, 4' LT.
- 51+42, 6' LT. - 51+72, 8' LT.
- 52+72, 2' LT. - 53+02, 4' LT.
- 52+72, 6' LT. - 53+02, 4' LT.

**PAINTED ISLAND**

- 51+42 - 53+02, LT.

- 2+00, LT. -

- 2+60, RT. -

- 3+16, RT. -

- 10+23, RT. - (4) ▼

- 11+44, RT. -

- 11+45, LT. -

- 11+45, RT. -

- 11+60, RT. -

- 11+70, RT. -

- 11+78, RT. -

- 22+30, C -

- 22+30, RT. -

- 22+30, 107' RT. -

- 23+12, RT. -


- 23+12, 107' RT. -

- 51+65, RT. - ONLY

- 52+09, RT. -

- 52+50, RT. - ONLY

- 52+90, RT. -

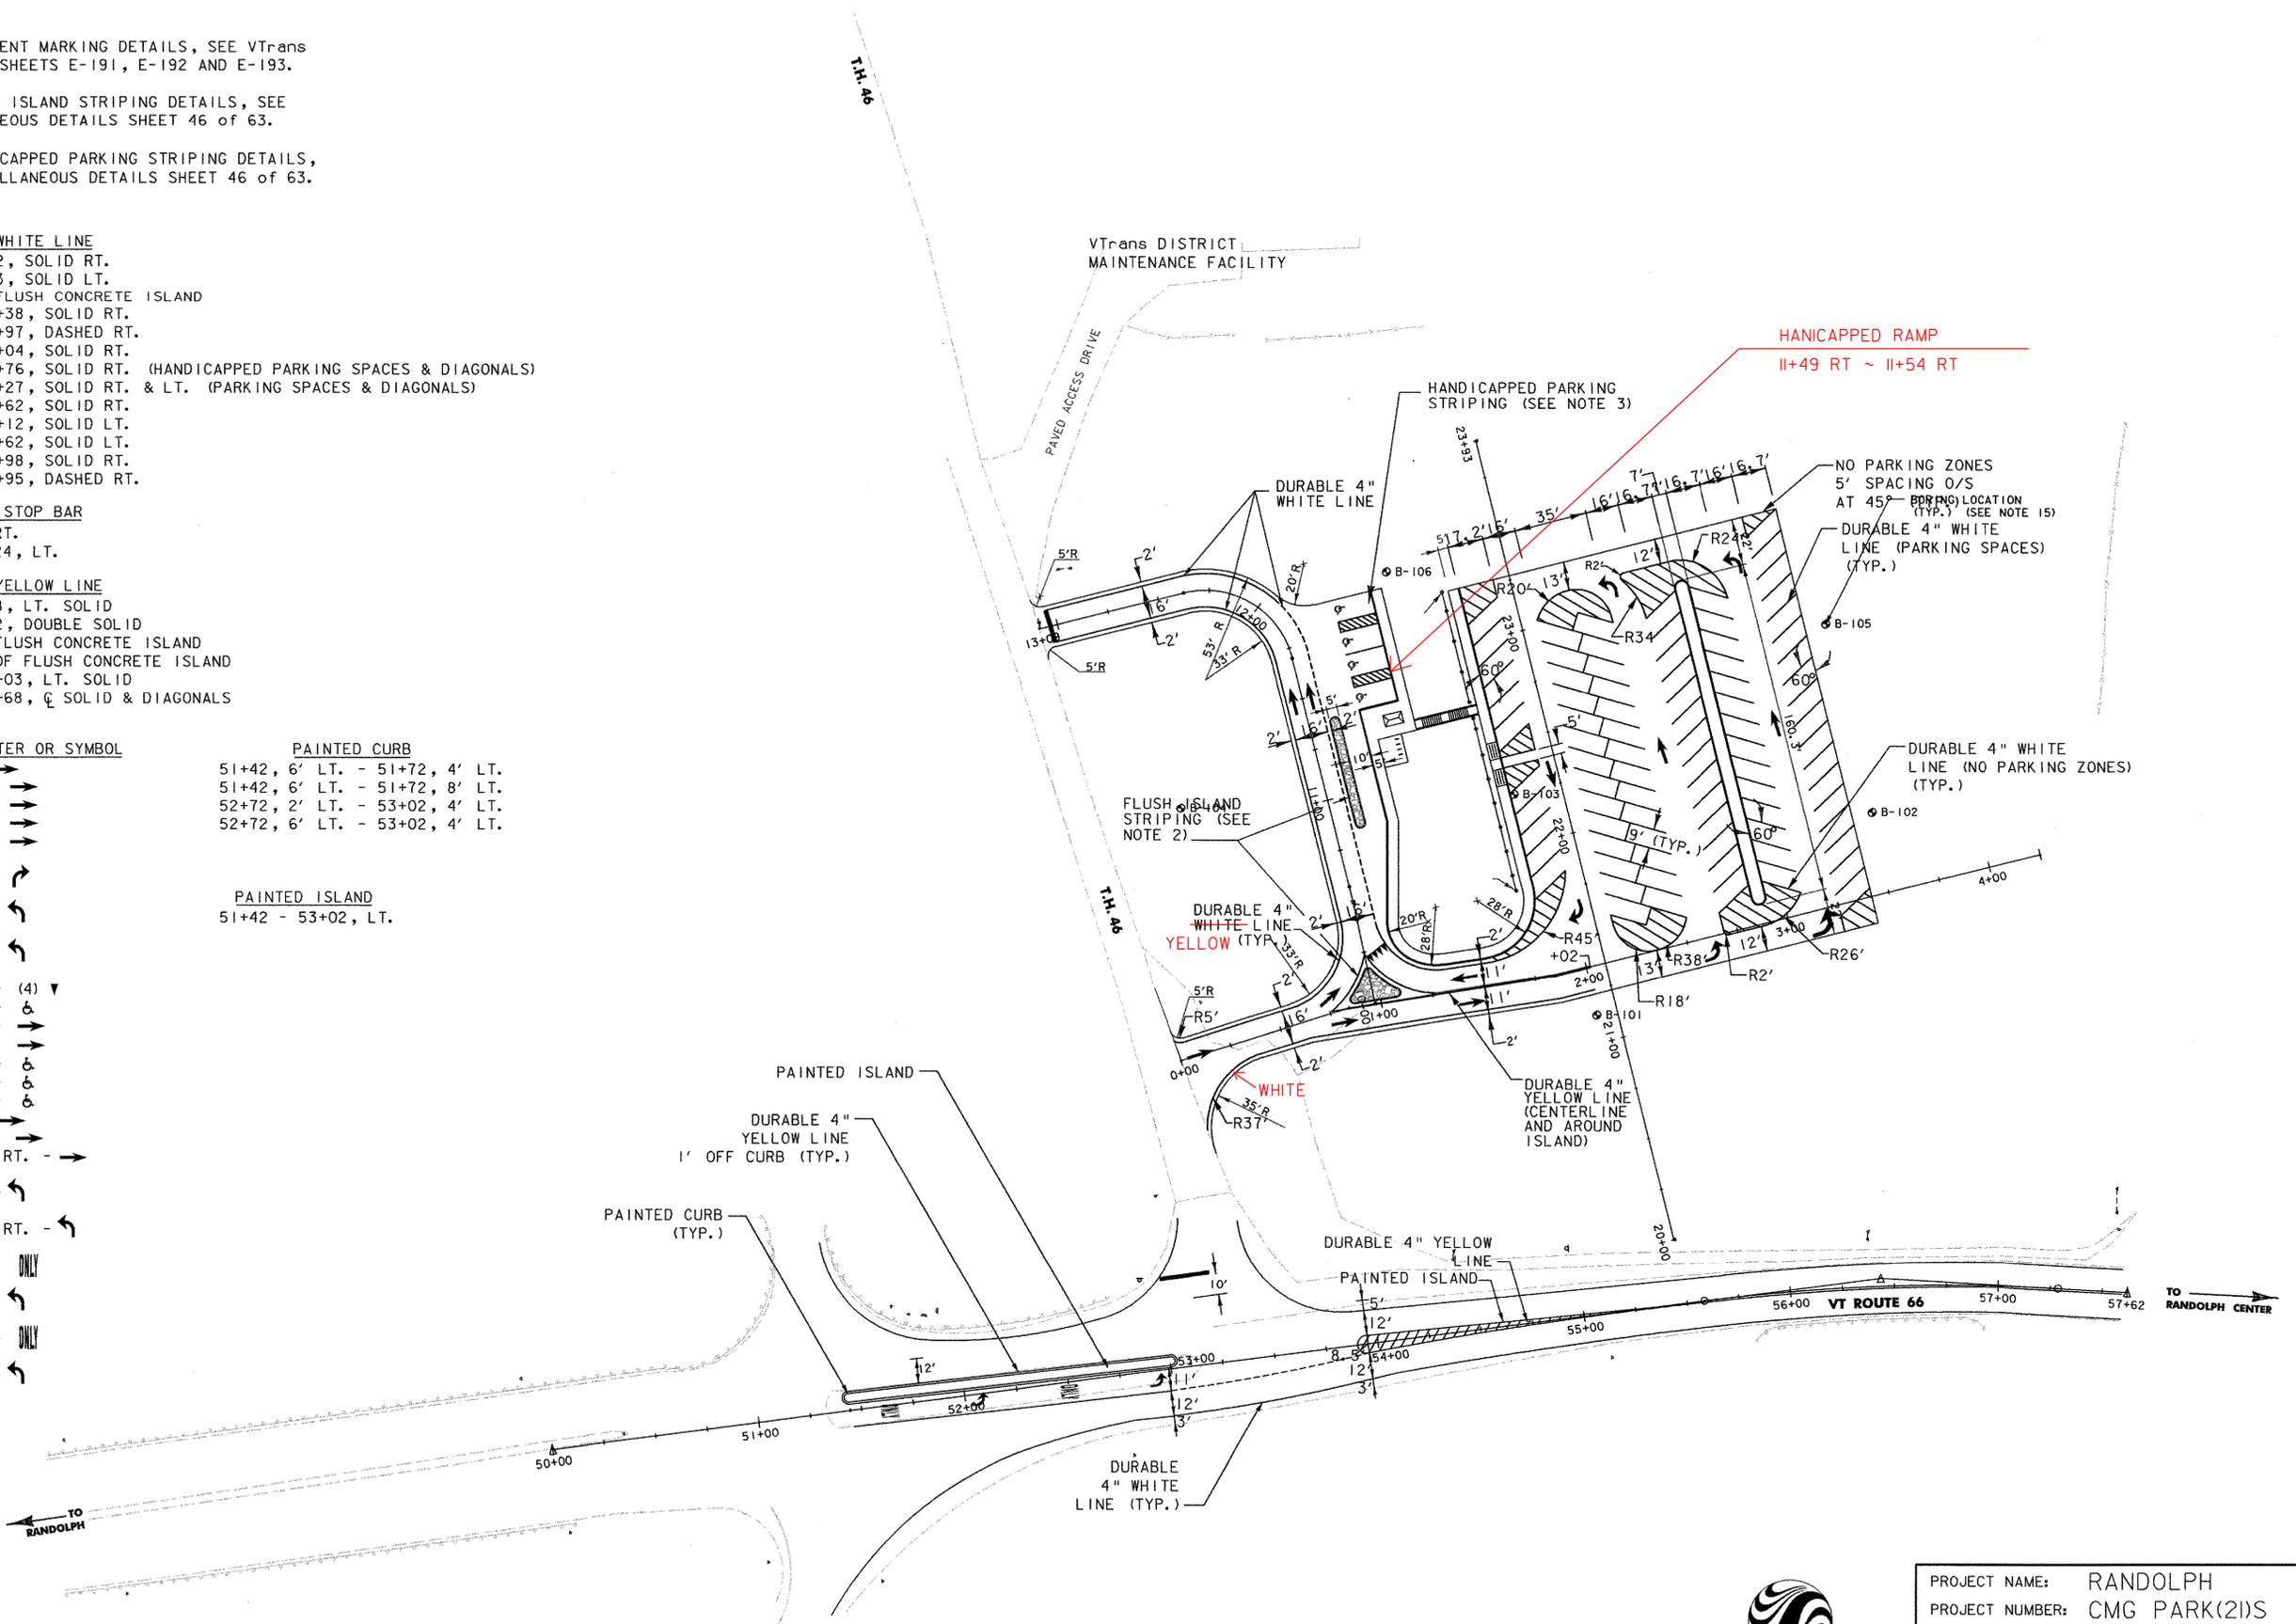

PROJECT NAME:	RANDOLPH		
PROJECT NUMBER:	CMG PARK(2)S		
FILE NAME:	...23_Pavement Markings.pff	PLOT DATE:	8/3/2007
PROJECT LEADER:	WLD	DRAWN BY:	STANTEC
DESIGNED BY:	STANTEC	CHECKED BY:	GAS
<b>PAVEMENT MARKING PLAN</b>		SHEET 38 OF 63	