
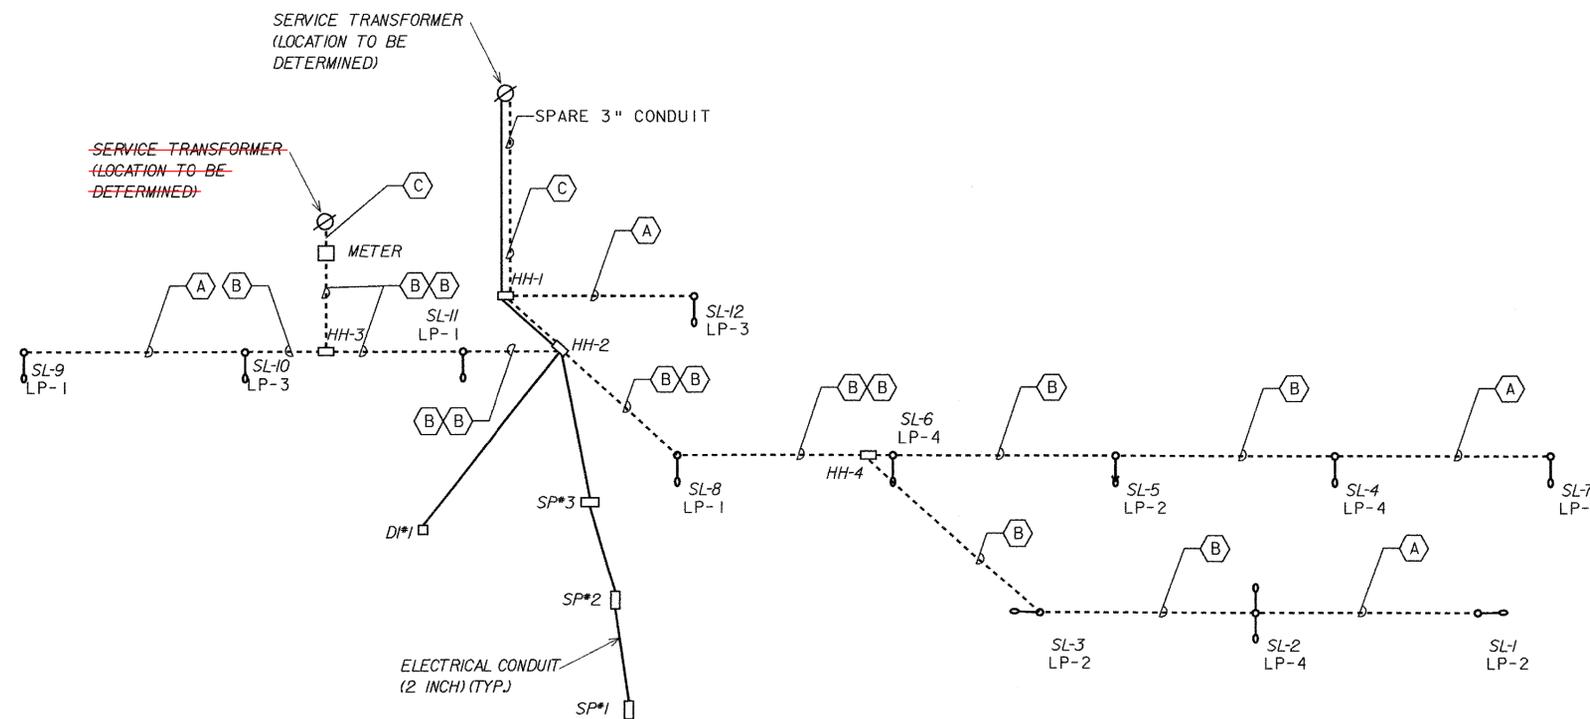


CONDUIT & CONDUCTOR SCHEDULE				
KEY	CONDUIT SIZE	CONDUCTORS		
		FOR FIXTURES	FOR RECEPTACLES	FOR GROUND
A	2"	2#6		1#6G
B	2"	3#6		1#6G
C	3"	3#1/0		1#6G

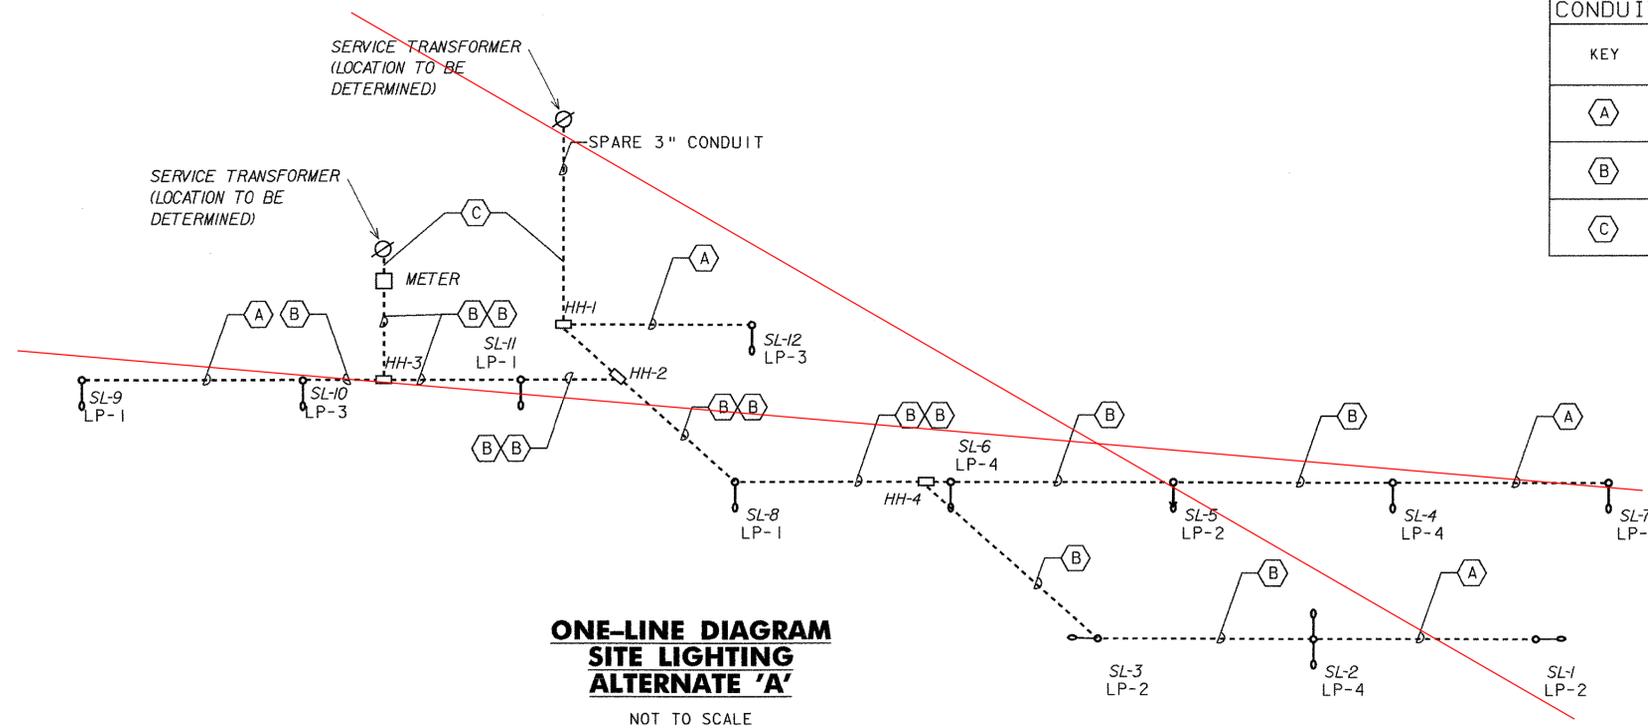

PROJECT NAME: RANDOLPH
PROJECT NUMBER: CMG PARK(2)S

FILE NAME: ...\\plotfiles\3L\Light Details.pptf PLOT DATE: 8/3/2007
PROJECT LEADER: WLD DRAWN BY: STANTEC
DESIGNED BY: STANTEC CHECKED BY: GAS
LIGHTING DETAILS 1 SHEET 48 OF 63