


STA. 21+75

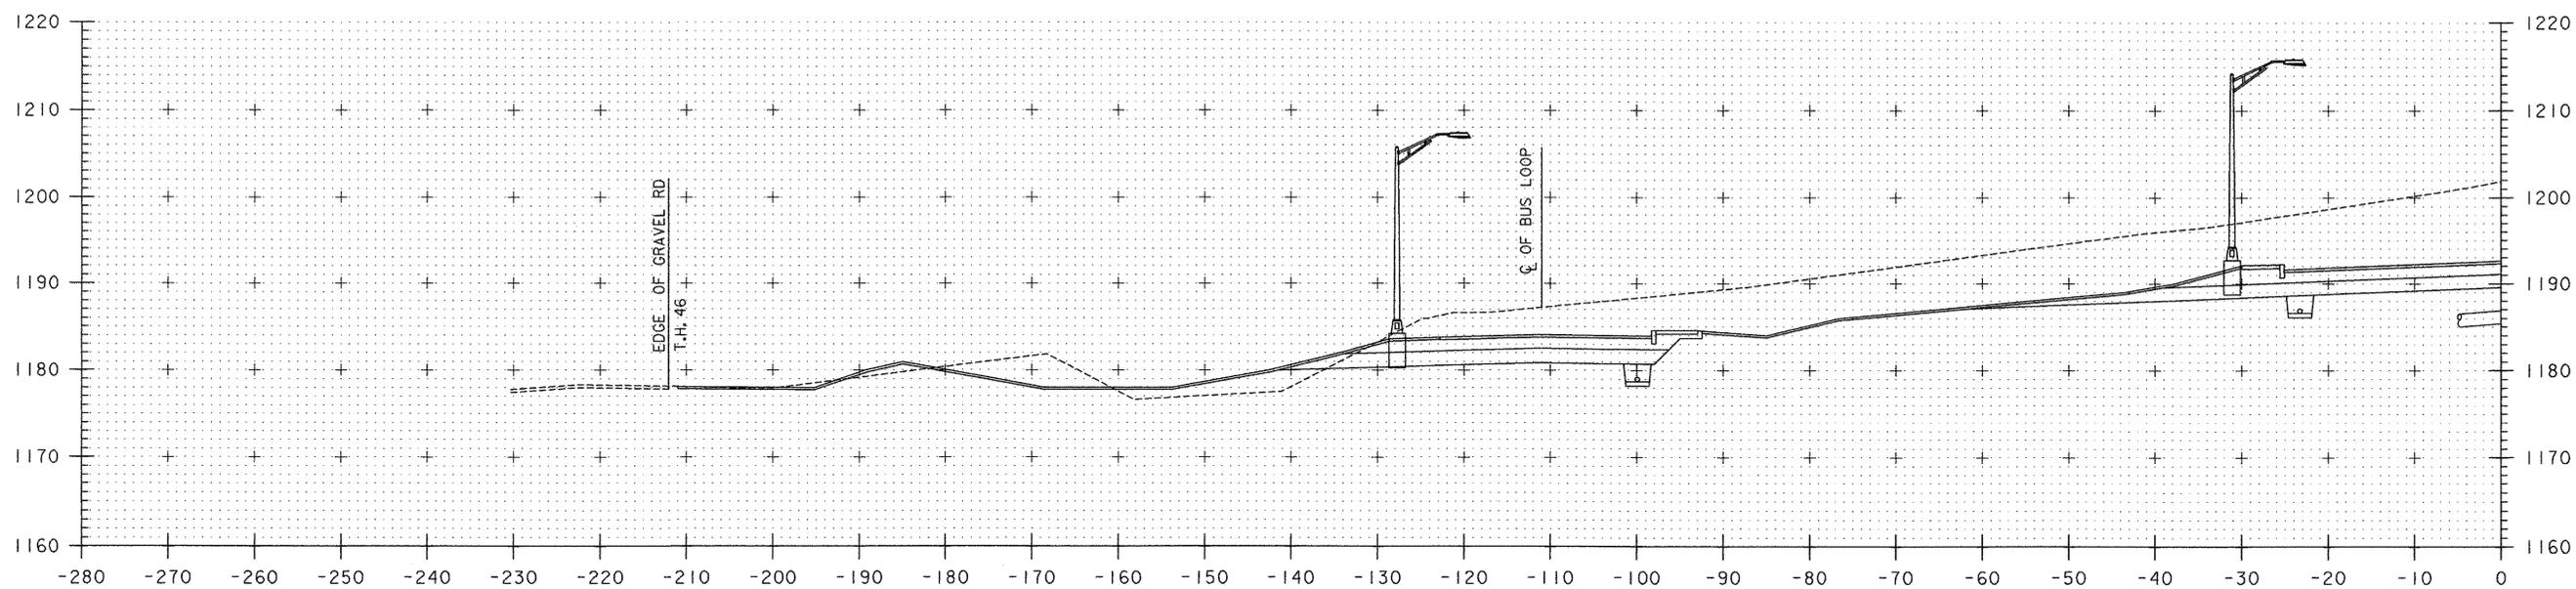


STA. 21+75

VOID SHEET

**ALTERNATE
'A'**

NOTE:
FOR FURTHER DETAIL ON CROSS SECTIONAL ELEMENTS
REFER TO THE LAYOUT PLAN, PROFILE SHEET, AND
GRADING AND DRAINAGE PLAN.

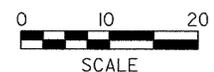

PROJECT NAME:	RANDOLPH	DATE:	8/3/2007
PROJECT NUMBER:	CMG PARK(2)S		
FILE NAME:	...35_zk000criticalsections.por	DRAWN BY:	STANTEC
PROJECT LEADER:	WLD	CHECKED BY:	GAS
DESIGNED BY:	STANTEC		
CRITICAL SECTIONS 1		SHEET	56 OF 63