


STA. 23+00

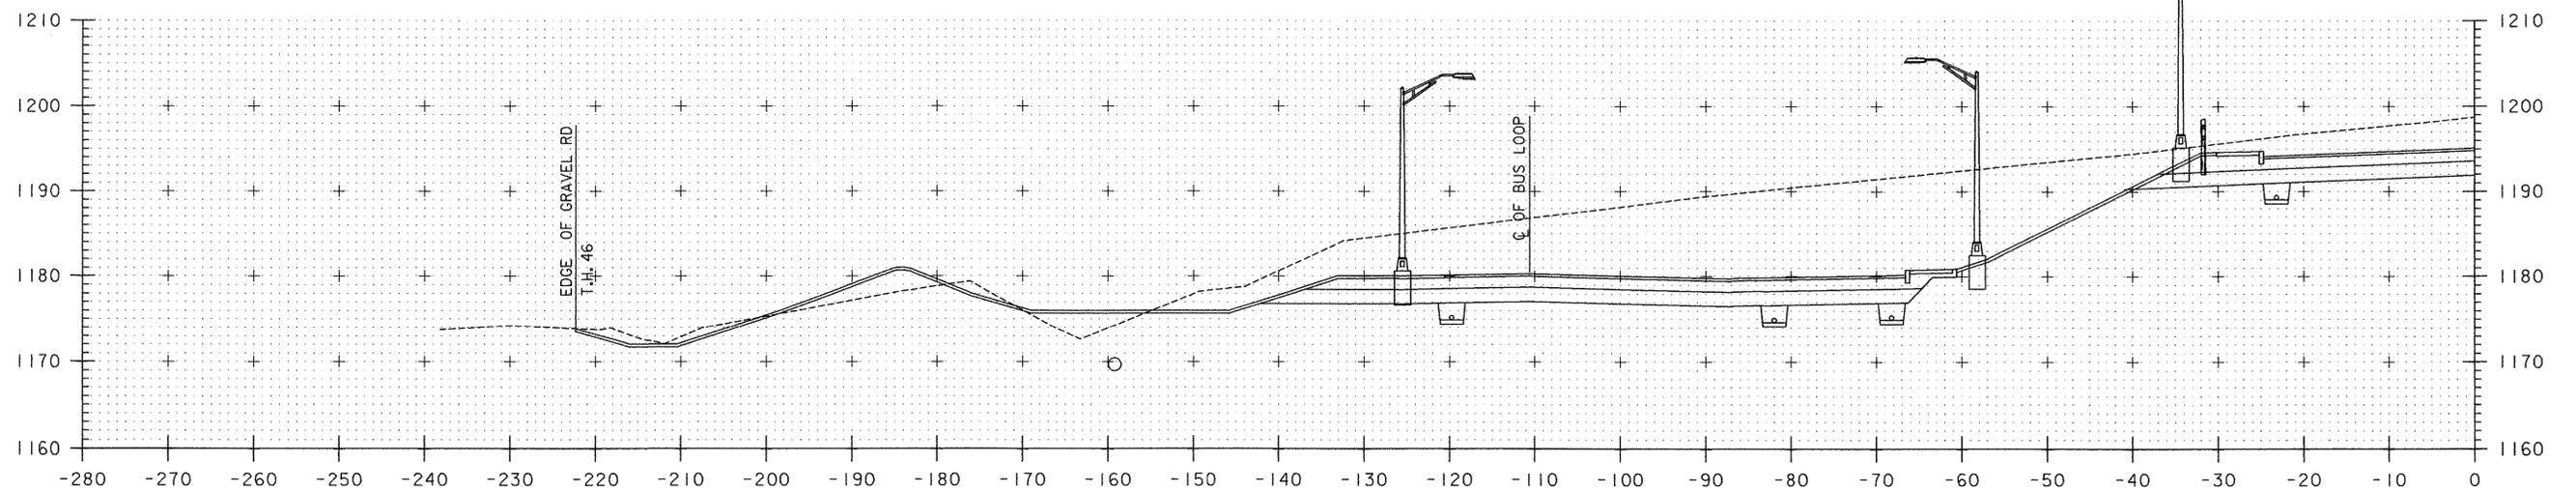

STA. 23+00

VOID SHEET

ALTERNATE
'A'

NOTE:
FOR FURTHER DETAIL ON CROSS SECTIONAL ELEMENTS
REFER TO THE LAYOUT PLAN, PROFILE SHEET, AND
GRADING AND DRAINAGE PLAN.



PROJECT NAME:	RANDOLPH	DATE:	8/3/2007
PROJECT NUMBER:	CMG PARK(2)S	DRAWN BY:	STANTEC
FILE NAME:	... \35_zk000criticalsections.por	CHECKED BY:	GAS
PROJECT LEADER:	WLD	SHEET	57 OF 63
DESIGNED BY:	STANTEC	CRITICAL SECTIONS 2	