


STANDARDS		
A-76	STANDARDS FOR TOWN AND DEVELOPMENT ROADS	03/03/03
B-5M	EMBANKMENT ON EARTH SLOPE. EMBANKMENT ON ROCK SLOPE, MUCK EXCAVATION, TYPICAL SLOPE ROUNDING	01/03/00
B-71	STANDARDS FOR RESIDENTIAL AND COMMERCIAL DRIVES	02/01/04
C-1M	VERTICAL GRANITE CURB	01/03/00
D-2M	CEMENT RUBBLE MASONRY HEADWALL & RETAINING WALL RIPRAP LIGHT TYPE STONE HEADWALLS REINFORCED CONCRETE HEADWALL UNDERDRAIN & CARRIER PIPE CONSTRUCTION DETAIL	06/13/97
D-3M	TREATED GUTTERS	06/13/97
D-4M	CORRUGATED STEEL PIPE END SECTION	06/13/97
D-6M	REINFORCED CONCRETE DROP INLET WITH GRATE FOR USE IN DITCHES	06/13/97
D-9M	REINFORCED CONCRETE DROP INLET WITH VERTICAL CURB REINFORCED CONCRETE DROP INLET THROAT ADAPTER	06/13/97
D-15M	PRECAST REINFORCED CONCRETE CATCH BASIN W/ CAST IRON GRATE PRECAST REINFORCED CONCRETE MANHOLE W/ CAST IRON COVER CAST IRON GRATE WITH FRAME, TYPE D CAST IRON GRATE WITH FRAME, TYPE E	06/13/97
D-20	HIGHWAY CROSSING SLEEVES FOR UNDERGROUND UTILITIES	03/03/03
E-100	CONSTRUCTION APPROACH SIGNS	01/02/04
E-100A	SIDE ROAD CONSTRUCTION APPROACH SIGNS	01/02/04
E-101	CONSTRUCTION SIGN DETAILS	05/30/03
E-102	CONSTRUCTION SIGN DETAILS	06/30/03
E-102A	CONSTRUCTION SIGN DETAILS	05/01/04
E-106	TRAFFIC CONTROL MISCELLANEOUS DETAILS	03/01/04
E-107	DELINEATION, BARRICADES AND DETOURS FOR CONSTRUCTION AREAS	06/30/03
E-107A	BREAKAWAY BARRICADE DETAILS	08/08/95
E-108	CONSTRUCTION ZONE LONGITUDINAL DROP OFFS	08/18/95
E-121	STANDARD SIGN PLACEMENT CONVENTIONAL ROAD	08/08/95
E-123	GUIDE SIGN PLACEMENT MISC. DETAILS	03/16/04
E-143	REGULATORY SIGN DETAILS	06/15/94
E-144	REGULATORY SIGN DETAILS	03/15/05
E-152	WARNING SIGN DETAILS	05/01/04
E-160	FLANGED CHANNEL STEEL SIGN POST	05/20/99
E-173	PULLBOXES AND JUNCTION BOXES	08/09/95
E-175	POWER DROP STANCHIONS	11/17/93
E-180A	STREET LIGHTING DETAILS	08/09/95
E-180B	STREET LIGHTING DETAILS	08/09/95
E-191	PAVEMENT MARKING DETAILS	02/01/99
E-193	PAVEMENT MARKING DETAILS	08/18/95
G-1M	STEEL BEAM GUARDRAIL WITH STEEL POSTS	01/03/00
G-1dM	STEEL BEAM GUARDRAIL APPROACH END TERMINAL	01/03/00
G-4M	PLANK RAIL/GUIDE POSTS/YIELDING MARKER POSTS	06/13/97

STATE OF VERMONT AGENCY OF TRANSPORTATION



PROPOSED IMPROVEMENT TOWN OF ST. ALBANS. COUNTY OF FRANKLIN COMMUTER PARKING LOT

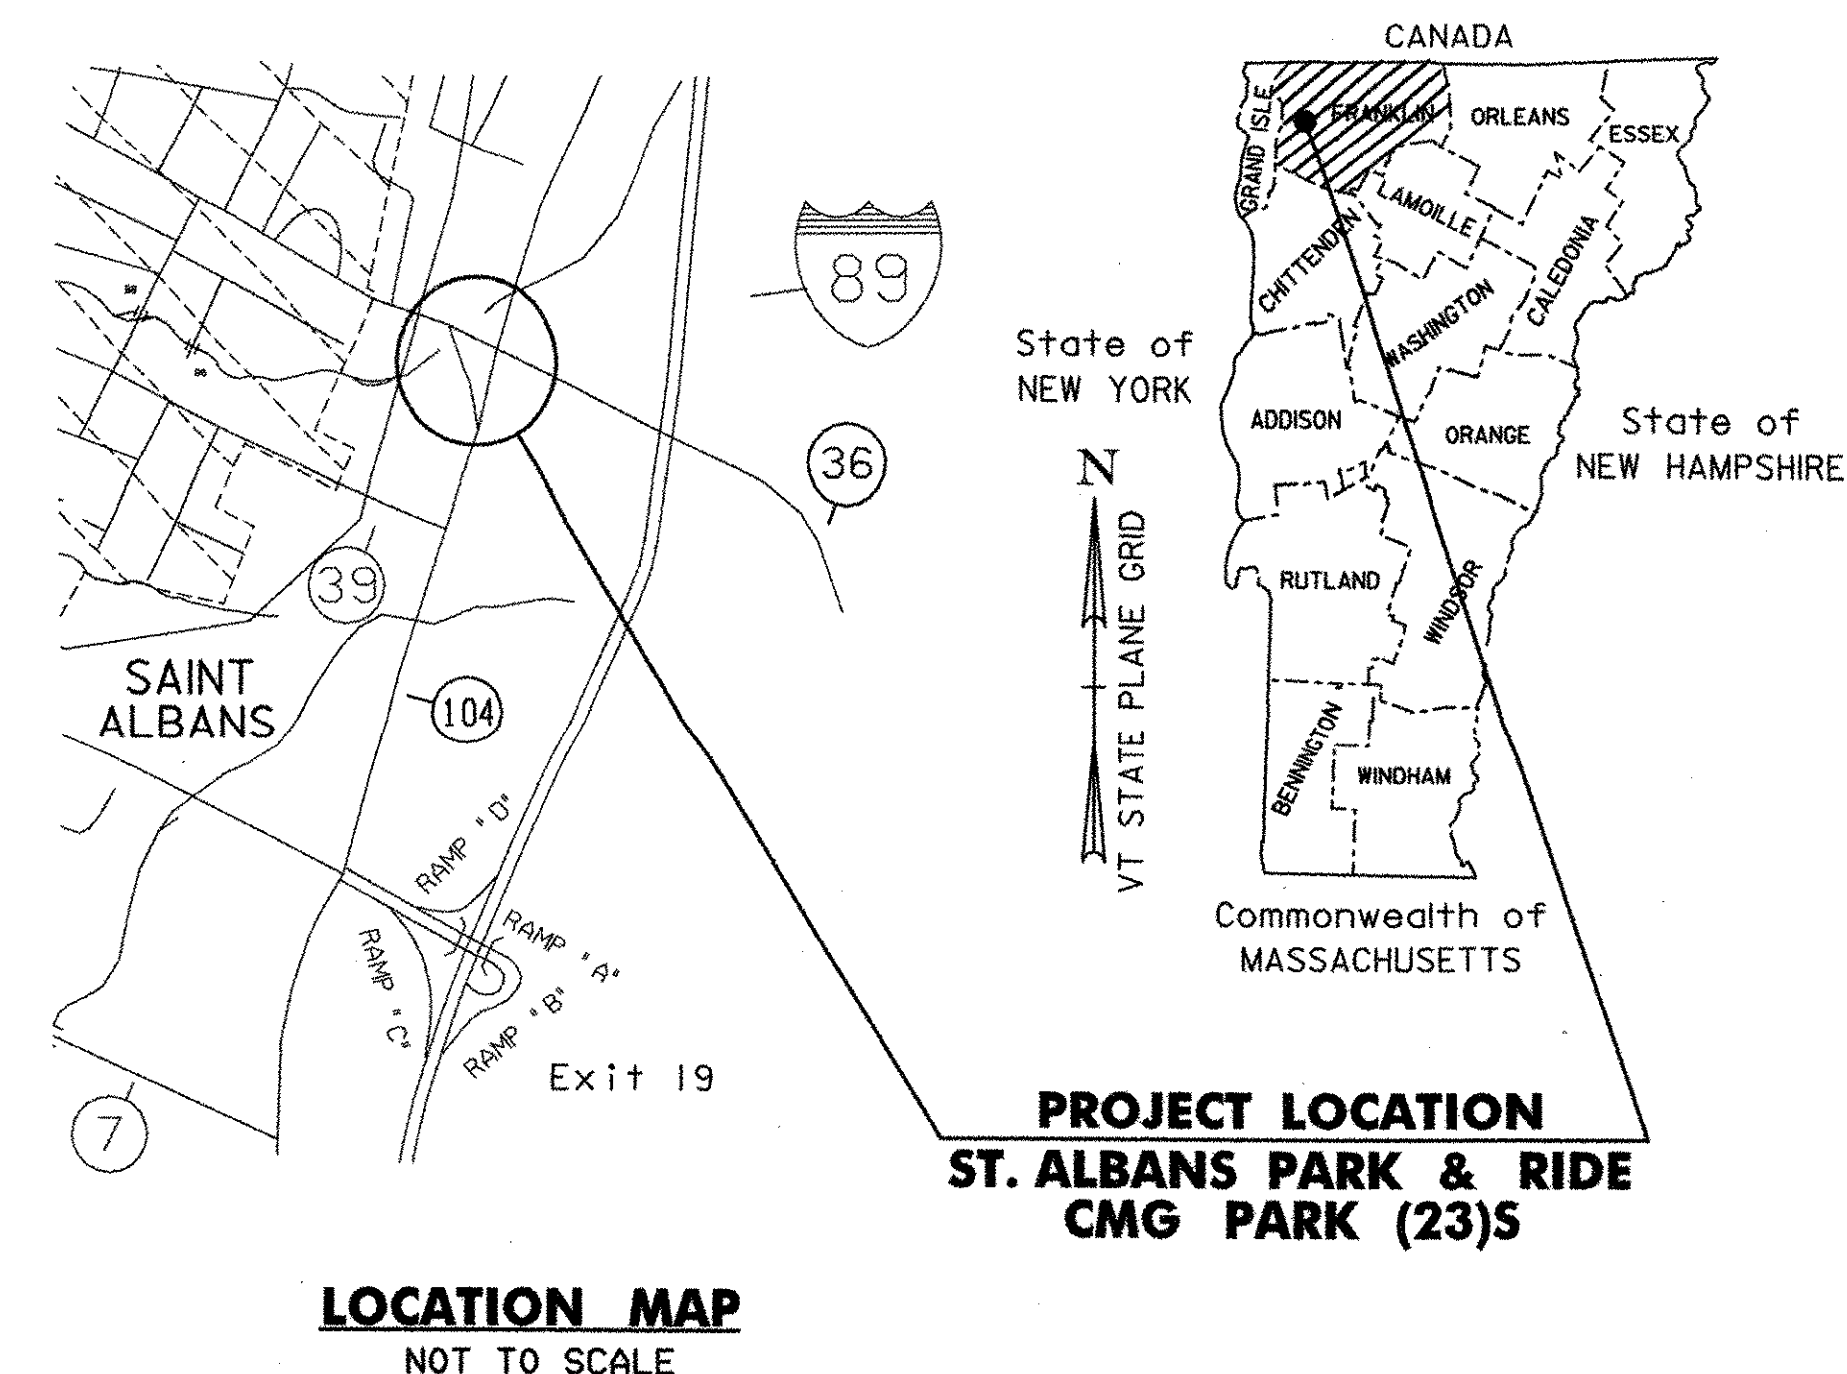

PROJECT LOCATION : BEGINNING IN THE GRASS ISLAND ON THE SOUTHWEST SIDE OF VT ROUTE 36 AT STA 0+035.000 RT 33.500 AND EXTENDING 217.000 METERS SOUTHEASTERLY TO THE EDGE OF SLIP RAMP ON THE WESTERN EDGE OF VT ROUTE 104, AT STA. 0+252.000 RT 44.500.

PROJECT DESCRIPTION : WORK TO BE PERFORMED UNDER THIS PROJECT INCLUDES ELIMINATION OF THE SLIP RAMP FROM VT ROUTE 36 TO VT ROUTE 104 AND THE EXPANSION OF AN EXISTING COMMUTER PARKING LOT INCLUDING THE INSTALLATION OF ADDITIONAL PARKING SPACES, BUS SHELTER, LIGHTING, LANDSCAPING, DRAINAGE, AND INCIDENTAL ITEMS.

LENGTH OF PROJECT : 217.000 METERS (0.135 MILES)

INDEX OF SHEETS

1	TITLE SHEET
2	TYPICAL SECTIONS
3	MISCELLANEOUS DETAILS
4	QUANTITY SHEET
5	TIE & PAVEMENT LAYOUT SHEET
6	EXISTING CONDITIONS PLAN
7	SITE PLAN & RIGHT-OF-WAY SHEET
8	PROFILES & PAVEMENT REMOVAL PLAN
9	STORMWATER DETENTION POND & SIDEWALK LAYOUT
10	LANDSCAPING PLAN
11	EROSION CONTROL PLAN
12	EROSION CONTROL NARRATIVE
13	LIGHTING DETAIL PLAN
14	SITE LIGHTING SHEET
15	PLANTING & MISCELLANEOUS DETAILS
16	SILT FENCE DETAILS
17	CHECK DAM DETAILS
18	DROP INLET PROTECTION DETAILS
19	CONSTRUCTION ENTRANCE DETAILS
20	DITCH & SIDE SLOPE PROTECTION DETAILS
21	GENERAL NOTES
22	CONSTRUCTION SIGNING PLAN
23	PAVEMENT MARKINGS & SIGNAGE PLAN
24	TRAFFIC SIGN SUMMARY SHEET
25	SHELTER DETAILS
26	SHELTER FOUNDATION & BIKE RACK DETAILS
27-28	CROSS SECTIONS
29	DRAINAGE PROFILES


RECORD PLANS	
CONTRACTOR:	WRIGHT'S EXCAVATION INC. -FRANKLIN, VT
RESIDENT ENGINEER:	CARL GLEASON
CONSTRUCTION BEGAN:	MARCH 17, 2006
CONSTRUCTION COMPLETE:	SEPTEMBER 26, 2006
RECORD PLANS BY:	RON STANCLIFF & C. PIERCE
I HEREBY CERTIFY THAT ALL THE CONSTRUCTION REQUIRED BY THIS SET OF DRAWINGS HAS BEEN ACCOMPLISHED AS INDICATED HEREIN.	
BY <i>Carl Gleason</i>	RESIDENT ENGINEER
DATE <i>4/27/09</i>	
NOTE: Any further information concerning final quantities, amounts or other details relative to this project may be found at Central Files in the electronic archives.	

CONVENTIONAL SYMBOLS	
COUNTY LINE	---
TOWN LINE	---
LIMITS OF ACCESS	○---○
POINT OF ACCESS	X
FENCE LINE	X---X---X---X
STONE WALL	○---○---○---○
TRAVELED WAY	○---○---○---○
GUARD RAIL	○---○---○---○
RAILROAD	▬---▬---▬---▬
SURVEY LINE	---
CULVERT	---
POWER POLE	⊕
TELEPHONE POLE	⊗
TREES	⊙
CONTROL OF ACCESS	///
PROPERTY LINE	P
R.O.W. LINE	---
SLOPE RIGHTS	SR
TOP OF CUT	△
TOE OF SLOPE	○


SURVEYED BY : DUBOIS & KING, INC.
SURVEYED DATE : OCT-31-00

DATUM
VERTICAL NAVD 88
HORIZONTAL NAD 83

**STA 0+035.000
BEGIN PROJECT
ST. ALBANS
PARK & RIDE
CMG PARK (23) S**

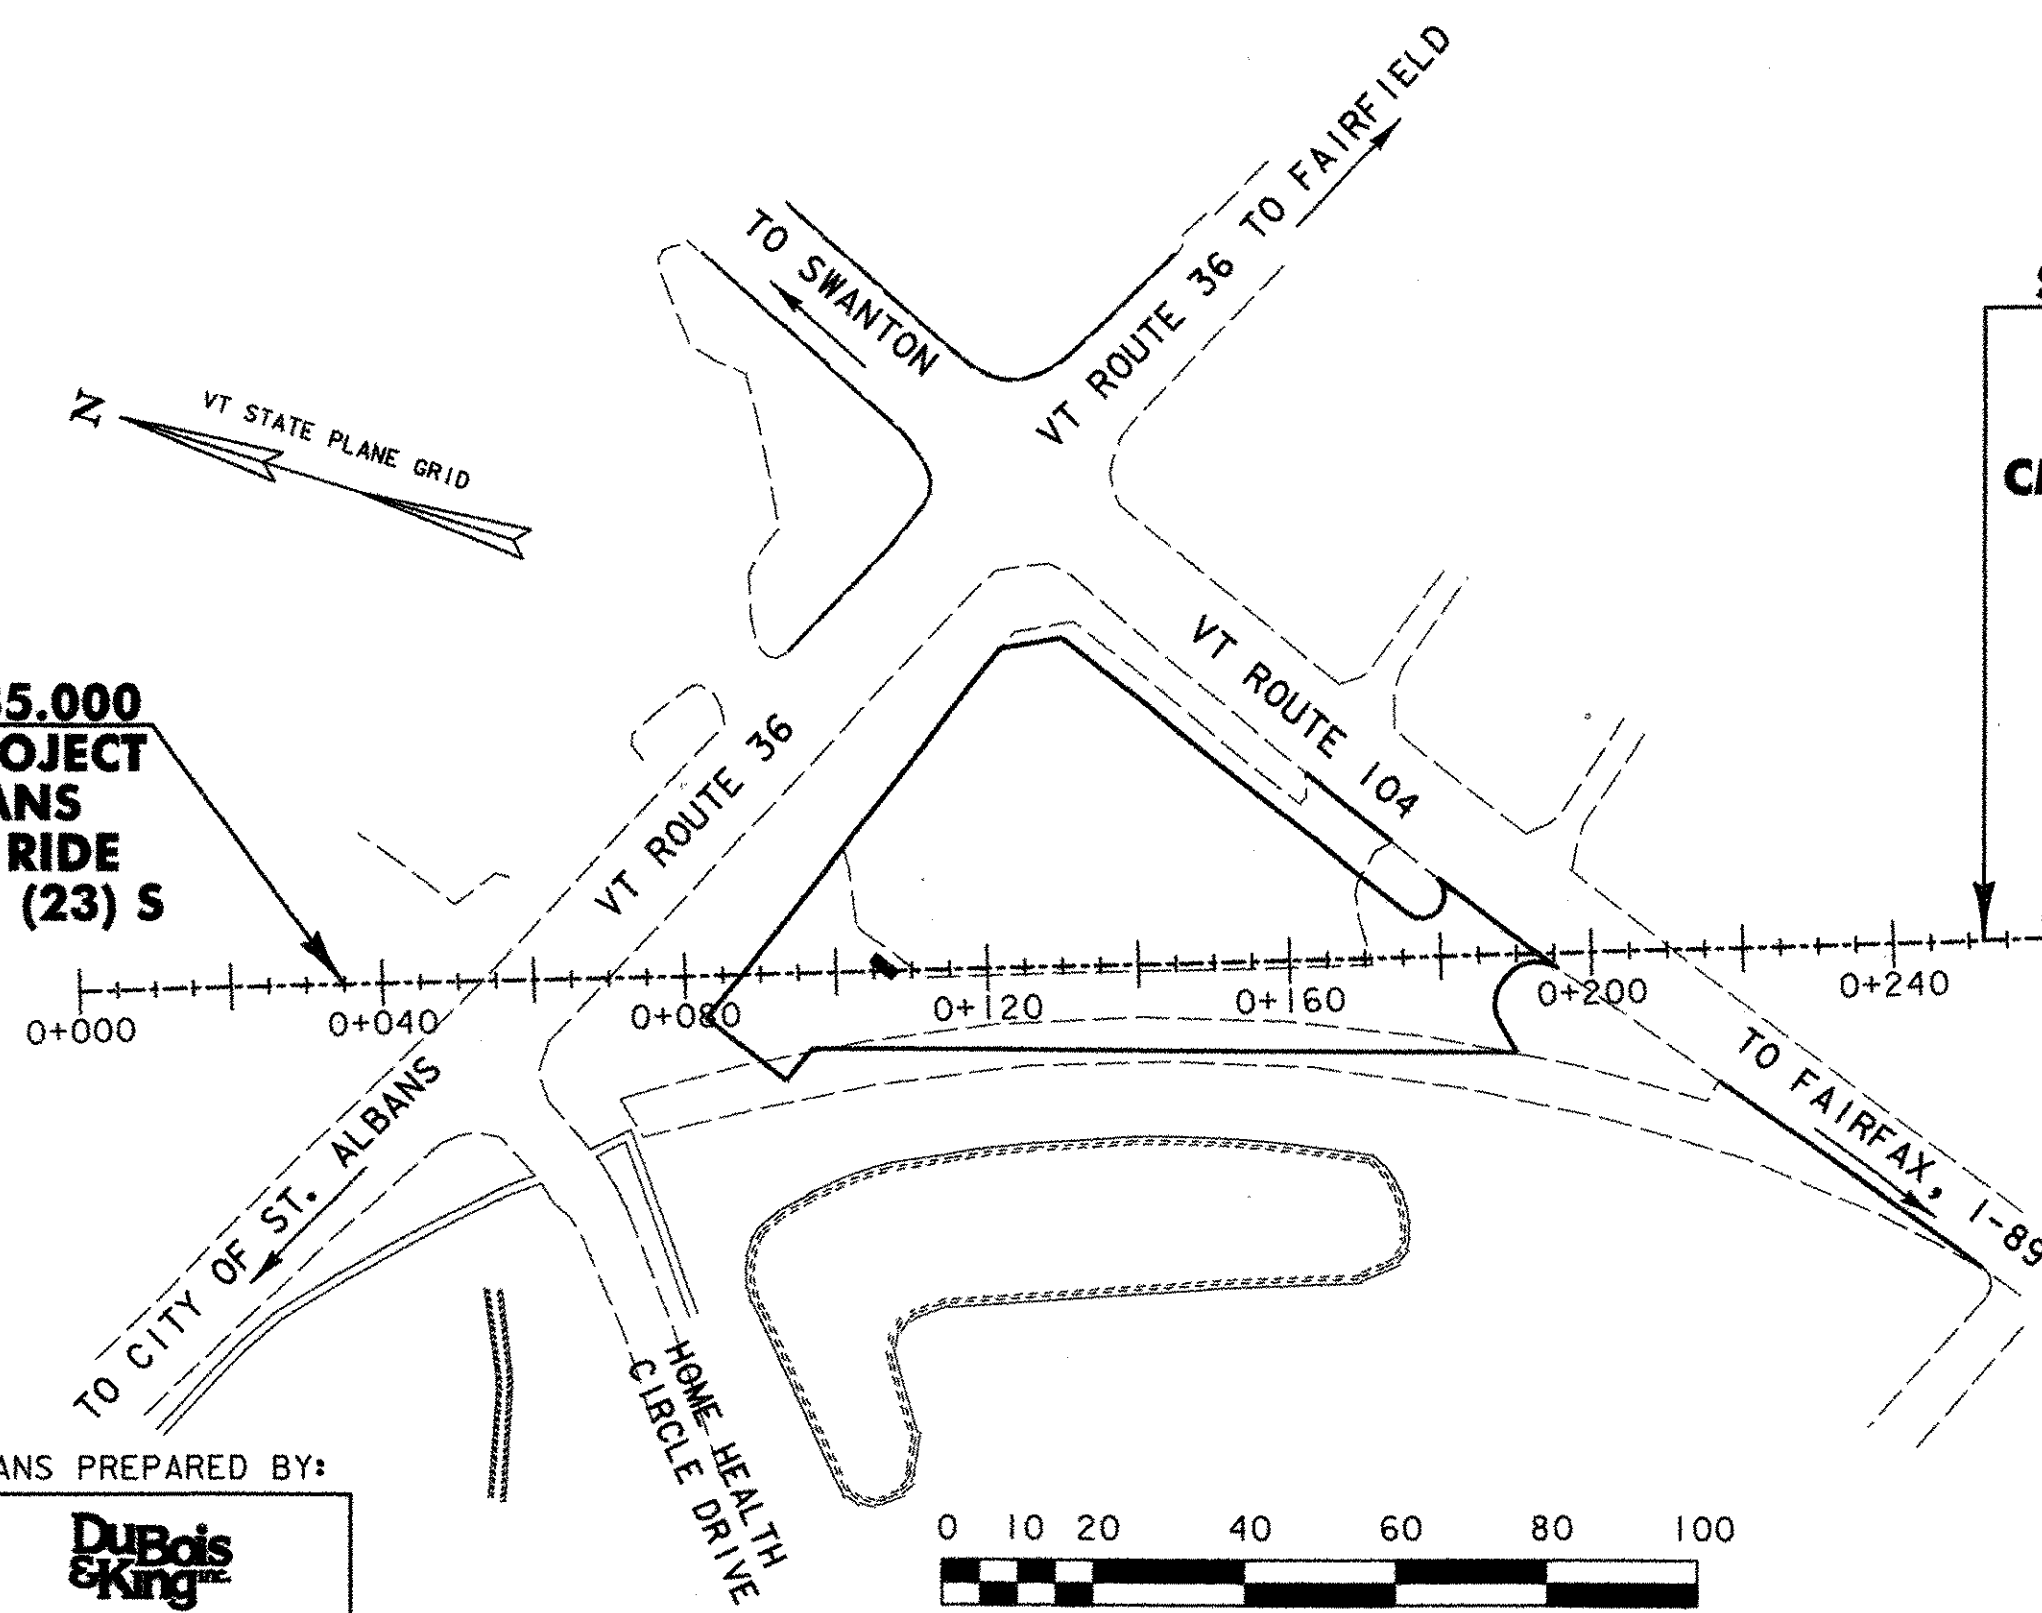

**STA 0+252.000
END PROJECT
ST. ALBANS
PARK & RIDE
CMG PARK (23) S**

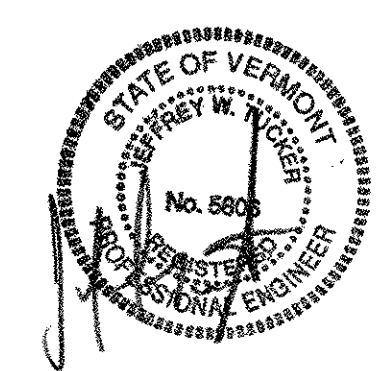

THESE PLANS ARE SUBJECT TO SUCH ENGINEERING CHANGES AS MAY BE REQUIRED BY THE FEDERAL HIGHWAY ADMINISTRATION OR THE DIRECTOR OF PROGRAM DEVELOPMENT.


CONSTRUCTION IS TO BE CARRIED ON IN ACCORDANCE WITH THESE PLANS AND THE STANDARD SPECIFICATIONS FOR CONSTRUCTION DATED 2001, AS APPROVED BY THE FEDERAL HIGHWAY ADMINISTRATION ON JANUARY 04, 2001 FOR USE ON THIS PROJECT, INCLUDING ALL SUBSEQUENT REVISIONS AND SUCH REVISED SPECIFICATIONS AND SPECIAL PROVISIONS AS ARE INCORPORATED IN THESE PLANS.

BUILT AS DESIGNED

Metric

UNLESS NOTED OTHERWISE
STATIONS ARE IN KILOMETERS
ELEVATIONS ARE IN METERS
DIMENSIONS ARE IN MILLIMETERS

DEPARTMENT OF TRANSPORTATION FEDERAL HIGHWAY ADMINISTRATOR	
APPROVED _____	DATE _____
DIRECTOR OF PROGRAM DEVELOPMENT	
APPROVED <i>Richard J. Stewart</i>	DATE <i>10-17-05</i>
PROJECT MANAGER: <i>Wayne L. Davis</i>	
PROJECT NAME : ST. ALBANS PARK & RIDE	
PROJECT NUMBER : CMG PARK (23) S	
SHEET 1 OF 29 SHEETS	

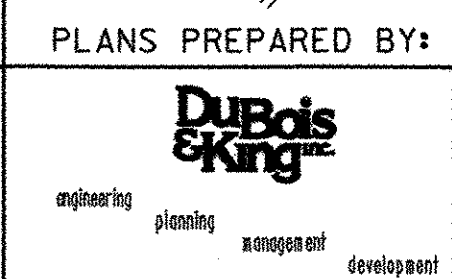

PLOTTED 10/14/2005