


**STA 0+252.000  
END PROJECT  
ST. ALBANS  
PARK & RIDE  
CMG PARK (23)S**

DATUM  
VERTICAL NAVD 88  
HORIZONTAL NAD 83

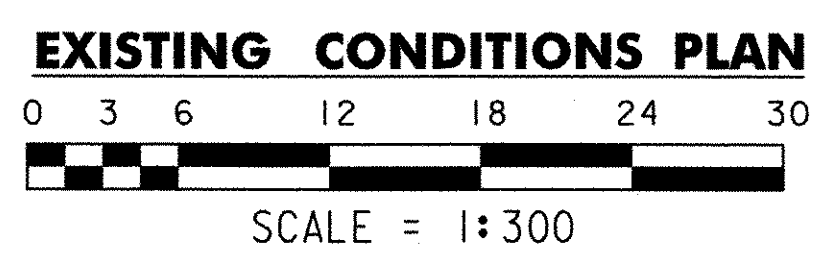

PROJECT NAME: ST. ALBANS PARK & RIDE	
PROJECT NUMBER: CMG PARK (23)S	
FILE NAME:	PLOT DATE: 10/14/2005
PROJECT LEADER: JWT	DRAWN BY: PGJ
DESIGNED BY: PGJ	CHECKED BY: EPD
EXISTING CONDITIONS PLAN	SHEET 6 OF 29

10/14/2005 11:53:54 AM  
 10/14/2005 11:53:54 AM