


LEGEND

- EXISTING WATERLINE
- NEW GRASS SWALE
- EXISTING CATCH BASIN
- NEW CATCH BASIN
- EXISTING DECIDUOUS TREE
- NEW DECIDUOUS TREE
- NEW EVERGREEN SHRUB
- EXISTING LIGHT POLE
- RELOCATED LIGHT POLE
- NEW LIGHT POLE
- SILT FENCE
- TEMPORARY STONE CHECK DAM
- EROSION MATTING

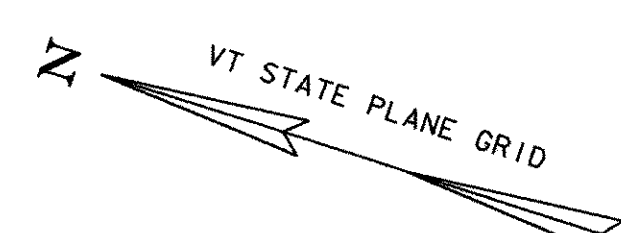

STA 0+035.000
BEGIN PROJECT
ST. ALBANS
PARK & RIDE
CMG PARK (23)S

STA 0+252.000
END PROJECT
ST. ALBANS
PARK & RIDE
CMG PARK (23)S

EROSION CONTROL PLAN
 0 3 6 12 18 24 30
 SCALE = 1:300

DATUM
 VERTICAL NAVD 88
 HORIZONTAL NAD 83

PROJECT NAME: ST. ALBANS PARK & RIDE	
PROJECT NUMBER: CMG PARK (23)S	
FILE NAME:	PLOT DATE: 10/14/2005
PROJECT LEADER: JWT	DRAWN BY: PGJ
DESIGNED BY: PGJ	CHECKED BY: EPD
EROSION CONTROL PLAN	
SHEET 11 OF 29	