


SITE LIGHTING SHEET

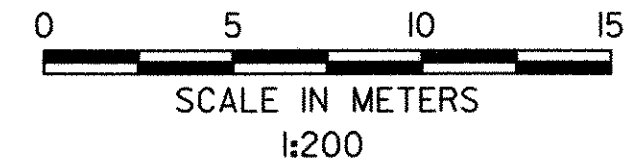

LEGEND

- EXISTING EDGE OF PAVEMENT
- PROPOSED EDGE OF PAVEMENT
- EXISTING LIGHT POLE
- EXISTING RELOCATED LIGHT POLE
- NEW LIGHT POLE

DATUM	
VERTICAL	NAVD 88
HORIZONTAL	NAD 83

SITE LIGHTING LOCATIONS						
POLE NO.	LOCATION	HEIGHT	SUPPORT ARM / LENGTH	LUMINAIRE	CONCRETE BASE	REMARKS
				WATTS TYPE	DIA. x DEEP x ABOVE GROUND	
①	STA. 0+094.702 LT 10.261 m	8382	100 SQUARE POLE ARM / 7620	150 III	610 X 1830 X 762	NEW
②	STA. 0+097.815 RT 12.805 m	8382	100 SQUARE POLE ARM / 7620	150 III	610 X 1830 X 762	NEW
③	STA. 0+121.306 RT 13.566 m	8382	100 SQUARE POLE ARM / 7620	150 III	610 X 1830 X 762	RELOCATED
④	STA. 0+136.925 LT 11.827 m	8382	100 SQUARE POLE ARM / 7620	150/150 III	610 X 1830 X 762	NEW DUAL LUMINAIRE
⑤	STA. 0+144.844 RT 14.329 m	8382	100 SQUARE POLE ARM / 7620	150 III	610 X 1830 X 762	RELOCATED
⑥	STA. 0+168.426 RT 15.093 m	8382	100 SQUARE POLE ARM / 7620	150 III	610 X 1830 X 762	RELOCATED
⑦	STA. 0+191.783 RT 13.863 m	8382	100 SQUARE POLE ARM / 7620	150 III	610 X 1830 X 762	NEW
⑧	STA. 0+167.515 LT 14.159 m	8382	100 SQUARE POLE ARM / 7620	150 III	610 X 1830 X 762	NEW
⑨	STA. 0+148.478 LT 29.770 m	8382	100 SQUARE POLE ARM / 7620	150 III	610 X 1830 X 762	NEW
⑩	STA. 0+126.704 LT 43.068 m	8382	100 SQUARE POLE ARM / 7620	150 III	610 X 1830 X 762	RELOCATED
⑪	STA. 0+109.842 LT 27.736 m	8382	100 SQUARE POLE ARM / 7620	150 III	610 X 1830 X 762	EXISTING

PROJECT NAME:	ST. ALBANS PARK & RIDE
PROJECT NUMBER:	CMG PARK (23S)
FILE NAME:	PLOT DATE: 10/14/2005
PROJECT LEADER: JWT	DRAWN BY: PGJ
DESIGNED BY: PGJ	CHECKED BY: EPD
SITE LIGHTING SHEET	SHEET 14 OF 29