


DATUM
 VERTICAL NAVD 88
 HORIZONTAL NAD 83

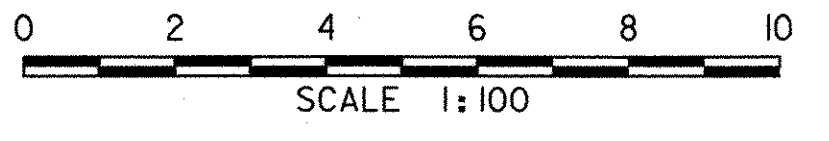

PROJECT NAME: ST. ALBANS PARK & RIDE
 PROJECT NUMBER: CMG PARK (23)S
 FILE NAME:
 PROJECT LEADER: JWT
 DRAWN BY: PGJ
 DESIGNED BY: PGJ
 CHECKED BY: EPD
 CROSS SECTION SHEET
 PLOT DATE: 10/14/2005
 SHEET 27 OF 29