


DATUM
 VERTICAL NAVD 88
 HORIZONTAL NAD 83

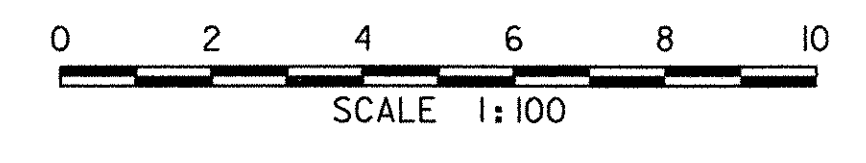

PROJECT NAME: ST. ALBANS PARK & RIDE
 PROJECT NUMBER: CMG PARK (23)S
 FILE NAME: PLOT DATE: 10/14/2005
 PROJECT LEADER: JWT DRAWN BY: PGJ
 DESIGNED BY: PGJ CHECKED BY: EPD
 CROSS SECTION SHEET SHEET 28 OF 29