


- 646.402 DURABLE 4 INCH WHITE LINE, THERMOPLASTIC
MM 1.594 - MM 5.00 SOLID LT & RT
(WITH BREAKS OR RADII FOR TOWN HIGHWAYS)
- 646.412 DURABLE 4 INCH YELLOW LINE, THERMOPLASTIC
MM 1.594 - MM 5.00 SOLID LT & RT
(WITH CENTERLINE BREAKS FOR TOWN HIGHWAYS)
- 646.602 TEMPORARY 4 INCH WHITE LINE, PAINT
MM 1.594 - MM 5.00 SOLID LT & RT
(WITH BREAKS OR RADII FOR TOWN HIGHWAYS)
- 646.612 TEMPORARY 4 INCH YELLOW LINE, PAINT
MM 1.594 - MM 5.00 SOLID LT & RT
(WITH CENTERLINE BREAKS FOR TOWN HIGHWAYS)

⊙ PROJECT MILE MARKERS DID NOT MATCH UP WITH ONES ON THESE "PLANS"

NOTE:
SEE SHEET 29 FOR TOWN HIGHWAY SIGNING AND MARKING SHEET

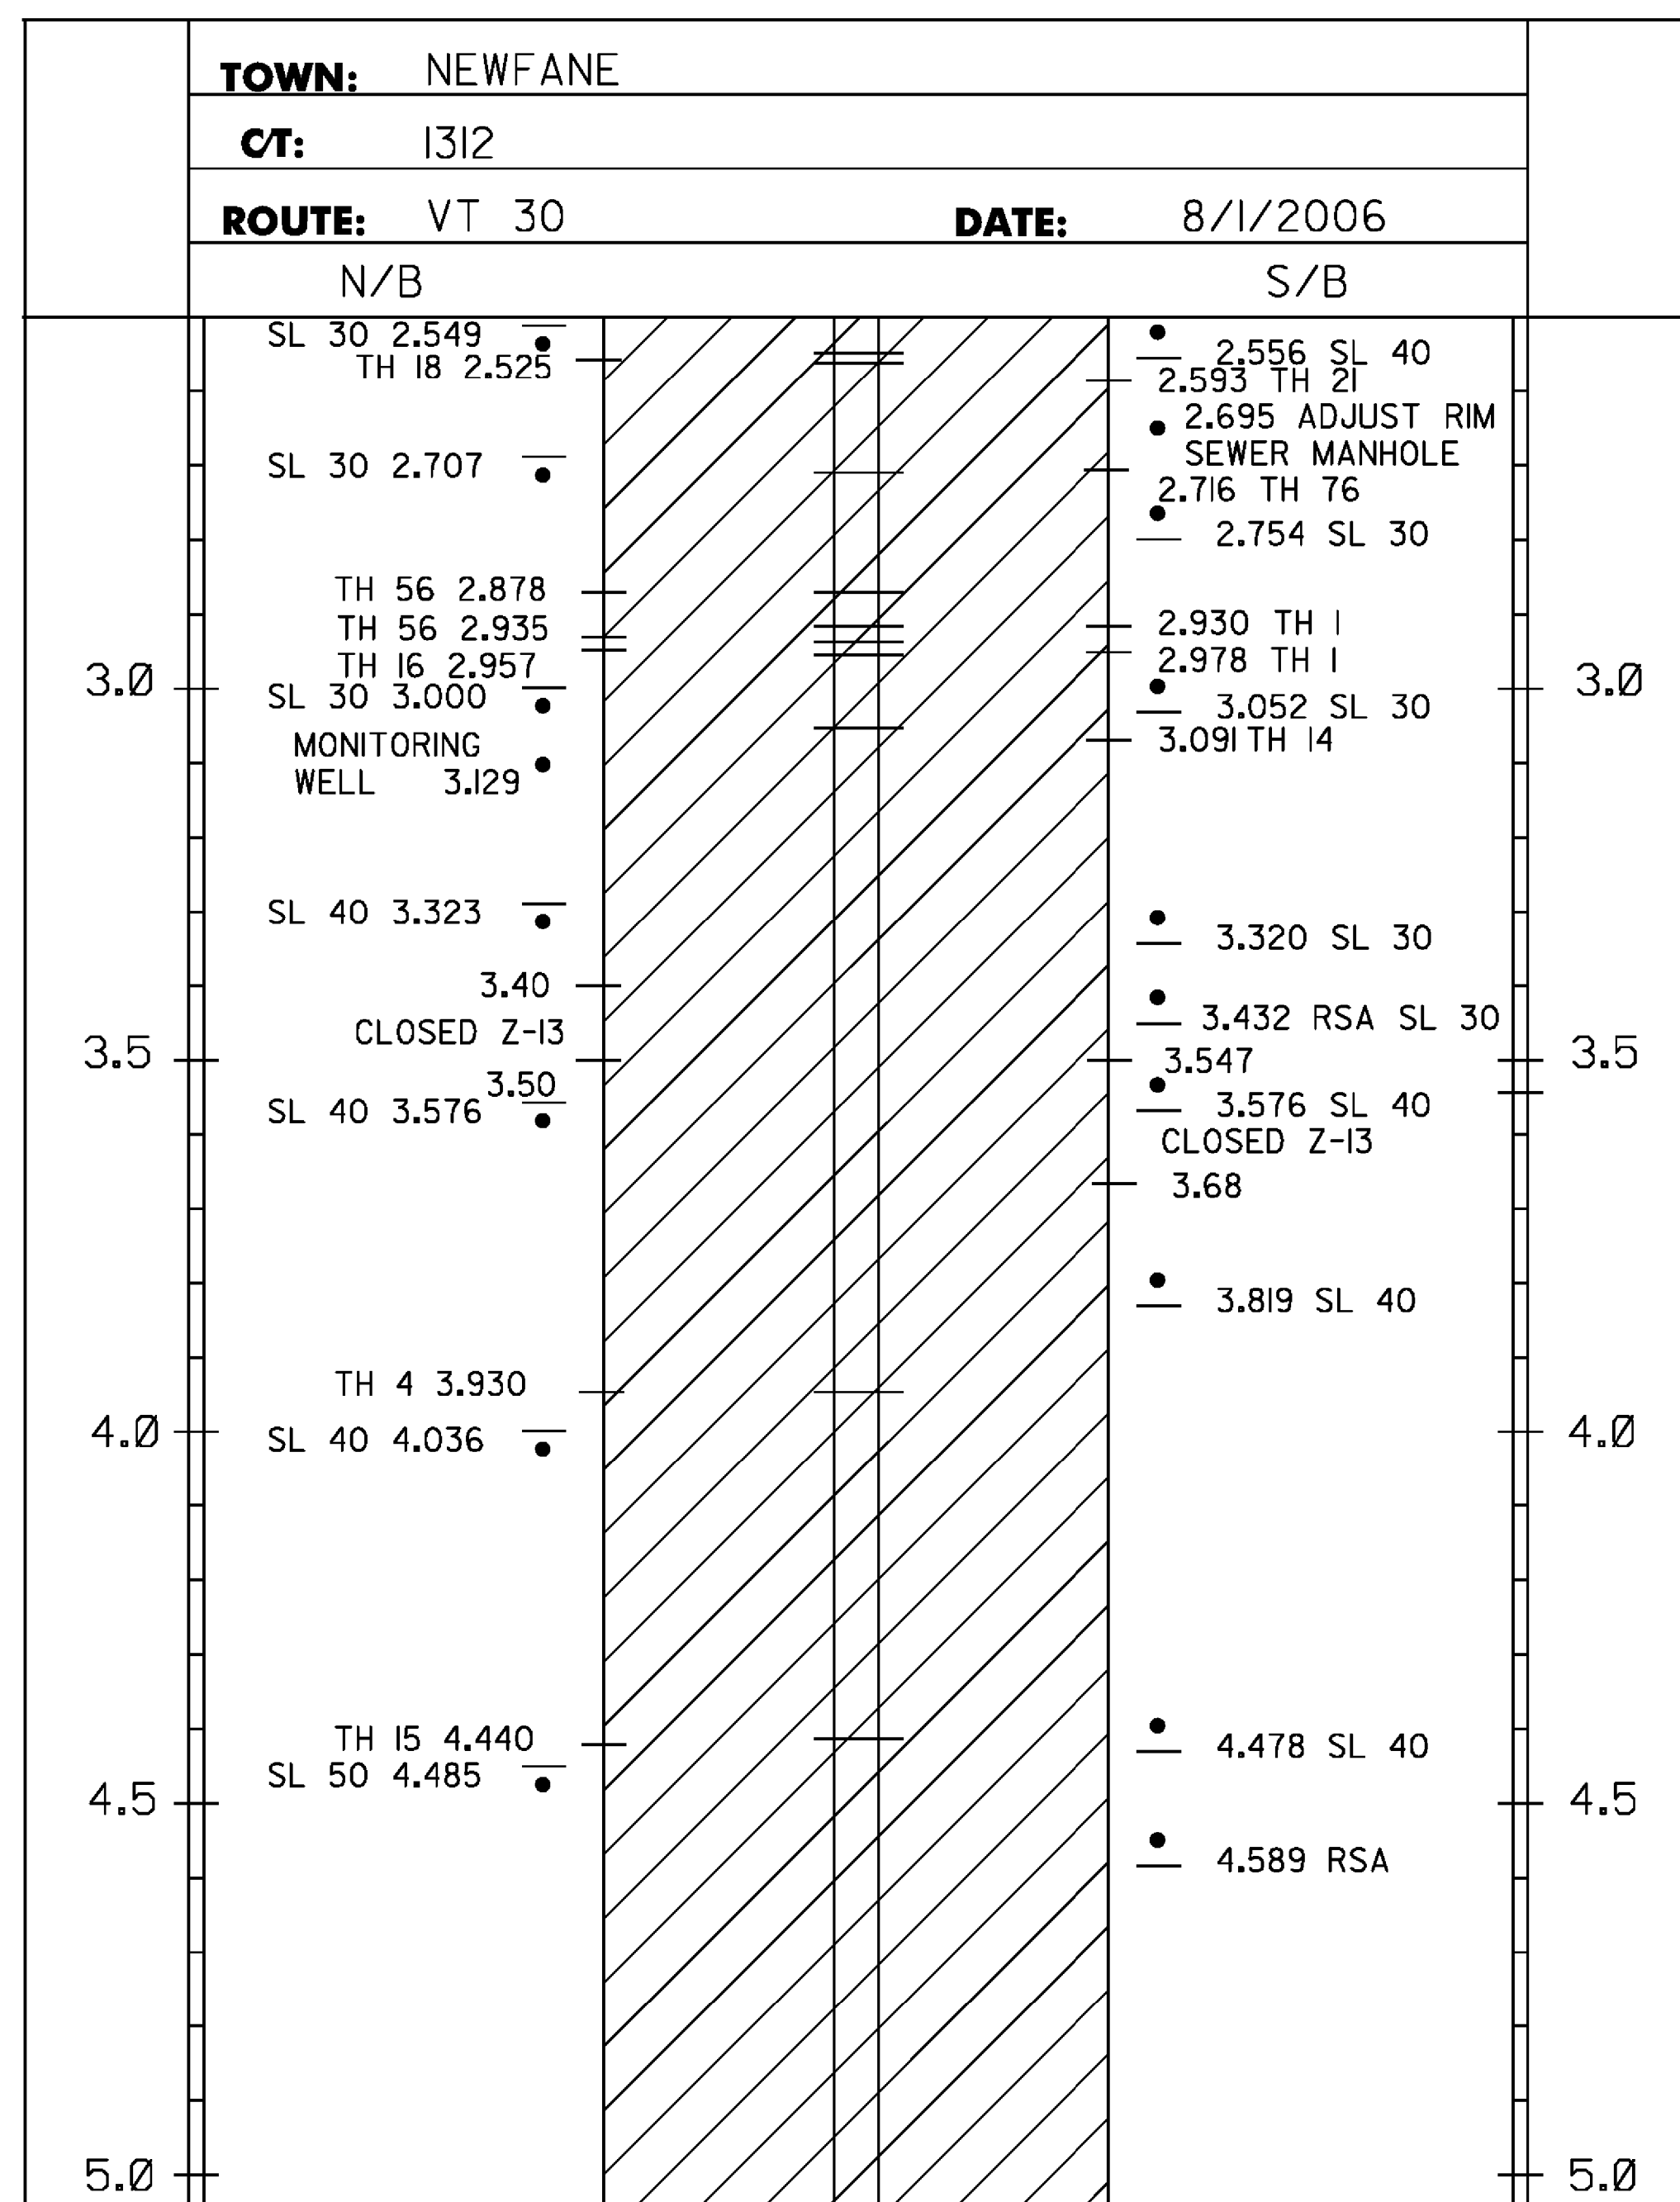

NOTES:
THIS SHEET TO BE USED FOR THE LAYOUT OF ALL PAVEMENT MARKINGS. THE RESIDENT ENGINEER MAY CONTACT KEITH SWEET, PAVEMENT MARKINGS SUPERVISOR AT (802) 828-5573 FOR ASSISTANCE LAYING OUT THE CENTERLINE DURING CONSTRUCTION.

PROJECT LAYOUT SHEET 1

PROJECT NAME: NEWFANE-TOWNSHEND	
PROJECT NUMBER: STP 2401 (I)	
FILE NAME: p01b036.dgn	PLOT DATE: 04-FEB-2010
PROJECT LEADER: CRB	DRAWN BY: JBZ
DESIGNED BY: JBZ	CHECKED BY: BDB
IPARM FILE NAME: p01b036_20.1	SHEET 20 OF 32

NOT TO SCALE