

646.402 DURABLE 4 INCH WHITE LINE, THERMOPLASTIC
MM 5.000 - MM 5.662 SOLID LT & RT (NEWFANE)
MM 0.000 - MM 2.500 SOLID LT & RT (TOWNSHEND)
(WITH BREAKS OR RADII FOR TOWN HIGHWAYS)

646.412 DURABLE 4 INCH YELLOW LINE, THERMOPLASTIC
NEWFANE
MM 5.000 - MM 5.185 SOLID LT & RT
MM 5.185 - MM 5.340 SOLID LT, DASHED RT
MM 5.340 - MM 5.522 SOLID LT & RT
MM 5.522 - MM 5.653 SOLID LT, DASHED RT
MM 5.653 - MM 5.662 SOLID LT & RT
TOWNSHEND
MM 0.000 - MM 0.199 SOLID LT & RT
MM 0.199 - MM 0.295 SOLID LT, DASHED RT
MM 0.295 - MM 0.567 SOLID LT & RT
MM 0.567 - MM 0.692 SOLID LT, DASHED RT
MM 0.692 - MM 0.706 SOLID LT & RT
MM 0.706 - MM 0.814 DASHED LT, SOLID RT
MM 0.814 - MM 2.500 SOLID LT & RT
(WITH CENTERLINE BREAKS FOR TOWN HIGHWAYS)


646.492 DURABLE LETTER OR SYMBOL, THERMOPLASTIC
VT 30 MM 2.254 LT - *SCHOOL* 6 EA
(SEE SHEET 31 FOR NB STENCIL QUANTITIES)

646.602 TEMPORARY 4 INCH WHITE LINE, PAINT
MM 5.000 - MM 5.662 SOLID LT & RT (NEWFANE)
MM 0.000 - MM 2.500 SOLID LT & RT (TOWNSHEND)
(WITH BREAKS OR RADII FOR TOWN HIGHWAYS)

646.612 TEMPORARY 4 INCH YELLOW LINE, PAINT
NEWFANE
MM 5.000 - MM 5.185 SOLID LT & RT
MM 5.185 - MM 5.340 SOLID LT, DASHED RT
MM 5.340 - MM 5.522 SOLID LT & RT
MM 5.522 - MM 5.653 SOLID LT, DASHED RT
MM 5.653 - MM 5.662 SOLID LT & RT
TOWNSHEND
MM 0.000 - MM 0.199 SOLID LT & RT
MM 0.199 - MM 0.295 SOLID LT, DASHED RT
MM 0.295 - MM 0.567 SOLID LT & RT
MM 0.567 - MM 0.692 SOLID LT, DASHED RT
MM 0.692 - MM 0.706 SOLID LT & RT
MM 0.706 - MM 0.814 DASHED LT, SOLID RT
MM 0.814 - MM 2.500 SOLID LT & RT
(WITH CENTERLINE BREAKS FOR TOWN HIGHWAYS)

646.692 TEMPORARY LETTER OR SYMBOL, PAINT
VT 30 MM 2.254 LT - *SCHOOL* 6 EA
(SEE SHEET 31 FOR NB STENCIL QUANTITIES)

NOTES:
SEE INTERSECTION DETAIL SHEET 31 FOR
MM 1.965 - MM 2.122.
SEE SHEET 29 FOR TOWN HIGHWAY SIGNING
AND MARKING SHEET

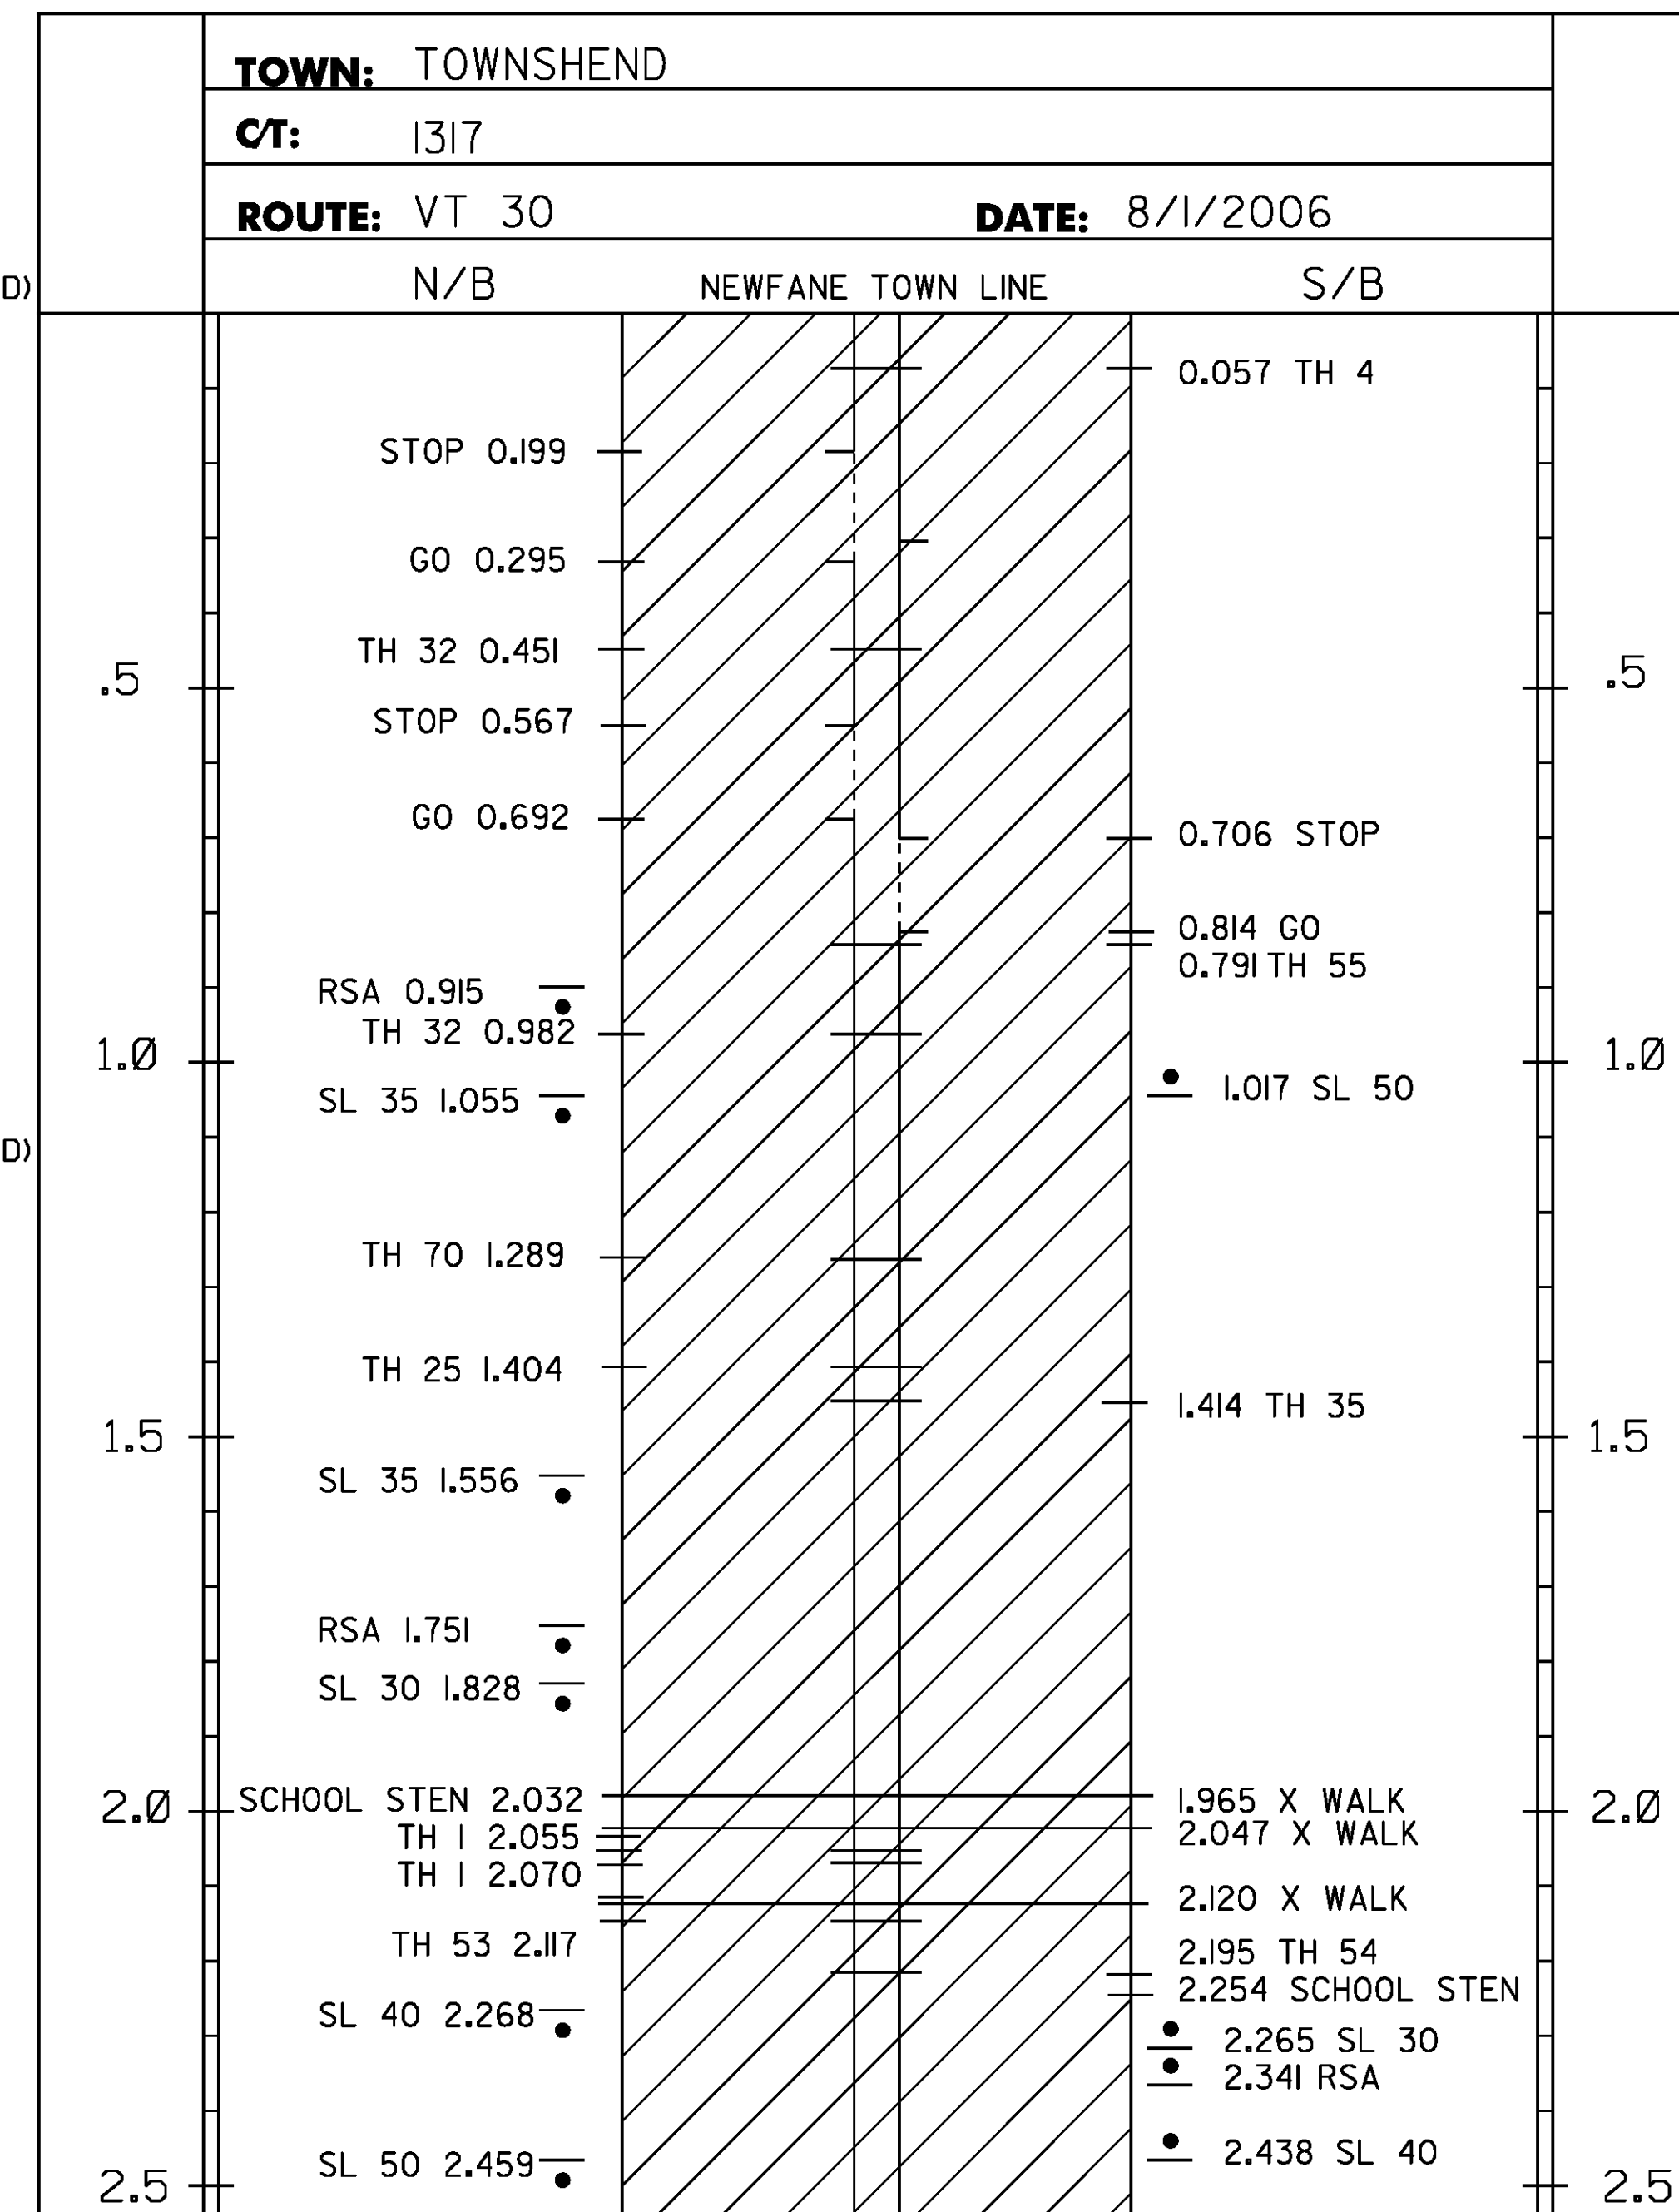

NOTES:
THIS SHEET TO BE USED FOR THE LAYOUT OF ALL PAVEMENT MARKINGS. THE RESIDENT ENGINEER MAY CONTACT KEITH SWEET,
PAVEMENT MARKINGS SUPERVISOR AT (802) 828-5573 FOR ASSISTANCE LAYING OUT THE CENTERLINE DURING CONSTRUCTION.

PROJECT LAYOUT SHEET 2

PROJECT NAME: NEWFANE-TOWNSHEND	
PROJECT NUMBER: STP 2401 (I)	
FILE NAME: p01b036.dgn	PLOT DATE: 04-FEB-2010
PROJECT LEADER: CRB	DRAWN BY: JBZ
DESIGNED BY: JBZ	CHECKED BY: BDB
IPARM FILE NAME: p01b036_21.I	SHEET 21 OF 32