


646.402 DURABLE 4 INCH WHITE LINE, THERMOPLASTIC
 MM 2.500 - MM 7.190 SOLID LT & RT
 (WITH BREAKS OR RADII FOR TOWN HIGHWAYS)

646.412 DURABLE 4 INCH YELLOW LINE, THERMOPLASTIC
 MM 2.500 - MM 2.990 SOLID LT & RT
 MM 2.990 - MM 3.108 SOLID LT, DASHED RT
 MM 3.108 - MM 3.130 SOLID LT & RT
 MM 3.130 - MM 3.255 DASHED LT, SOLID RT
 MM 3.255 - MM 3.685 SOLID LT & RT
 MM 3.685 - MM 3.813 SOLID LT, DASHED RT
 MM 3.813 - MM 3.827 SOLID LT & RT
 MM 3.827 - MM 3.952 DASHED LT, SOLID RT
 MM 3.952 - MM 4.378 SOLID LT & RT
 MM 4.378 - MM 4.523 SOLID LT, DASHED RT
 MM 4.523 - MM 4.547 DASHED RT
 MM 4.547 - MM 4.695 DASHED LT, SOLID RT
 MM 4.695 - MM 7.190 SOLID LT & RT
 (WITH CENTERLINE BREAKS FOR TOWN HIGHWAYS)

646.602 TEMPORARY 4 INCH WHITE LINE, PAINT
 MM 2.500 - MM 7.190 SOLID LT & RT
 (WITH BREAKS OR RADII FOR TOWN HIGHWAYS)

646.612 TEMPORARY 4 INCH YELLOW LINE, PAINT
 MM 2.500 - MM 2.990 SOLID LT & RT
 MM 2.990 - MM 3.108 SOLID LT, DASHED RT
 MM 3.108 - MM 3.130 SOLID LT & RT
 MM 3.130 - MM 3.255 DASHED LT, SOLID RT
 MM 3.255 - MM 3.685 SOLID LT & RT
 MM 3.685 - MM 3.813 SOLID LT, DASHED RT
 MM 3.813 - MM 3.827 SOLID LT & RT
 MM 3.827 - MM 3.952 DASHED LT, SOLID RT
 MM 3.952 - MM 4.378 SOLID LT & RT
 MM 4.378 - MM 4.523 SOLID LT, DASHED RT
 MM 4.523 - MM 4.547 DASHED RT
 MM 4.547 - MM 4.695 DASHED LT, SOLID RT
 MM 4.695 - MM 7.190 SOLID LT & RT
 (WITH CENTERLINE BREAKS FOR TOWN HIGHWAYS)

NOTE:
 SEE SHEET 29 FOR TOWN HIGHWAY
 SIGNING AND MARKING SHEET

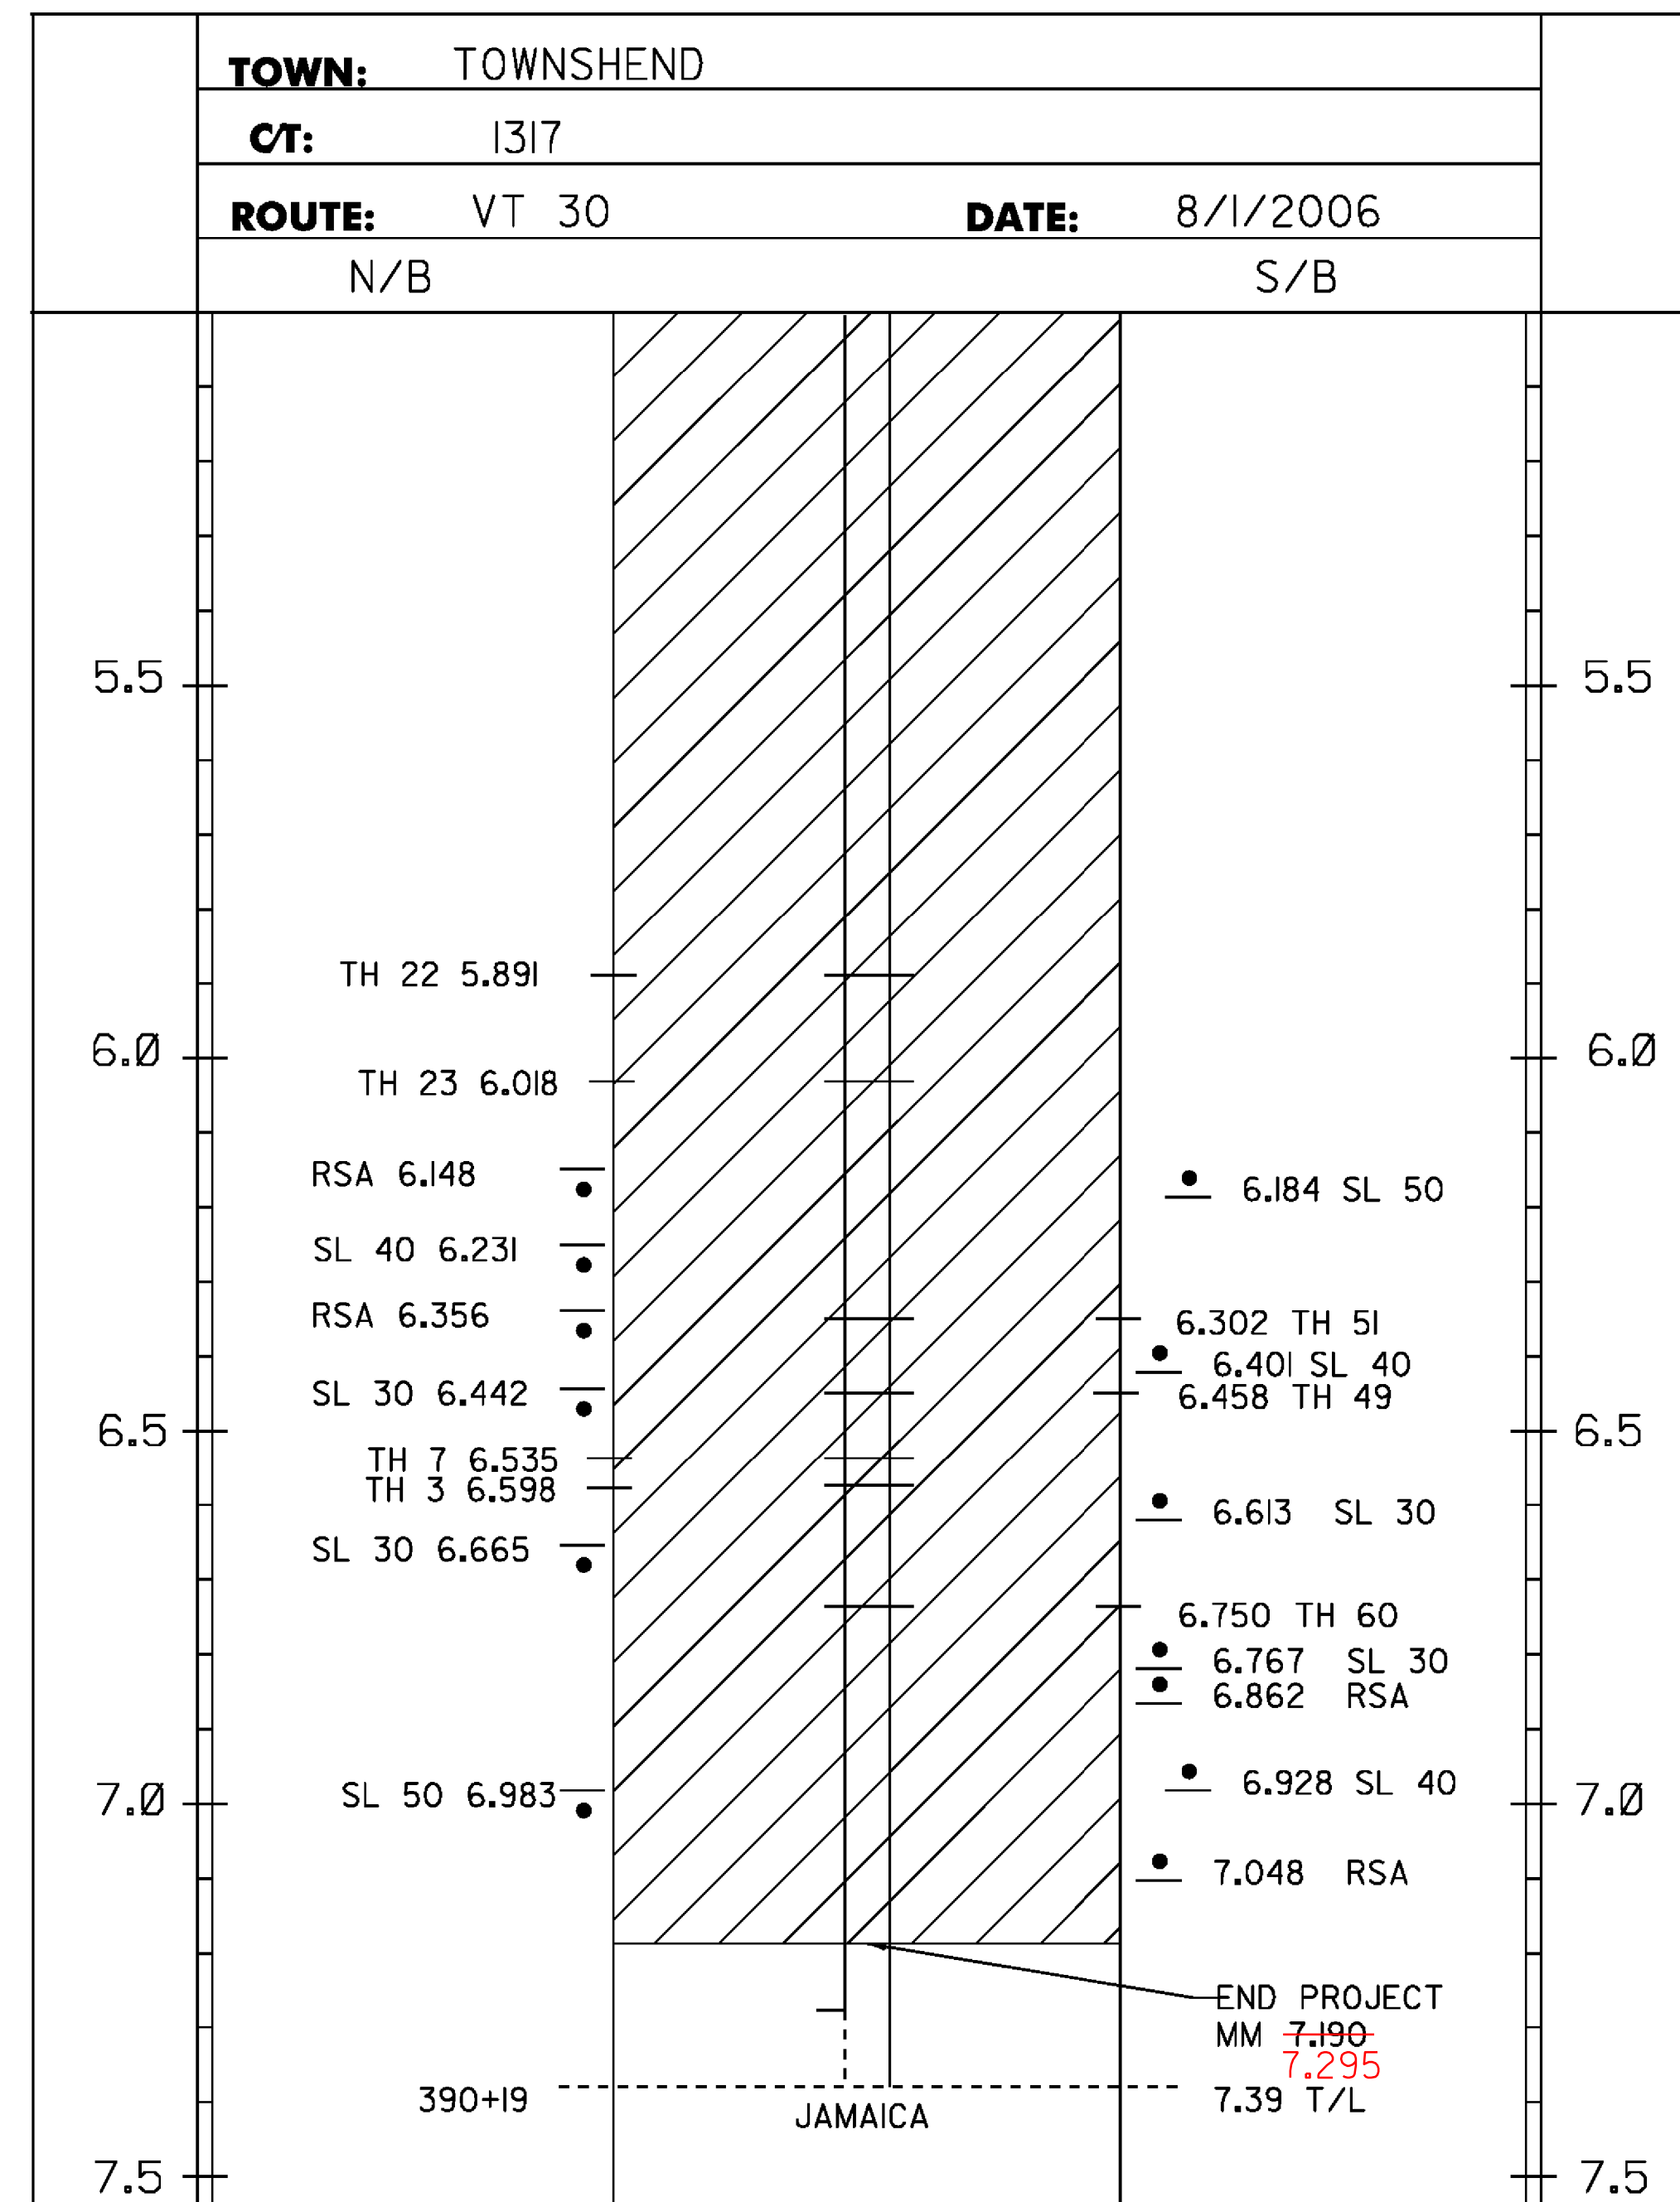

NOTES:
 THIS SHEET TO BE USED FOR THE LAYOUT OF ALL PAVEMENT MARKINGS. THE RESIDENT ENGINEER MAY CONTACT KEITH SWEET,
 PAVEMENT MARKINGS SUPERVISOR AT (802) 828-5573 FOR ASSISTANCE LAYING OUT THE CENTERLINE DURING CONSTRUCTION.

PROJECT LAYOUT SHEET 3

PROJECT NAME: NEWFANE-TOWNSHEND	
PROJECT NUMBER: STP 2401(I)	
FILE NAME: p01b036.dgn	PLOT DATE: 04-FEB-2010
PROJECT LEADER: CRB	DRAWN BY: JBZ
DESIGNED BY: JBZ	CHECKED BY: BDB
IPARM FILE NAME: p01b036_22.1	SHEET 22 OF 32