

TRAFFIC SIGN SUMMARY SHEET #3

MILEMARKER, STATION, OR SIGN NUMBER	SIGN LEGEND REMOVAL	SIGN DIMENSIONS		NEW & SALVAGED SIGNS				EXIST POST RETAIN SALVAGE	NO. OF POSTS	NEW SIGN POSTS														REMARKS	SIGN DETAIL					
		EA	WIDTH (In)	HEIGHT (In)	"A"	"B"	SALV SIGN			SALV TIS	SQUARE STEEL (In)				TUBULAR ALUMINUM (In)			TUBULAR STEEL (In)				W-SHAPE STEEL			DETAIL ON SHEET NUMBER	STD. SHEET NUMBER				
											1.75	2.0	2.5	ANCHOR	S U M M E R	FOUND- ATION	3.0	4.0	4.0 MOD	3.0	3.5	4.0	5.0				FTG. SIZE		WEIGHT	POST SIZE
											lb/ft						1.3	1.7	1.7								lb/ft			
1.88	2.42	3.35	1.3	1.7	1.7	7.6	9.0	10.8	14.6	24"	30"	WEIGHT	POST SIZE																	
NEWFANE MM 3.928 RT TH 4		1	24	30	5.00				1		12.5	X		X											VR-017	E-141				
NEWFANE MM 3.932 RT TH 4		2	30	30	6.25				1		14.0	X		X											RI-I	BACK TO BACK E-138				
NEWFANE MM 4.438 RT TH 15		1	24	30	5.00		I		1		13.5	X		X											VR-017	UPPER RIVER RD E-141				
NEWFANE MM 4.443 RT TH 15		2	30	30	6.25				1		13.75	X		X											RI-I	BACK TO BACK E-138				
TOWNSHEND MM 0.055 LT TH 4		2	30	30	6.25				1		13.5	X		X											RI-I	BACK TO BACK E-138				
TOWNSHEND MM 0.060 LT TH 4		1	24	30	5.00				1		12.5	X		X											VR-017	E-141				
TOWNSHEND MM 0.449 RT TH 32		1	24	30	5.00				1		12.5	X		X											VR-017	E-141				
TOWNSHEND MM 0.454 RT TH 32		1	30	30	6.25				1		13.25	X		X											RI-I					
TOWNSHEND MM 0.789 LT TH 55		2	30	30	6.25				1		13.5	X		X											RI-I	BACK TO BACK E-138				
TOWNSHEND MM 0.794 LT TH 55		1	24	30	5.00				1		13.5	X		X											VR-017	E-141				
TOWNSHEND MM 0.980 RT TH 32		1	24	30	5.00				1		14.5	X		X											VR-017	E-141				
TOWNSHEND MM 0.985 RT TH 32		2	30	30	6.25				1		13.75	X		X											RI-I	BACK TO BACK E-138				
TOWNSHEND MM 0.060 LT							I				12.5	X																		

FINAL POST LENGTHS ARE TO BE DETERMINED IN THE FIELD. POST SIZES ARE COMPUTED BASED ON INFORMATION FURNISHED ON THE STANDARD SHEETS AND VTRANS "SIGN POST DESIGN GUIDELINE."

SHEET TOTALS

SF 69.60

SF

EA. 2

EA.

EA.


EA.

EA.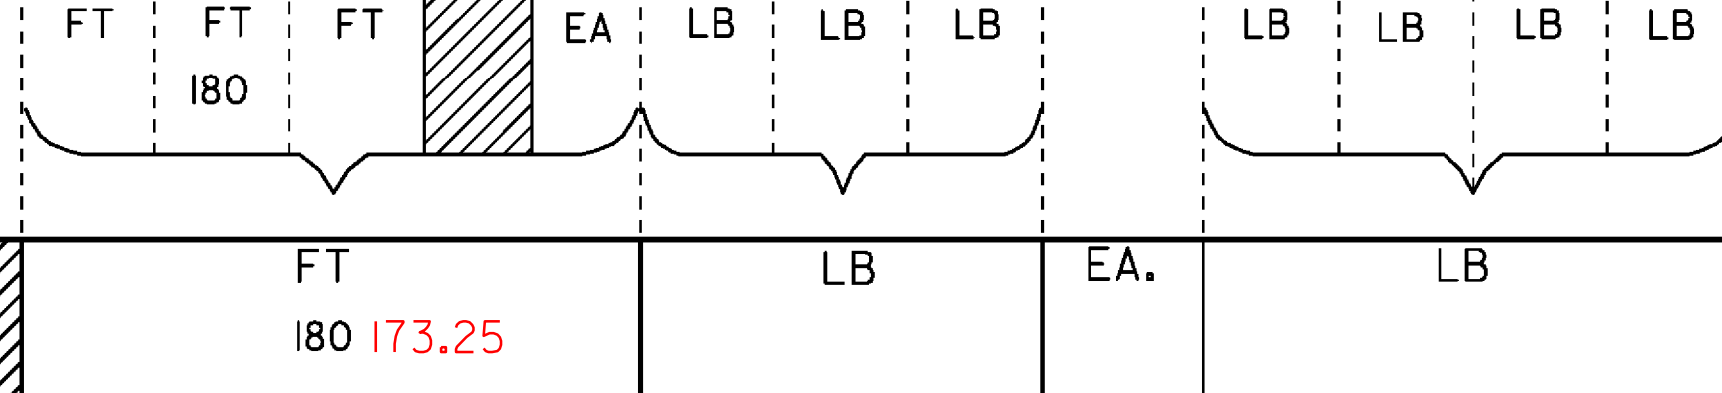

TRAFFIC SIGN SUMMARY SHEET #3

PROJECT NAME: NEWFANE-TOWNSHEND
PROJECT NUMBER: STP 240I (I)
FILE NAME: p0lb036.dgn
DESIGNED BY: JBZ
IPARM FILE NAME: p0lb036_25.1
PLOT DATE: 04-FEB-2010
DRAWN BY: JBZ
CHECKED BY: BDB
SHEET 25 OF 32