

TRAFFIC SIGN SUMMARY SHEET #4

MILEMARKER, STATION, OR SIGN NUMBER	SIGN LEGEND REMOVAL	SIGN DIMENSIONS		NEW & SALVAGED SIGNS				EXIST POST RETAIN SALVAGE	NO. OF POSTS	NEW SIGN POSTS														REMARKS	SIGN DETAIL					
		EA	WIDTH (In)	HEIGHT (In)	"A"	"B"	SALV SIGN			SALV TIS	SQUARE STEEL (In)				TUBULAR ALUMINUM Ø (In)			TUBULAR STEEL Ø (In)				W-SHAPE STEEL			DETAIL ON SHEET NUMBER	STD. SHEET NUMBER				
											1.75	2.0	2.5	ANCHOR	S U M M E R	FOUND-ATION	3.0	4.0	4.0 MOD	3.0	3.5	4.0	5.0				FTG. SIZE		WEIGHT	POST SIZE
											lb/ft						1.3	1.7	1.7								lb/ft			
1.88	2.42	3.35	1.3	1.7	1.7	7.6	9.0	10.8	14.6	24"	30"	WEIGHT	POST SIZE																	
TOWNSHEND MM 1.287 RT TH 70		1	24	30	5.00				1		15.5	X		X										VR-017	E-141					
		1																						SALVAGE EXISTING SIGN MOUNT BELOW LEGAL LOAD LIMIT SIGN						
TOWNSHEND MM 1.292 RT TH 70		2	30	30	6.25				1		13.5	X		X										RI-1	BACK TO BACK	E-138				
TOWNSHEND MM 1.402 RT TH 25		1	24	30	5.00				1		14.75	X		X										VR-017	E-141					
TOWNSHEND MM 1.407 RT TH 25		2	30	30	6.25				1		12.5	X		X										RI-1	BACK TO BACK	E-138				
TOWNSHEND MM 1.412 LT TH 35		2	30	30	6.25				1		13.5	X		X										RI-1	BACK TO BACK	E-138				
TOWNSHEND MM 1.417 LT TH 35		1	24	30	5.00				1		13.5	X		X										VR-017	E-141					
TOWNSHEND MM 1.965 RT VT 30		1	30	30	6.25				1		15	X		X										WII-2	FLUORESCENT YELLOW GREEN	E-152				
		1	24	12	2.00																			W16-7P	FLUORESCENT YELLOW GREEN	E-152				
TOWNSHEND MM 1.970 LT VT 30		1	30	30	6.25				1		15	X		X										WII-2	FLUORESCENT YELLOW GREEN	E-152				
		1	24	12	2.00																			W16-7P	FLUORESCENT YELLOW GREEN	E-152				
TOWNSHEND MM 2.050 RT TH 1		2	30	30	6.25				1		13.5	X		X										RI-1	BACK TO BACK	E-138				
TOWNSHEND MM 2.053 RT TH 1		1	30	30	6.25				1		13.5	X		X										RI-1						

FINAL POST LENGTHS ARE TO BE DETERMINED IN THE FIELD. POST SIZES ARE COMPUTED BASED ON INFORMATION FURNISHED ON THE STANDARD SHEETS AND VTRANS "SIGN POST DESIGN GUIDELINE."

SHEET TOTALS

SF 64.43

SF

EA. 1

EA.

EA.


EA.

EA.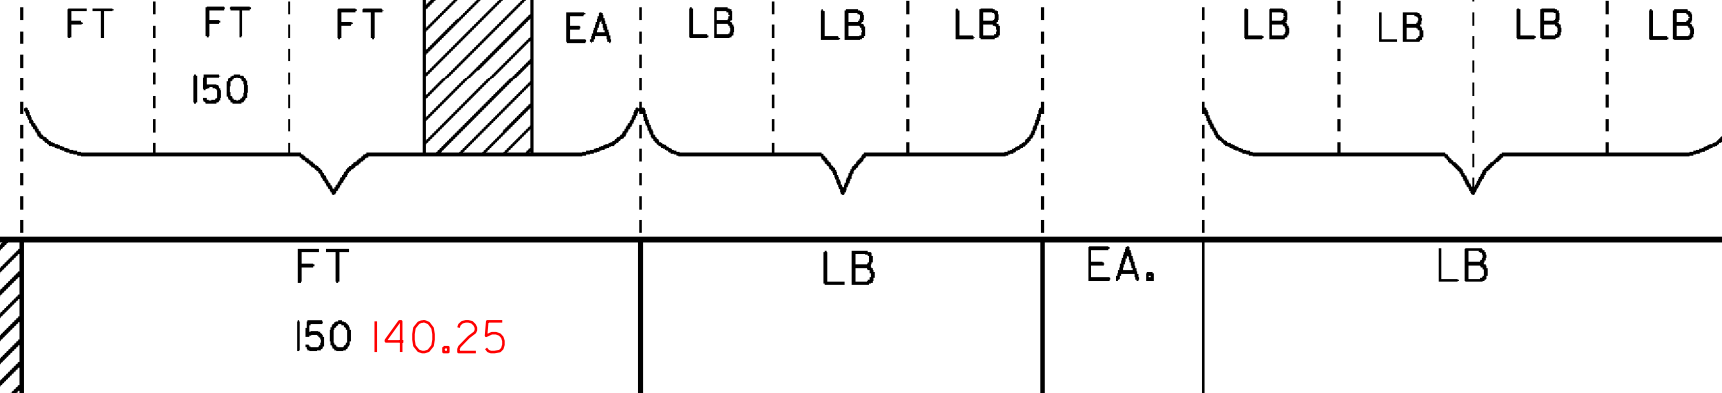

TRAFFIC SIGN SUMMARY SHEET #4

PROJECT NAME: NEWFANE-TOWNSHEND
PROJECT NUMBER: STP 2401(I)
FILE NAME: p0lb036.dgn
DESIGNED BY: JBZ
IPARM FILE NAME: p0lb036_26.1
PLOT DATE: 04-FEB-2010
DRAWN BY: JBZ
CHECKED BY: BDB
SHEET 26 OF 32