




VT ROUTE 35/121 PROFILE

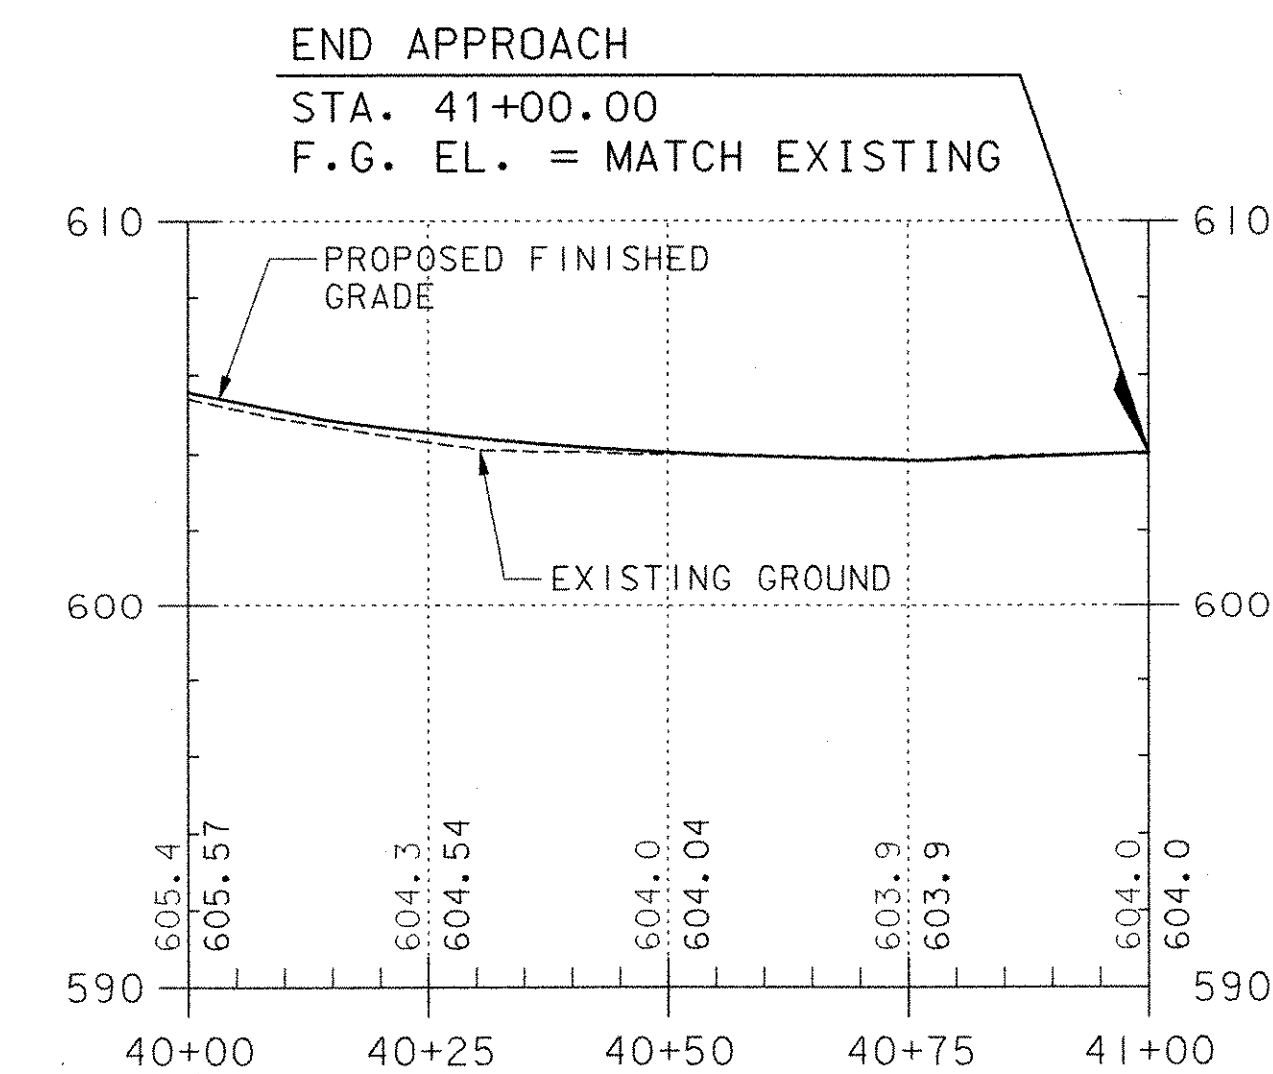

PARKER HILL ROAD PROFILE

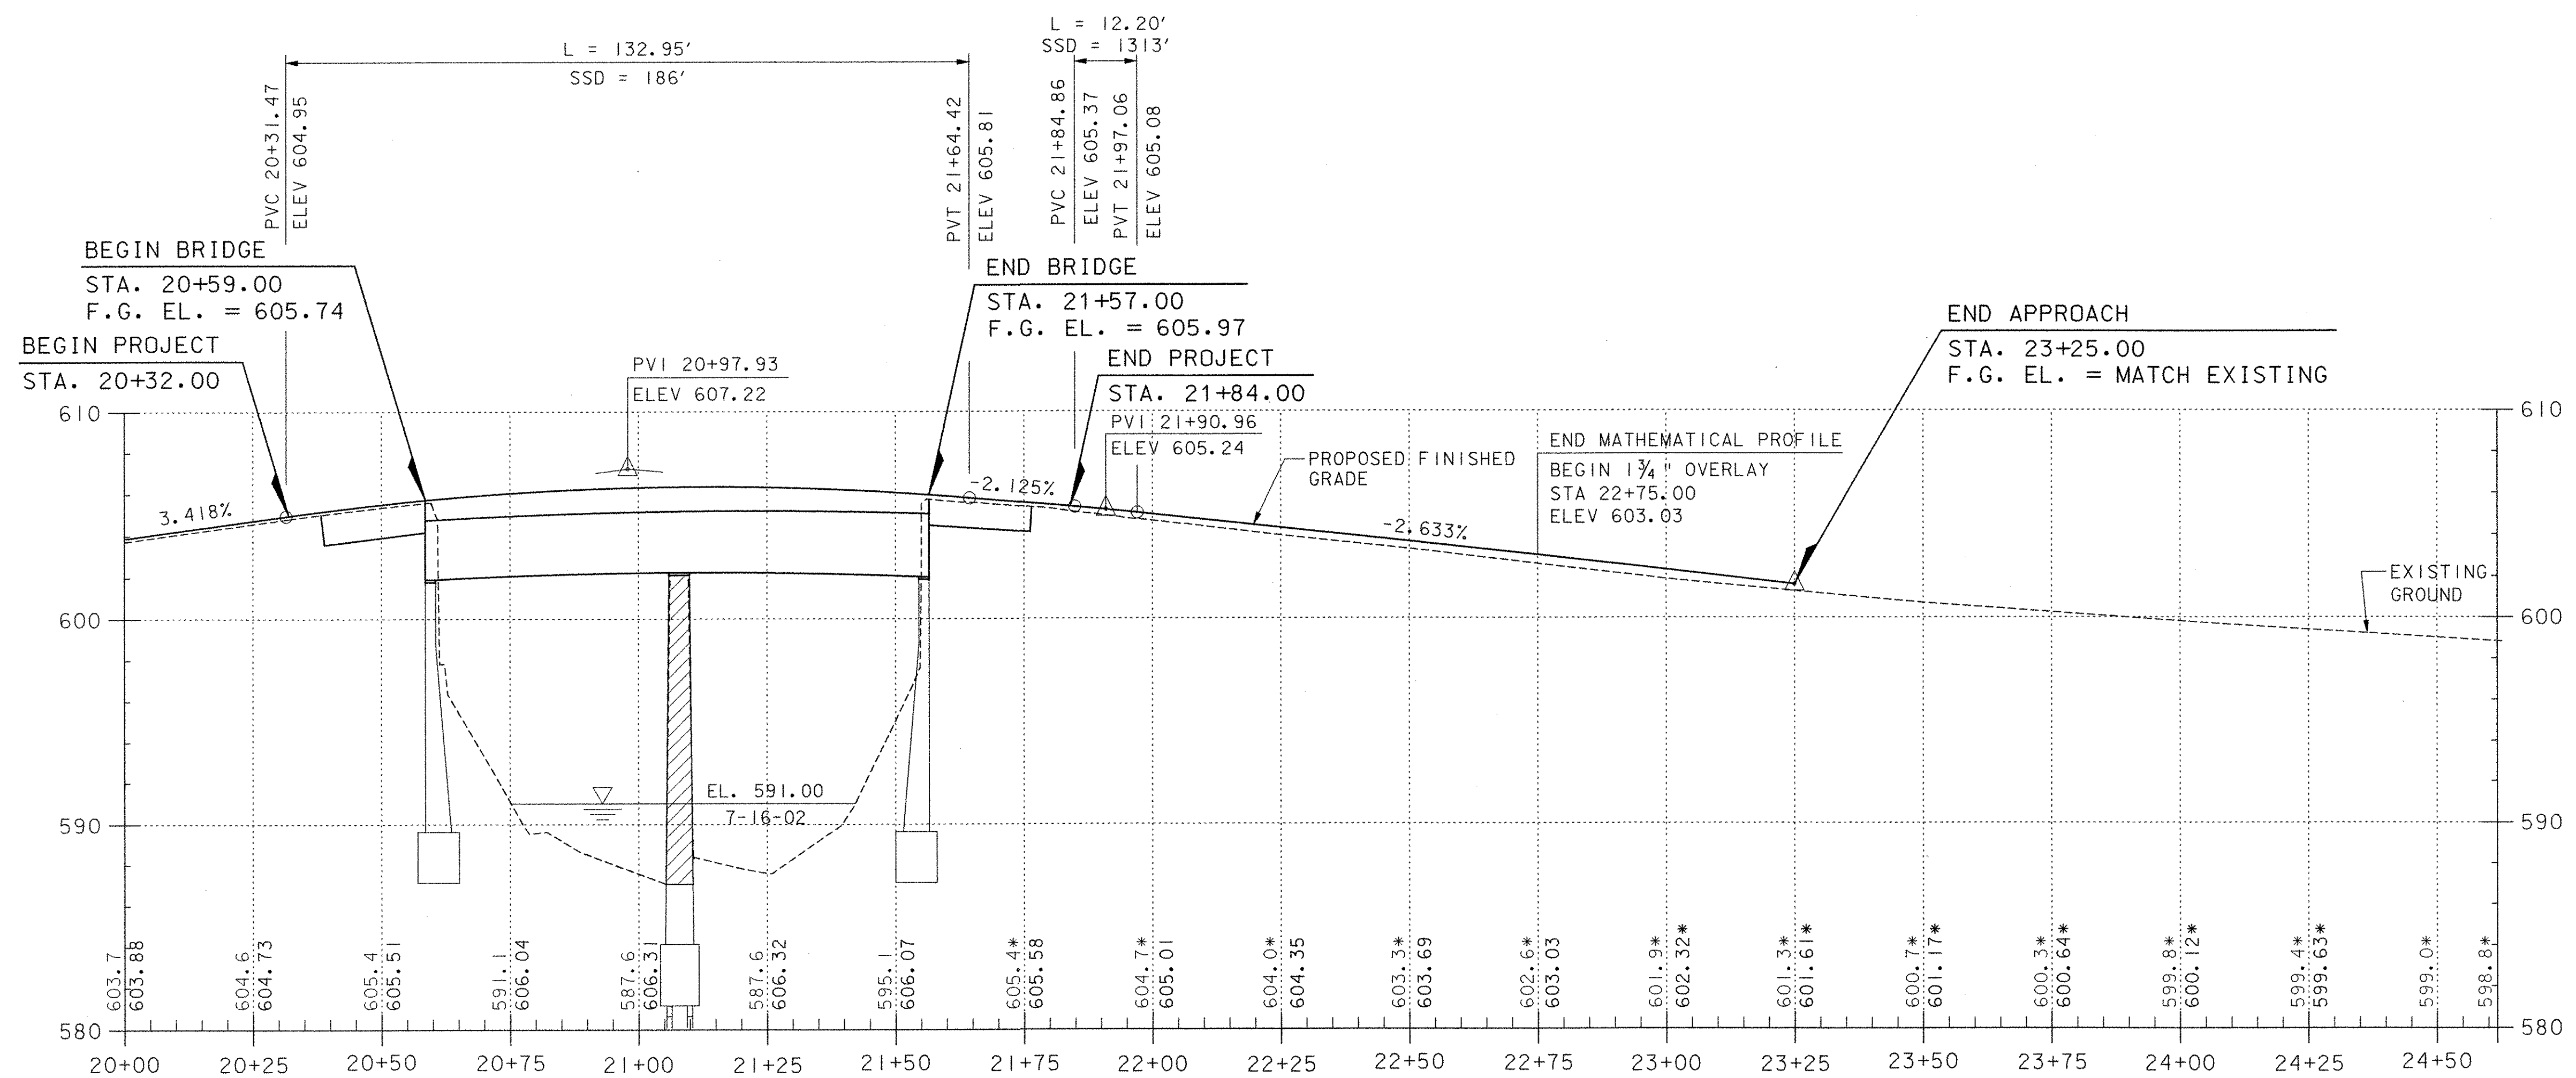

VT ROUTE 121 PROFILE

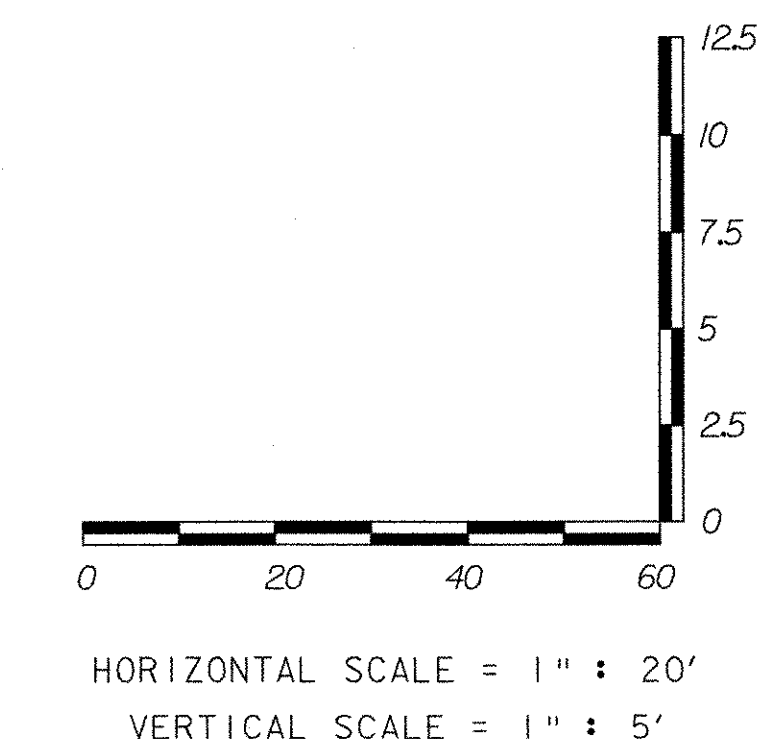

DENOTES APPROXIMATE LIMITS OF PIER REMOVAL

* EXISTING ELEVATIONS SHOWN MAY NOT MATCH EXISTING CONDITIONS (SEE GENERAL NOTE 5 SHEET 26). THE INTENT OF THE PROPOSED ELEVATIONS IS TO SHOW A 1 3/4" OVERLAY

**TOWN OF GRAFTON
CAMBRIDGEPORT BRIDGE**

Town Of	GRAFTON	Bridge No.	16G
Highway No.	TH 1	Log Sta.	
		Surv. Sta.	

TH 1 (CAMBRIDGEPORT BRIDGE) OVER THE SAXTONS RIVER

PROFILES			
Designed By	C. S. MERCER	Drawn By	C. S. MERCER
Checked By	Date	Bridge Design Supervisor	
J. A. MERCER	5/05	M. A. COLGAN	Date 5/05
PROJECT	GRAFTON	PROJECT NO.	TH2-0104

I.G.C. Info.	File No. 51335PRF	Sheet	8 of 42
--------------	-------------------	-------	---------

VHB Vanasse Hangen Brustlin, Inc.