


PLAN
SCALE: 1/4" = 1'-0"

SEE SHEET
28R

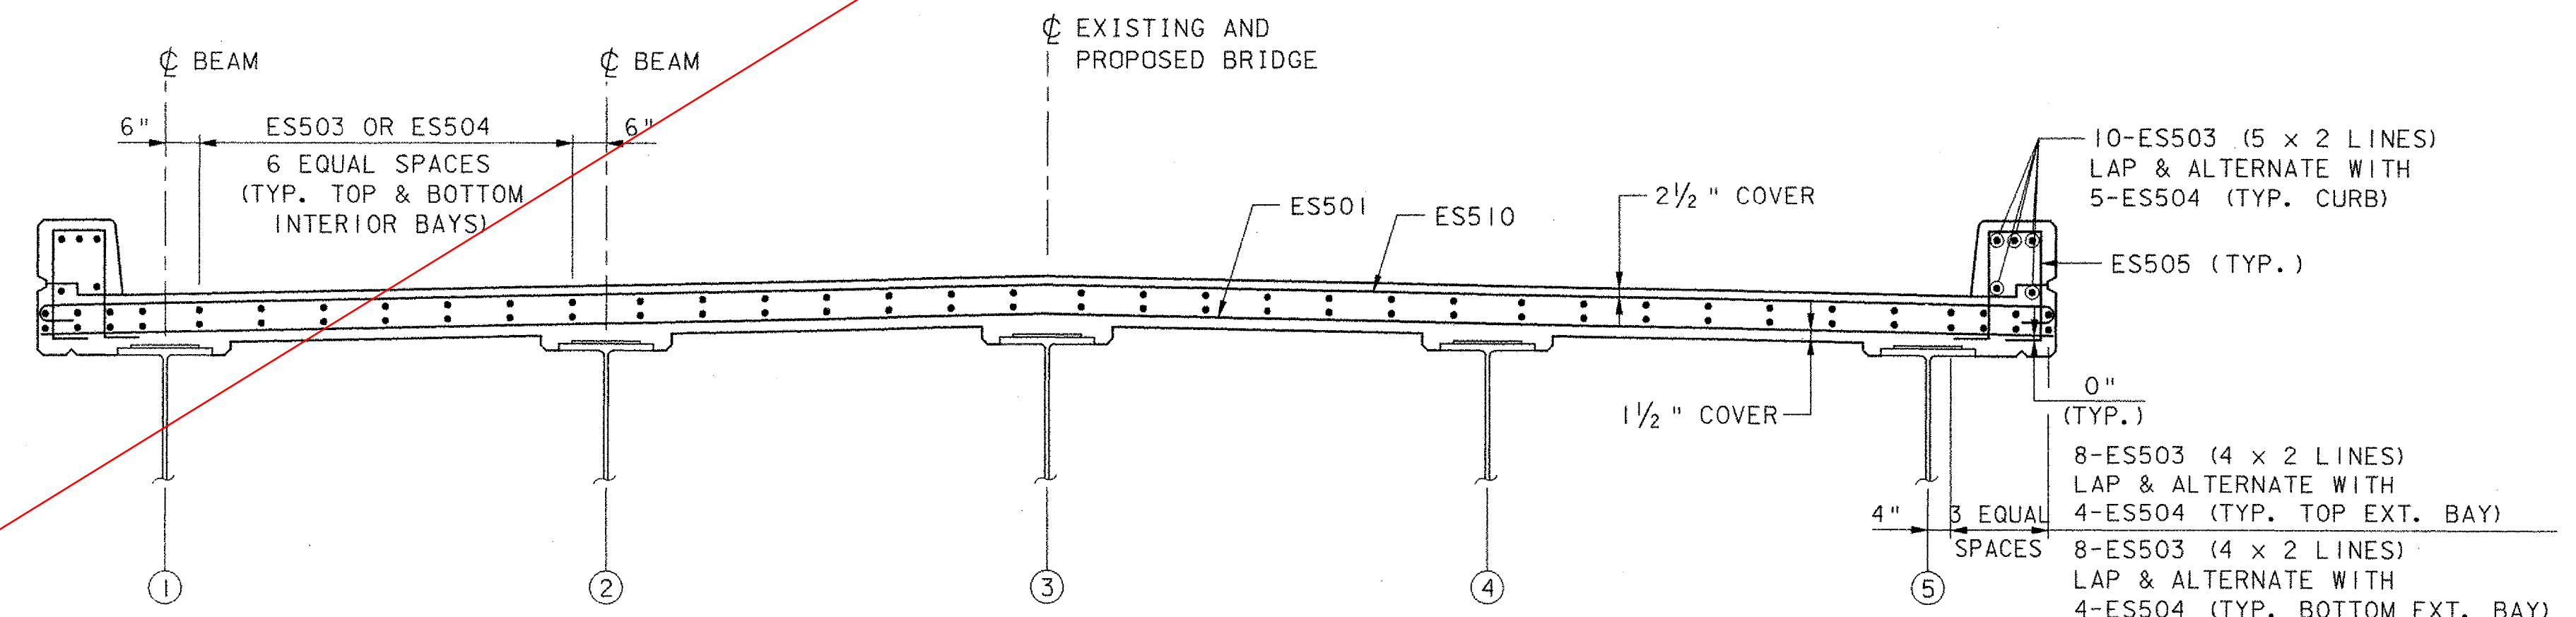

SECTION A-A
SCALE: 1/2" = 1'-0"

KEY
N.F. = NEAR FACE
F.F. = FAR FACE
E.F. = EACH FACE
▲ = CUT TO FIT IN FIELD

TOWN OF GRAFTON CAMBRIDGEPORT BRIDGE		
Town Of	GRAFTON	Bridge No. 16G
Highway No.	TH 1	Log Sta.
TH 1 (CAMBRIDGEPORT BRIDGE) OVER THE SAXTONS RIVER		Surv. Sta.
DECK REINFORCEMENT		
Designed By	J. T. KLEIN	Drawn By
Checked By	K. R. CRAWFORD	Date
PROJECT		PROJECT NO.
GRAFTON		TH2-0104
I.G.C. Info.		File No. 51335DRF
		Sheet 28 of 42

VHB Vanasse Hangen Brustlin, Inc.