


TOP OF APPROACH SLAB ELEVATIONS		
EL.	SLAB NO. 1	SLAB NO. 2
A	604.72	605.45
B	605.17	605.15
C	605.10	605.71
D	605.48	605.38
E	605.17	605.40
F	604.85	605.37
	605.17	605.15

APPROACH SLAB NO. 1
SCALE: 1/4" = 1'-0"

APPROACH SLAB NO. 2
SCALE: 1/4" = 1'-0"

KEY
 N.F. = NEAR FACE
 F.F. = FAR FACE
 E.F. = EACH FACE
 ▲ = CUT TO FIT IN FIELD

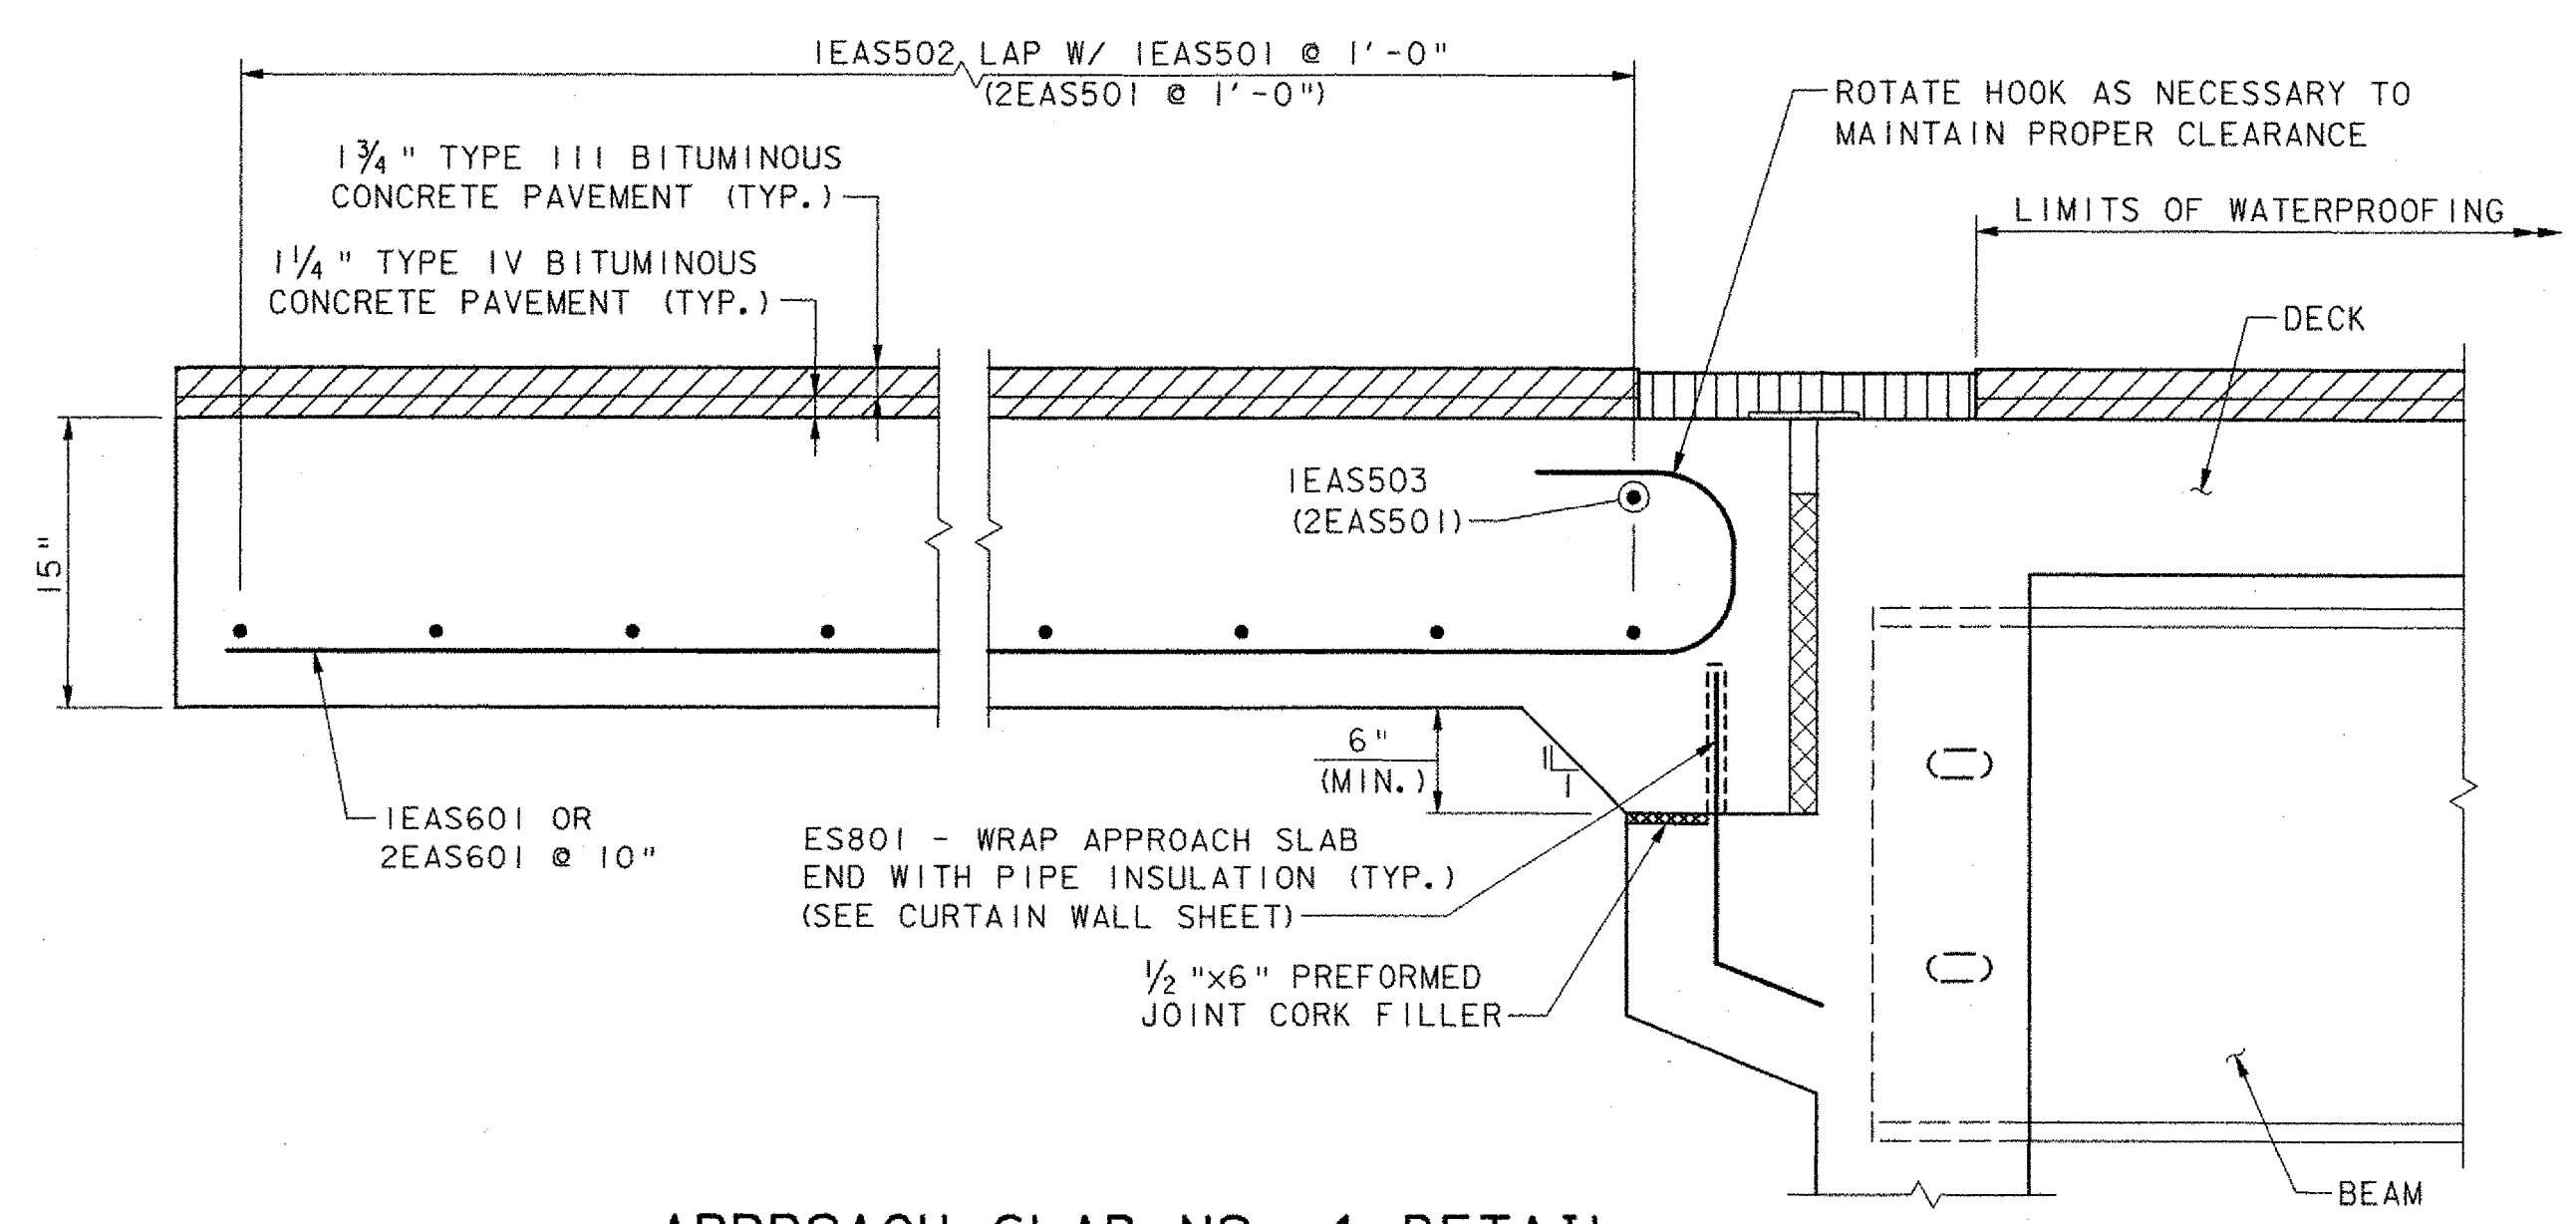

APPROACH SLAB NO. 1 DETAIL
(APPROACH SLAB NO. 2 SIMILAR)
N. T. S.

TOWN OF GRAFTON CAMBRIDGEPORT BRIDGE		
Town Of	GRAFTON	Bridge No. 16G
Highway No.	TH 1	Log Sta.
		Surv. Sta.
TH 1 (CAMBRIDGEPORT BRIDGE) OVER THE SAXTONS RIVER		
APPROACH SLAB DETAILS		
Designed By	J. T. KLEIN	Drawn By B. J. MASSE
Checked By	Date	Bridge Design Supervisor
M. A. COLGAN	5/05	M. A. COLGAN Date 5/05
PROJECT	GRAFTON	PROJECT NO. TH2-0104
I.G.C. Info.		
File No. 51335AS1		Sheet 33 of 42

VHB Vanasse Hangen Brustlin, Inc.