
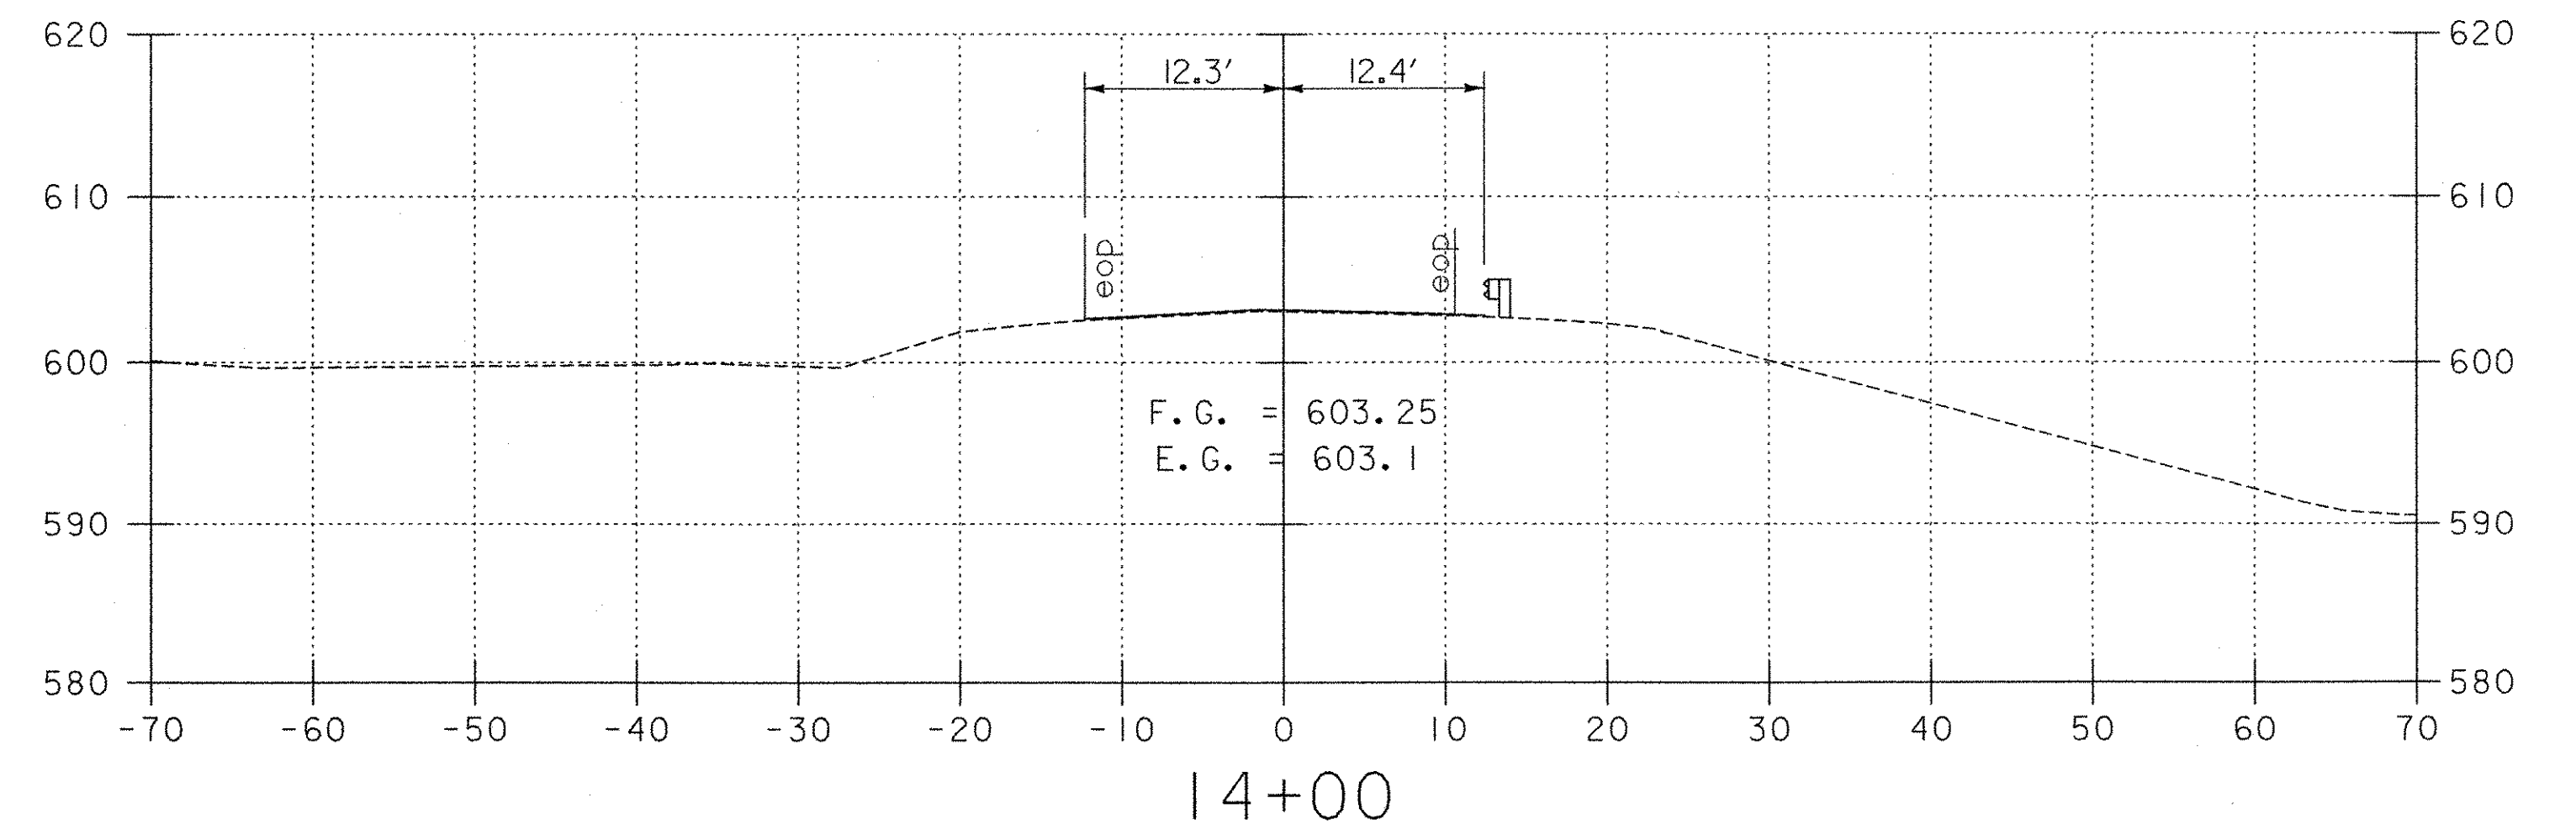
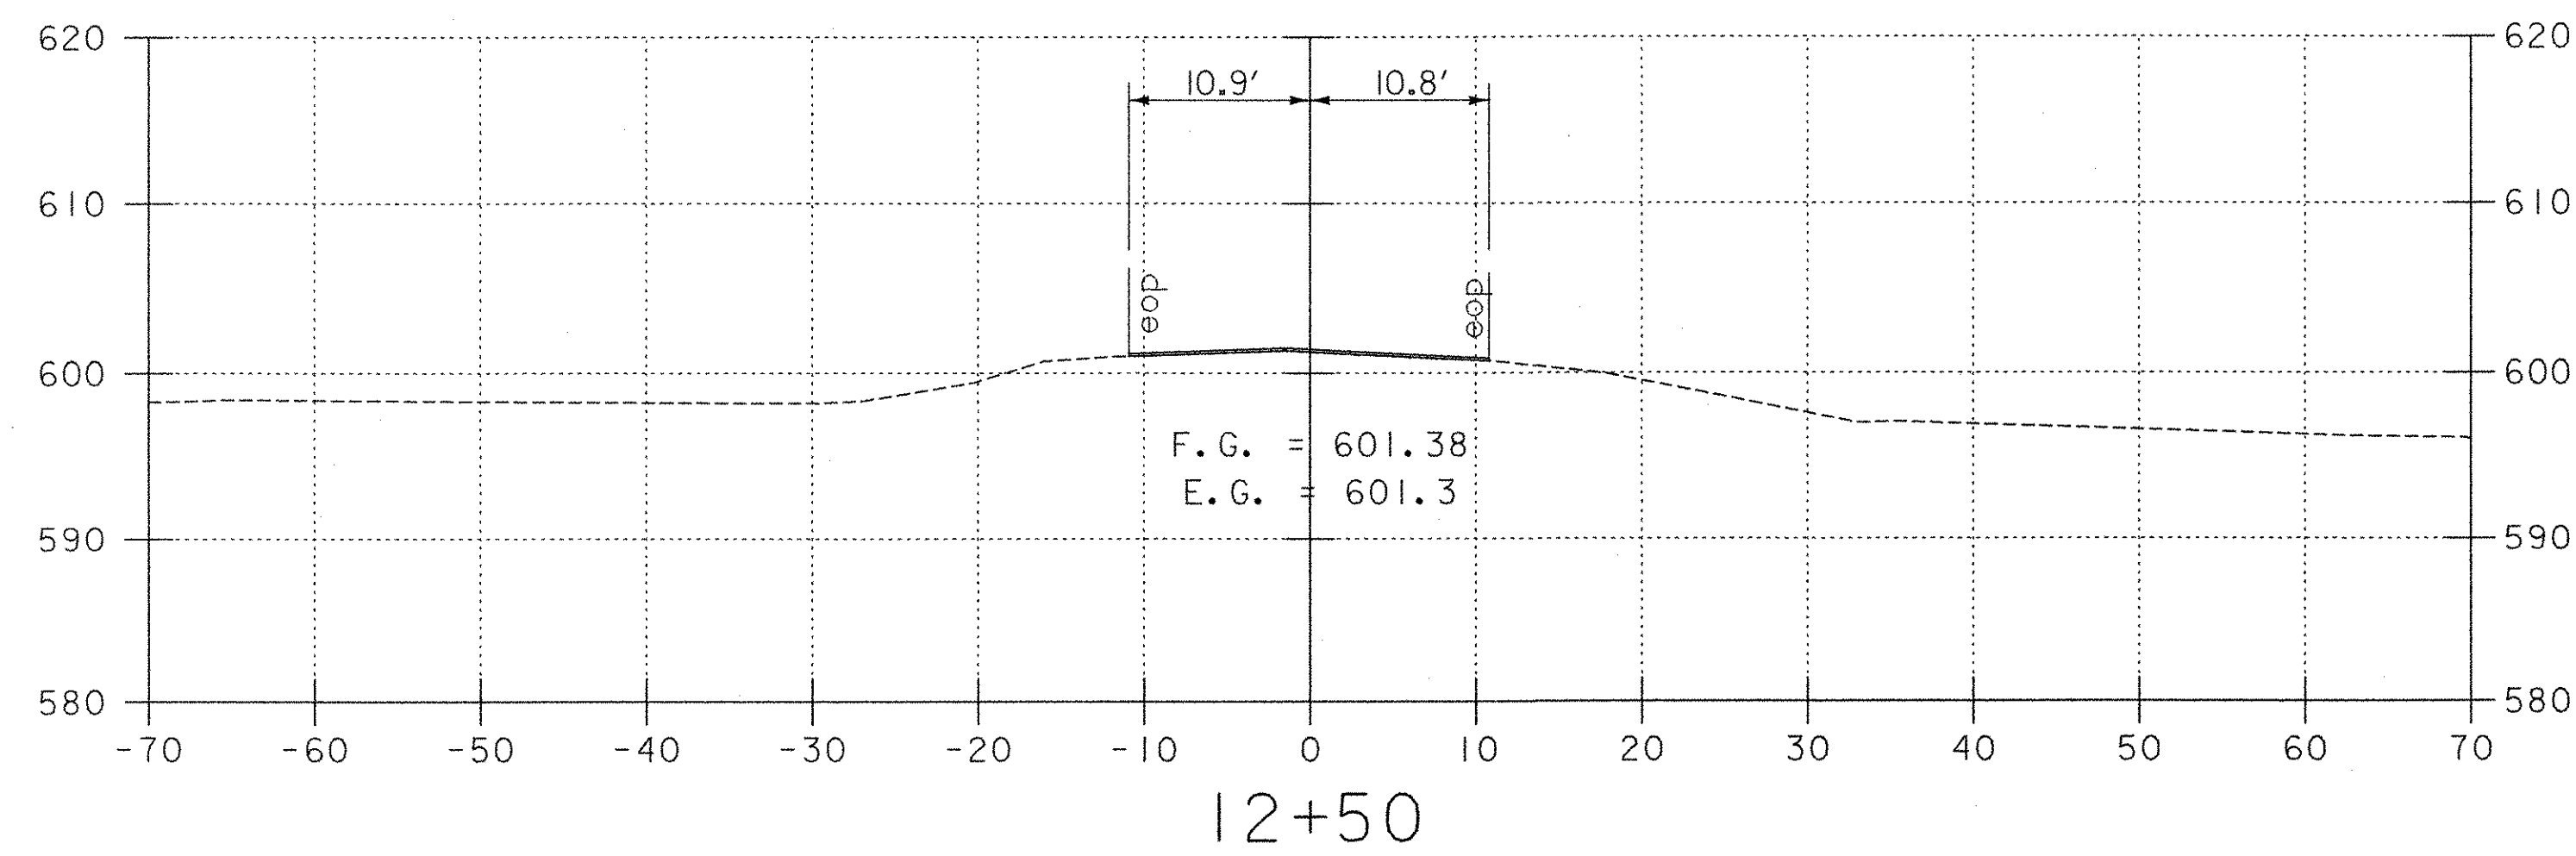
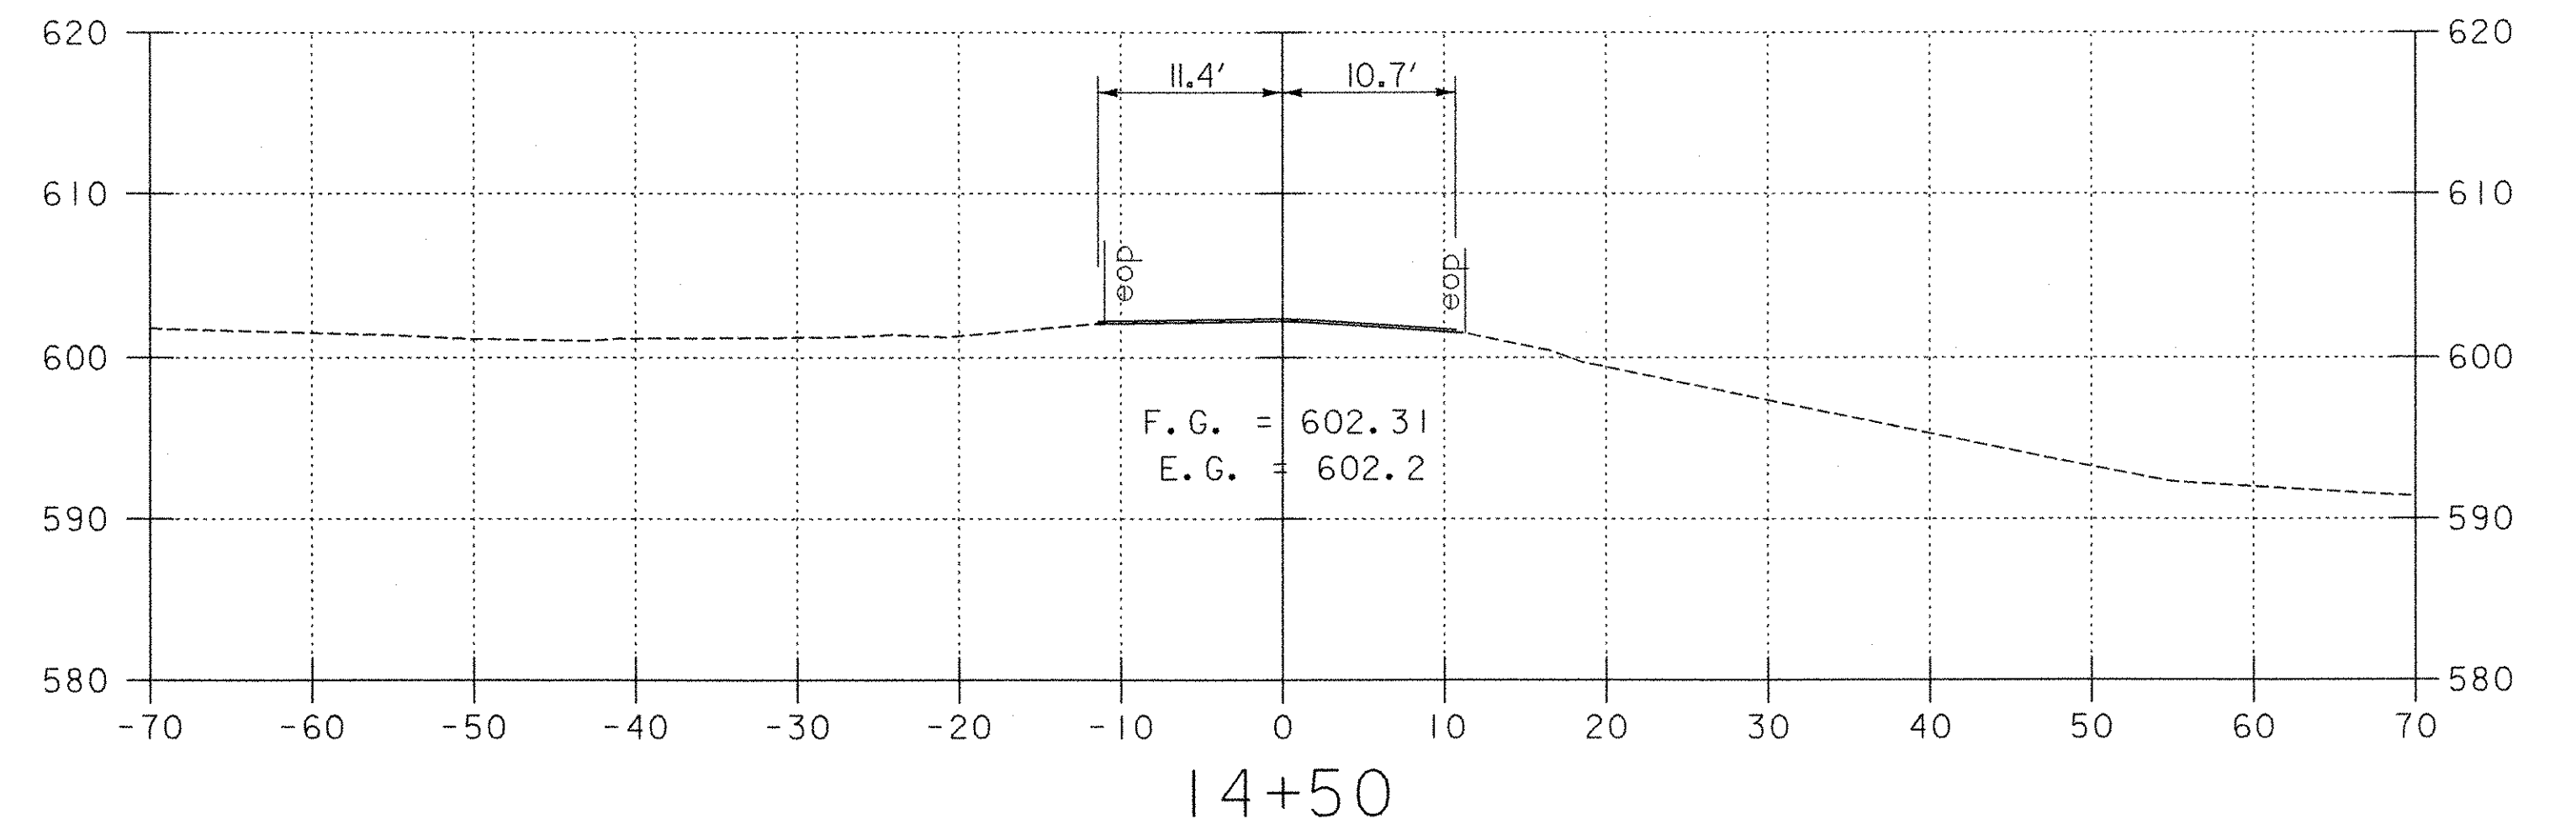


END APPROACH
STA. 15+20
MATCH EXISTING

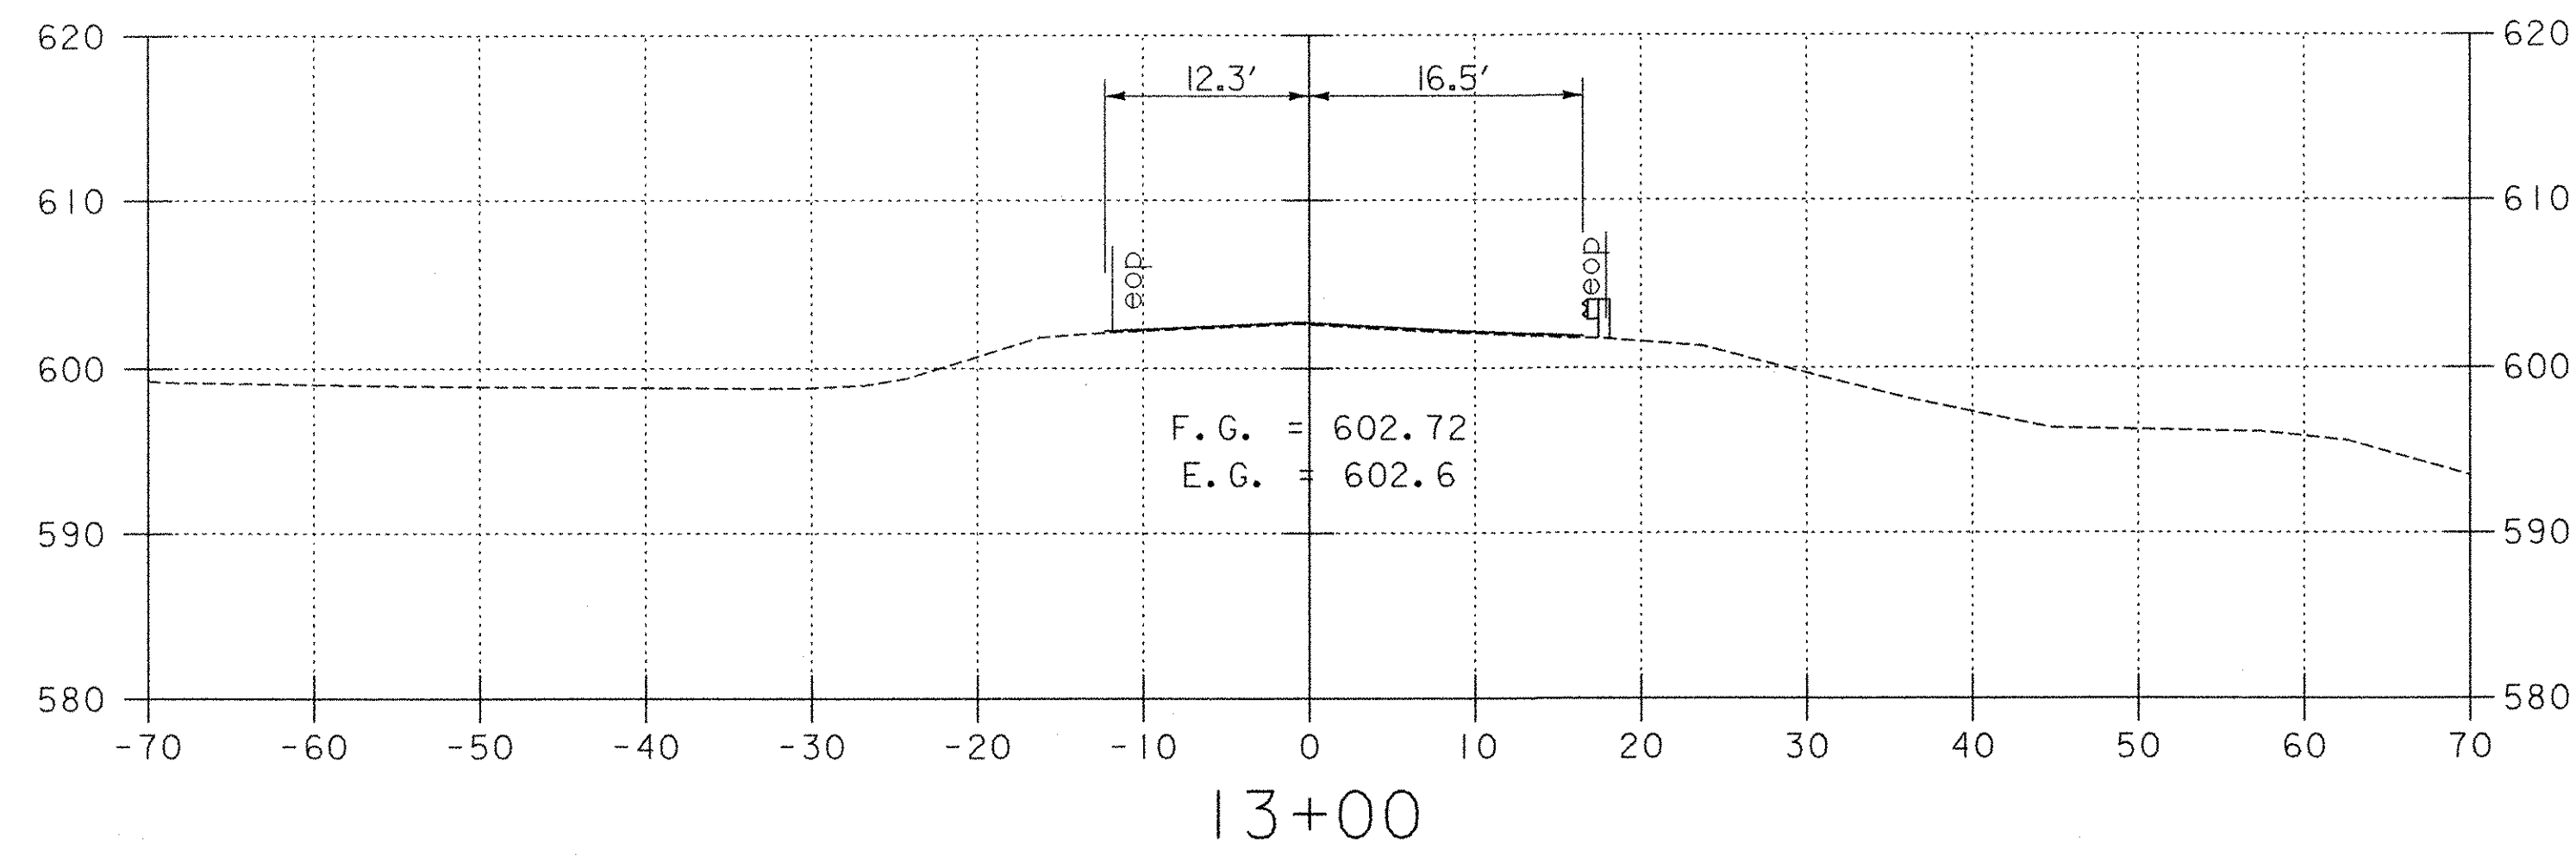

BEGIN APPROACH
STA. 12+05
MATCH EXISTING

VT ROUTE 35/121 CROSS SECTIONS

VANASSE HANGEN BRUSTLIN, INC.

FROM STA 12+50 TO STA 14+50
PROJECT NAME GRAFTON
PROJECT NO. TH2-0104
SURVEYED BY EIV TECH. SERVICES, LLC 6/02
SHEET 37 OF 42