
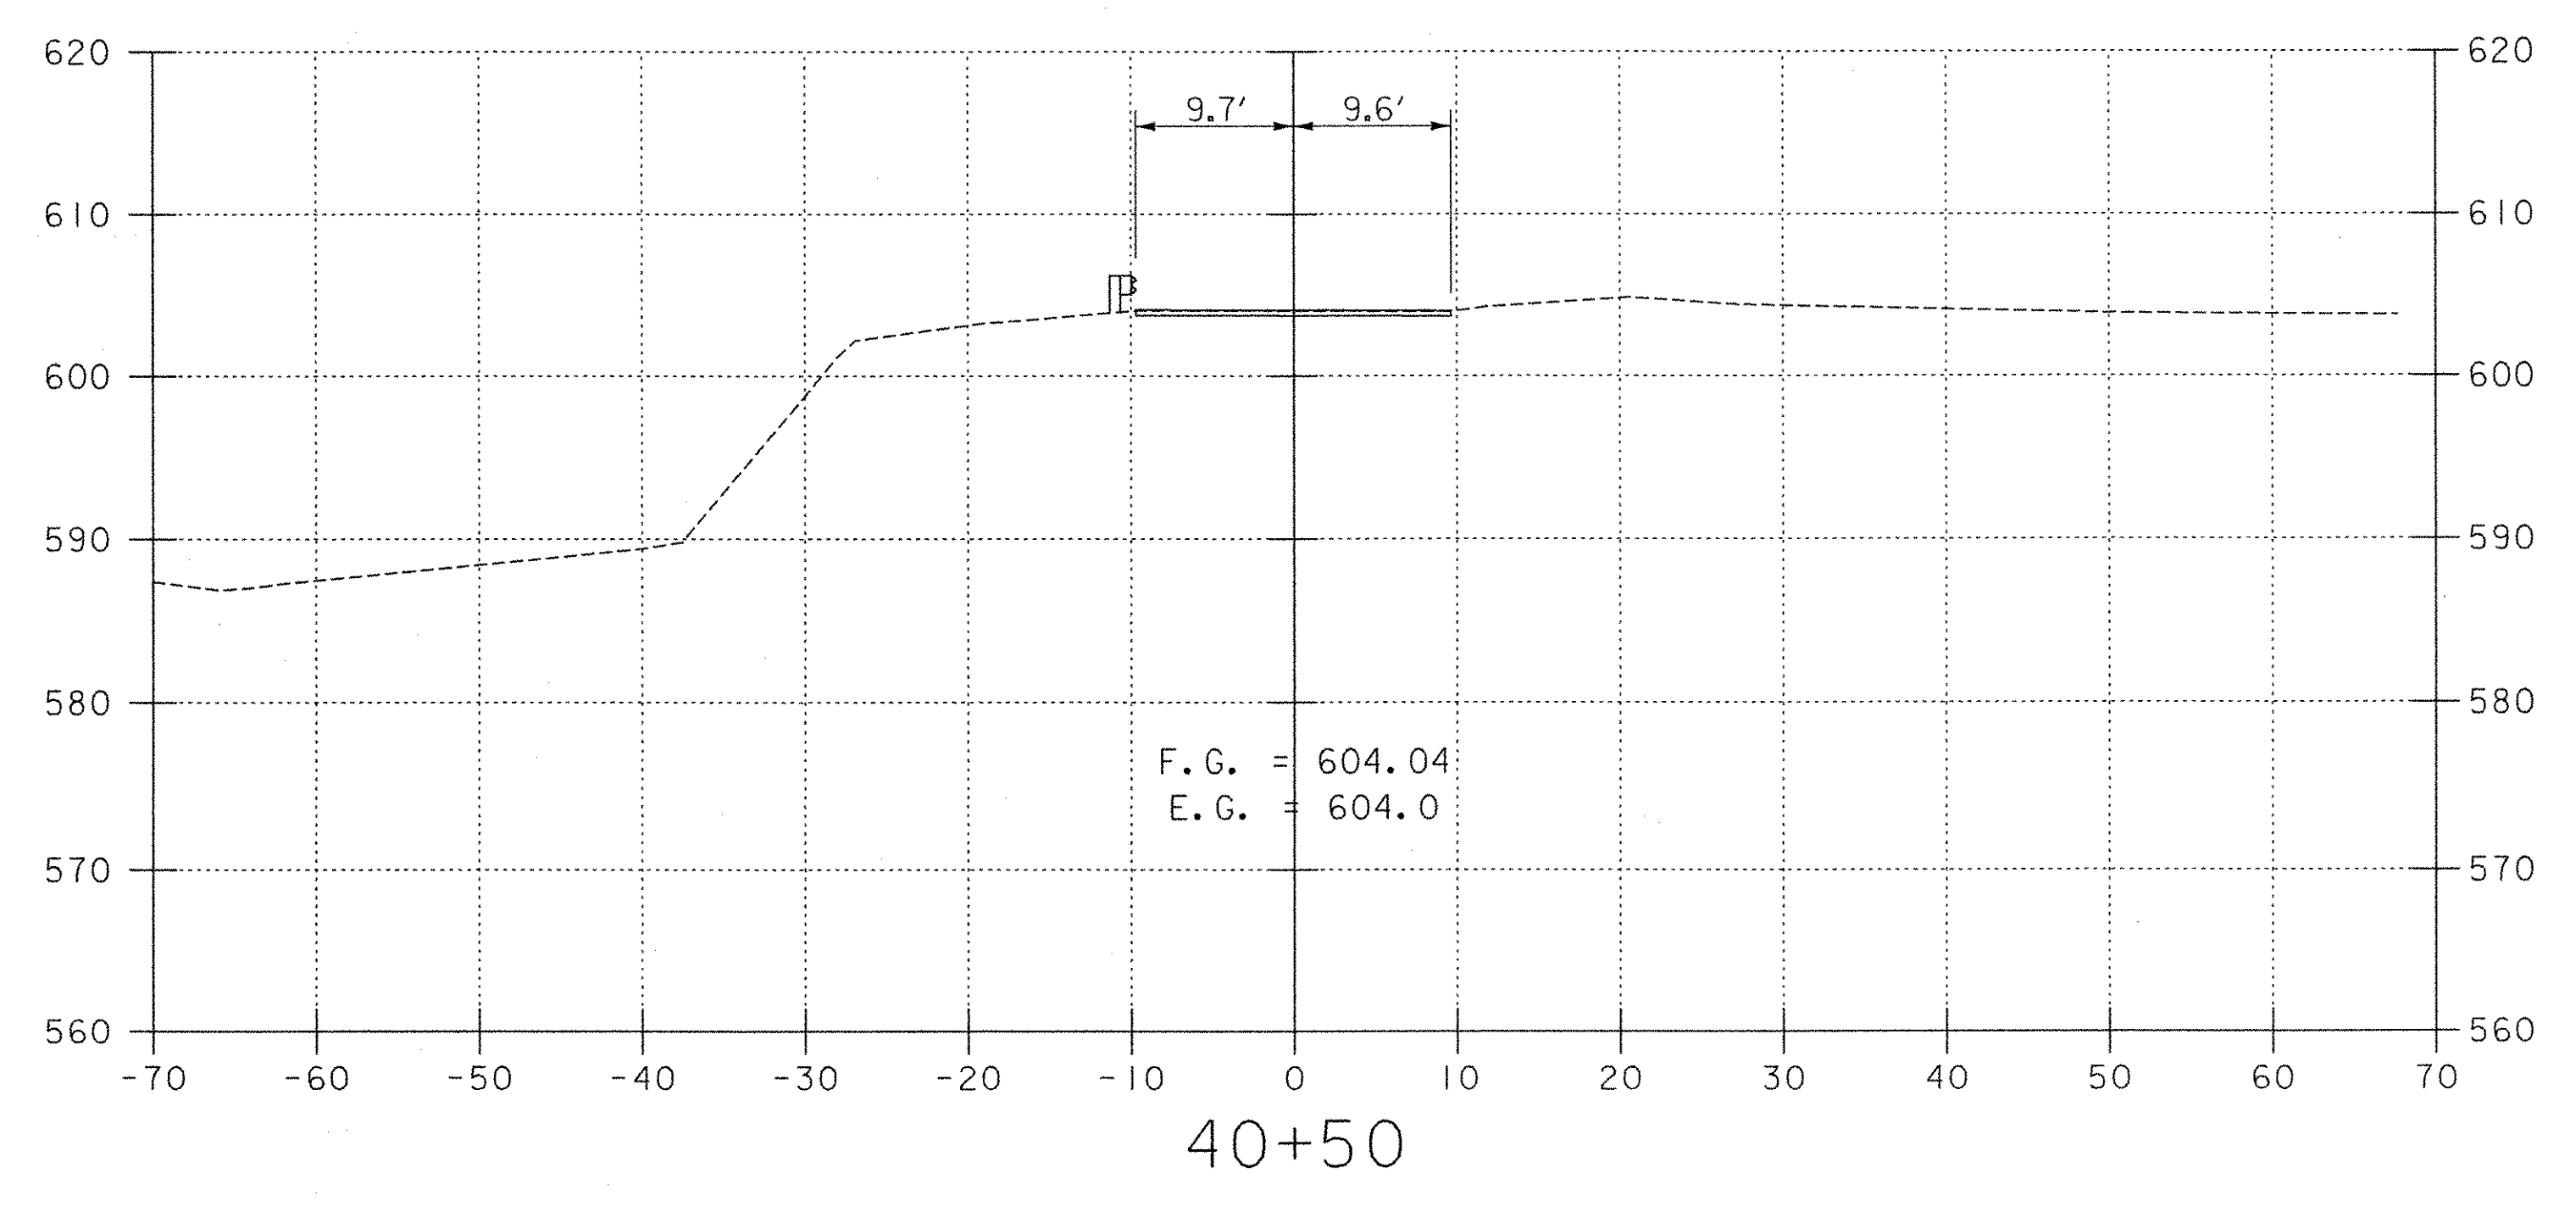
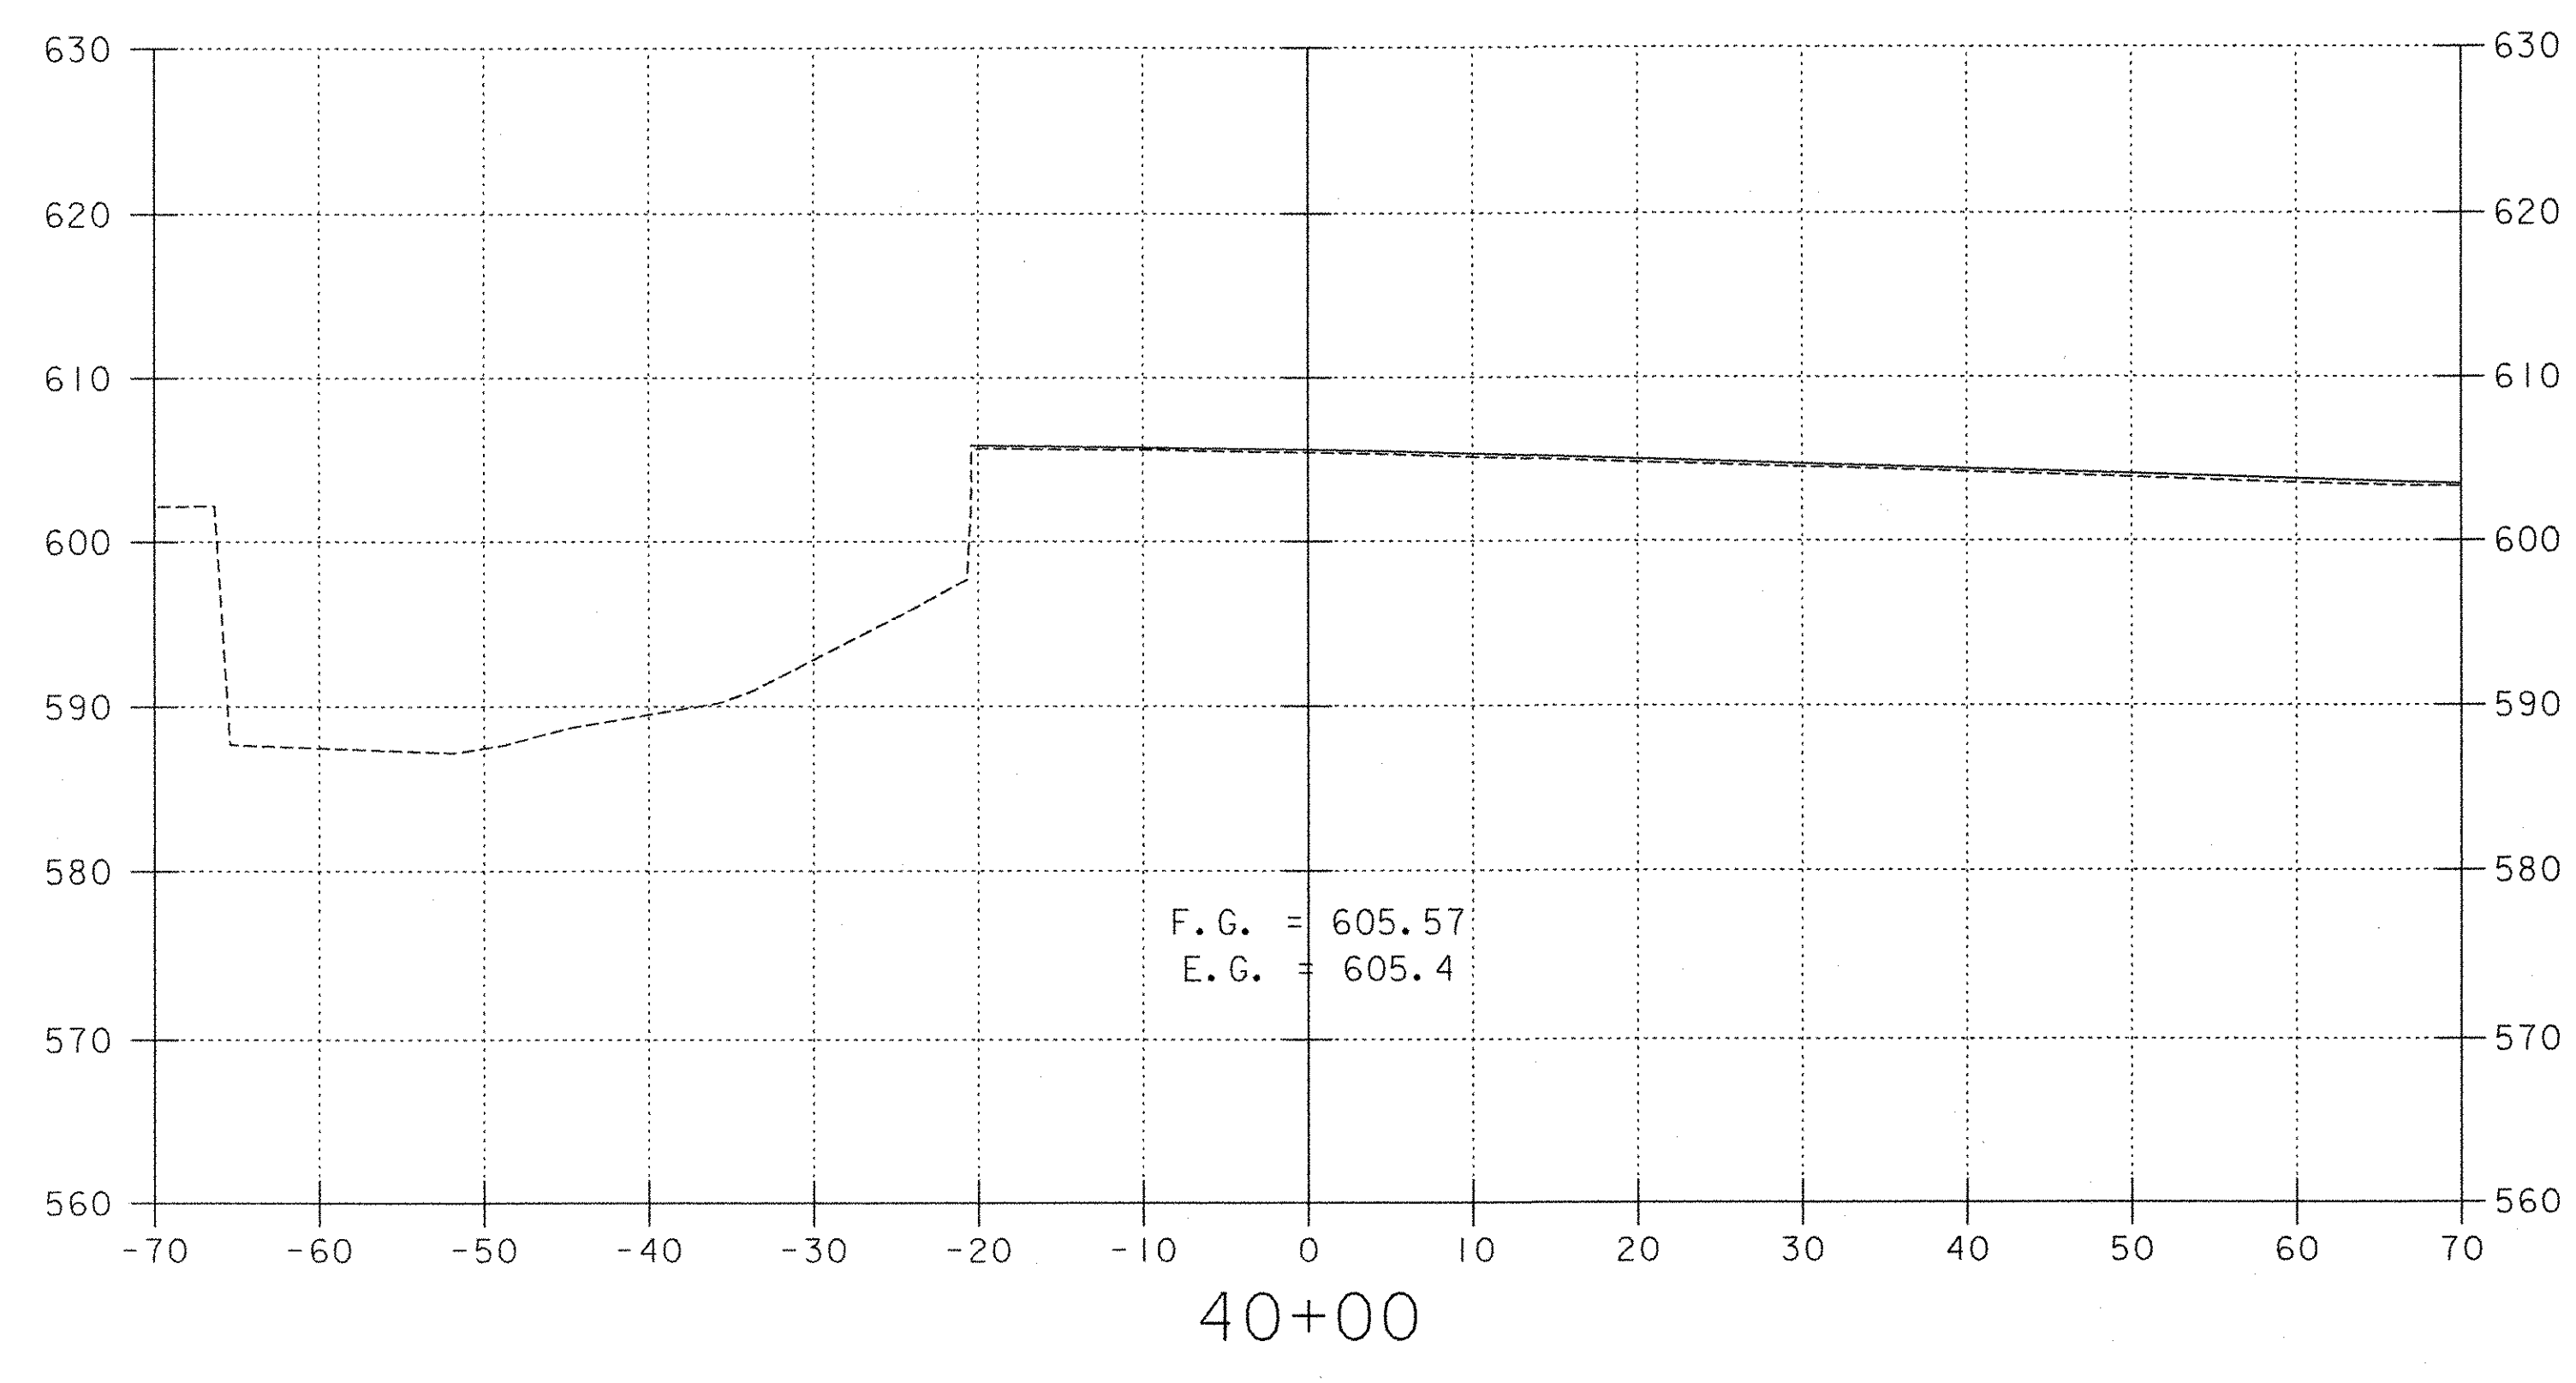
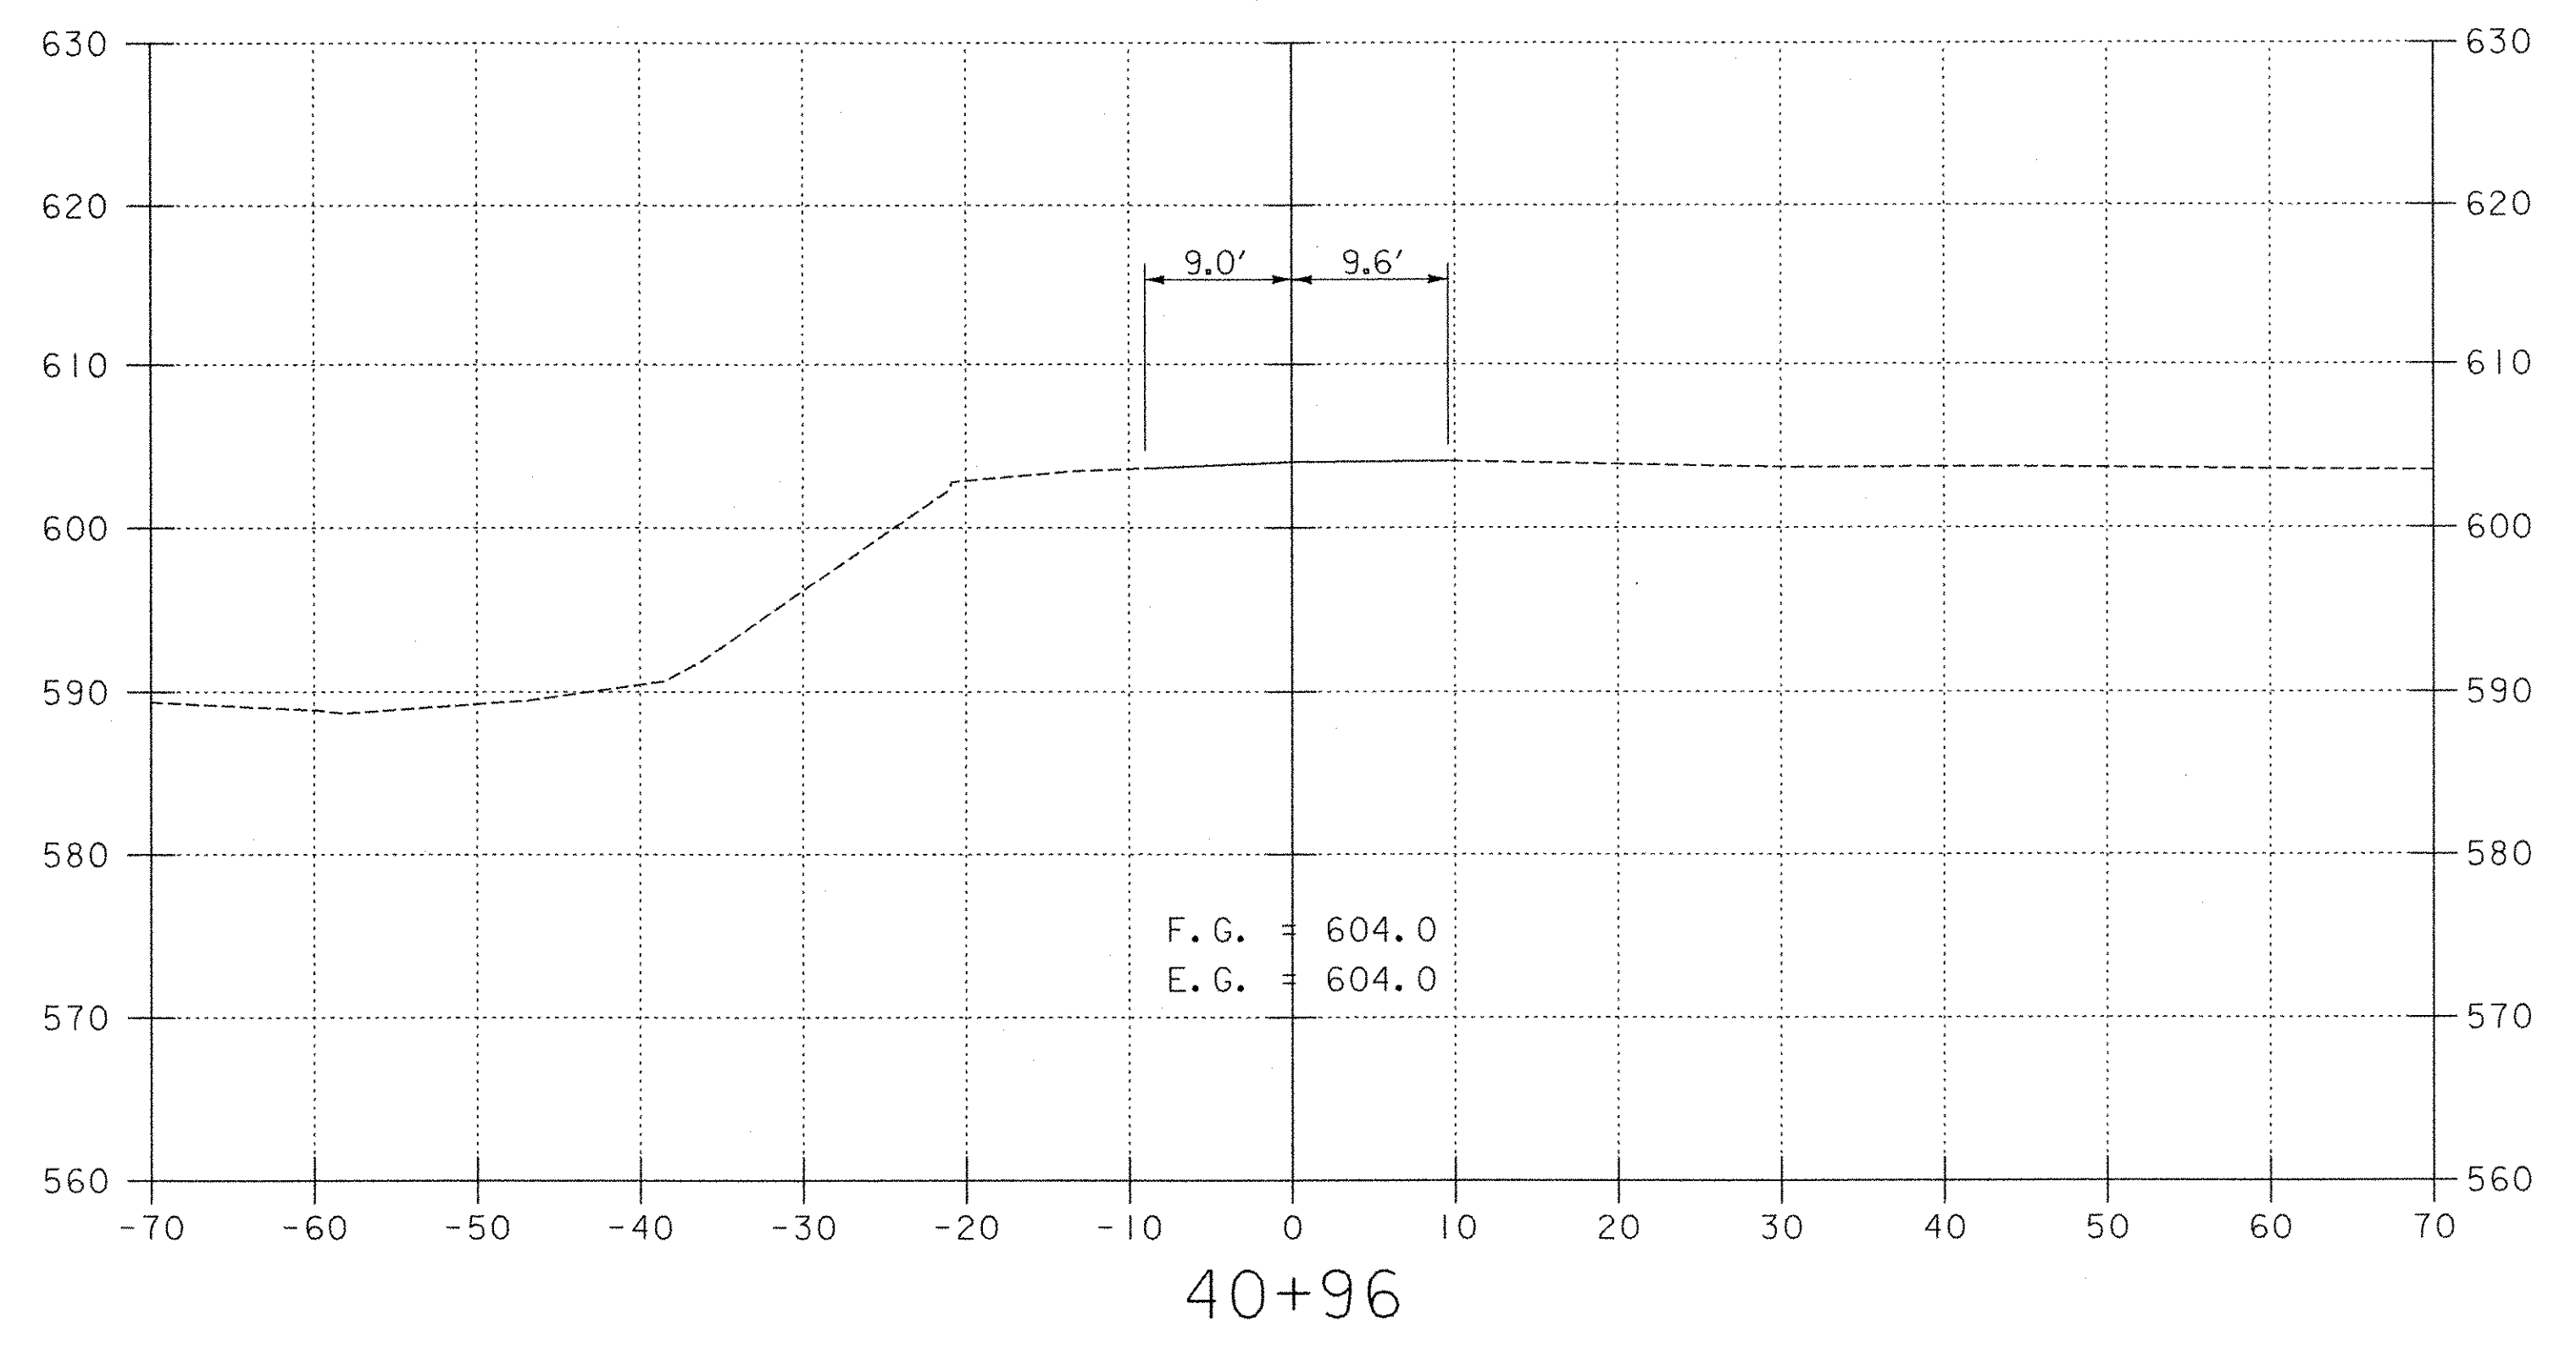


END APPROACH
 STA. 41+00
 MATCH EXISTING

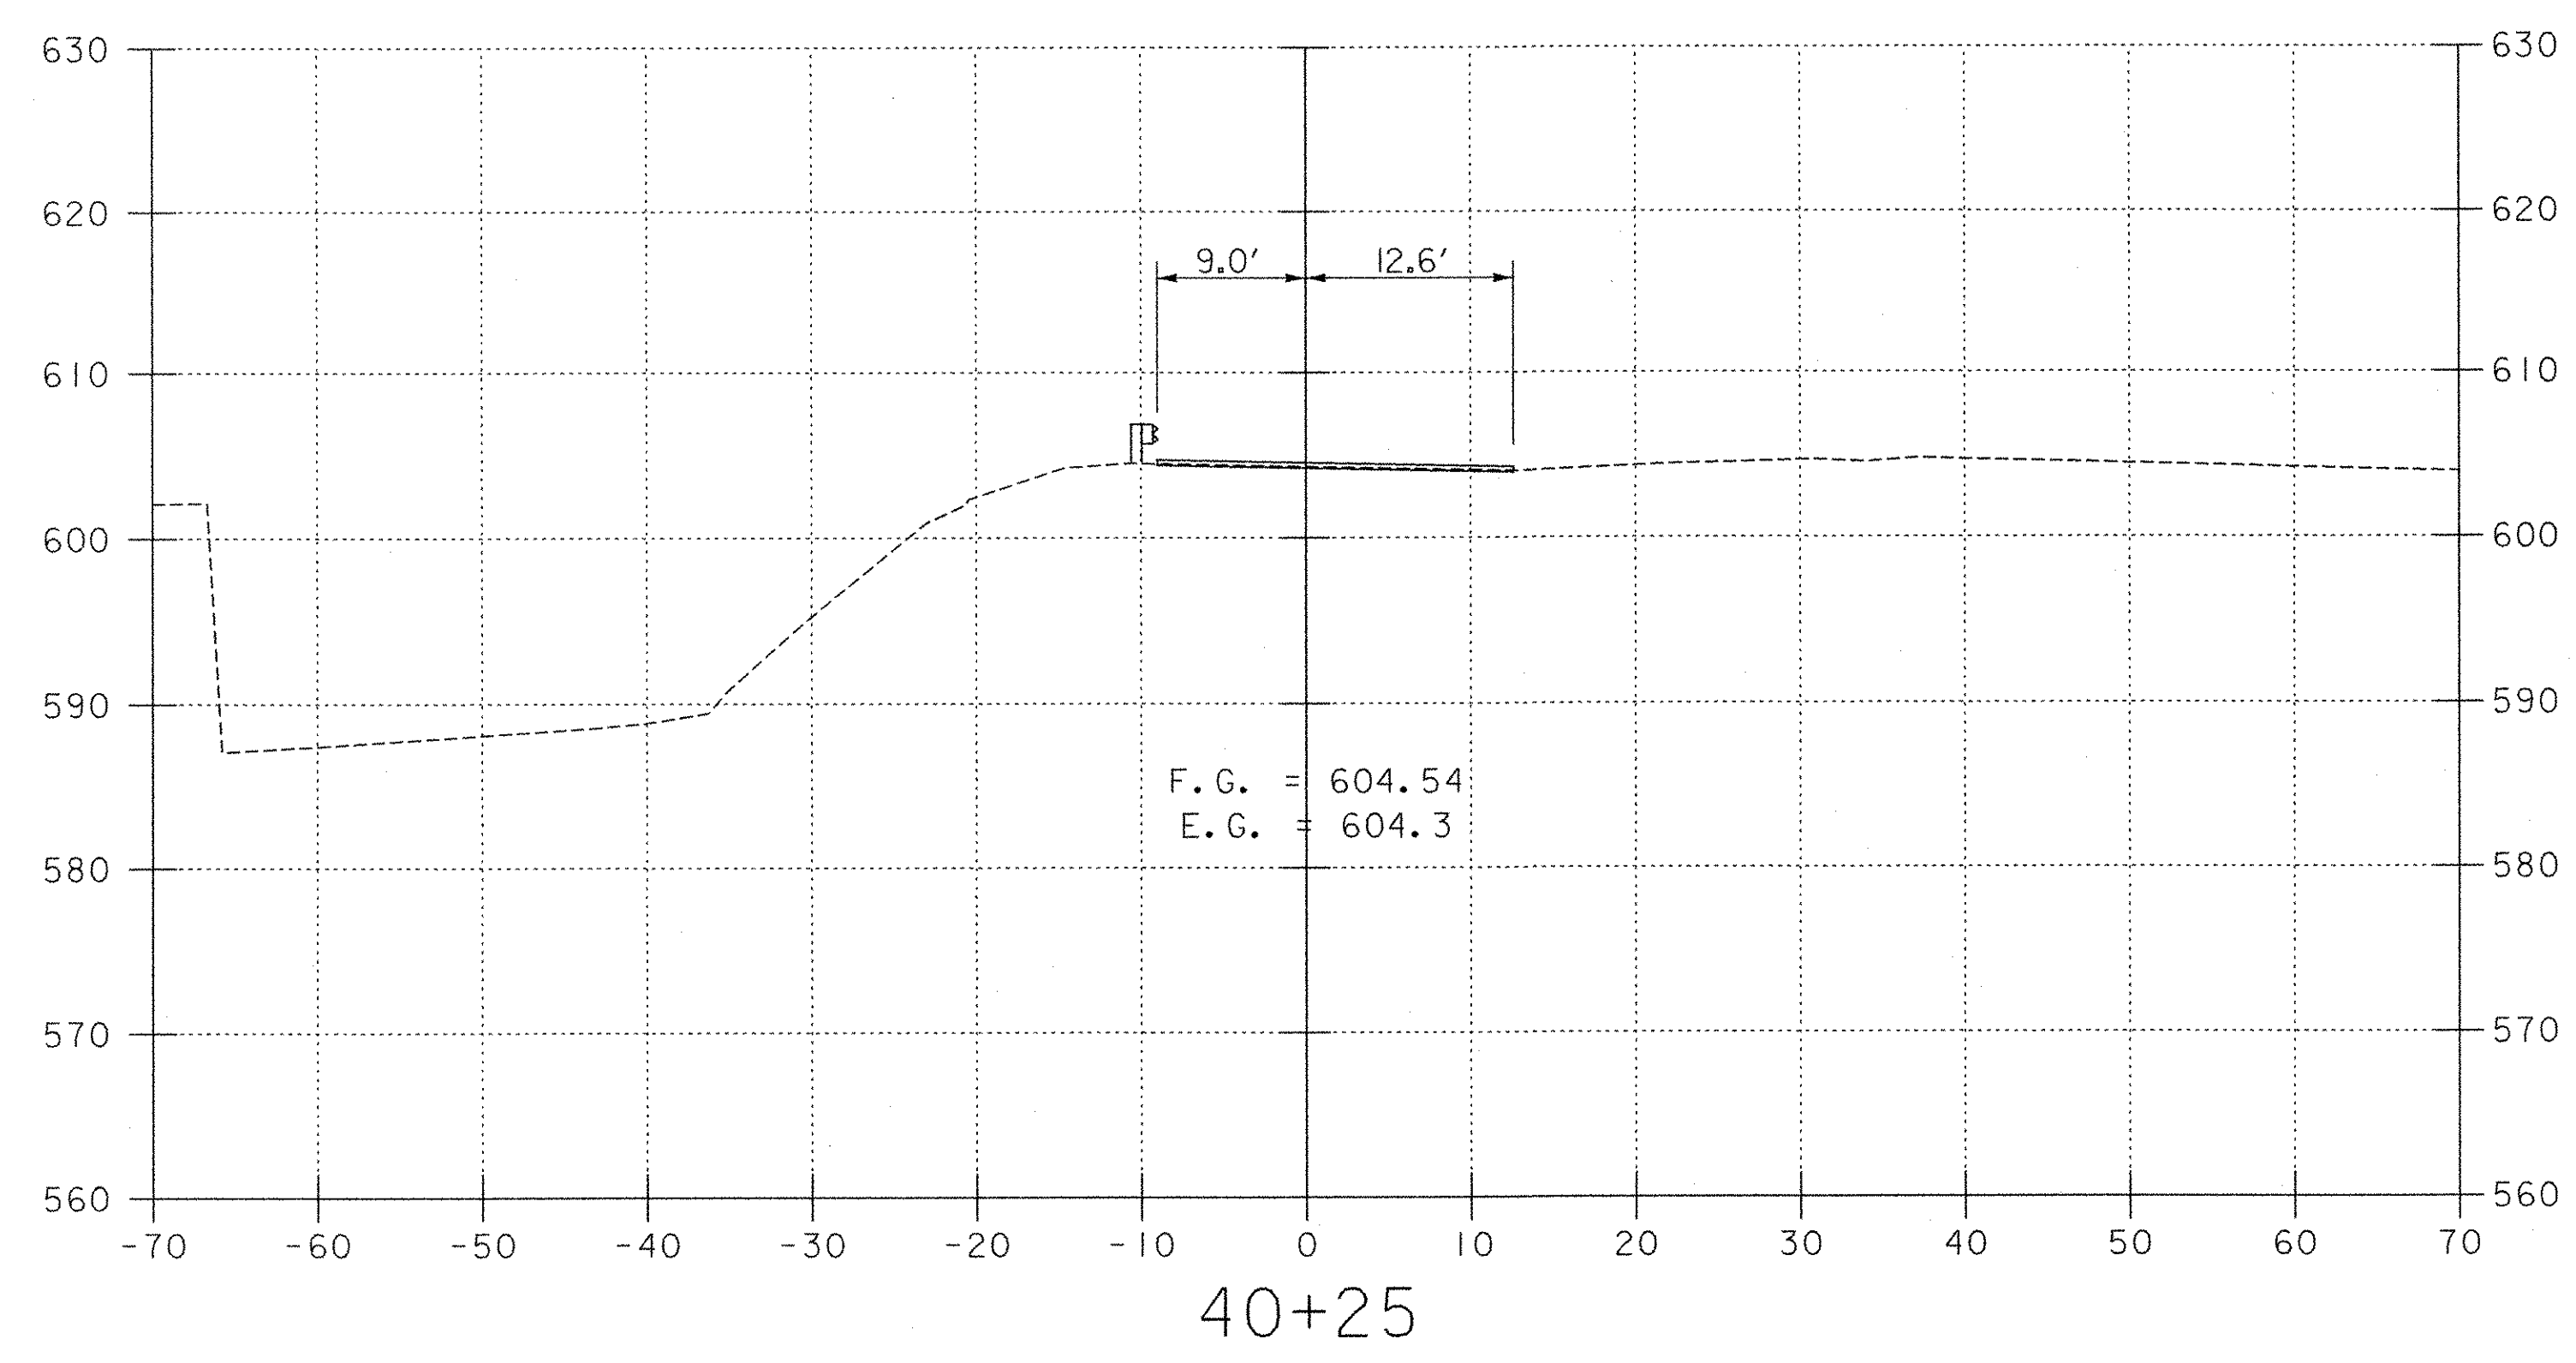

PARKER HILL RD CROSS SECTIONS

FROM STA 40+00	TO STA 40+96
PROJECT NAME	GRAFTON
PROJECT NO.	TH2-0104
SURVEYED BY	EIV TECH. SERVICES, LLC 6/02
SHEET 39 OF 42	

VANASSE HANGEN BRUSTLIN, INC.