

646.40 DURABLE 100 mm WHITE LINE
(ALL LINES WILL INCLUDE EDGE LINE BREAKS AND RADIUS FOR TOWN HIGHWAYS)

SALISBURY:
STA. 1+807.293 - STA. 2+360.0 LT & RT

646.60 TEMPORARY 100 mm WHITE LINE
(ALL LINES WILL INCLUDE EDGE LINE BREAKS AND RADIUS FOR TOWN HIGHWAYS)

SALISBURY:
STA. 1+807.293 - STA. 2+360.0 LT & RT

646.41 DURABLE 100 mm YELLOW LINE
(ALL LINES WILL INCLUDE C/L BREAKS FOR TOWN HIGHWAYS) S=SOLID, D=DASHED

SALISBURY:
STA. 1+807.293 - STA. 2+148.5 LT S
STA. 2+148.5 - STA. 2+323.0 S
STA. 2+323.0 - STA. 2+360.0 D
STA. 2+132.381 DOUBLE SOLID LT, T-23

646.61 TEMPORARY 100 mm YELLOW LINE
(ALL LINES WILL INCLUDE C/L BREAKS FOR TOWN HIGHWAYS) S=SOLID, D=DASHED

SALISBURY:
STA. 1+807.293 - STA. 2+148.5 LT S
STA. 2+148.5 - STA. 2+323.0 S
STA. 2+323.0 - STA. 2+360.0 D
STA. 2+132.381 DOUBLE SOLID LT, T-23

646.46 DURABLE 600 mm STOP BAR

SALISBURY:
STA. 2+132.381 LT, T-23

646.66 TEMPORARY 600 mm STOP BAR

SALISBURY:
STA. 2+132.381 LT, T-23

675.50 REMOVING SIGNS

AS SHOWN - 8

675.60 ERECTING SALVAGED SIGNS


AS SHOWN - 1

646.50 DURABLE LETTER OR SYMBOL

SALISBURY:
STA. 2+132.381 LT, T-23, "S,T,O,P" (4 EA)

646.70 TEMPORARY LETTER OR SYMBOL

SALISBURY:
STA. 2+132.381 LT, T-23, "S,T,O,P" (4 EA)

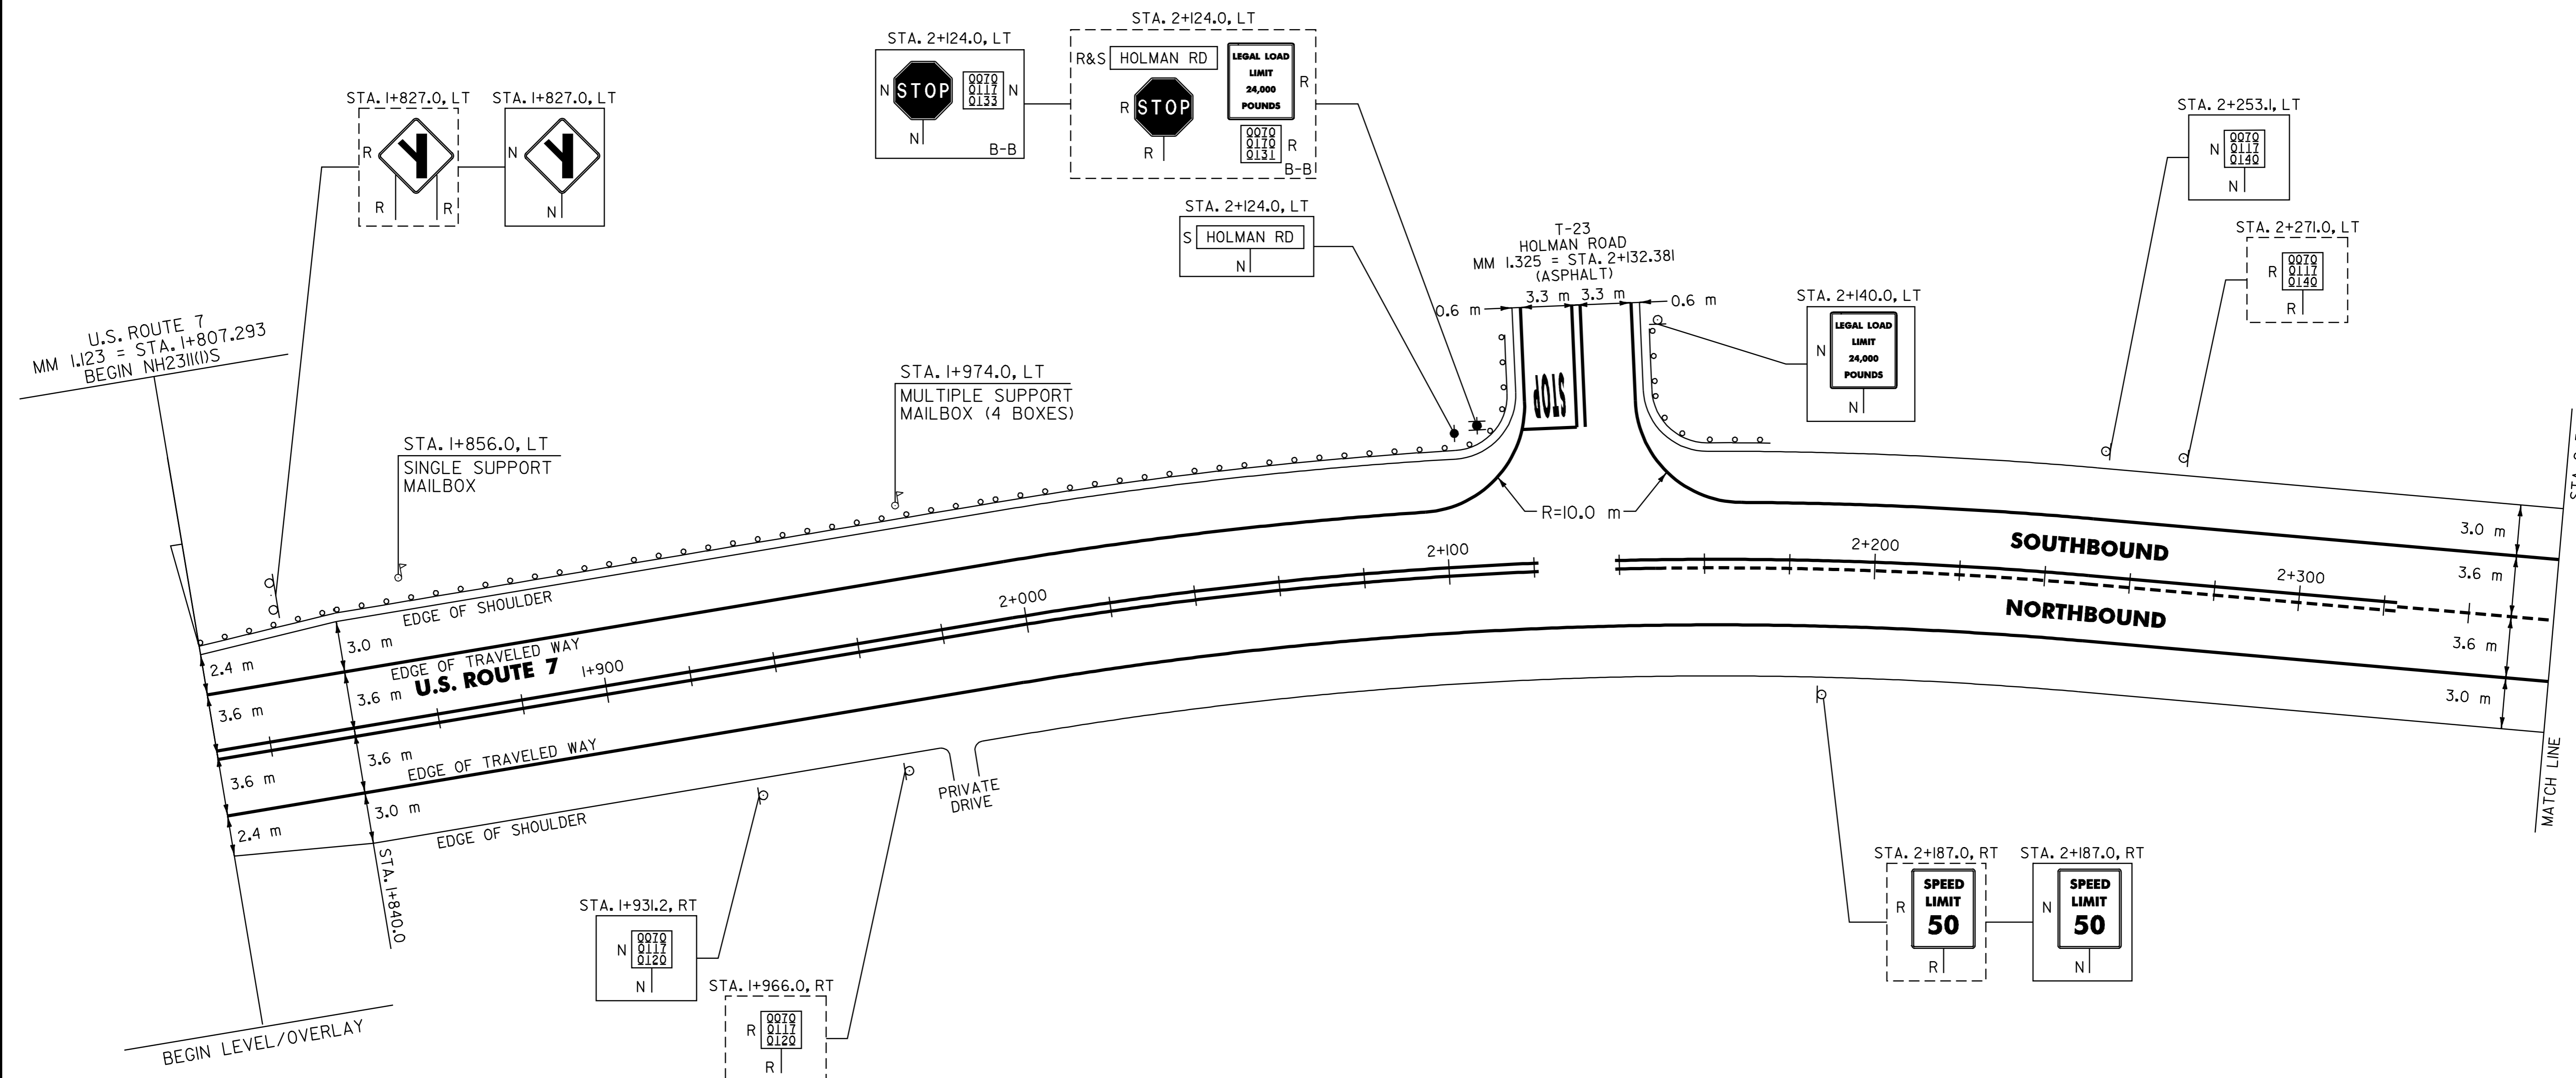

621.20 STEEL BEAM GUARDRAIL

SALISBURY:
STA. 1+819.4 - STA. 2+119.0 LT (311.6 m) (331.47 m)
STA. 2+144.0 - STA. 2+166.8 LT (347.2 m) (38.1 m)

621.505 MANUFACTURED TERMINAL SECTION (FLARED)

SALISBURY:
STA. 1+808.0 - STA. 1+819.4 LT
STA. 2+119.0 LT (ON T-23)
STA. 2+144.0 LT (ON T-23)
STA. 2+166.8 - STA. 2+178.2 LT

621.80 REMOVAL AND DISPOSAL OF GUARDRAIL

SALISBURY:
STA. 1+809.0 - STA. 2+119.0 LT (311.6 m)
STA. 2+144.0 - STA. 2+175.0 LT (53.8 m)

617.10 RELOCATE MAILBOX, SINGLE SUPPORT

SALISBURY:
STA. 1+856.0 LT

617.12 RELOCATE MAILBOX, MULTIPLE SUPPORT

SALISBURY:
STA. 1+974.0 LT

NOTE:

1. PAVING LIMIT ON ALL TOWN HIGHWAYS SHALL BE MEASURED 8 m BACK FROM U.S. ROUTE 7 EDGE OF SHOULDER UNLESS DENOTED OTHERWISE ON THE PLANS OR AS DIRECTED BY THE RESIDENT ENGINEER.

DATUM	
VERTICAL	N/A
HORIZONTAL	N/A

SIGN LEGEND
R= REMOVE
S= SALVAGE
N= NEW
RET= RETAIN
B-B= BACK TO BACK
EXISTING= _____
NEW= _____

<h2>PAVING PROJECT LAYOUT # 1</h2>	SURVEYED BY	N/A	DATE	N/A
	DRAWN BY	C.A.K.	DATE	2/02
	SQUAD LEADER	D.E.G.		
	DESIGN FILE NO.	pave/01b018/pb018.dgn		
	IPARM FILE	pb018p01.i	DATE PLOTTED	10-JUL-2006 13:
PROJ. NAME	SALISBURY - MIDDLEBURY			
PROJ. NO.	NH_231111S			
SHEET	10	OF	67	SHEETS