

646.40 DURABLE 100 mm WHITE LINE
(ALL LINES WILL INCLUDE EDGE LINE BREAKS AND RADIUS FOR TOWN HIGHWAYS)

SALISBURY:
STA. 5+060.0 - STA. 5+600.0 LT & RT

646.60 TEMPORARY 100 mm WHITE LINE
(ALL LINES WILL INCLUDE EDGE LINE BREAKS AND RADIUS FOR TOWN HIGHWAYS)

SALISBURY:
STA. 5+060.0 - STA. 5+600.0 LT & RT

646.41 DURABLE 100 mm YELLOW LINE
(ALL LINES WILL INCLUDE C/L BREAKS FOR TOWN HIGHWAYS) S=SOLID, D=DASHED

SALISBURY:
STA. 5+060.0 - STA. 5+100.0 LT S D RT D
STA. 5+100.0 - STA. 5+116.0 S D - S
STA. 5+116.0 - STA. 5+296.0 D - S
STA. 5+296.0 - STA. 5+600.0 S - S
STA. 5+309.226 DOUBLE SOLID RT, T-9

646.61 TEMPORARY 100 mm YELLOW LINE
(ALL LINES WILL INCLUDE C/L BREAKS FOR TOWN HIGHWAYS) S=SOLID, D=DASHED

SALISBURY:
STA. 5+060.0 - STA. 5+100.0 LT S D RT D
STA. 5+100.0 - STA. 5+116.0 S D - S
STA. 5+116.0 - STA. 5+296.0 D - S
STA. 5+296.0 - STA. 5+600.0 S - S
STA. 5+309.226 DOUBLE SOLID RT, T-9

646.46 DURABLE 600 mm STOP BAR

SALISBURY:
STA. 5+309.226 RT, T-9

646.66 TEMPORARY 600 mm STOP BAR

SALISBURY:
STA. 5+309.226 RT, T-9

646.50 DURABLE LETTER OR SYMBOL

SALISBURY:
STA. 5+309.226 RT, T-9, "S,T,O,P" (4 EA)

646.70 TEMPORARY LETTER OR SYMBOL


SALISBURY:
STA. 5+309.226 RT, T-9, "S,T,O,P" (4 EA)

675.50 REMOVING SIGNS

AS SHOWN - 6

675.60 ERECTING SALVAGED SIGNS

AS SHOWN - 1

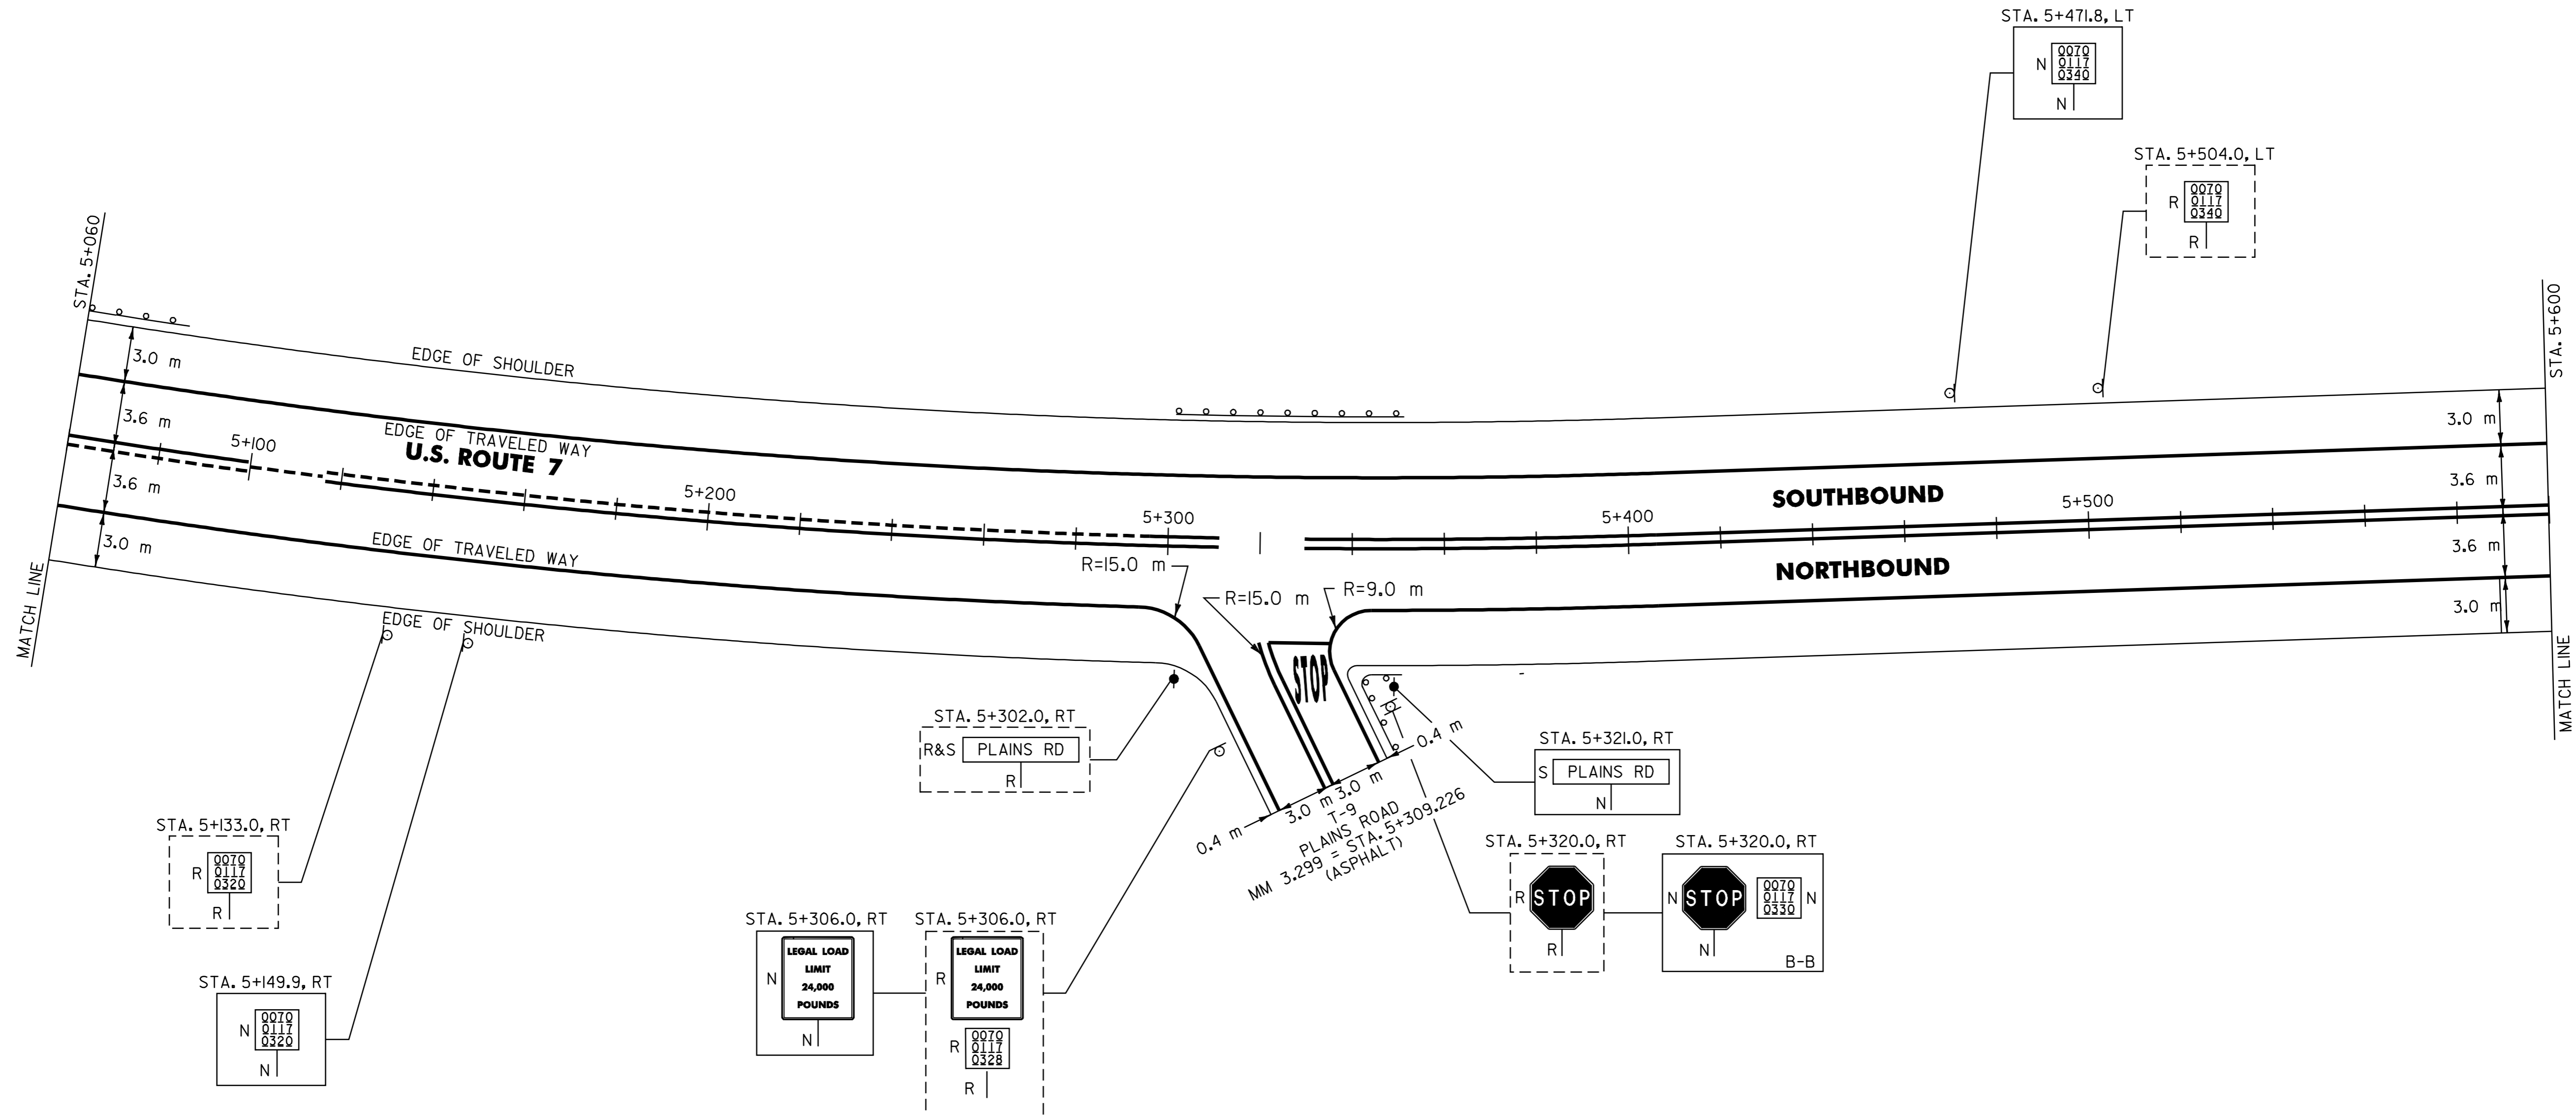

621.20 STEEL BEAM GUARDRAIL

SALISBURY: **SEE SHEET 15**
~~STA. 5+060.0 - STA. 5+069.8 LT (9.8 m)~~
 STA. 5+313.4 - STA. 5+340.0 LT (26.6 m)
 STA. 5+323.0 - STA. 5+338.0 RT (26.6 m)
 (30.48 m)

621.505 MANUFACTURED TERMINAL SECTION

SALISBURY:
STA. 5+323.0 RT (ON T-9)

621.505 MANUFACTURED TERMINAL SECTION (FLARED)

SALISBURY:
 STA. 5+069.8 - STA. 5+081.2 LT
 STA. 5+302.0 - STA. 5+313.4 LT
 STA. 5+338.0 - STA. 5+349.4 RT
 STA. 5+340.0 - STA. 5+351.4 LT

621.80 REMOVAL AND DISPOSAL OF GUARDRAIL

SALISBURY:
 STA. 5+060.0 - STA. 5+078.0 LT (18.0 m)
 STA. 5+302.0 - STA. 5+349.0 LT (47.0 m)
 STA. 5+323.0 - STA. 5+346.0 RT (49.6 m)

NOTE:

1. PAVING LIMIT ON ALL TOWN HIGHWAYS SHALL BE MEASURED 8 m BACK FROM U.S. ROUTE 7 EDGE OF SHOULDER UNLESS DENOTED OTHERWISE ON THE PLANS OR AS DIRECTED BY THE RESIDENT ENGINEER.

SIGN LEGEND
 R= REMOVE
 S= SALVAGE
 N= NEW
 RET= RETAIN
 B-B= BACK TO BACK
 EXISTING= _____
 NEW= _____

PAVING PROJECT LAYOUT # 7

SURVEYED BY N/A DATE N/A
 DRAWN BY C.A.K. DATE 2/02
 SQUAD LEADER D.E.G.
 DESIGN FILE NO. pave/01b018/pb018.dgn
 IPARM FILE pb018p07.i DATE 10-JUL-2006 13:
 PROJ. NAME SALISBURY - MIDDLEBURY
 PROJ. NO. NH_231111
 SHEET J6 OF 67 SHEETS _____

DATUM
 VERTICAL N/A
 HORIZONTAL N/A