

646.40 DURABLE 100 mm WHITE LINE
 (ALL LINES WILL INCLUDE EDGE LINE BREAKS AND RADIUS FOR TOWN HIGHWAYS)

SALISBURY:
 STA. 6+680.0 - STA. 7+220.0 LT & RT

646.60 TEMPORARY 100 mm WHITE LINE
 (ALL LINES WILL INCLUDE EDGE LINE BREAKS AND RADIUS FOR TOWN HIGHWAYS)

SALISBURY:
 STA. 6+680.0 - STA. 7+220.0 LT & RT


646.4I DURABLE 100 mm YELLOW LINE
 (ALL LINES WILL INCLUDE C/L BREAKS FOR TOWN HIGHWAYS) S=SOLID, D=DASHED

SALISBURY: LT C RT
 STA. 6+680.0 - STA. 6+984.6 - D - S
 STA. 6+984.6 - STA. 7+220.0 - - -

646.6I TEMPORARY 100 mm YELLOW LINE
 (ALL LINES WILL INCLUDE C/L BREAKS FOR TOWN HIGHWAYS) S=SOLID, D=DASHED

SALISBURY: LT C RT
 STA. 6+680.0 - STA. 6+984.6 - D - S
 STA. 6+984.6 - STA. 7+220.0 - - -

675.50 REMOVING SIGNS
 AS SHOWN - 2

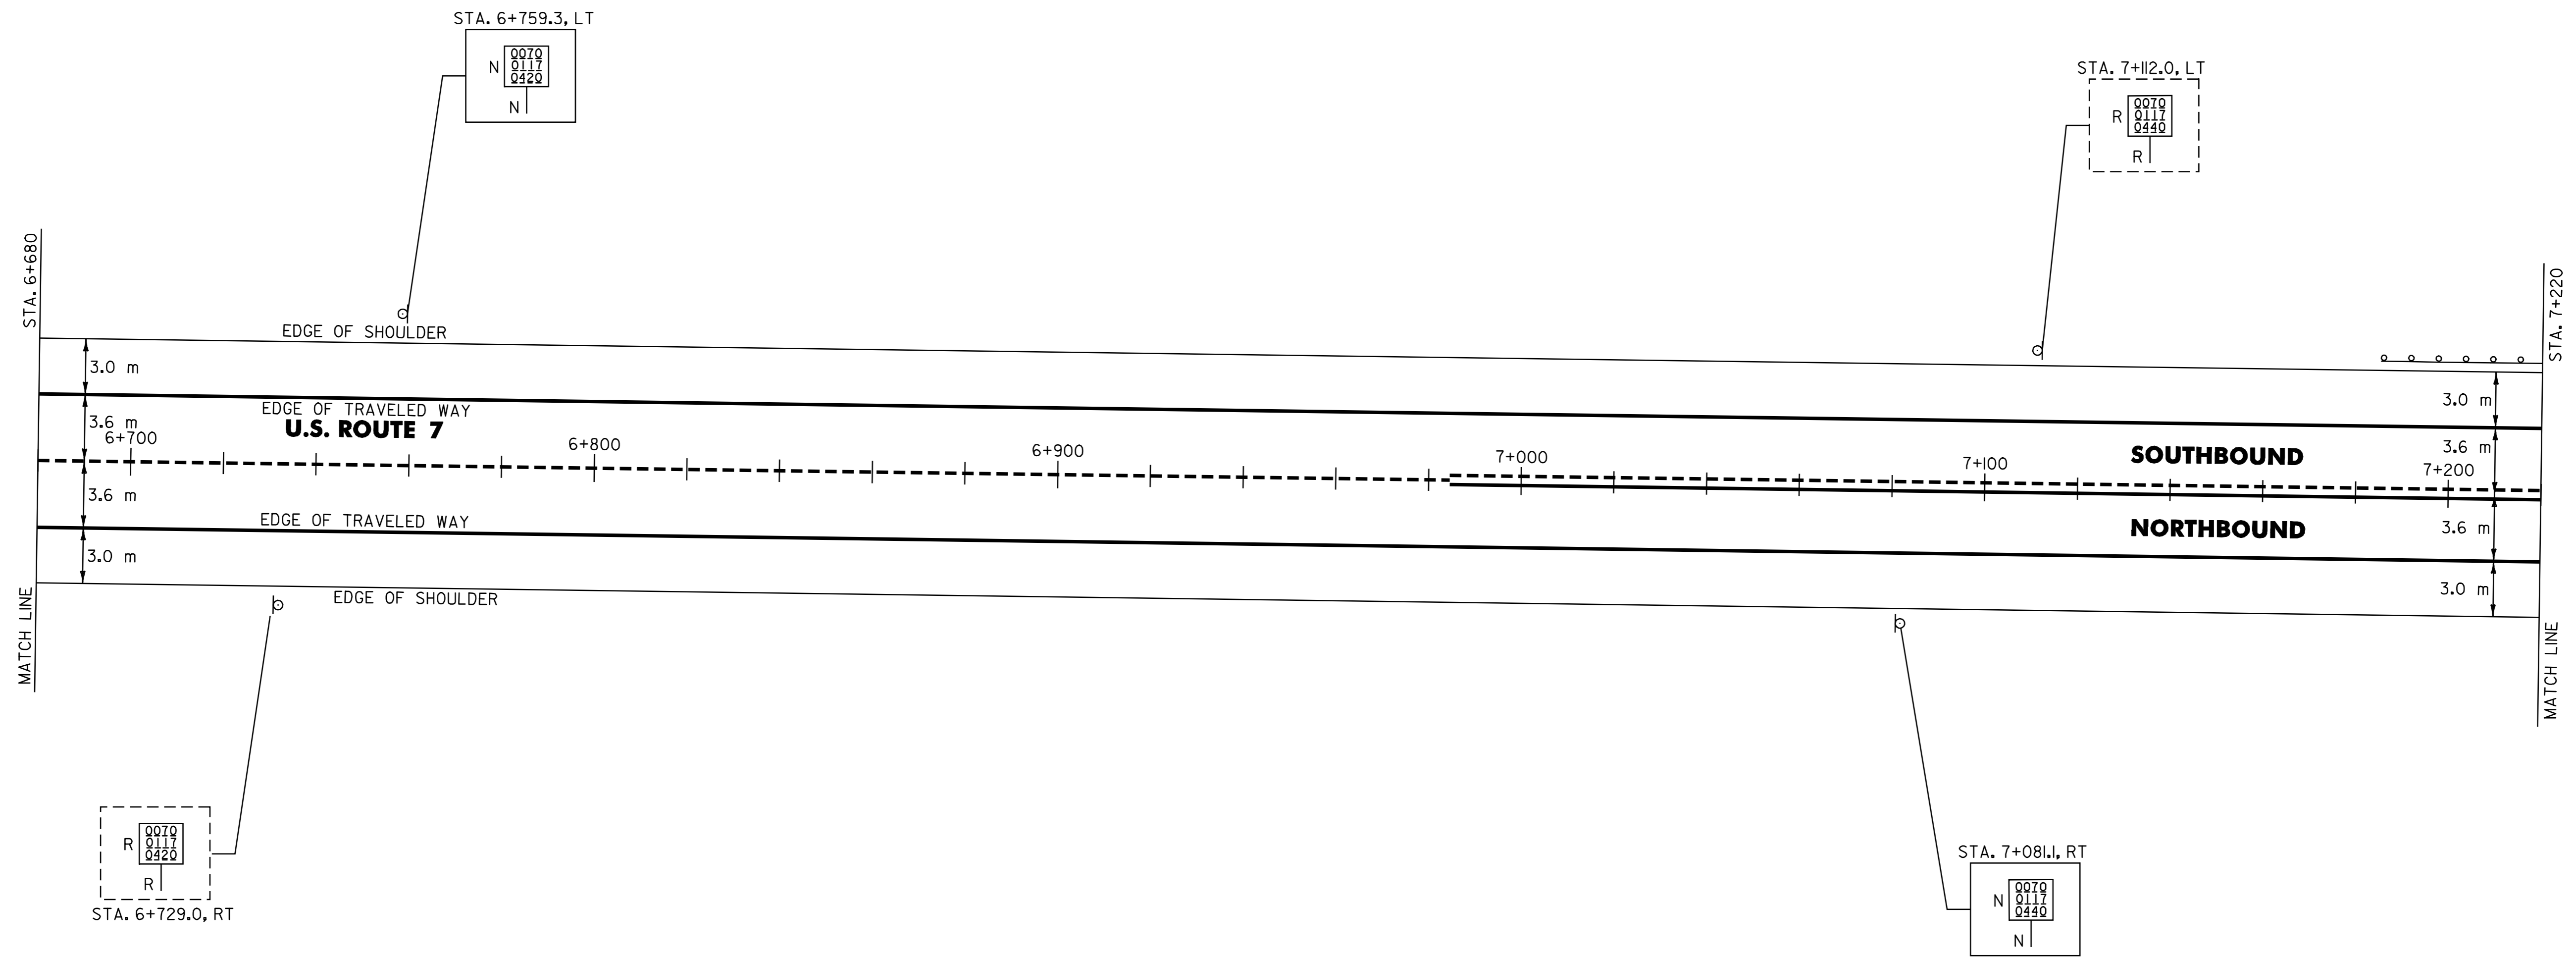

621.20 STEEL BEAM GUARDRAIL

SALISBURY:
 STA. 7+197.4 - ~~STA. 7+220.0 LT (22.6 m)~~
 STA. 7+258.36 LT (60.96 m)

621.505 MANUFACTURED TERMINAL SECTION (FLARED)

SALISBURY:
 STA. 7+186.0 - STA. 7+197.4 LT

621.80 REMOVAL AND DISPOSAL OF GUARDRAIL

SALISBURY:
 STA. 7+186.0 - STA. 7+220.0 LT (34.0 m)

SIGN LEGEND
 R= REMOVE
 S= SALVAGE
 N= NEW
 RET= RETAIN
 B-B= BACK TO BACK
 EXISTING= -----
 NEW= _____

PAVING PROJECT LAYOUT # 10

SURVEYED BY	N/A	DATE	N/A
DRAWN BY	C.A.K.	DATE	2/02
SQUAD LEADER	D.E.G.		
DESIGN FILE NO.	pave/01b018/pb018.dgn		
IPARM FILE	pb018p10.i	DATE PLOTTED	10-JUL-2006 13:58
PROJ. NAME	SALISBURY - MIDDLEBURY		
PROJ. NO.	NH_231111S		
SHEET	19	OF	67 SHEETS

DATUM	
VERTICAL	N/A
HORIZONTAL	N/A