

646.40 DURABLE 100 mm WHITE LINE
(ALL LINES WILL INCLUDE EDGE LINE BREAKS AND RADIUS FOR TOWN HIGHWAYS)

MIDDLEBURY:
STA. 5+340.0 - STA. 5+880.0 LT & RT

646.60 TEMPORARY 100 mm WHITE LINE
(ALL LINES WILL INCLUDE EDGE LINE BREAKS AND RADIUS FOR TOWN HIGHWAYS)

MIDDLEBURY:
STA. 5+340.0 - STA. 5+880.0 LT & RT

646.41 DURABLE 100 mm YELLOW LINE
(ALL LINES WILL INCLUDE C/L BREAKS FOR TOWN HIGHWAYS) S=SOLID, D=DASHED

MIDDLEBURY: LT C RT S
STA. 5+340.0 - STA. 5+880.0 S
STA. 5+648.797 DOUBLE SOLID RT, T-115
STA. 5+858.012 DOUBLE SOLID LT, T-113

646.61 TEMPORARY 100 mm YELLOW LINE
(ALL LINES WILL INCLUDE C/L BREAKS FOR TOWN HIGHWAYS) S=SOLID, D=DASHED

MIDDLEBURY: LT C RT S
STA. 5+340.0 - STA. 5+880.0 S
STA. 5+648.797 DOUBLE SOLID RT, T-115
STA. 5+858.012 DOUBLE SOLID LT, T-113

646.46 DURABLE 600 mm STOP BAR

MIDDLEBURY:
STA. 5+648.797 RT, T-115
STA. 5+858.012 RT, T-113

646.66 TEMPORARY 600 mm STOP BAR

MIDDLEBURY:
STA. 5+648.797 RT, T-115
STA. 5+858.012 RT, T-113

646.50 DURABLE LETTER OR SYMBOL

MIDDLEBURY:
STA. 5+648.797 RT, T-115, "S,T,O,P" (4 EA)
STA. 5+858.012 RT, T-113, "S,T,O,P" (4 EA)

646.70 TEMPORARY LETTER OR SYMBOL


MIDDLEBURY:
STA. 5+648.797 RT, T-115, "S,T,O,P" (4 EA)
STA. 5+858.012 RT, T-113, "S,T,O,P" (4 EA)

675.50 REMOVING SIGNS

AS SHOWN - 12

675.60 ERECTING SALVAGED SIGNS

AS SHOWN - 2

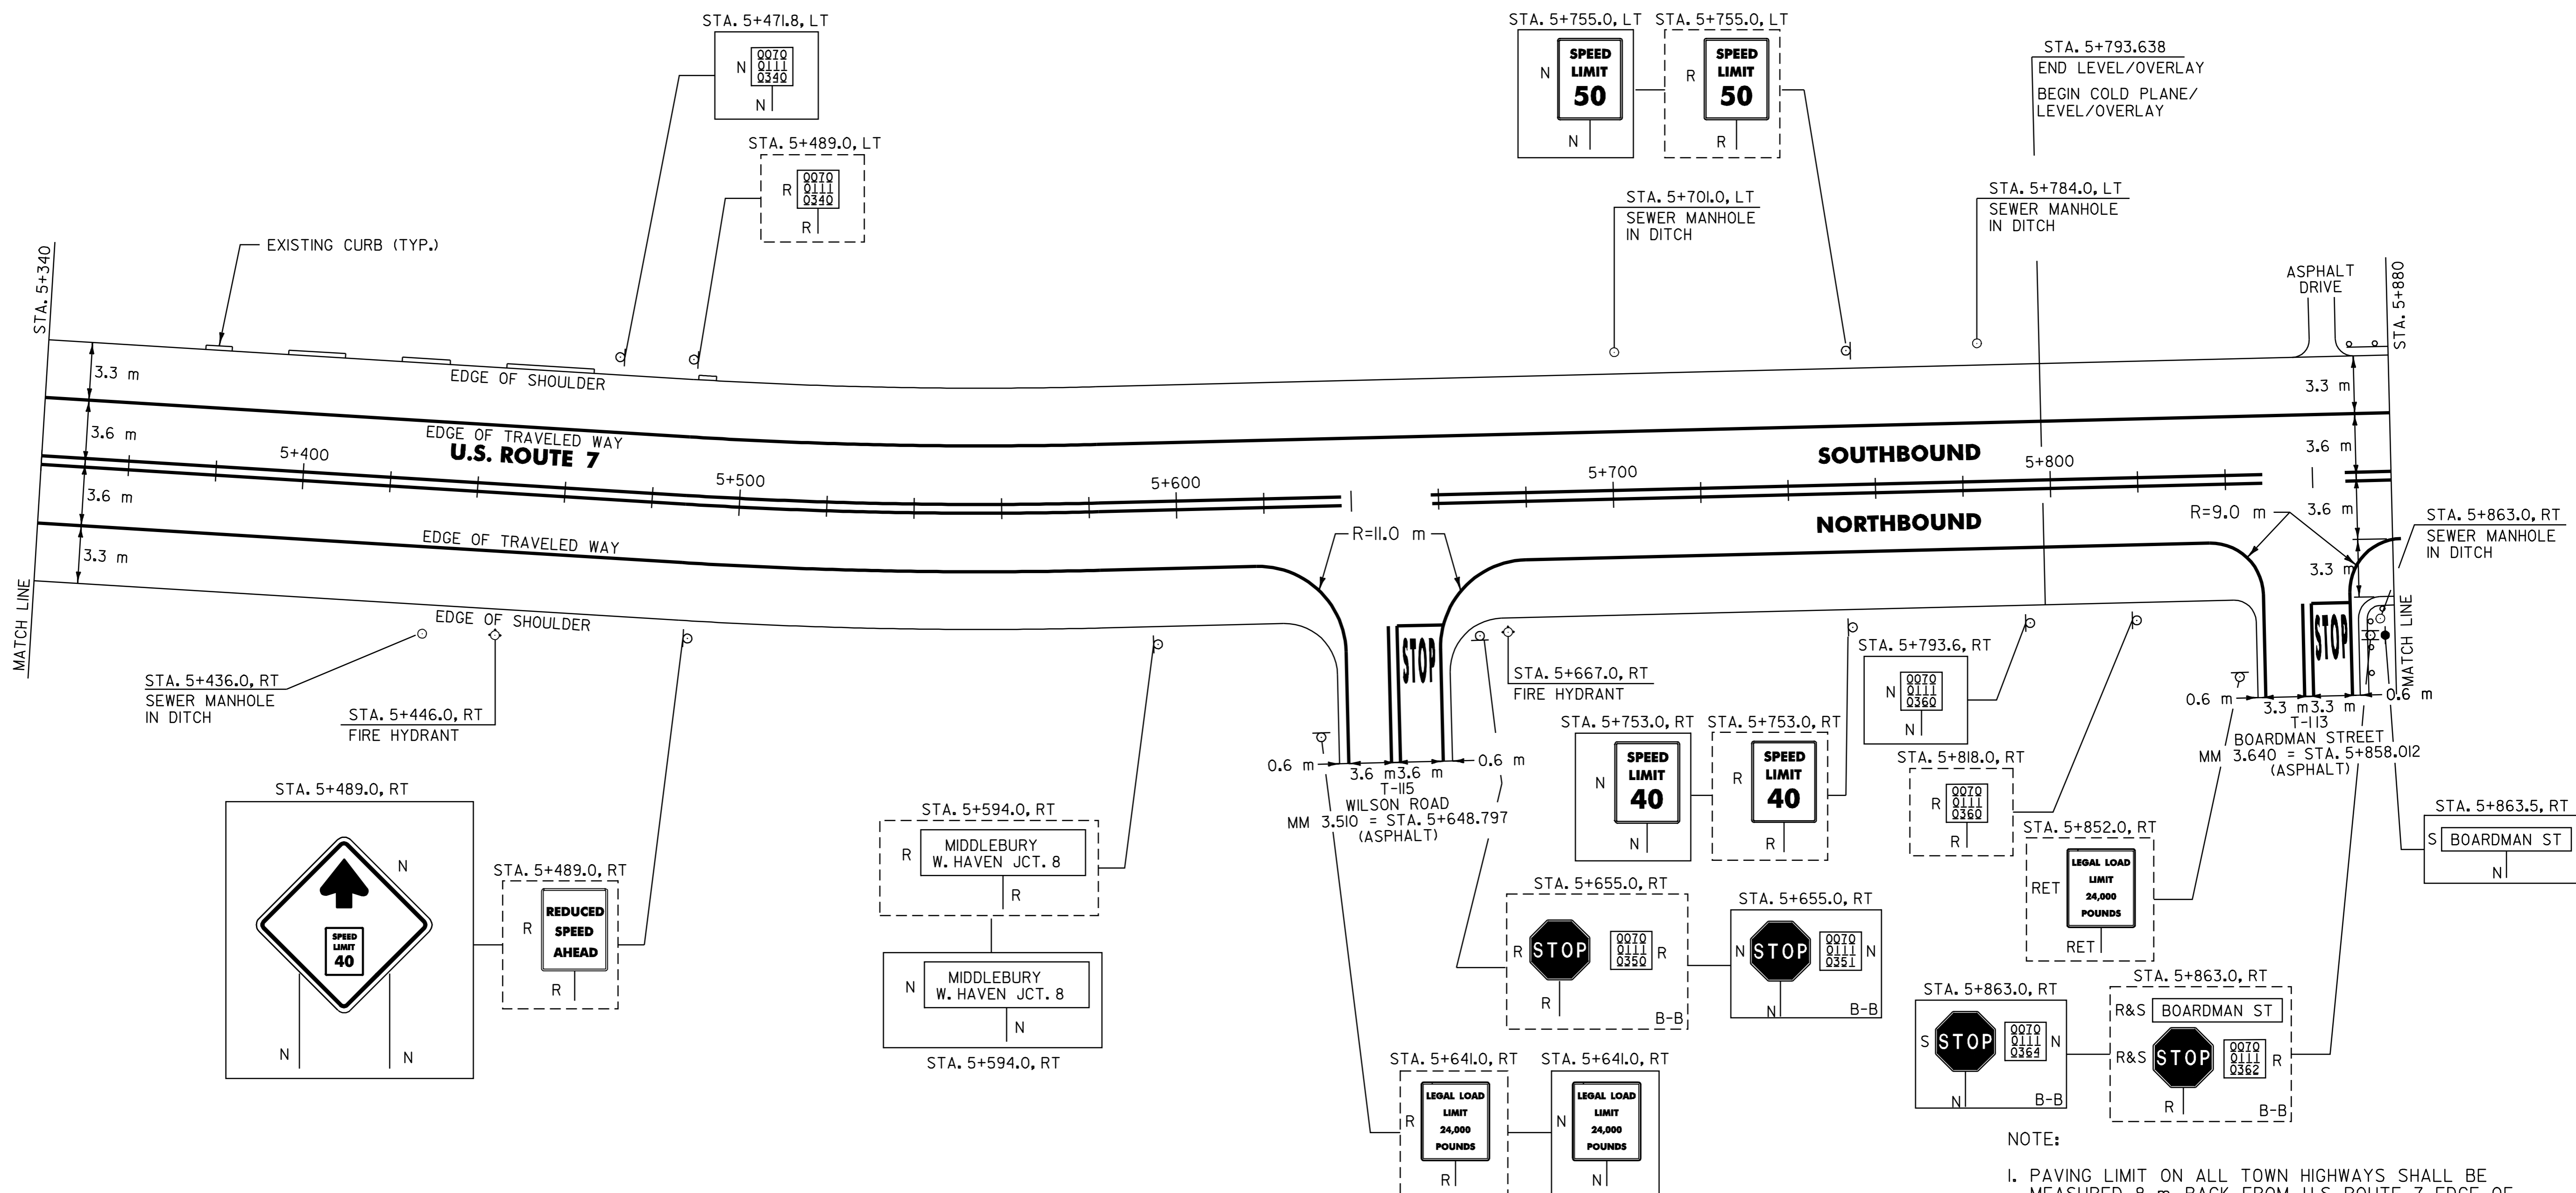

621.20 STEEL BEAM GUARDRAIL

MIDDLEBURY:

STA. 5+869.0 - STA. 5+880.0 RT (36.2 m) SEE PG 33 OF 67

621.505 MANUFACTURED TERMINAL SECTION (FLARED)

MIDDLEBURY:

STA. 5+869.0 RT (ON T-113)

621.80 REMOVAL AND DISPOSAL OF GUARDRAIL

MIDDLEBURY:

STA. 5+869.0 - STA. 5+880.0 LT (11.0 m)
STA. 5+869.0 - STA. 5+880.0 RT (45.2 m)

NOTE:
I. PAVING LIMIT ON ALL TOWN HIGHWAYS SHALL BE MEASURED 8 m BACK FROM U.S. ROUTE 7 EDGE OF SHOULDER UNLESS DENOTED OTHERWISE ON THE PLANS OR AS DIRECTED BY THE RESIDENT ENGINEER.

SIGN LEGEND

- R= REMOVE
- S= SALVAGE
- N= NEW
- RET= RETAIN
- B-B= BACK TO BACK
- EXISTING=
- NEW=

PAVING PROJECT LAYOUT # 23

SURVEYED BY N/A DATE N/A
 DRAWN BY C.A.K. DATE 2/02
 SQUAD LEADER D.E.G.
 DESIGN FILE NO. pave/01b018/pb018.dgn
 IPARM FILE pb018p23.i DATE 10-JUL-2006 13:
 PROJ. NAME SALISBURY - MIDDLEBURY
 PROJ. NO. NH_23(11)
 SHEET 32 OF 67 SHEETS

DATUM
 VERTICAL N/A
 HORIZONTAL N/A